


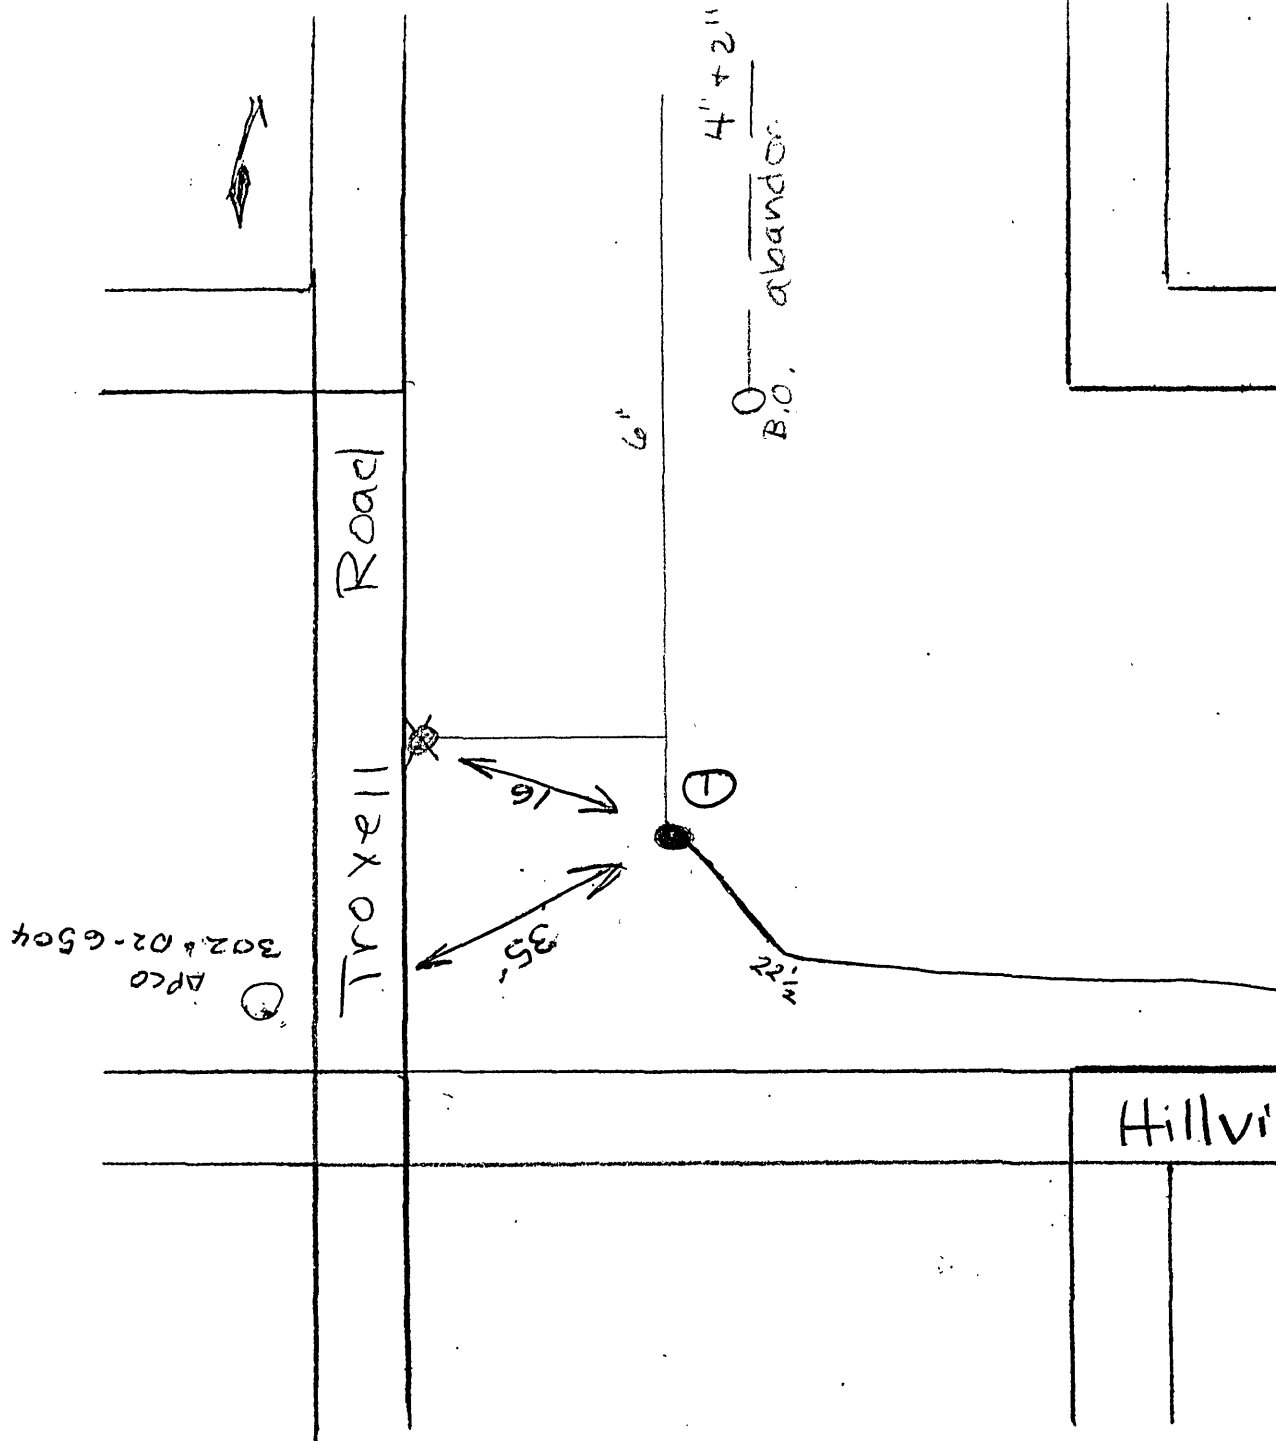

DATE	NO.	SIZE	MAKE	OPEN	TURNS
2-98	1	6"	MU.	R	21

P. L. Measurements		
No.	Distance	Direction

Hillview Ave.

CITY OF ROANOKE - WATER DEPT.	
VALVE DIAGRAM	
Hillview Ave.	
Troxell Rd.	
Sec. Map	439 SE
Date	Page No.