


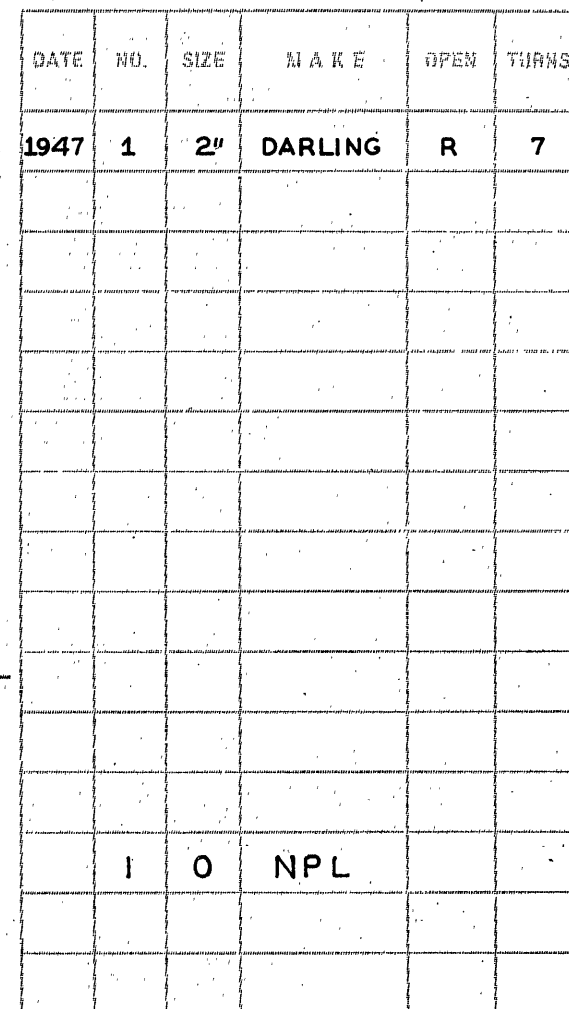

DATE 5/19/47 PAGE NO. SE 258