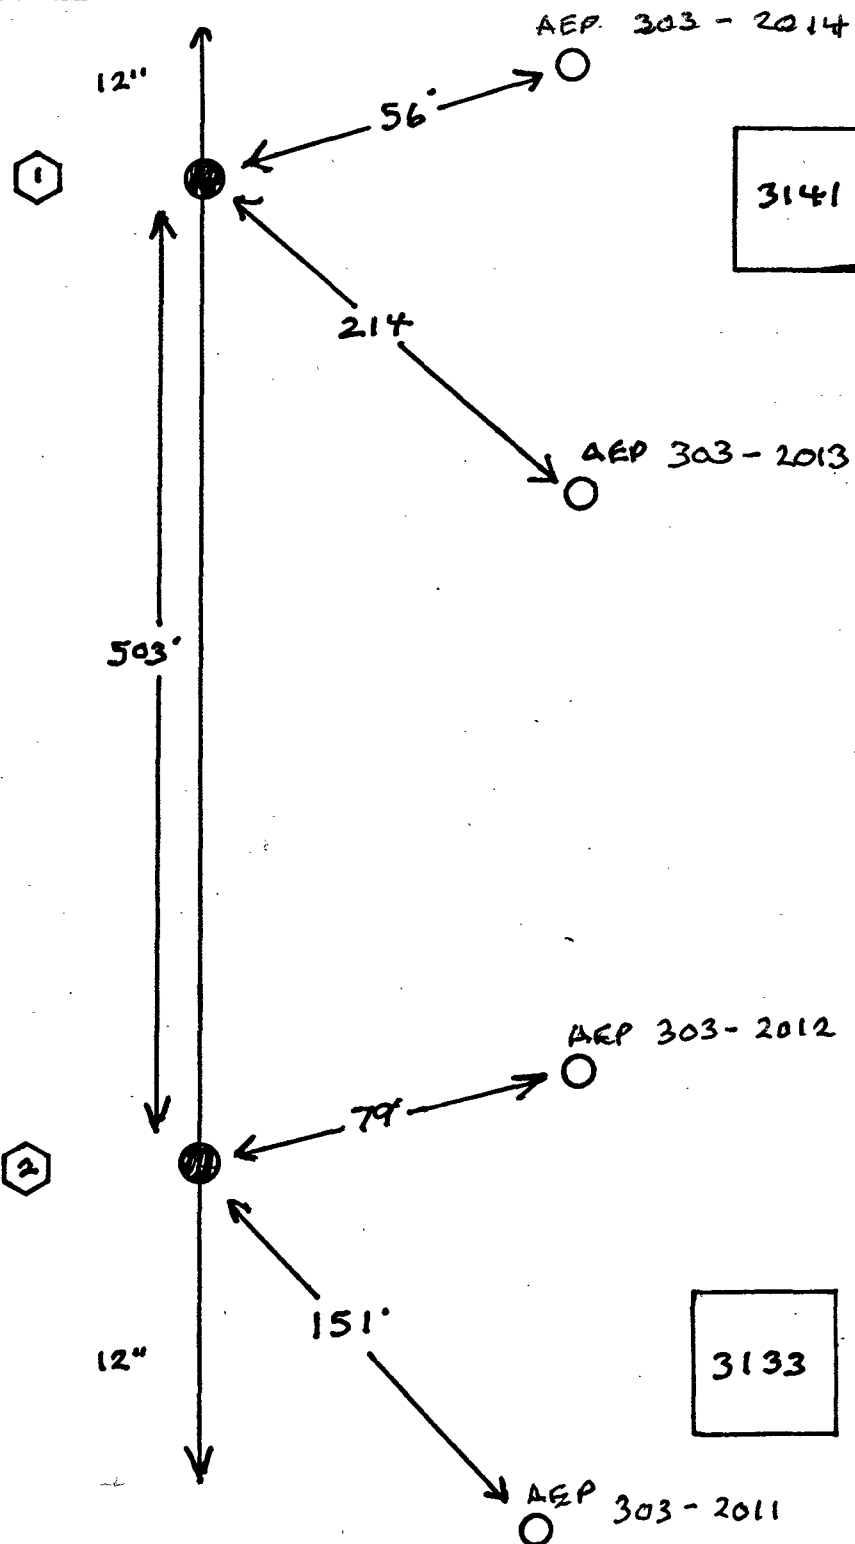


[illegible]

WESTERN VIRGINIA WATER AUTHORITY
VALVE DIAGRAM
3100 Block of Rutrough Rd.
SECT. MAP SE. CO.
DATE 8-7-09