


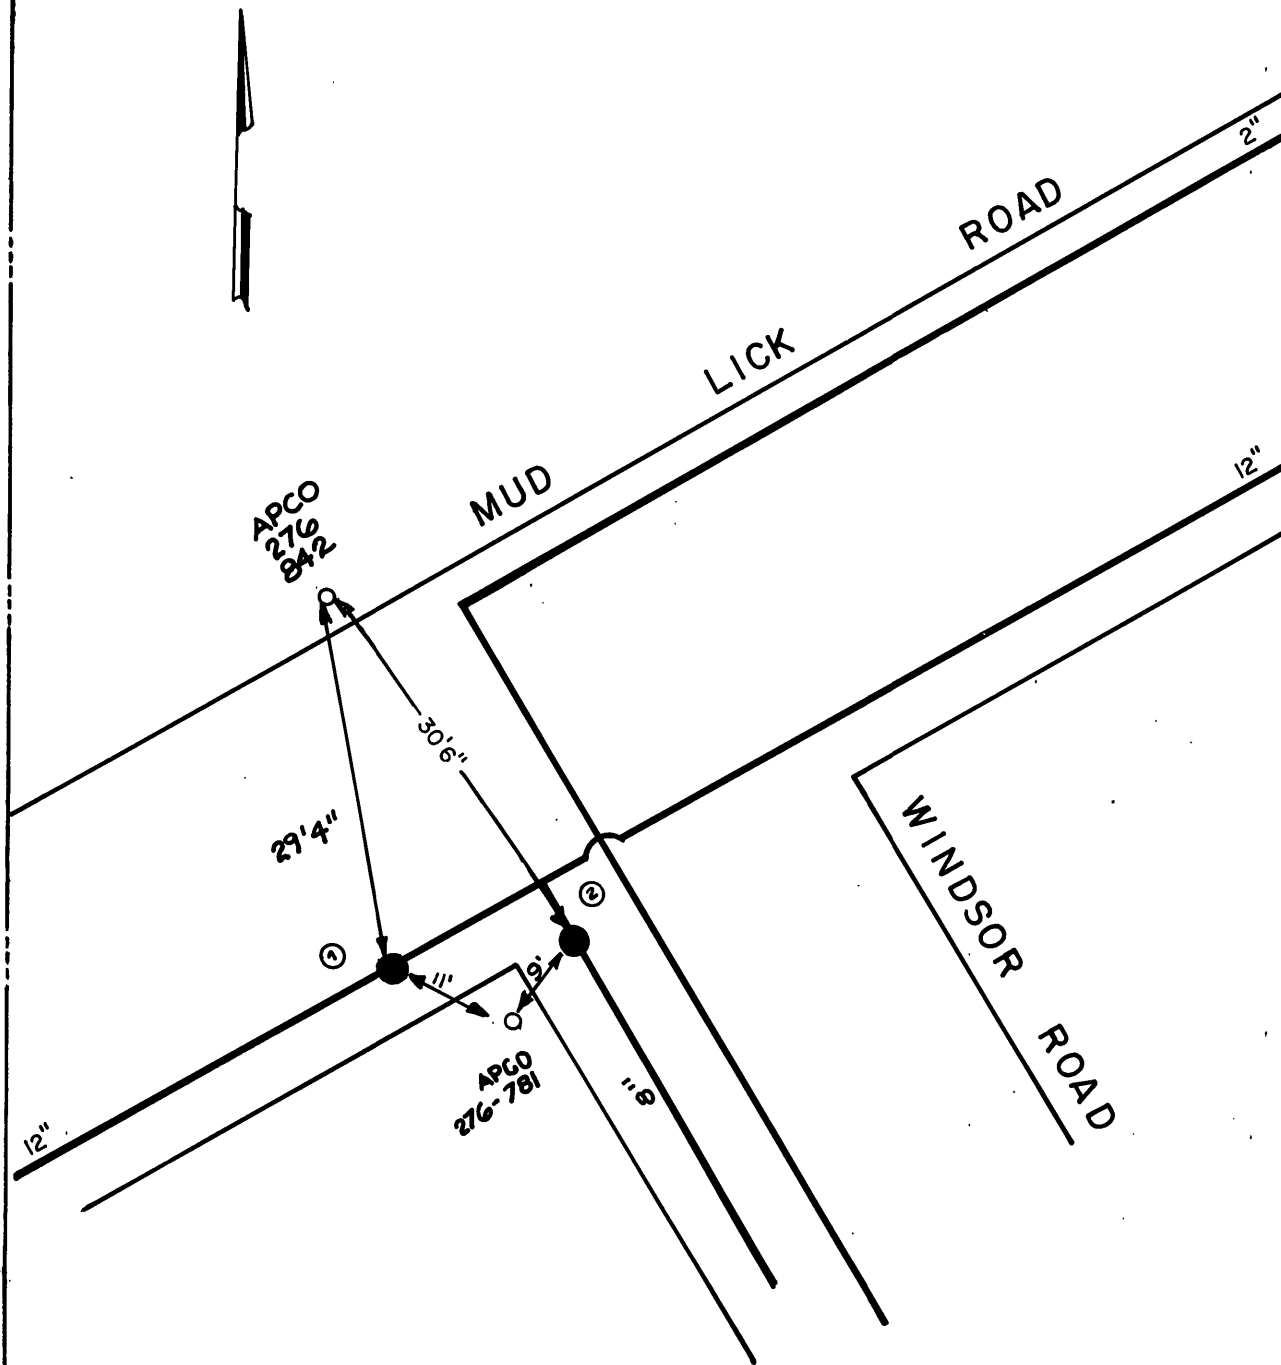

DATE	NO.	SIZE	MAKE	OPEN	TURNS
1979	1	12	DARLING	R	
1979	2	8	DARLING	R	

CITY OF ROANOKE—WATER DEP'T	
VALVE DIAGRAM	
MUD LICK RD	
WINDSOR ROAD	
SEC. MAP 504	S.W.
DATE 7/14/80	PAGE NO.