
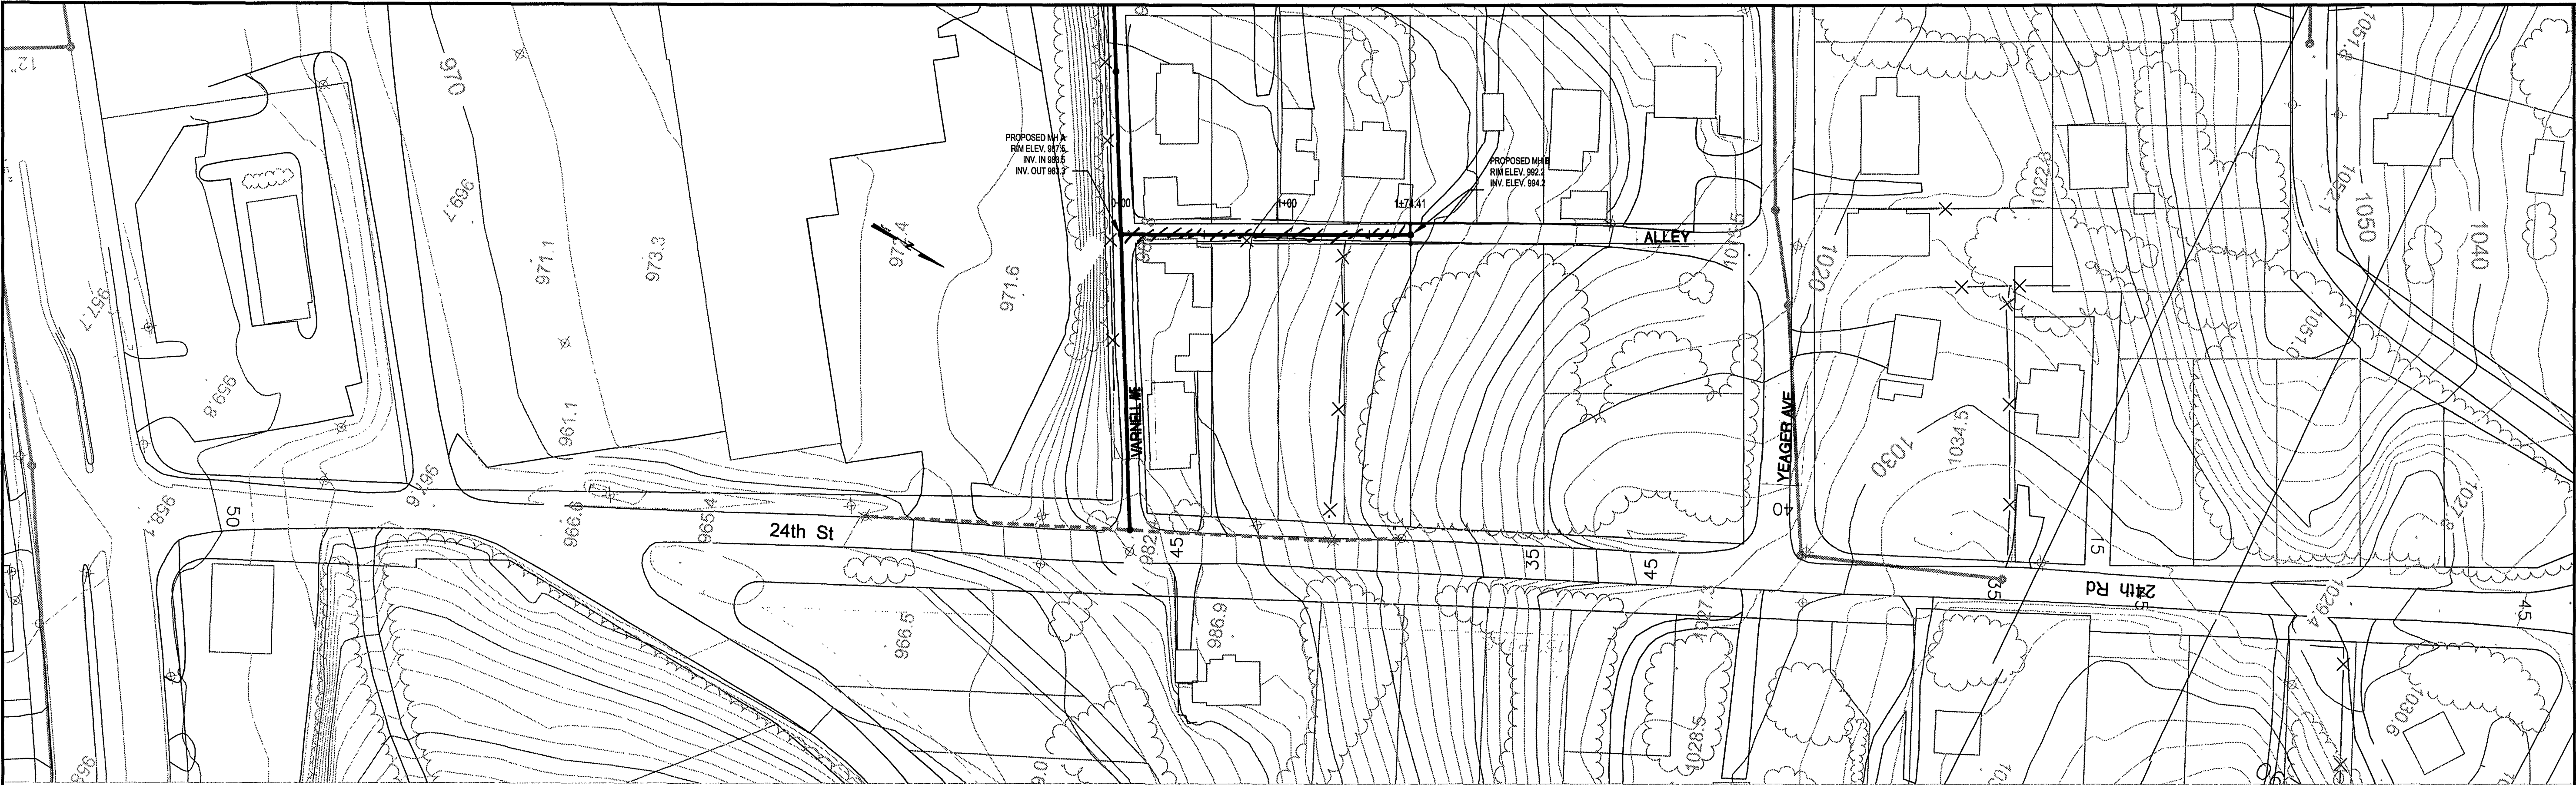
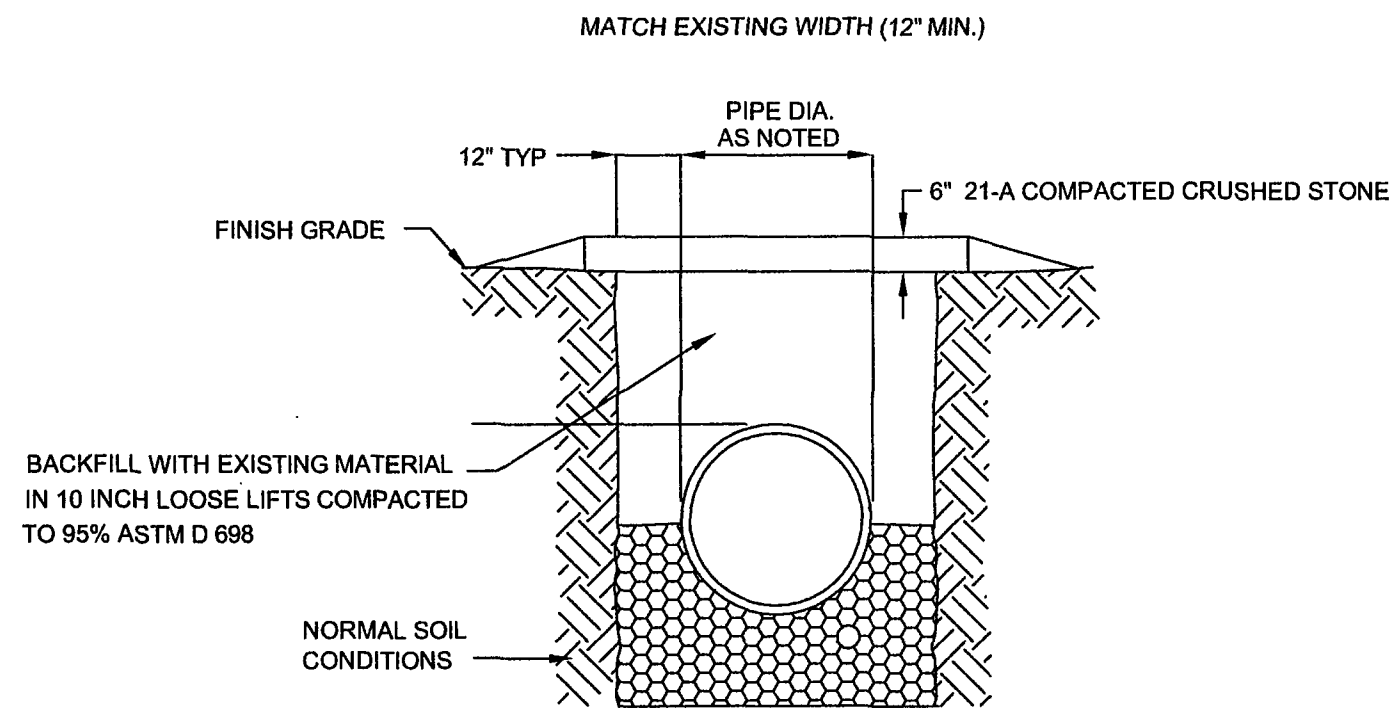


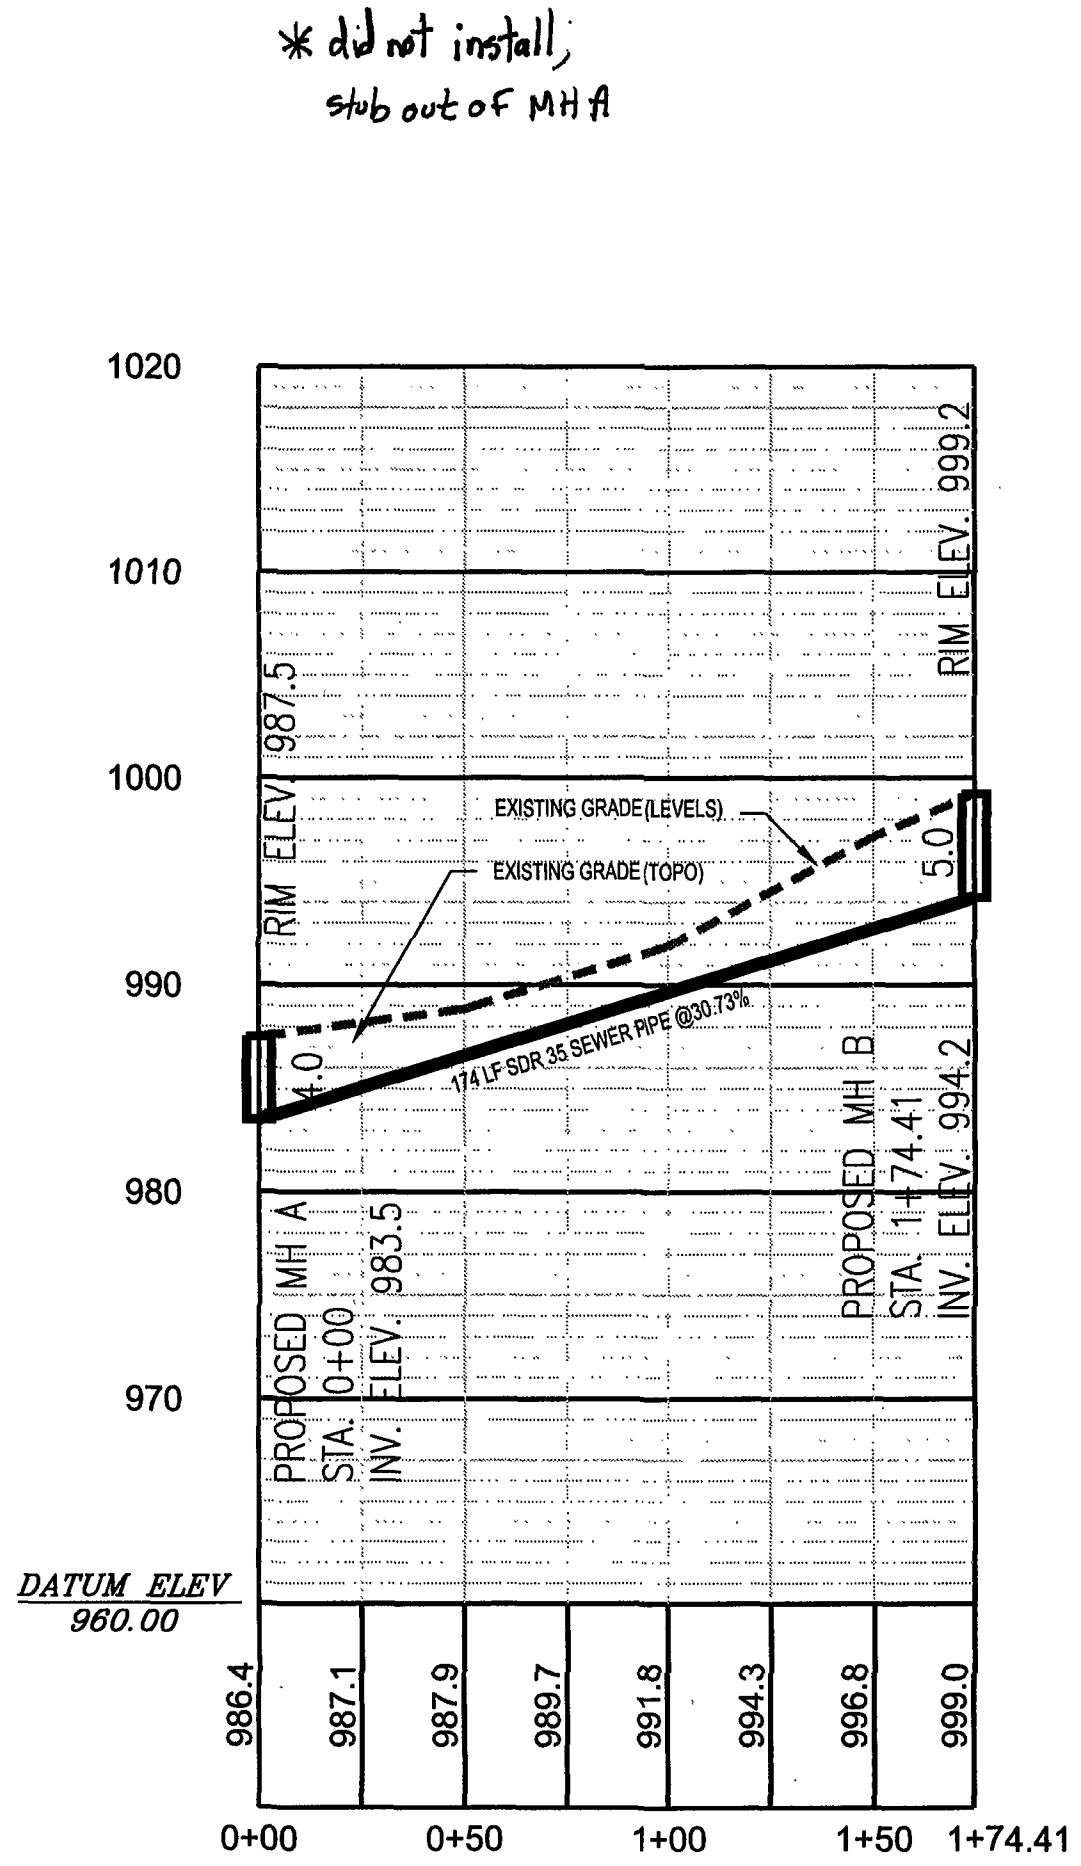

LEGEND

EXISTING SANITARY SEWER

PROPOSED SANITARY SEWER


NOTES:

1. ALL WORK SHALL CONFORM TO WESTERN VIRGINIA WATER AUTHORITY DESIGN & CONSTRUCTION STANDARDS LATEST EDITION.

SCALE: HOR. 1 IN. = 50 FT.
VERT. 1 IN. = 10 FT.


AS-BUILT
4/19/2005

WWW.ID# 6K8MGC

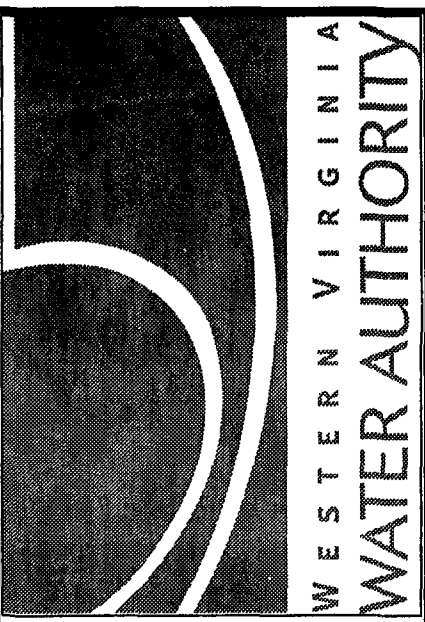

ENGINEERING SERVICES

2012 SOUTH JEFFERSON STREET
ROANOKE, VIRGINIA 24014
PHONE (540) 853-5641

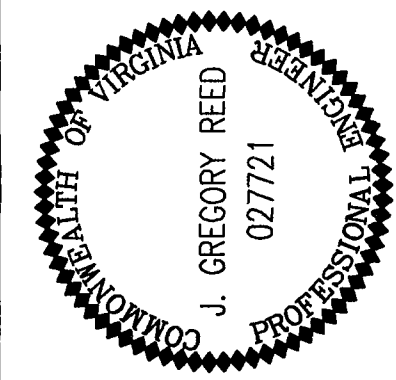

ALLEY BETWEEN 24th & 23rd STREET, NE
PROPOSED SEWER EXTENSION

Designed By:	JAD
Drawn By:	JAD
Checked By:	JGR
Date:	12/16/04
Scale:	1" = 50'
Plan #:	04-07
Sheet:	3 OF 3