
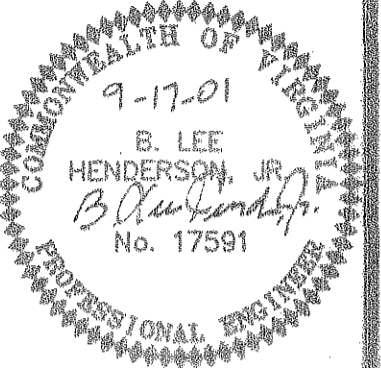


**AS-BUILTS  
SSMH DEPTHS**

SSMH#	DEPTH
1	7.00'
2	7.14'
3	11.76'
4	8.70'
5	8.50'
6	8.50'
7	8.50'
8	9.50'
9	12.00'
10	10.00'
11	8.00'
12	12.00'

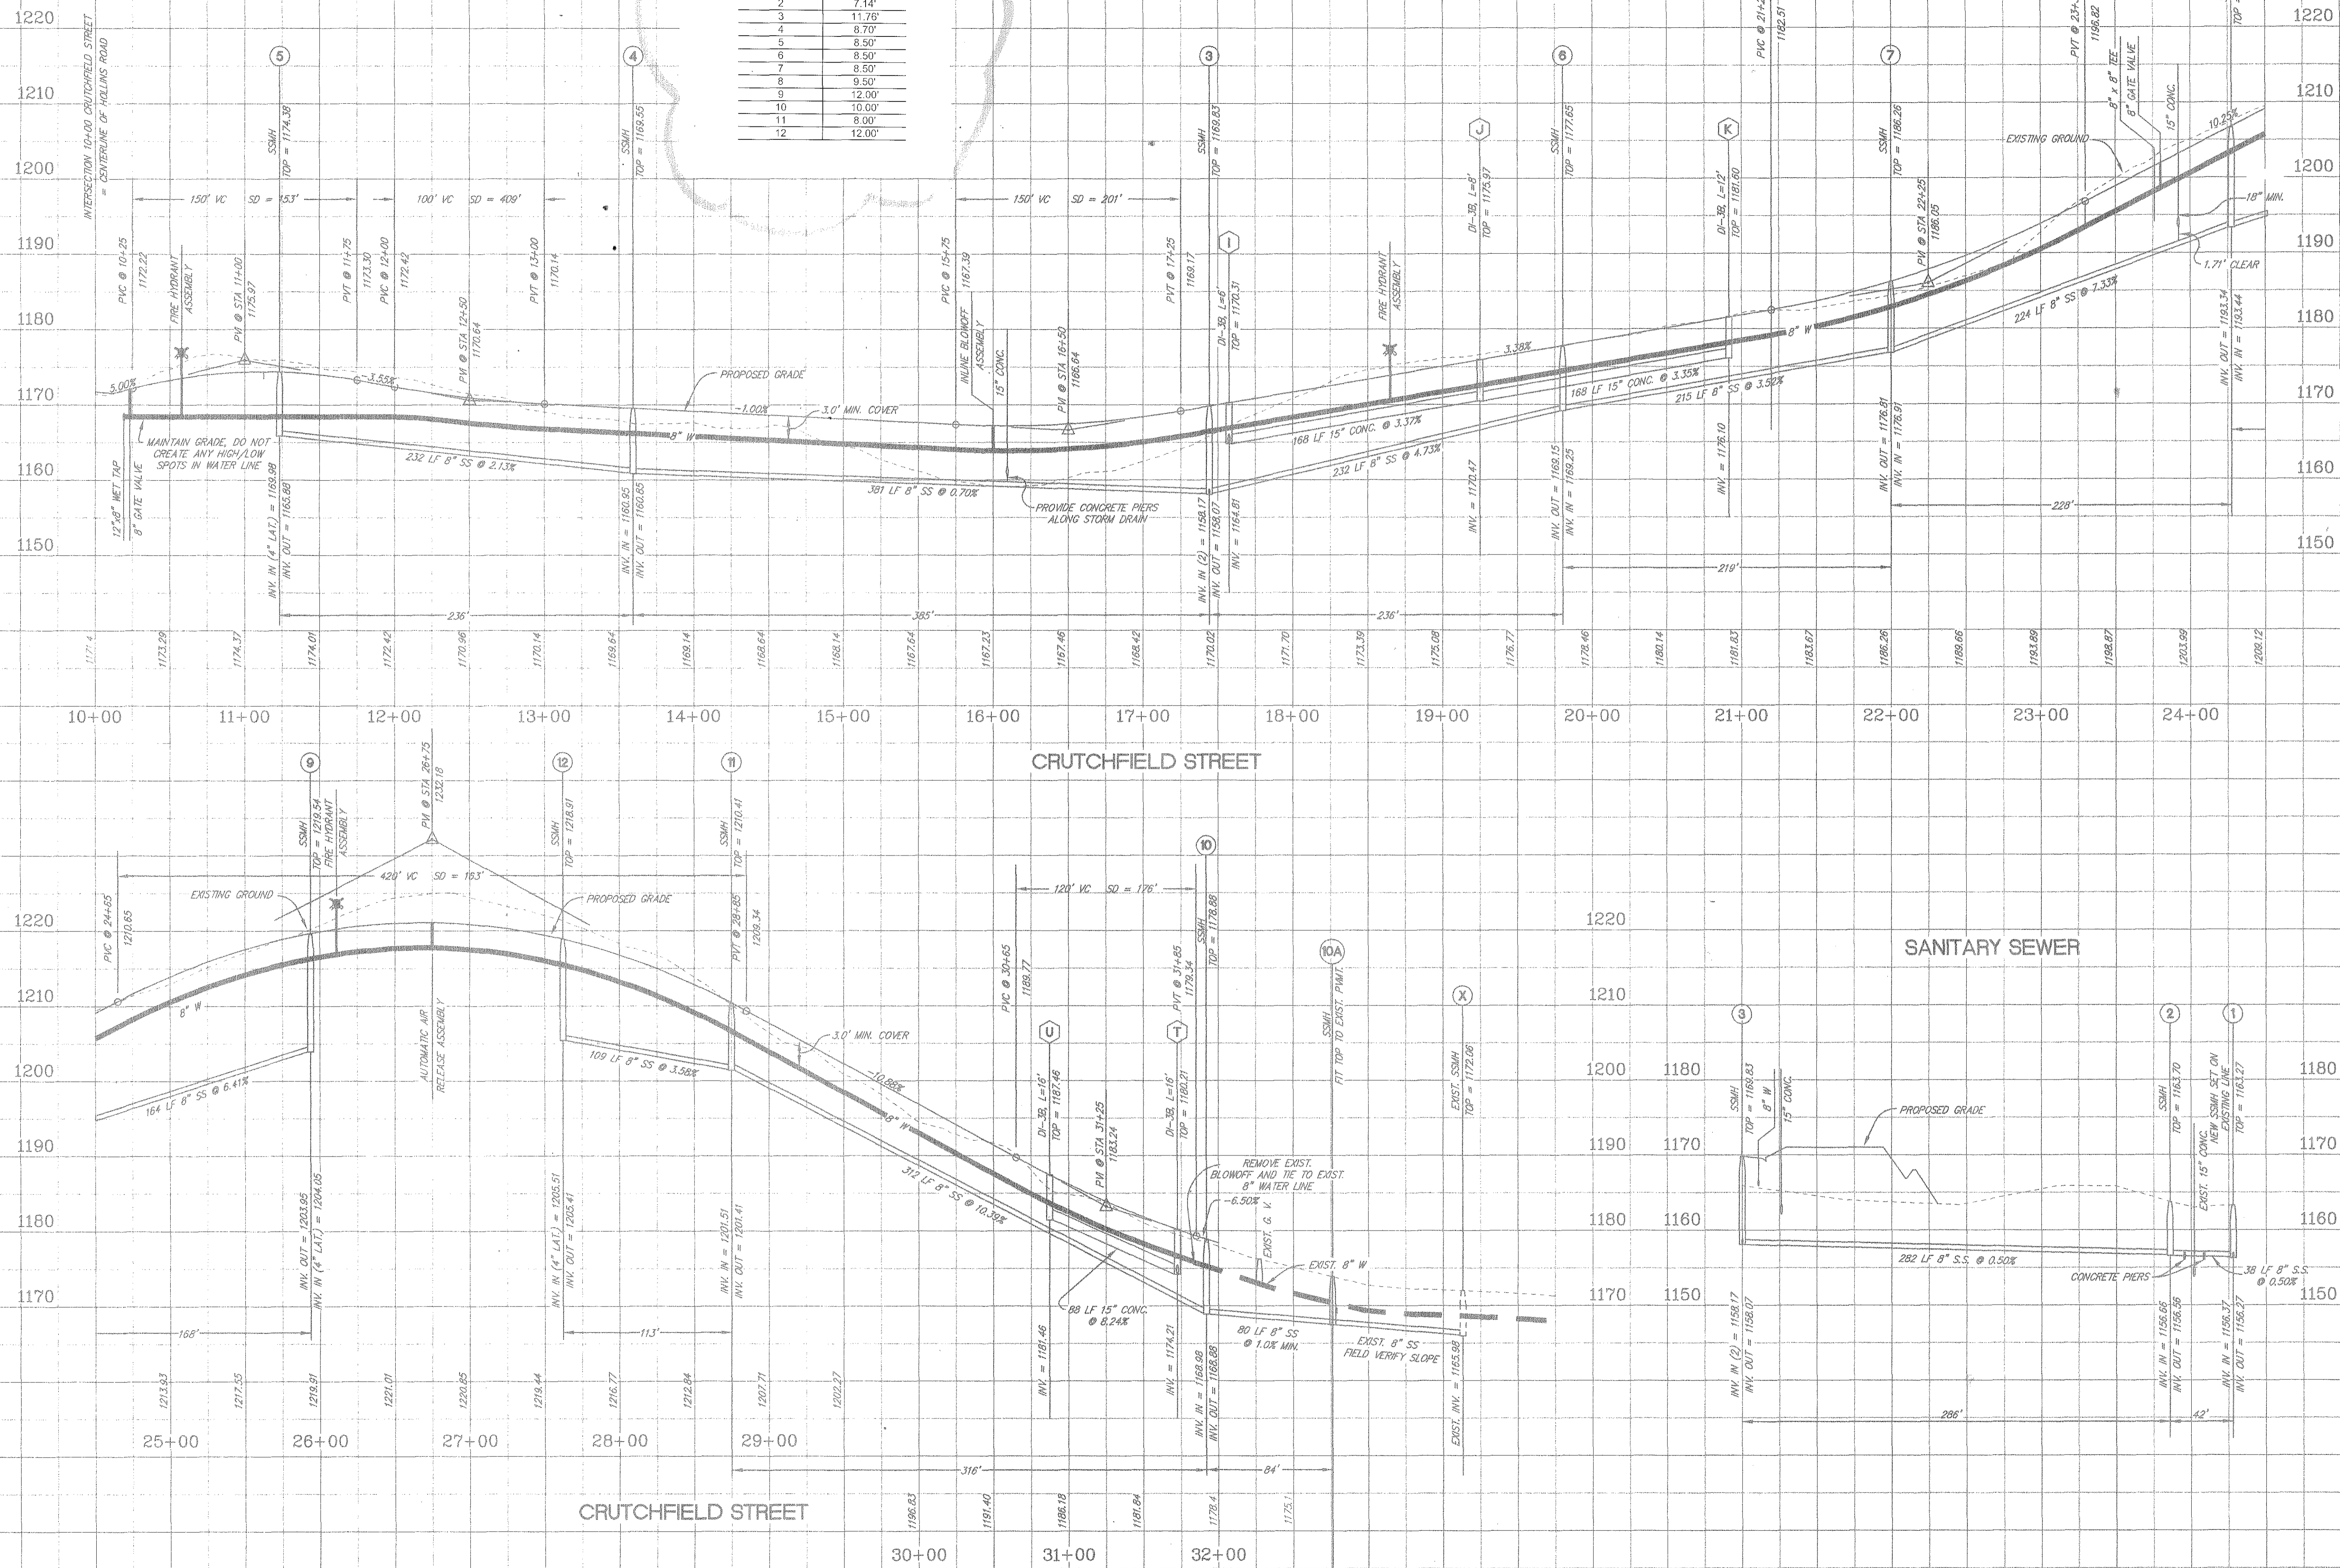

NO.	DATE	DESCRIPTION
1	8/28/01	ISSUED FOR PERMITS TO CONSTRUCT SANITARY SEWER
2	9/20/01	CHANGED ELEVATIONS OF SANITARY SEWER STRUCTURES 7, 8, 9, 10, 11 & 12
3	9/11/01	RAISED WATERLINE STA. 21+00 - 21+00 TO 21+00
4		
5		