





Lumsden Associates, P.C.
ENGINEERS | SURVEYORS | PLANNERS

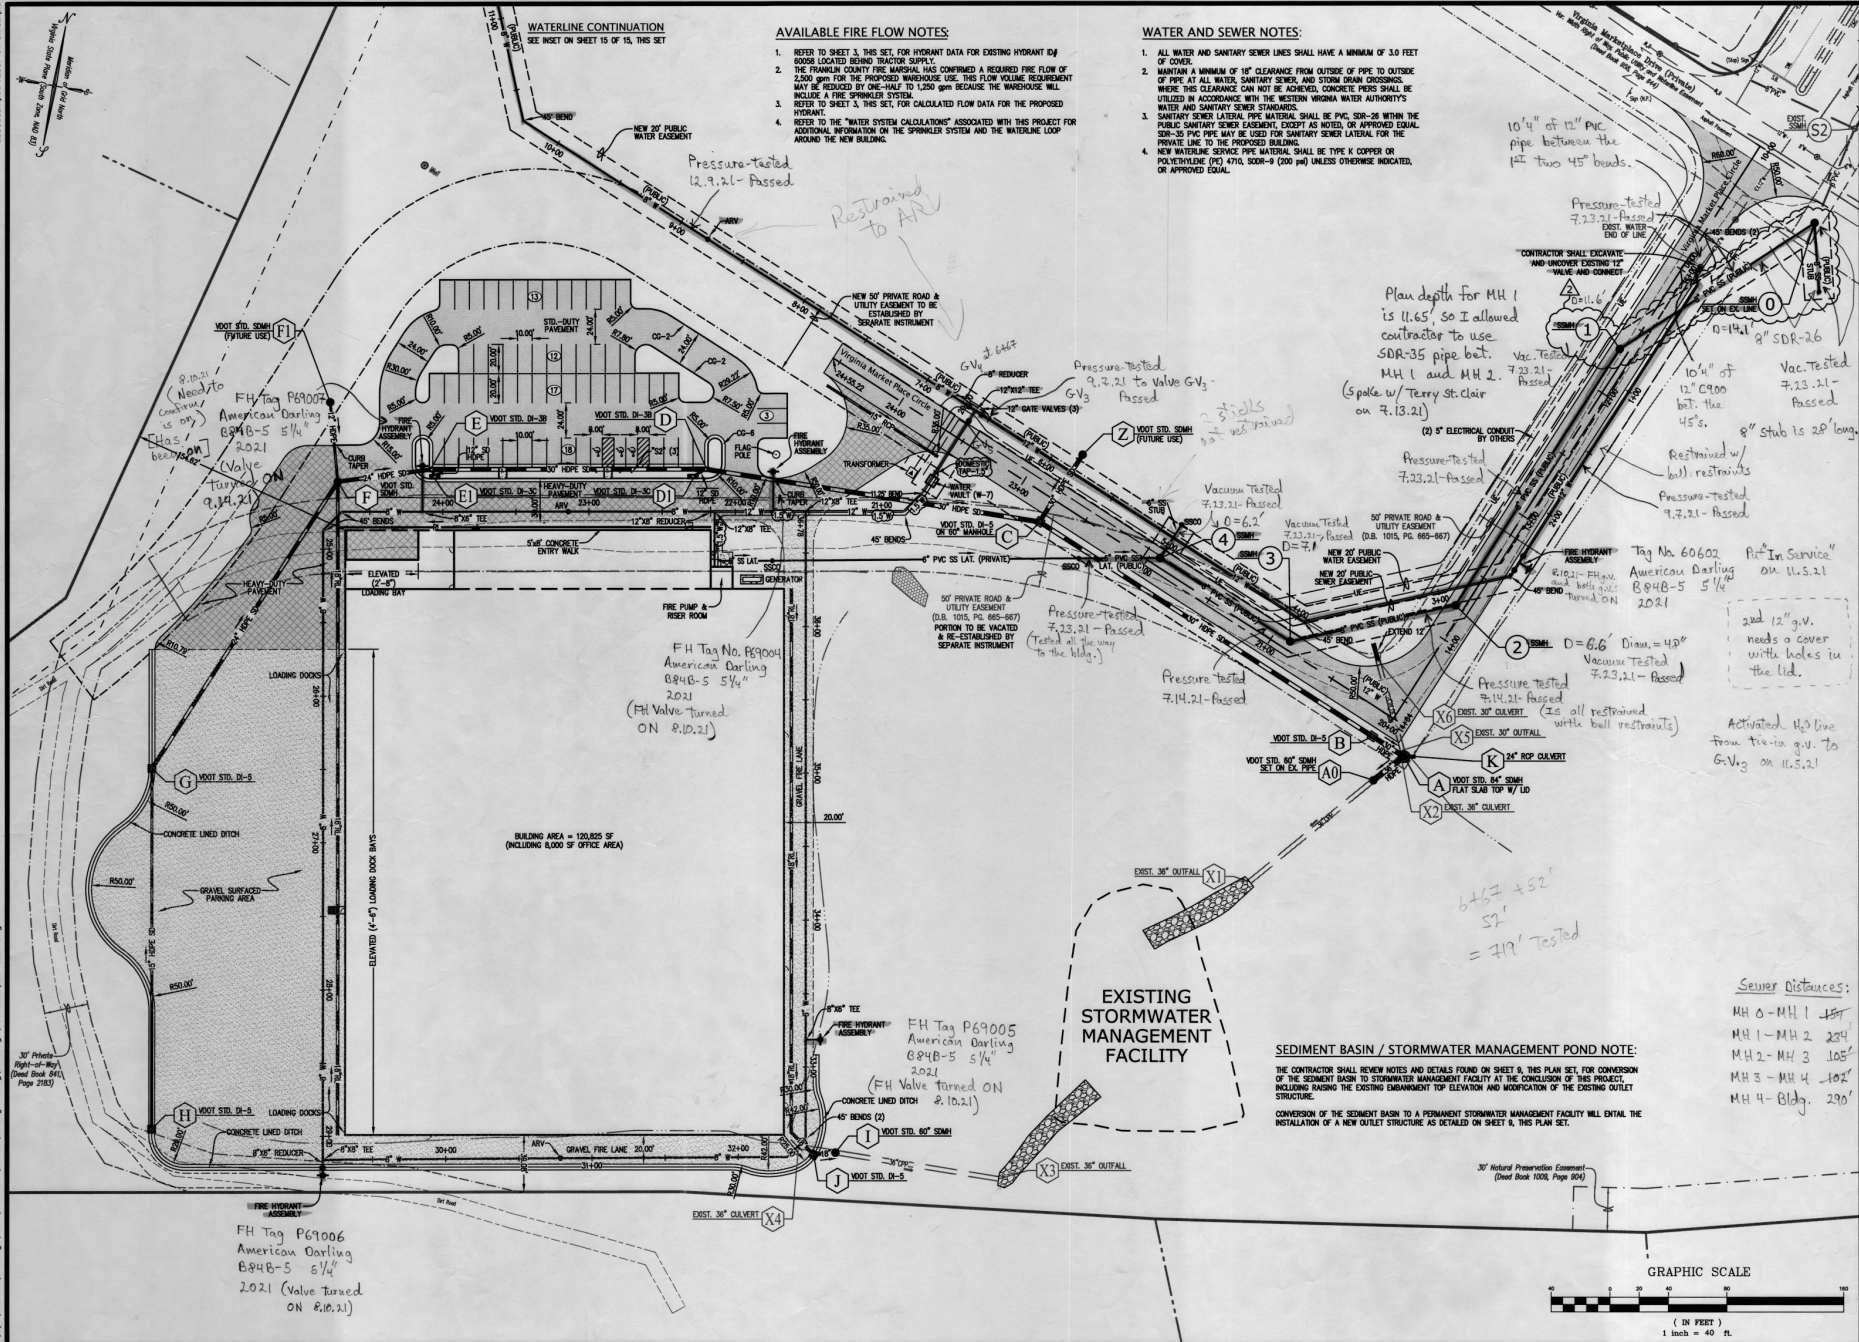

4664 BRAMBLETON AVENUE
P.O. BOX 20669
FARMACIE, VIRGINIA 24018
PHONE: (540) 774-4411
FAX: (540) 772-8445
WWW.LUMSDENPC.COM

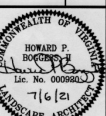

DIMENSIONAL LAYOUT

NEW WAREHOUSE SITE PLAN for
Virginia Furniture Market
PREPARED FOR
SHEPHERD PROPERTIES, LLC
SITUATED ALONG
VIRGINIA MARKET PLACE DRIVE
FARMACIE COUNTY, VIRGINIA

REVISIONS		DATE	DESCRIPTION
1	1	7/6/21	POSS. SANITARY SEWER ALIGNMENT
2	2		POSS. SANITARY SEWER ALIGNMENT
3	3		POSS. SANITARY SEWER ALIGNMENT
4	4		POSS. SANITARY SEWER ALIGNMENT
5	5		POSS. SANITARY SEWER ALIGNMENT
6	6		POSS. SANITARY SEWER ALIGNMENT
7	7		POSS. SANITARY SEWER ALIGNMENT
8	8		POSS. SANITARY SEWER ALIGNMENT
9	9		POSS. SANITARY SEWER ALIGNMENT
10	10		POSS. SANITARY SEWER ALIGNMENT

DATE: May 19, 2021
SCALE: 1" = 40'
COMMISSION NO.: 2020-301
SHEET 4 OF 15