GENERAL SITE NOTES:

- 1. G.C. TO CONFIRM THE LOCATION OF ALL EXISTING UTILITIES PRIOR TO ANY CONSTRUCTION OF PROPOSED IMPROVEMENTS.
- 2. NO CONSTRUCTION/FIELD CHANGES WITHOUT THE APPROVAL OF THE CONSULTING ENGINEERING AND CITY OF ROANOKE PLANNING, BUILDING, AND DEVELOPMENT DEPARTMENT. G.C SHALL OBTAIN A RIGHT OF WAY PERMIT FROM THE CITY OF ROANOKE PRIOR TO ANY WORK WITHIN THE CITY OF ROANOKE R.O.W.
- 3. GENERAL CONTRACTOR TO FIELD VERIFY PAVEMENT TIE IN LOCATIONS AND ENSURE THAT POSITIVE DRAINAGE AWAY FROM THE PROPOSED BUILDING IS MAINTAINED THROUGHOUT THE SITE AND W/THE ADJACENT BUILDING TO THE SOUTH.
- 4. ANY PAVEMENT TO REMAIN THAT IS DISTURBED OR DESTROYED DURING THE CONSTRUCTION PROCESS SHALL BE REPAIRED/REPLACED AS NECESSARY TO PRE-CONSTRUCTION CONDITIONS AT NO COST TO THE OWNER.
- 5. ALL BUILDING DIMENSIONS SHALL BE COORDINATED WITH THE ARCHITECTURAL
- 6. G.C. SHALL SUBMIT A TRAFFIC CONTROL PLAN TO THE CITY OF ROANOKE PRIOR TO ANY CONSTRUCTION WITHIN THE RIGHT-OF-WAY.
- 7. G.C. TO PROVIDE ALL REQUIRED CONDUIT FOR EXTERIOR LIGHTING, ELECTRICAL, TELEPHONE, AND COMMUNICATIONS.
- 8. G.C. SHALL COORDINATE CONCRETE FINISHING AROUND THE PROPOSED DOOR LOCATIONS WITH THE ARCHITECTURAL PLANS.
- 9. THE SITE CONTRACTOR MUST COORDINATE THE TIMING AND INSTALLATION OF ALL UTILITIES AND MAKE ALL NECESSARY SCHEDULE ARANGEMENTS FOR TEMPORARY OR PERMANENT UTILITIES PER THE PROJECT SCHEDULE.
- 10. ALL ROOFTOP OR GROUND MOUNTED MECHANICAL EQUIPMENT SHALL BE SCREENED FROM VIEW PER CITY OF ROANOKE ZONING ORDINANCE. THE PERIMETER OF ALL GROUND-MOUNTED EQUIPMENT SHALL BE SCREENED FROM ANY STREET FRONTAGE OR ADJACENT PROPERTY BY A FENCE OR SOLID WALL WITH 60% OR GREATER OPACITY. THE PERIMETER OF ALL ROOFTOP EQUIPMENT THAT WOULD OTHERWISE BE VISIBLE FROM ANY STREET FRONTAGE SHALL BE SCREENED BY A FENCE OR SOLID WALL WITH 60% OR GREATER OPACITY AT LEAST 1/2 THE VERTICIAL HEIGHT OF THE EQUIPMENT FROM THE ADJACENT STREET, TO BE VERIFIED BY SUBMISSION OF A FIELD REVISION TO THE DEVELOPMENT PLAN OR SEPARATE BUILDING PERMIT.
- 11. G.C. SHALL OBTAIN A SEPARATE SIGN PERMIT FOR ALL ON-SITE AND BUILDING SIGNAGE. IF A FLAGPOLE DISPLAY IS PROPOSED, NOTE THAT ONLY FLAGS TO BE DISPLAYED ARE NATIONAL, STATE, OR OTHER GOVERNMENTAL FLAGS AND INSIGNIAS.
- 12.THE DUMPSTER OR REFUSE CONTAINER STORAGE AREA MUST MEET ALL REQUIREMENTS SET FORTH IN TABLE 647-1 AND ARTICLE 4. SUPPLEMENTAL REGULATION SECTION OF THE ZONING ORDINANCE. THE HEIGHT OF THE DUMPSTER SCREENING MUST BE AT LEAST 12" ABOVE THE TOP OF THE DUMPSTER AND THE OPACITY OF THE SCREENING A SOLID FENCE MATERIAL. SEE SHEET C9 FOR DUMPSTER ENCLOSURE AND GATE DETAILS.
- 13. ALL EXTERIOR LIGHTING SHALL BE INSTALLED IN ACCORDANCE WITH THE APPROVED LIGHTING PLAN AND CUT SHEETS. THE LIGHTING SHALL ALSO BE INSTALLED AND AIMED TO MEET ALL REQUIREMENTS SET FORTH IN SECTION 36.2 DIVISION 2 OUTDOOR LIGHTING.
- 14. NO OUTDOOR STORAGE IS PROPOSED AS PART OF THIS PROJECT AT THIS

UTILITY NOTES:

- . G.C. SHALL COORDINATE THE EXACT SANITARY SEWER, WATER, AND STORM SEWER BUILDING TIE-IN LOCATIONS WITH THE ARCHITECTURAL PLANS
- 2. ALL UTILITY SERVICE LATERALS OR LINES, INCLUDING ELECTRIC, SHALL BE INSTALLED UNDERGROUND PER SECTION 36.2-610. WATER & SEWER CONNNECTIONS SHALL CONFORM TO WVWA UTILITY STANDARDS AND INTERNATIONAL BUILDING CODE.
- 3. G.C. SHALL VERIFY THE EXACT DEPTH OF THE EXISTING S.S. LATERAL VERTICAL ELEVATION PRIOR TO ANY BUILDING, SANITARY, OR STORM CONSTRUCTION.
- 4. THE G.C. SHALL COORDINATE TEMPORARY POWER FOR THE PROPOSED BUILDINGS.
- 5. THE G.C. IS RESPONSIBLE FOR PROVIDING AND INSTALLING ALL CONDUIT ASSOCIATED WITH REQUIRED UTILITIES FOR THE PROPOSED BUILDING AND ANY NECESSARY UTILITIES ON-SITE SUCH AS LIGHTING, ELECTRICAL, ETC.

SITE CONSTRUCTION - GENERAL NOTES

ALL MATERIALS AND CONSTRUCTION WITHIN THE PUBLIC RIGHT-OF-WAY SHALL BE IN ACCORDANCE WITH CURRENT CITY OF ROANOKE STANDARDS AND SPECIFICATIONS.

A RIGHT-OF-WAY EXCAVATION PERMIT MUST BE OBTAINED FROM THE CITY OF ROANOKE PRIOR TO BEGINNING ANY CONSTRUCTION WITHIN THE EXISTING CITY MAINTAINED RIGHT-OF-WAY (INCLUDING ACCESS).

THE CONTRACTOR SHALL VERIFY THE ELEVATIONS OF ALL POINTS OF CONNECTION OR PROPOSED WORK TO EXISTING CURBS, SANITARY LINES, WATER LINES, ETC., PRIOR TO CONSTRUCTION. CONTACT THE CONSULTING ENGINEER IF ANY DISCREPANCIES ARE

UPON THE DISCOVERY OF SOILS THAT ARE UNSUITABLE FOR FOUNDATIONS. SUBGRADES, OR OTHER ROADWAY CONSTRUCTION PURPOSES, THE CONTRACTOR SHALL IMMEDIATELY CONTACT A GEOTECHNICAL ENGINEER AND/OR THE CITY OF ROANOKE. THESE AREAS SHALL BE EXCAVATED BELOW PLAN GRADE AS DIRECTED BY THE GEOTECHNICAL ENGINEER, BACKFILLED WITH SUITABLE MATERIAL AND COMPACTED IN ACCORDANCE WITH CURRENT VDOT SPECIFICATIONS.

ALL STORM SEWER DESIGN AND CONSTRUCTION TO BE IN ACCORDANCE WITH CITY OF ROANOKE AND VDOT STANDARDS AND SPECIFICATIONS.

ALL ENTRANCES ARE TO BE DESIGNED AND CONSTRUCTED IN ACCORDANCE WITH CURRENT CITY OF ROANOKE STANDARDS.

CONTRACTOR SHALL VERIFY LOCATION AND ELEVATION OF ALL UNDERGROUND UTILITIES SHOWN ON PLANS IN AREAS OF CONSTRUCTION PRIOR TO STARTING WORK. CONTACT ENGINEER IMMEDIATELY IF LOCATION OR ELEVATION IS DIFFERENT FROM THAT SHOWN ON PLAN. IF THERE APPEARS TO BE A CONFLICT, AND/OR UPON DISCOVERY OF ANY UTILITY SHOWN ON THIS PLAN, CALL MISS UTILITY OF CENTRAL VIRGINIA AT 1-800-552-7001. THE DEVELOPER SHALL BE RESPONSIBLE FOR THE RELOCATION OF ANY UTILITY WITHIN EXISTING AND/OR PROPOSED RIGHT-OF-WAY REQUIRED BY THE DEVELOPMENT.

CASING SLEEVES OR CONDUIT MAY BE PROVIDED AS REQUIRED FOR THE LIGHT

THE INSTALLATION OF SANITARY SEWER, STORM SEWER, WATERLINES, AND GAS MAINS (INCLUDING SERVICE LATERALS AND/OR SLEEVES) AND OTHER UNDERGROUND UTILITIES SHALL BE COMPLETED PRIOR TO PLACEMENT OF AGGREGATE BASE COURSE.

A PRIME COAT SEAL BETWEEN THE AGGREGATE BASE AND BITUMINOUS CONCRETE WILL BE REQUIRED AT A RATE OF 0.30 GALLONS PER SQUARE YARD (REC-250 PRIME COAT) PER VDOT STANDARDS AND SPECIFICATIONS.


THE SCHEDULING OF AGGREGATE BASE INSTALLATION AND SUBSEQUENT PAVING ACTIVITIES SHALL ACCOMMODATE FORECAST WEATHER CONDITIONS PER SECTION 315 OF THE VDOT ROAD AND BRIDGE SPECIFICATIONS (LATEST EDITION).


ALL VEGETATION AND ORGANIC MATERIAL IS TO BE REMOVED FROM THE RIGHT-OF-WAY LIMITS PRIOR TO CONDITIONING OF THE SUBGRADE.

G.C. SHALL SUBMIT A TRAFFIC CONTROL PLAN TO THE CITY OF ROANOKE PRIOR TO ANY CONSTRUCTION WITHIN THE RIGHT-OF-WAY.

EXISTING FIRE HYDRANT FLOW DATA:

- 1. WILLIAMSON ROAD N.W. & OAKLAWN AVENUE N.W.
 - AUTHORITY ID 12855
 - 76 PSI STATIC 64 PSI RESIDUAL
 - 1,138 GPM 2,578 GPM @ 20 PSI
- 2. WILLIAMSON ROAD N.W. & MAPLELAWN AVENUE N.W.
 - AUTHORITY ID 12878 74 PSI STATIC
 - 50 PSI RESIDUAL
 - 1,113 GPM 1,725 GPM @ 20PSI
- 3. A KNOX BOX WILL NOT BE PROVIDED FOR THE BUILDING.

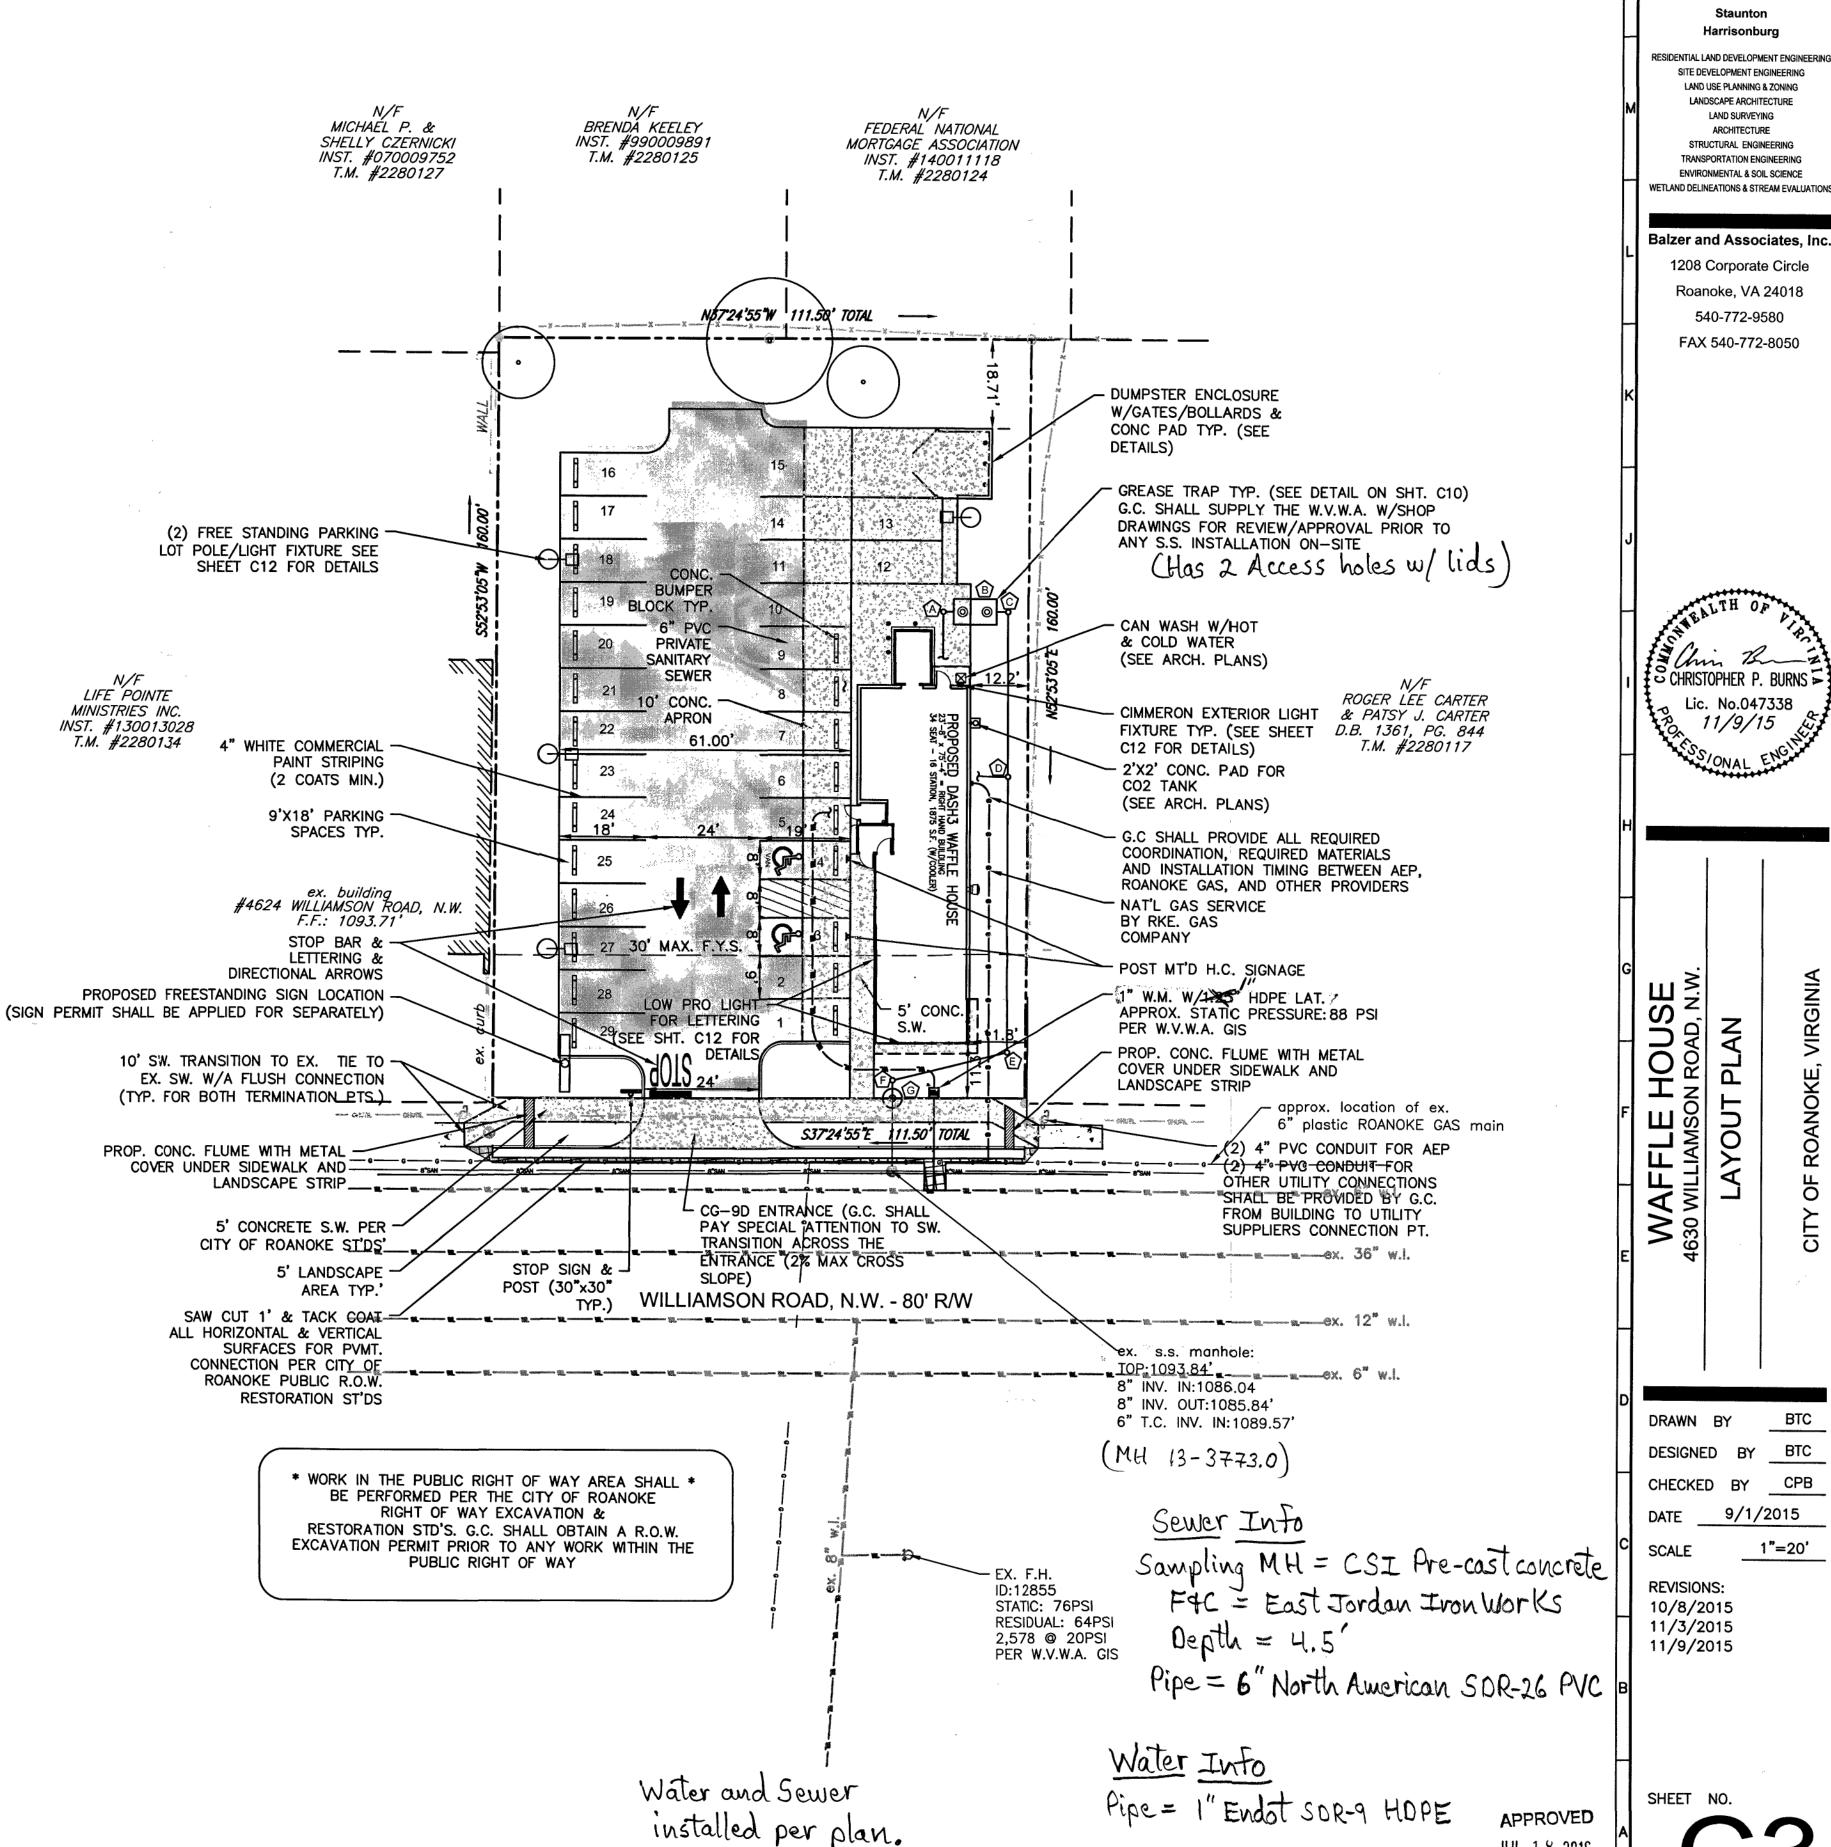

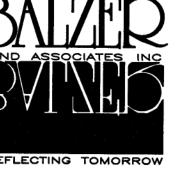

www.balzer.cc

New River Valley Richmond Staunton Harrisonburg

RESIDENTIAL LAND DEVELOPMENT ENGINEERIN SITE DEVELOPMENT ENGINEERING LAND USE PLANNING & ZONING LANDSCAPE ARCHITECTURE LAND SURVEYING ARCHITECTURE STRUCTURAL ENGINEERING TRANSPORTATION ENGINEERING ENVIRONMENTAL & SOIL SCIENCE

Balzer and Associates, Inc.

1208 Corporate Circle Roanoke, VA 24018

540-772-9580 FAX 540-772-8050

13 Chin Bran CHRISTOPHER P. BURNS Lic. No.047338 11/9/15

AYOUT

DRAWN BY

DESIGNED BY BTC CHECKED BY CPB 9/1/2015 DATE

1"=20' SCALE **REVISIONS:**

10/8/2015 11/3/2015 11/9/2015

SHEET NO.

JOB NO. 04150016.00

As-Builts 2.1.17 Substantial Completion

K. Winslow

JUL 18 2016

SCALE: 1" = 20'