


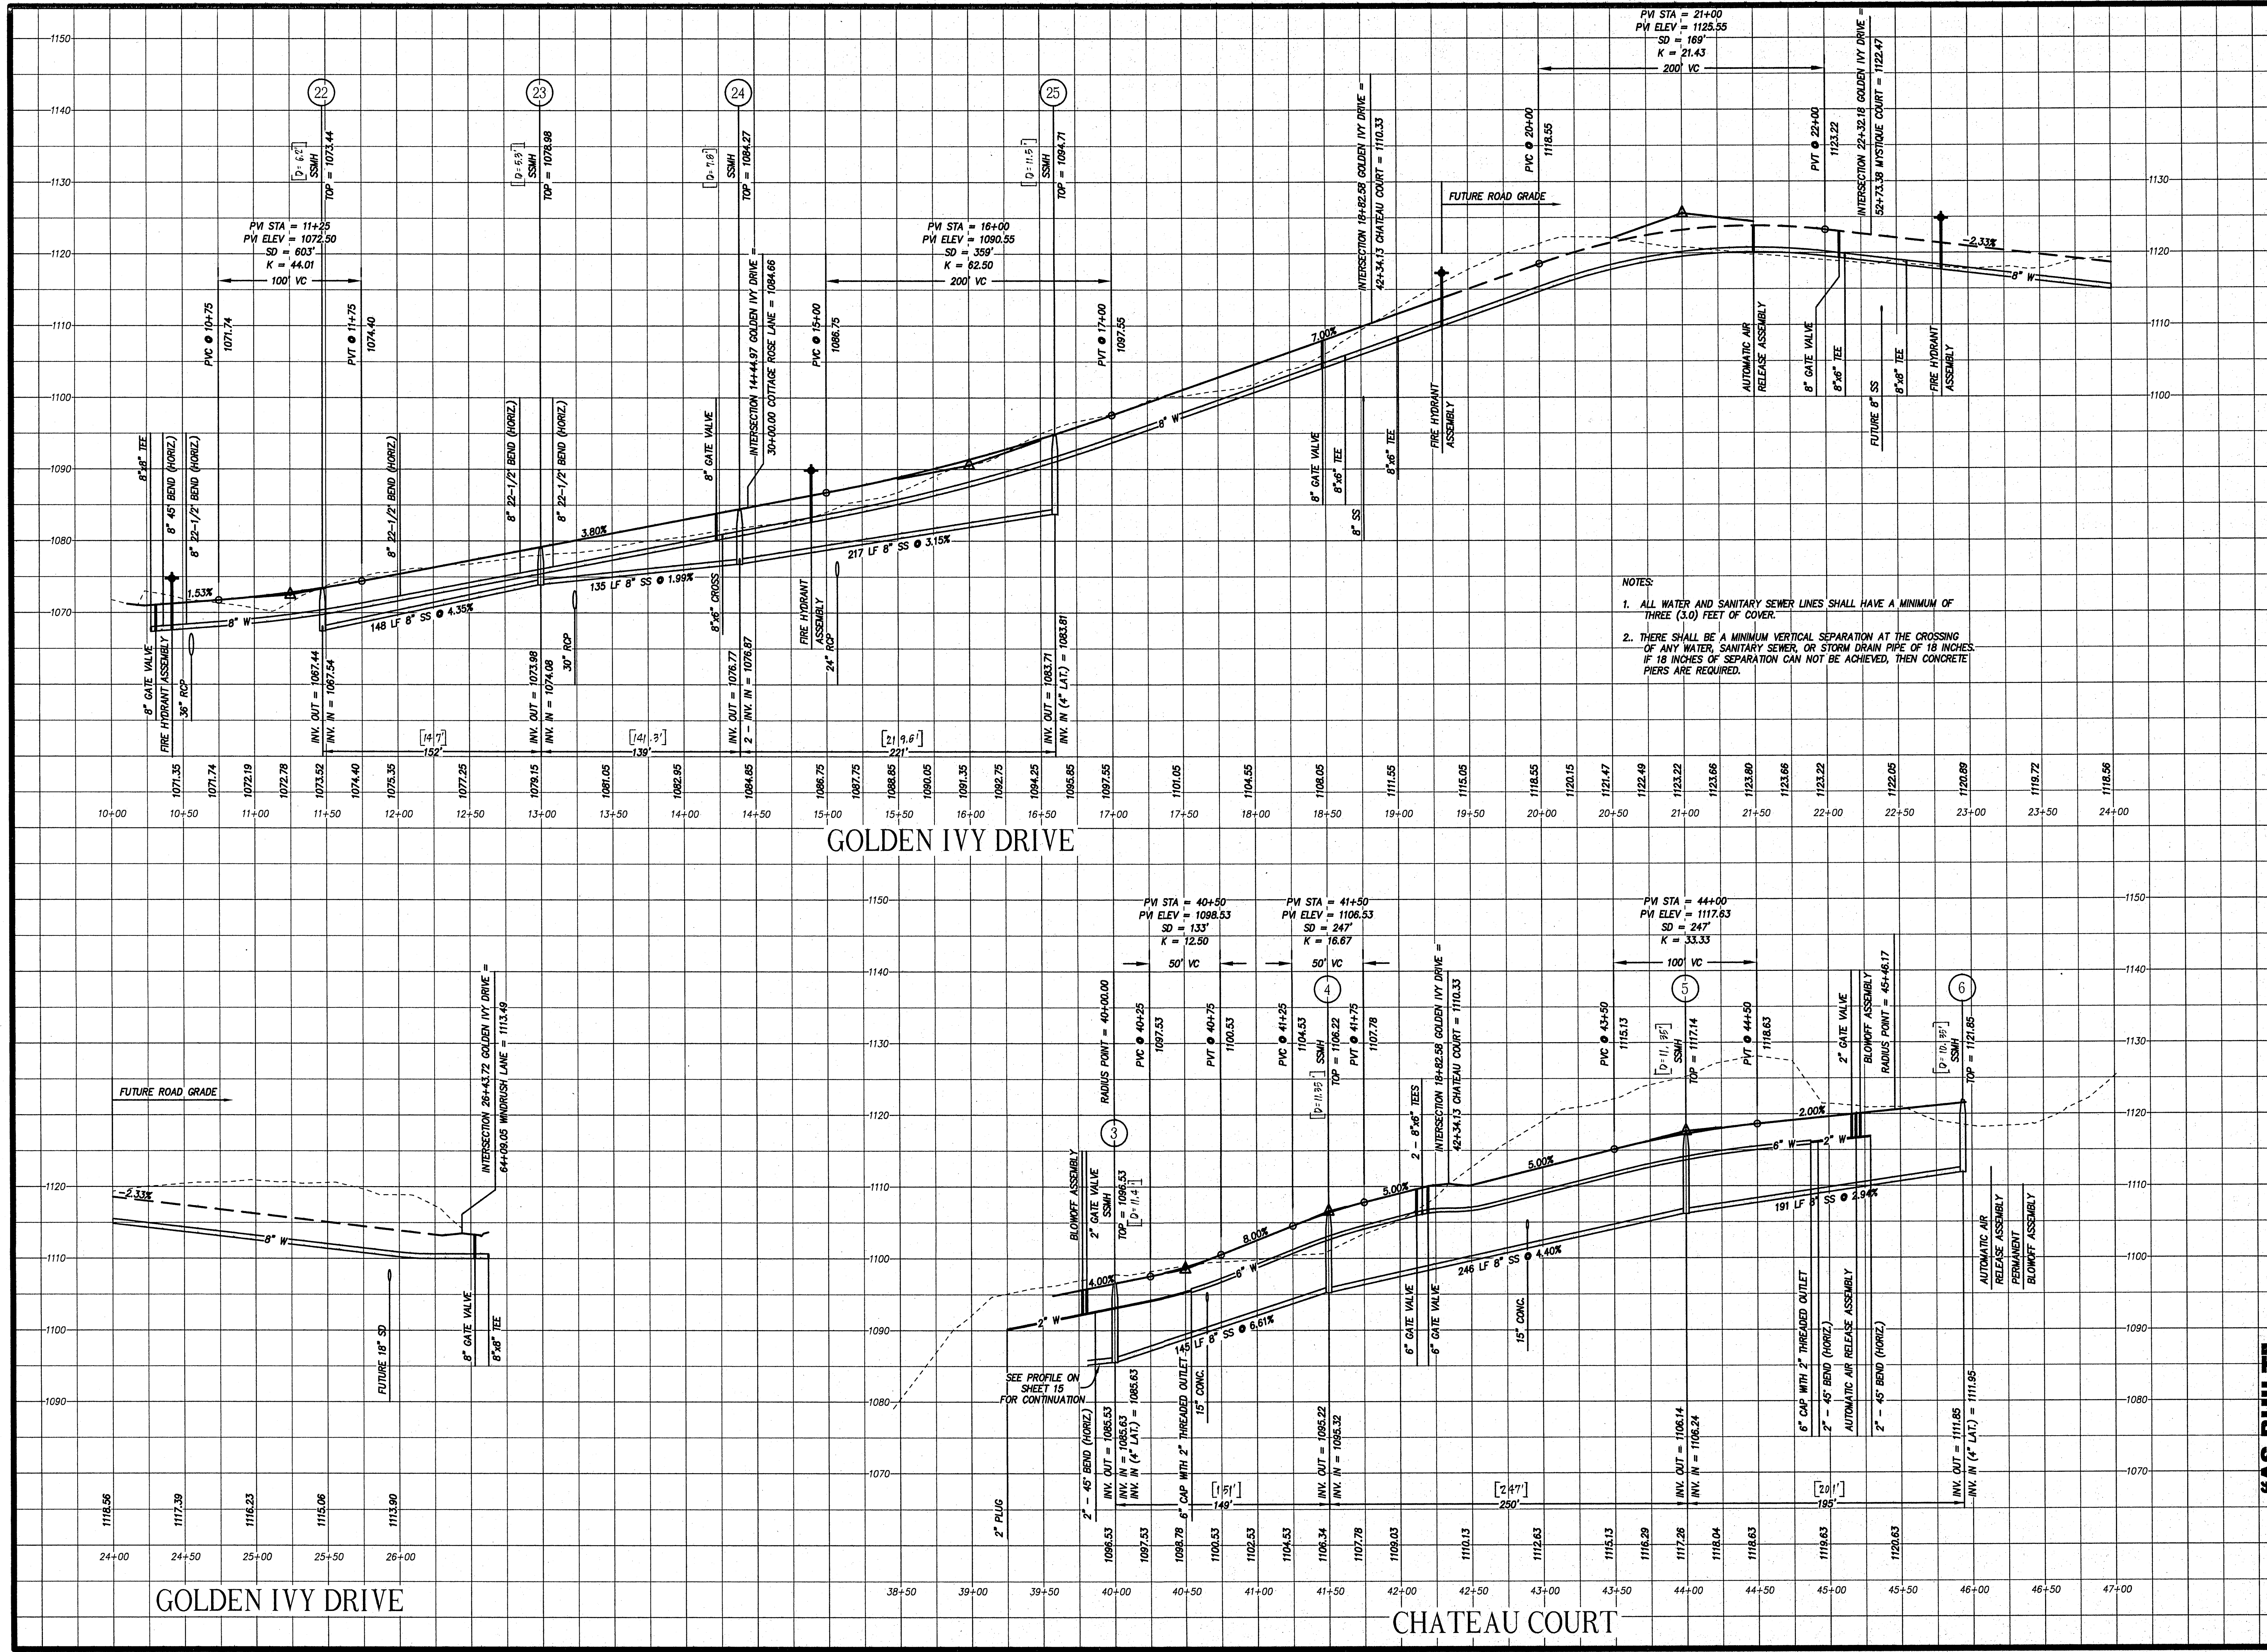

LUMSDEN ASSOCIATES, P.C.
ENGINEERS-SURVEYORS-PLANNERS
ROANOKE, VIRGINIA

4664 BRAMBLETON AVENUE
P.O. BOX 20669
ROANOKE, VIRGINIA 24018

PHONE: (540) 774-4411
FAX: (540) 772-9445
E-MAIL: MAIL@LUMSDENPC.COM

COMMONWEALTH OF VIRGINIA
No. 033002
2/9/04
THOMAS C. DALE
PROFESSIONAL ENGINEER

SECTION No. 1
WEDGWOOD
PREPARED FOR
STRAUSS DEVELOPMENT CORPORATION
HOLLINS MAGISTERIAL DISTRICT
ROANOKE COUNTY, VIRGINIA

ROAD PROFILES
SECTION Nos. 1 AND
FUTURE SECTION No. 2

"AS-BUILT"

NO.	DATE	DESCRIPTION
1	9/1/04	"AS-BUILT" SANITARY SEWER
2		
3		
4		
5		

DATE: FEBRUARY 9, 2004
SCALE: (H) 1"=50', (V) 1"=10'
COMMISSION NO.: 2002-389
CADD FILE: P:\005\02389\ENG\389COMP.DWG
SHEET 10 OF 16