

# QUANTITY & COST ESTIMATE

| ITEM                                                                                                 | QUANTITY                        | UNIT     | UNIT PRICE | COST       | BONDABLE |
|------------------------------------------------------------------------------------------------------|---------------------------------|----------|------------|------------|----------|
| CLEARING AND GRUBBING                                                                                | 5.0                             | ACRES    | 1500.00    | 7,500.00   |          |
| EXCAVATION                                                                                           | 617.0                           | C.Y.     | 3.00       | 18,519.00  |          |
| EMBANKMENT                                                                                           | 0                               | C.Y.     |            |            |          |
| CURB INLET @ 30                                                                                      | 2                               | EACH     | 750.00     | 1,500.00   |          |
| CURB INLET @ 30                                                                                      | 2                               | EACH     | 750.00     | 1,500.00   |          |
| MANHOLE NM 1                                                                                         |                                 | EACH     | 750.00     | 4,500.00   |          |
| MANHOLE NM                                                                                           | 6                               | EACH     |            |            |          |
| 15-IN. CONCRETE PIPE                                                                                 | 496                             | LN. FT.  | 12.50      | 6,200.00   |          |
| 15-IN. CONCRETE PIPE, CLASS III                                                                      | 172                             | LN. FT.  | 19.00      | 3,268.00   |          |
| 15-IN. CONCRETE PIPE, CLASS IV                                                                       |                                 | LN. FT.  |            |            |          |
| 15-IN. C.M. CULVERT                                                                                  |                                 | LN. FT.  |            |            |          |
| 15-IN. C.M. CULVERT                                                                                  |                                 | LN. FT.  |            |            |          |
| BOX CULVERT                                                                                          |                                 | LUMP SUM |            |            |          |
| PAVED DITCH                                                                                          |                                 | LN. FT.  |            |            |          |
| RIPRAP - CLASS                                                                                       |                                 | S.F.     |            |            |          |
| SOODED SWALE                                                                                         |                                 | S.F.     |            |            |          |
| 15-IN. CONCRETE ENDWALL EW                                                                           |                                 | EACH     |            |            |          |
| 15-IN. END SECTION ES                                                                                |                                 | EACH     |            |            |          |
| DRIVEWAY, ENTRANCE TYPE CG-10A                                                                       | 22                              | EACH     | 129.00     | 2,967.00   |          |
| HEADER CURB & GUTTER CG                                                                              |                                 | LN. FT.  |            |            |          |
| CURB & GUTTER CG G                                                                                   | 2200                            | LN. FT.  | 8.25       | 18,150.00  |          |
| VALLEY GUTTER                                                                                        |                                 | EACH     |            |            |          |
| GRAVEL BASE                                                                                          |                                 | S.F.     |            |            |          |
| GRAVEL SHOULDER                                                                                      |                                 | S.F.     |            |            |          |
| SURFACE TREATMENT                                                                                    |                                 | S.F.     |            |            |          |
| 15-IN. BIT. CONC. TYPE B-                                                                            |                                 | S.F.     |            |            |          |
| 2-IN. BIT. CONC. TYPE SM-2A                                                                          | 4750                            | S.F.     | 4.25       | 20,187.50  |          |
| 6-IN. BASE MATERIAL 21A                                                                              | 4750                            | C.Y.     | 4.25       | 20,187.50  |          |
| 15-IN. SUBBASE MATERIAL                                                                              |                                 | C.Y.     |            |            |          |
| TRAFFIC BARRICADE                                                                                    |                                 | EACH     |            |            |          |
| 8" WATER LINE                                                                                        | 1570                            | LN. FT.  | 13.00      | 20,410.00  |          |
| FIRE HYDRANT ASSEMBLIES                                                                              | 1                               | EACH     | 1000.00    | 1000.00    |          |
| BLDW OFFS W/VAULT, FRAME & COVER                                                                     |                                 | EACH     |            |            |          |
| 15-IN. GATE VALVES W/VAULT, FRAME & COVER                                                            |                                 | EACH     |            |            |          |
| 15-IN. GATE VALVES W/VAULT, FRAME & COVER                                                            |                                 | EACH     |            |            |          |
| STANDARD MANHOLE W/FRAME & COVER                                                                     |                                 | EACH     |            |            |          |
| SAMPLING MANHOLE/PORT                                                                                |                                 | EACH     |            |            |          |
| AS-BUILT PLANS                                                                                       | 1                               | LUMP SUM | 1200.00    | 1200.00    |          |
|                                                                                                      | 1                               | LUMP SUM | 8000.00    | 5000.00    |          |
| STORMWATER MANAGEMENT                                                                                | BONDED AND APPROVED WITH P.H.I. |          |            |            |          |
| SUB-TOTAL                                                                                            |                                 |          |            | 192,089.00 |          |
| 10% CONTINGENCY                                                                                      |                                 |          |            | 19,208.90  |          |
| ESTIMATED TOTAL                                                                                      |                                 |          |            | 145,297.90 |          |
| I HEREBY CERTIFY THAT THE FOREGOING ESTIMATE REFLECTS THE CURRENT IMPROVEMENT COSTS OF THIS PROJECT. |                                 |          |            |            |          |
| SIGNED: <i>Jackell...</i> DATE: 12-18-94                                                             |                                 |          |            |            |          |

## GENERAL NOTES

All construction methods and materials shall conform to the Construction Standards and Specifications of Roanoke County and/or the Virginia Department of Transportation.

The contractor or developer is required to notify the Roanoke County Engineering Division in writing at least three (3) days prior to any construction, including, but not limited to the following:

- Installation of approved erosion control devices
- Cleaning and grubbing
- Subgrade excavation
- Installing storm sewers or culverts
- Setting curb and gutter forms
- Placing curb and gutter
- Placing other concrete
- Placing gravel base
- Placing any roadway surface
- Installing water lines
- Installing sanitary sewer lines

A pre-construction conference should be scheduled with the Roanoke County Engineering Division to be held at least one (1) day prior to any construction.

Measures to control erosion and siltation must be provided prior to plan approval. Plan approval in no way relieves the developer or contractor of the responsibilities contained within the erosion and siltation control policies.

A permit must be obtained from the V.D.O.T. Residency Office, Roanoke County, prior to construction in the highway right-of-way.

Plan approval does not guarantee issuance of any permits by V.D.O.T.

An approved set of plans and all permits must be available at the construction site.

Field construction shall honor proposed drainage divides as shown on plans.

All unsuitable material shall be removed from the construction limits of the roadway before placing embankment.

Pavement sections on approved plans are based on a minimum CBR of 10. CBR tests are to be performed by the contractor and submitted to V.D.O.T. and to the Roanoke County Engineering Division prior to placement. CBR values < 10 will require revised pavement sections.

All roadside ditches or grades of more than 5 percent shall be paved with cement concrete to the limits as indicated on the plans and as required at the field inspection.

Location of guard rails shall be determined at a joint field inspection by the County and V.D.O.T.

All springs shall be capped and piped to the nearest storm sewer or natural watercourse. The pipe shall be 6 inch minimum diameter and conform to V.D.O.T. Standard SB-1.

Standard street and traffic control signs shall be erected at each intersection by the developer prior to final street acceptance.

Construction debris shall be containerized in accordance with the Virginia Litter Control Act. No less than one litter receptacle shall be provided on site.

The contractor shall provide adequate means of cleaning mud from trucks and/or other equipment prior to entering public streets. It is the contractor's responsibility to insure that the streets are in a clean, mud and dust free condition at all times.

The developer and/or contractor shall supply all utility companies with copies of approved plans, advising them that all grading and installation shall conform to approved plans.

Contractors shall notify utilities of proposed construction at least two (2) but not more than ten (10) working days in advance. All public utilities may be notified that "Miss Utility" has been called.

The developer or contractor shall supply the county with correct As-Built plans before final acceptance.

All work shall be subject to inspection by Roanoke County and/or V.D.O.T. inspectors.

Field corrections shall be approved by the Roanoke County Engineering Division prior to such construction.

100 year floodway and floodplain information shall be shown where applicable.

Grade stakes shall be set for all curb and gutter, culvert, sanitary sewer and storm sewer.

## INDEX

- SHEET 1 COVER SHEET
- SHEET 2 OVERVIEW & ESC. PLAN
- SHEET 3 PLAN & PROFILE HONEYWOOD CIRCLE
- SHEET 4 PLAN & PROFILE MIDSUMMER LANE
- SHEET 5 STORMWATER MANAGEMENT PLAN DETAILS
- SHEET 6 WATER DETAILS
- SHEET 7 EROSION & SEDIMENT CONTROL DETAILS
- SHEET 8 PRELIMINARY PLAN

THE EXISTING UNDERGROUND UTILITIES SHOWN HEREON ARE BASED ON AVAILABLE INFORMATION. UTILITIES MAY EXIST WITHIN THE CONSTRUCTION AREA OF THESE PLANS THAT ARE NOT SHOWN. THE CONTRACTOR SHALL BE RESPONSIBLE FOR DETERMINING THE EXACT LOCATION AND DEPTH OF ALL UTILITIES BEFORE COMMENCING WORK, AND FOR ANY DAMAGES WHICH OCCUR BY HIS FAILURE TO LOCATE THESE UNDERGROUND UTILITIES. IF DURING CONSTRUCTION OPERATIONS THE CONTRACTOR SHOULD ENCOUNTER UTILITIES OTHER THAN THOSE SHOWN ON THESE PLANS, HE SHALL IMMEDIATELY NOTIFY THE ENGINEER AND TAKE NECESSARY AND PROPER STEPS TO PROTECT THE FACILITY AND ASSURE CONTINUANCE OF SERVICE. TO KNOW UTILITIES, CALL "MISS UTILITIES" AT 1-800-552-7001 (TOLL FREE) 48 HOURS BEFORE DIGGING.

ALL CONSTRUCTION SHALL CONFORM TO THE COUNTY OF ROANOKE AND VIRGINIA DEPARTMENT OF TRANSPORTATION STANDARDS AND SPECIFICATIONS.

## SEWER NOTES

A minimum cover of three (3) feet is required over proposed lines.

Contractor shall be responsible for locating and uncovering all manholes after paving. Manhole tops shall be adjusted to grade if necessary.

All existing utilities may not be shown or may not be shown in the exact location. The contractor shall comply with State Water Works Regulations, Section 12.05.03, where lines cross.

House connections are to be made with 4" pipe installed at a minimum grade of 1/4 inch to 1 foot in R/W.

Laterals from manholes shall be PVC or Ductile Iron of sufficient length to provide two (2) feet of bearing on natural ground. The transition from ductile iron to asbestos cement or concrete pipe shall be made with an adapter coupling in R/W.

All trenches in existing or future rights-of-way shall be compacted according to V.D.O.T. standards.

Lines shall be staked prior to construction.

## WATER NOTES

A minimum cover of three (3) feet is required over proposed lines.

Contractor shall be responsible for locating and uncovering valve vaults after paving and adjustment to final grade if necessary.

All existing utilities may not be shown or may not be shown in the exact location. The contractor shall comply with the State Water Works Regulations, Section 12.05.03, where lines cross.

All trenches in existing or future highway rights-of-ways shall be compacted according to V.D.O.T. standards.


Lines shall be staked prior to construction.

Water main shall be minimum Class 52 Ductile Iron in accordance to AWWA C151 or DR-14 PVC in accordance with AWWA C-900.

Availability number: 99-209

## LEGEND

|                             |     |                           |
|-----------------------------|-----|---------------------------|
| Property Line               | --- | R---                      |
| Right-of-way                | --- | A/W---                    |
| Centerline                  | --- | C---                      |
| Minimum Building Line       | --- | M.B.L.---                 |
| Existing Storm Sewer        | --- | 18" S.D. --- 18" S.D. --- |
| Existing Sanitary Sewer     | --- | 8" SAN. --- 8" SAN. ---   |
| Existing Water Main         | --- | 4" W --- 4" W ---         |
| Existing Contour            | --- | 1845 --- 1845 ---         |
| Proposed Contour            | --- | 1845 --- 1845 ---         |
| Proposed Drainage Divide    | --- | 24" S.D. ---              |
| Proposed Limits of Clearing | --- | 24" S.D. ---              |
| Proposed Storm Sewer        | --- | 24" S.D. ---              |
| Proposed Sanitary Sewer     | --- | 8" SAN. ---               |
| Proposed Water Main         | --- | 4" W ---                  |

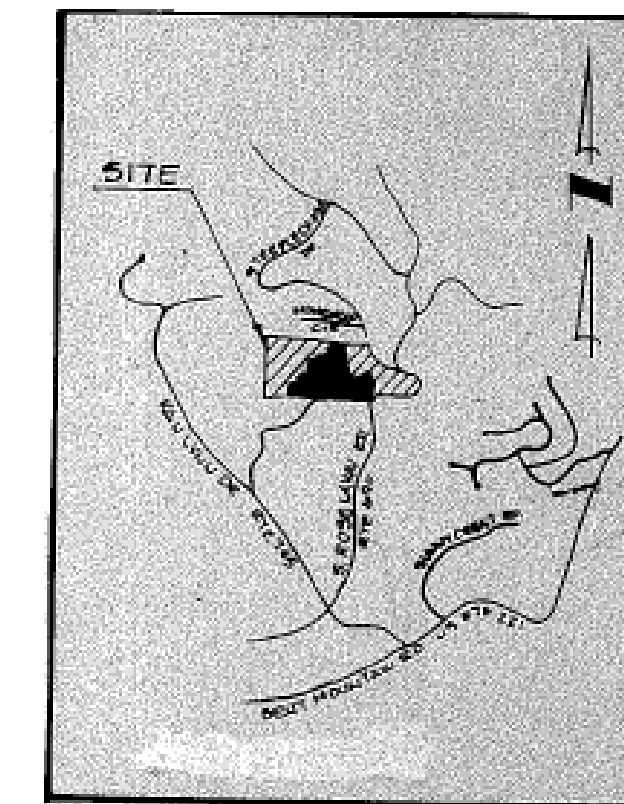

VICINITY MAP

## SURVEY INFORMATION

Horizontal and vertical control surveys were performed on or about 1994 by BALZER AND ASSOCIATES, INC.

All elevations must be referenced to the National Geodetic Vertical Datum of 1929.


Source of topographic mapping is BALZER AND ASSOCIATES, INC. dated JAN 1994.

Boundary was performed by BALZER AND ASSOCIATES, INC. dated JAN 1994.


The professional seal and signature below certifies the boundary survey and topographic mapping to be accurate and correct.

BENCHMARK: IRON PIPE WITH A YELLOW CAP 30.7' FROM 214 POLE # 224-2124 6.9' FROM EDGE OF PAVEMENT. ELEV. = 1918.86

AS-BUILT INFORMATION SHOWN IN BOXES. AS-BUILT INFORMATION FOR SUBSURFACE UTILITIES WAS NOT AVAILABLE.

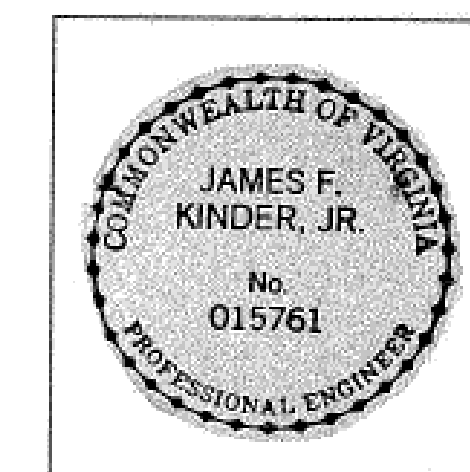

PROFESSIONAL ENGINEER SEAL AND SIGNATURE

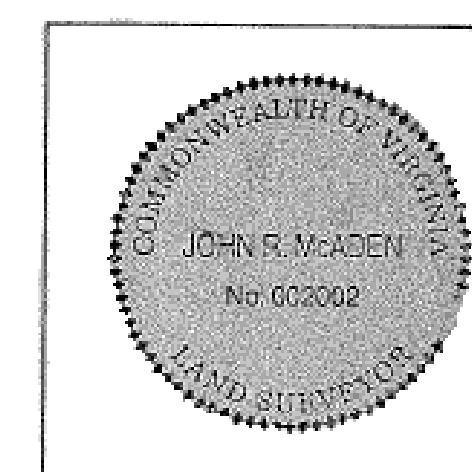

CERTIFIED LAND SURVEYOR SEAL AND SIGNATURE

# COUNTY OF ROANOKE

NAME OF DEVELOPMENT **WEXFORD SUBDIVISION, PHASE II (AS-BUILT)**

MAGISTERIAL DISTRICT(S) **WINDSOR HILLS**

OWNER (name, address, telephone) **JACKSON ASSOCIATES LTD. OF VIRGINIA  
P.O. BOX 217211  
ROANOKE, VA. 24018-0174 (703) 772-4600**

DEVELOPER (name, address, telephone) **SAME**

ENGINEER, ARCHITECT OR SURVEYOR (name, address, telephone) **BALZER AND ASSOCIATES, INC.  
1208 CORPORATE CIRCLE  
ROANOKE, VA. 24018 (703) 772-9580**

TAX MAP NO(S) **86.03**

BLOCK NO(S) **4**

PARCEL NO(S) **6**

I, J.P.L. OWNER/DEVELOPER, AM AWARE OF THE SITE DESIGN REQUIREMENTS IMPOSED BY THIS SITE DEVELOPMENT PLAN AND OTHER APPLICABLE COUNTY CODES. I HEREBY CERTIFY THAT I AGREE TO COMPLY WITH THESE REQUIREMENTS UNLESS MODIFIED IN ACCORDANCE WITH LOCAL LAW.

12-21-94 REV. PER AGENCIES  
11-3-95 FIELD REV. PER OWNER  
12-11-95 AS-BUILT