
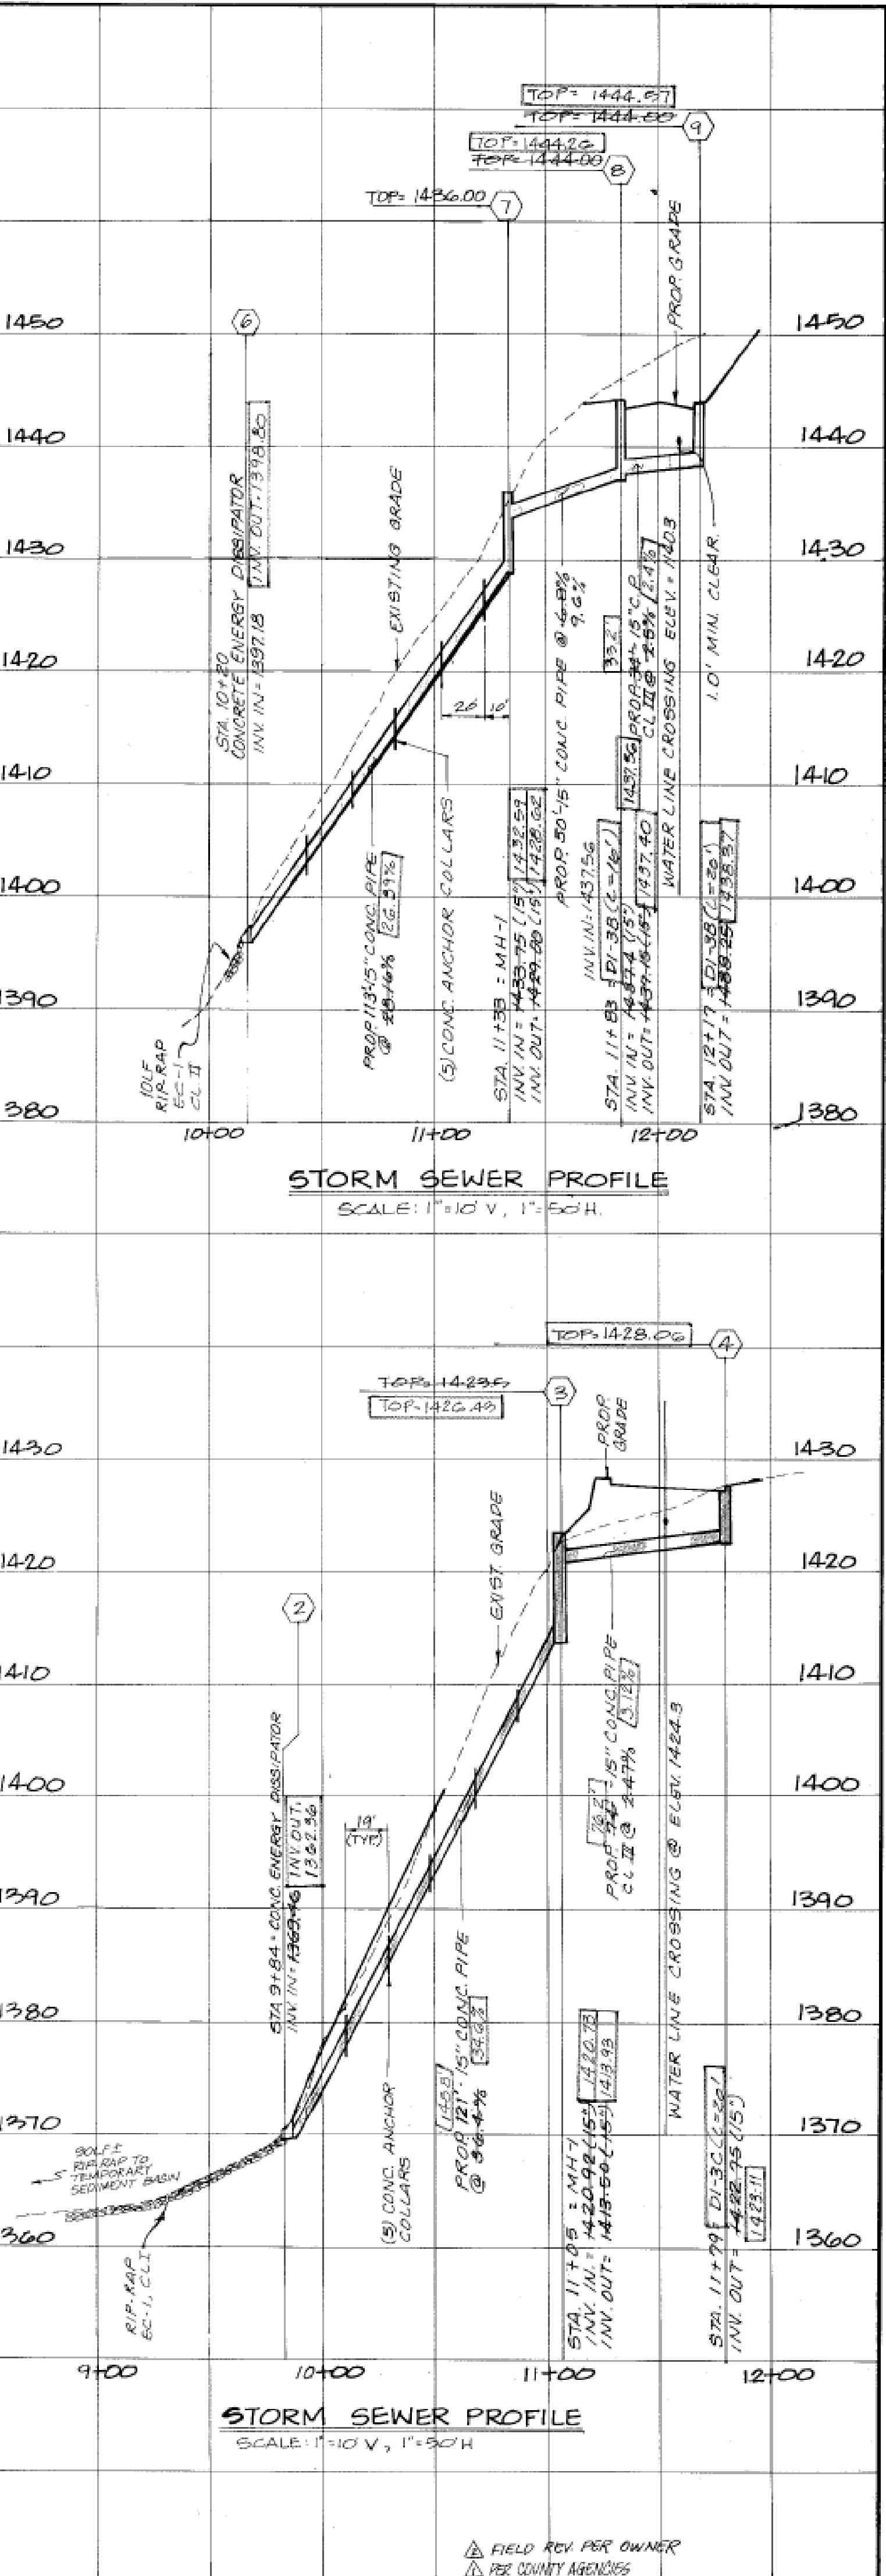
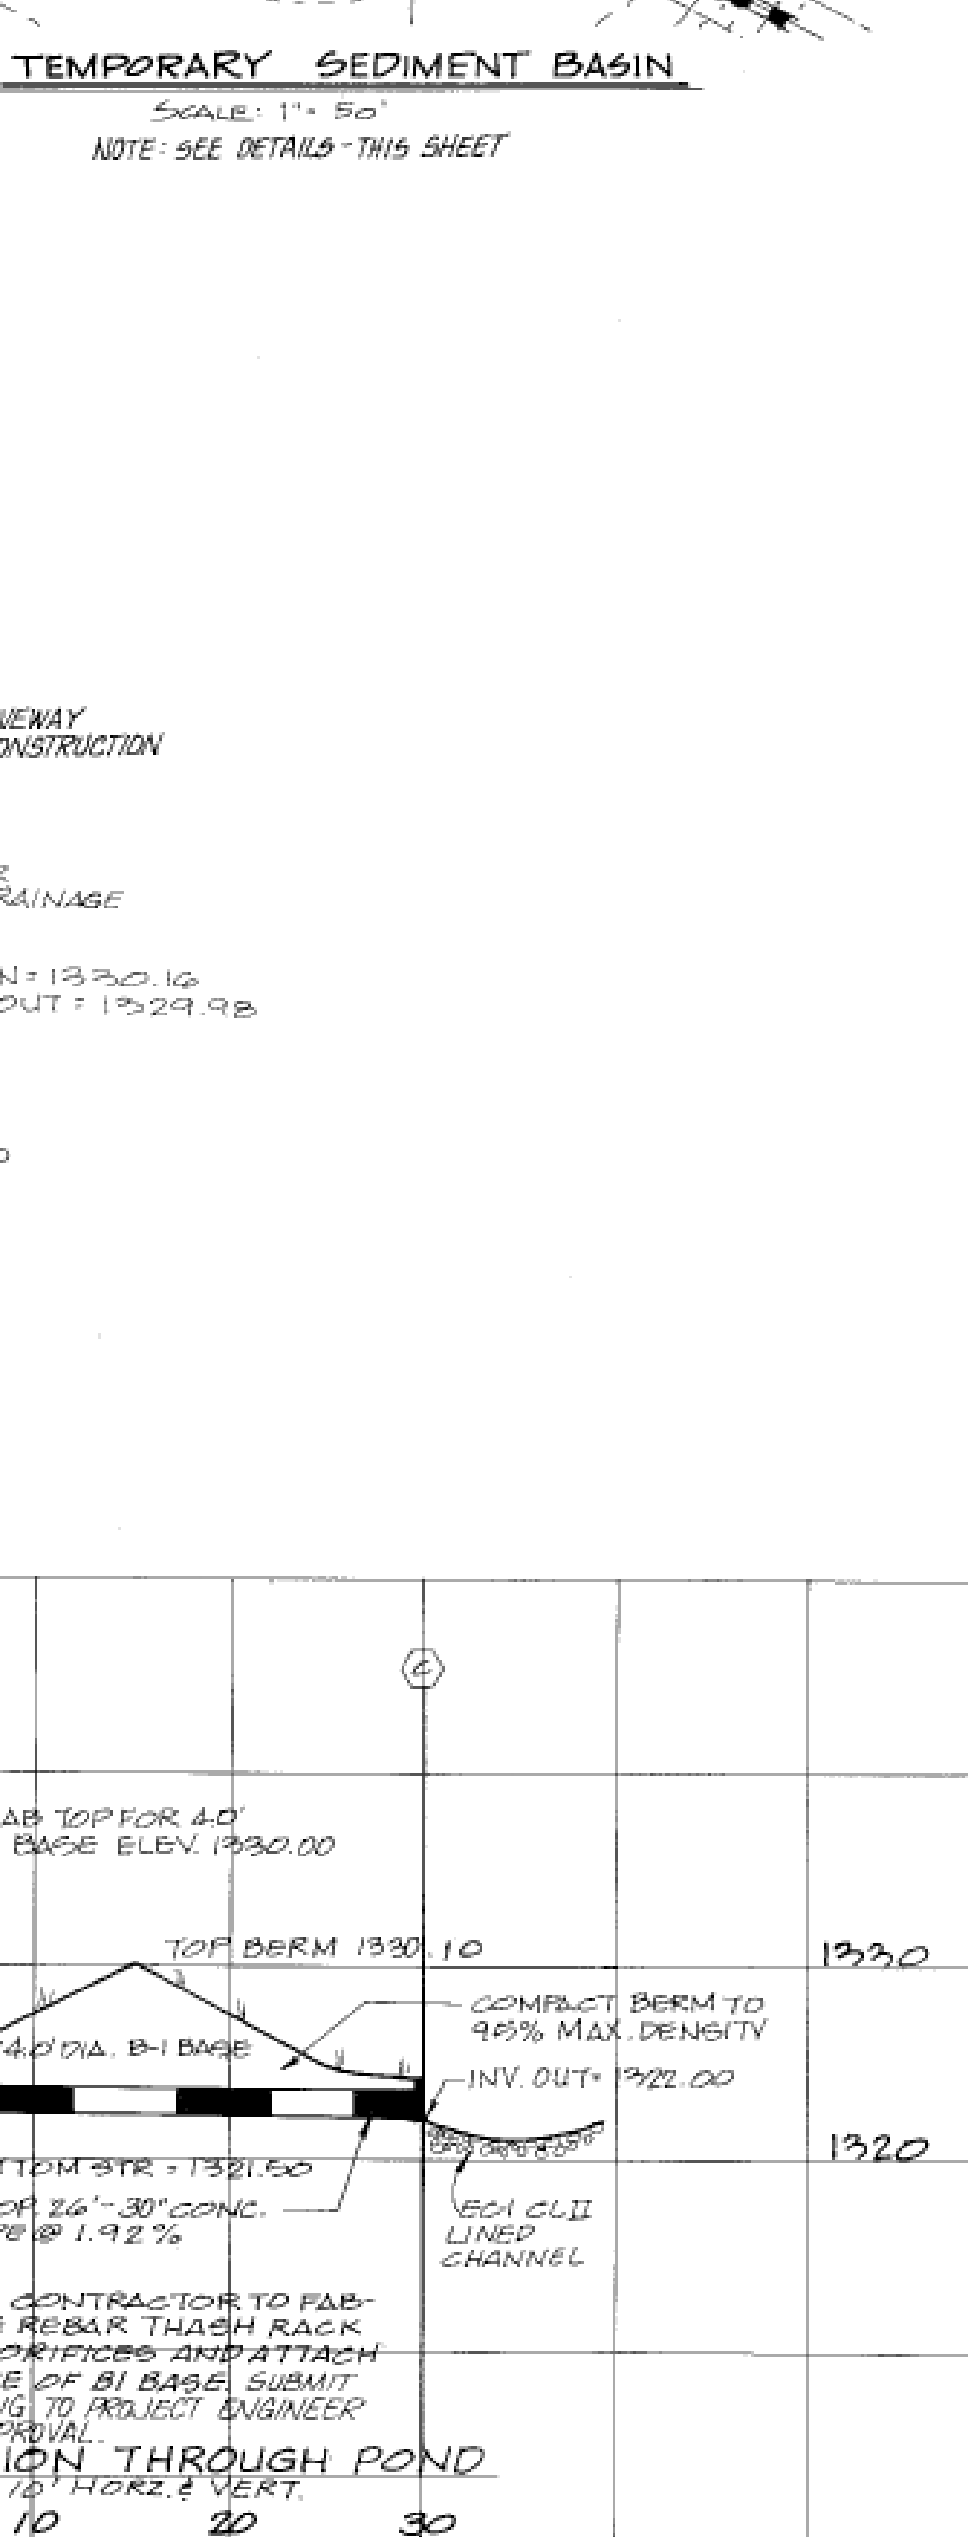
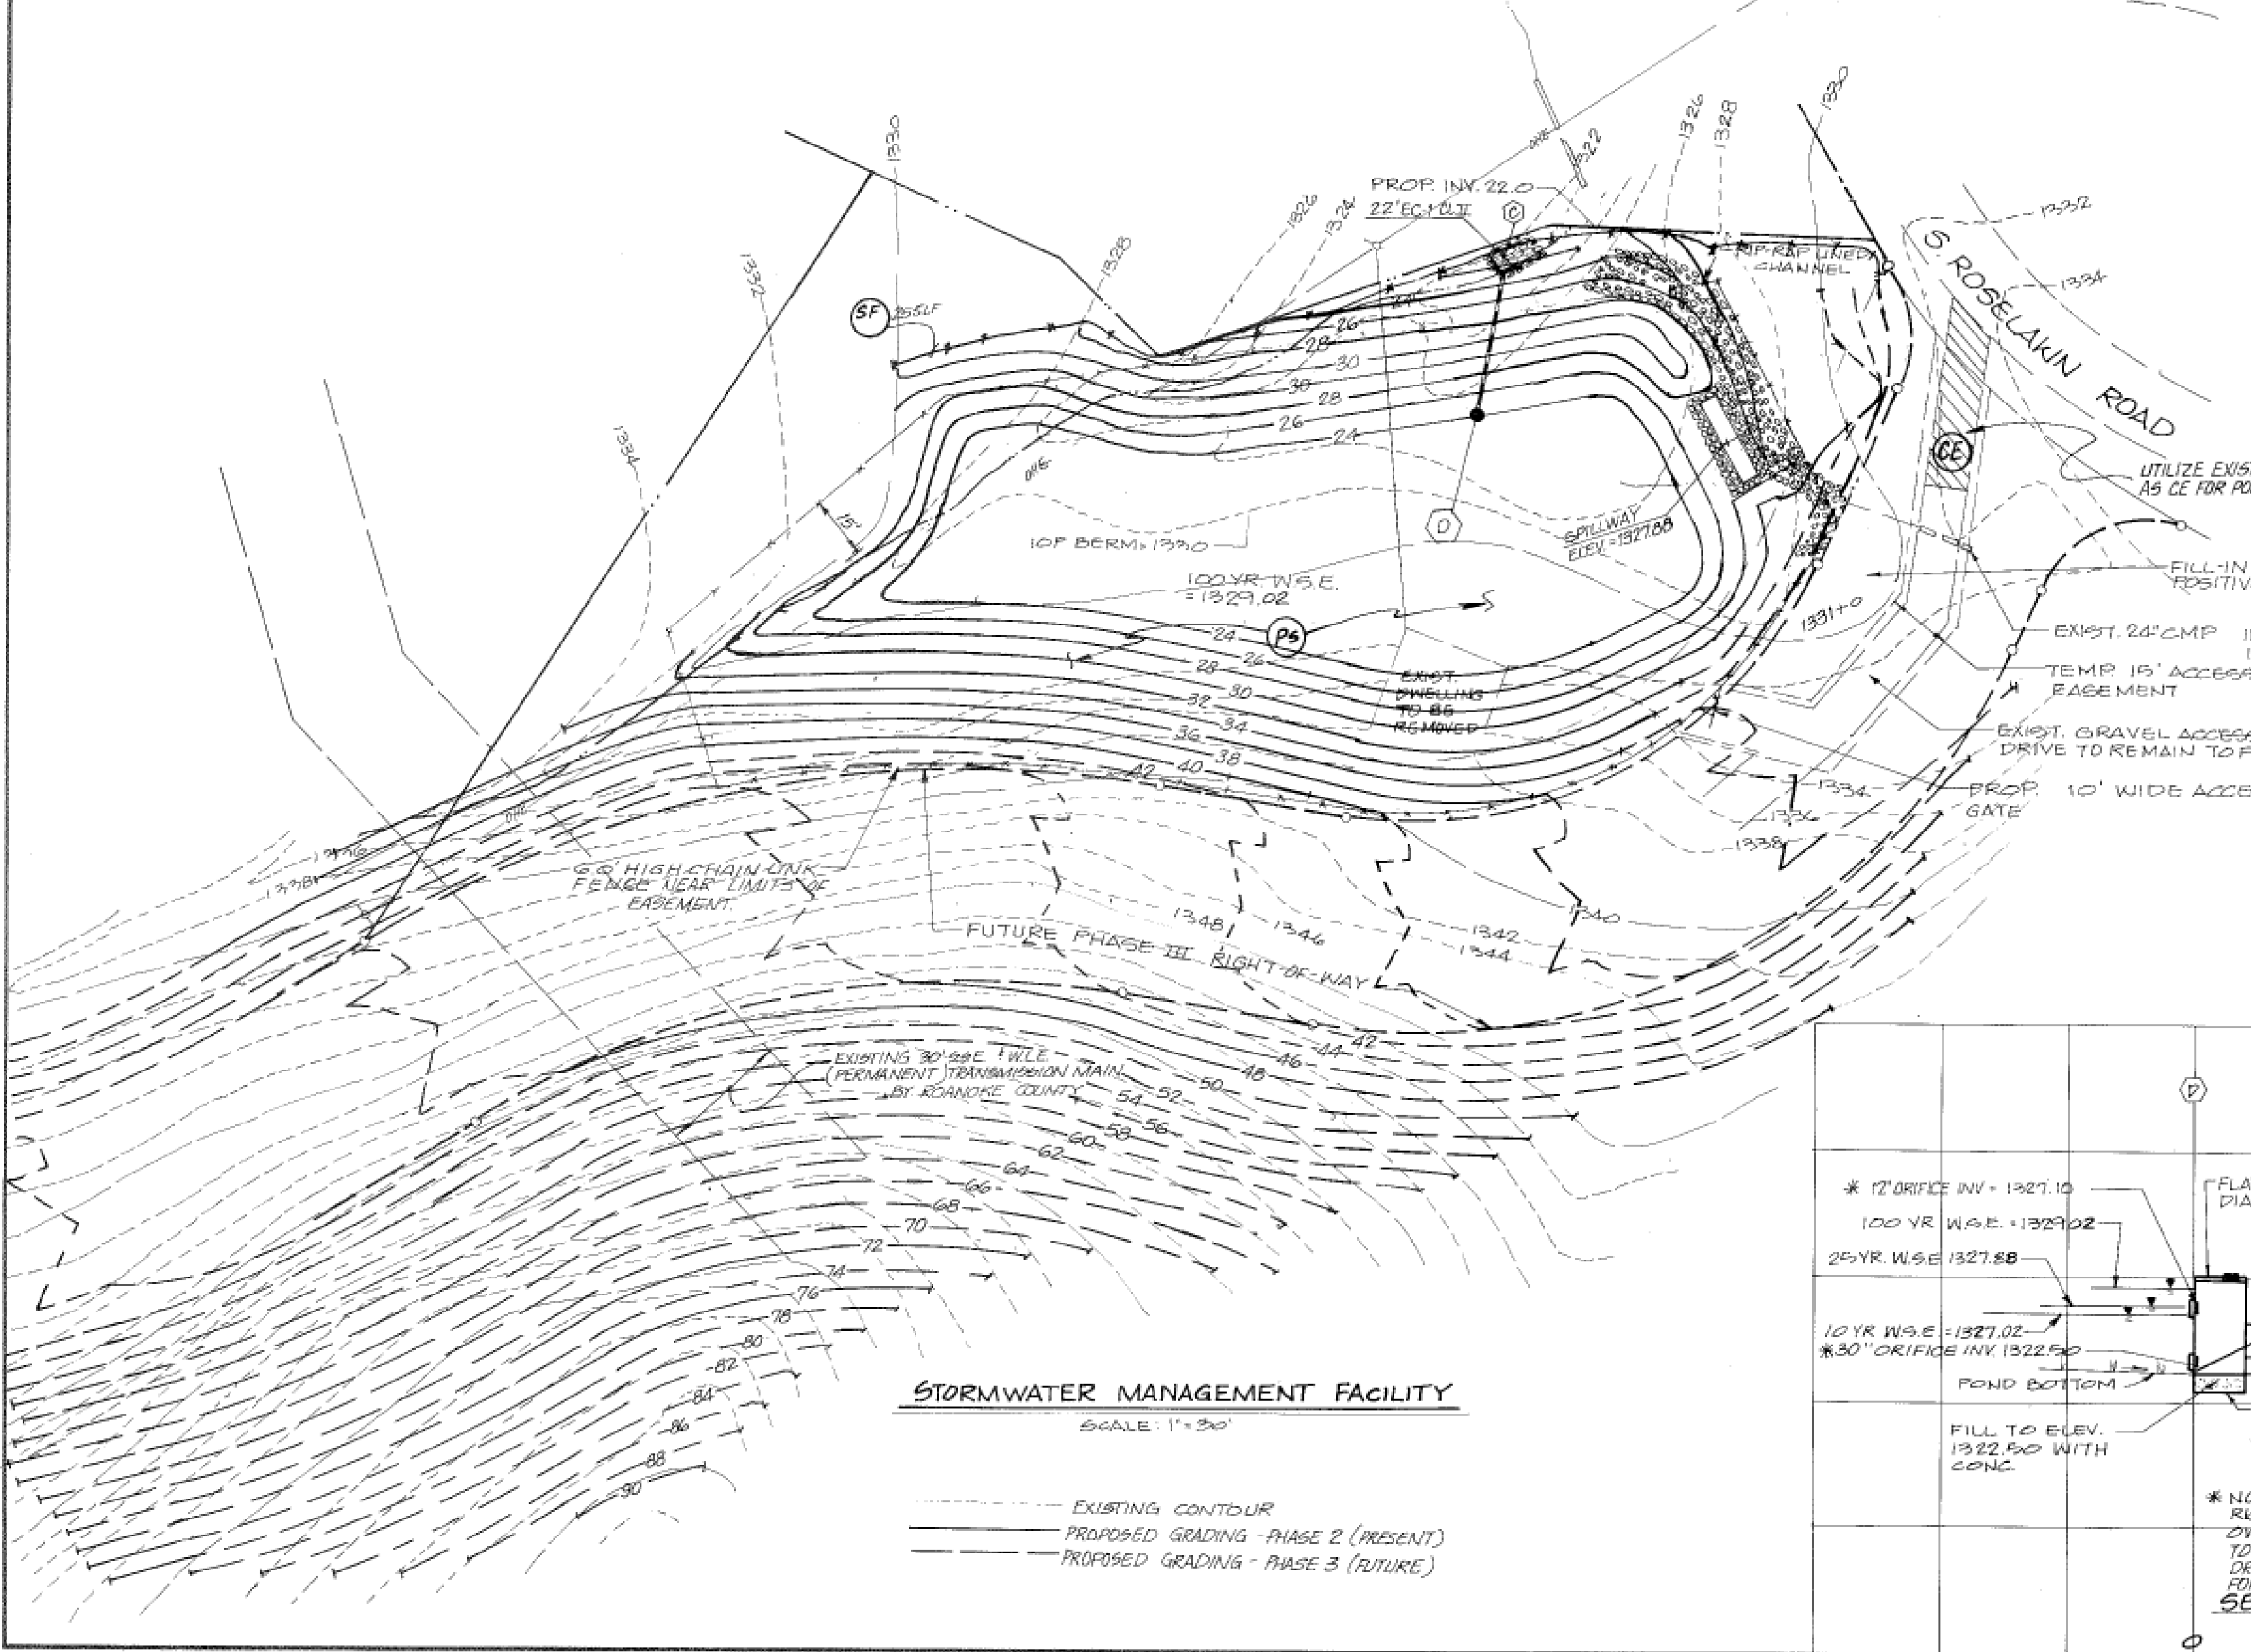
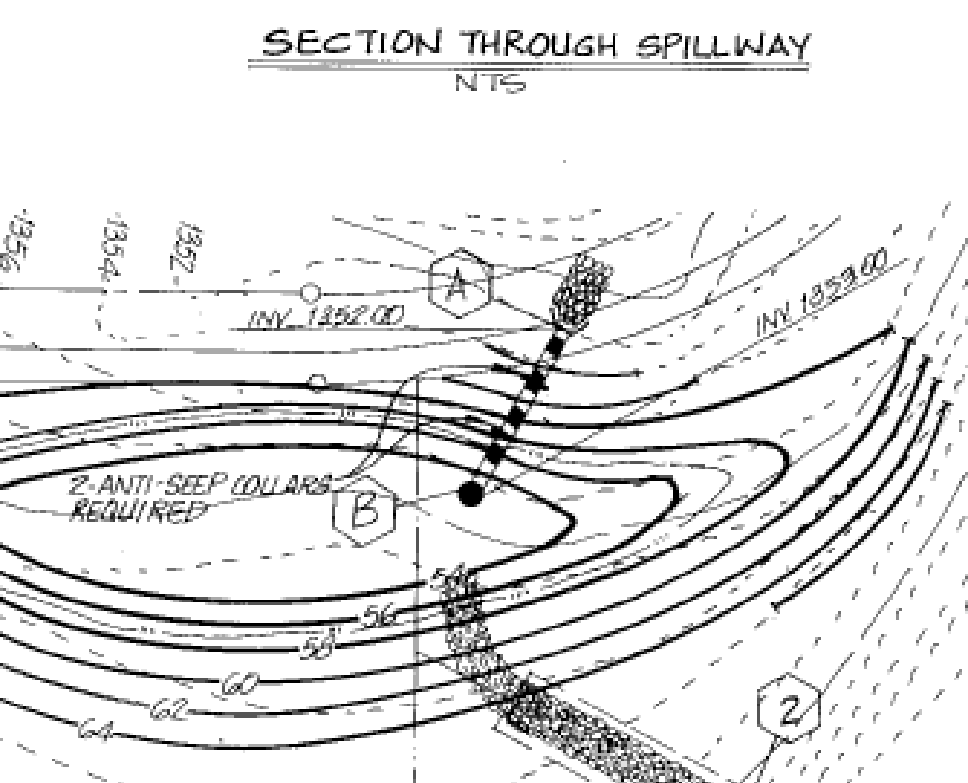
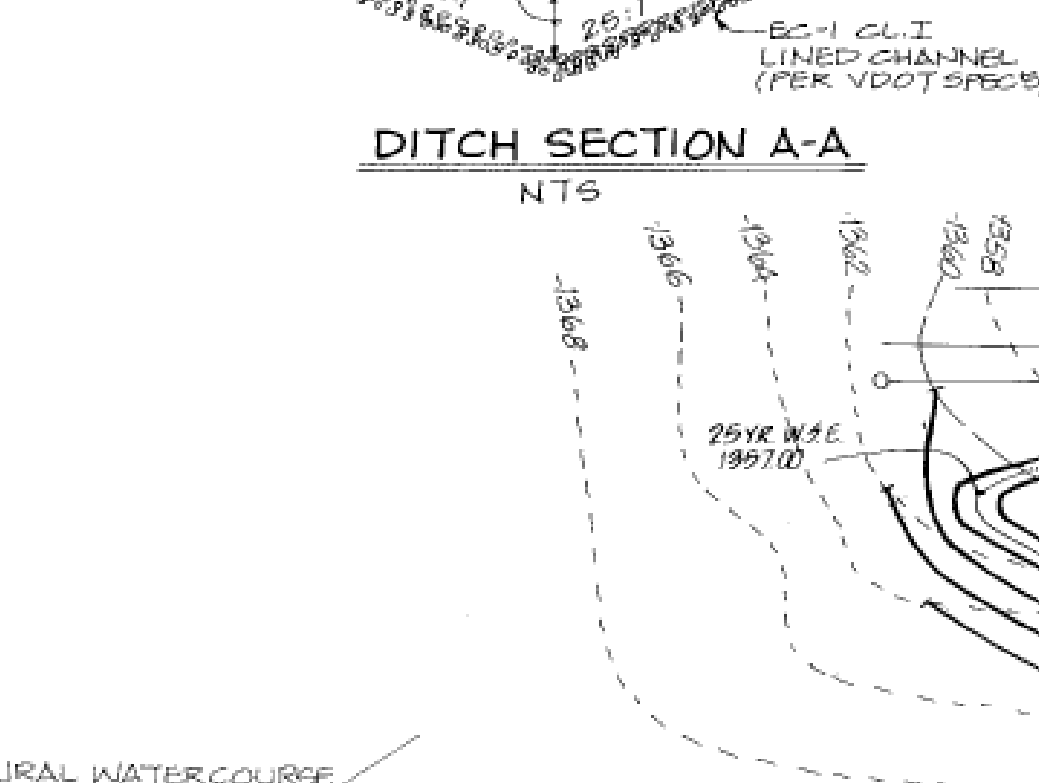 

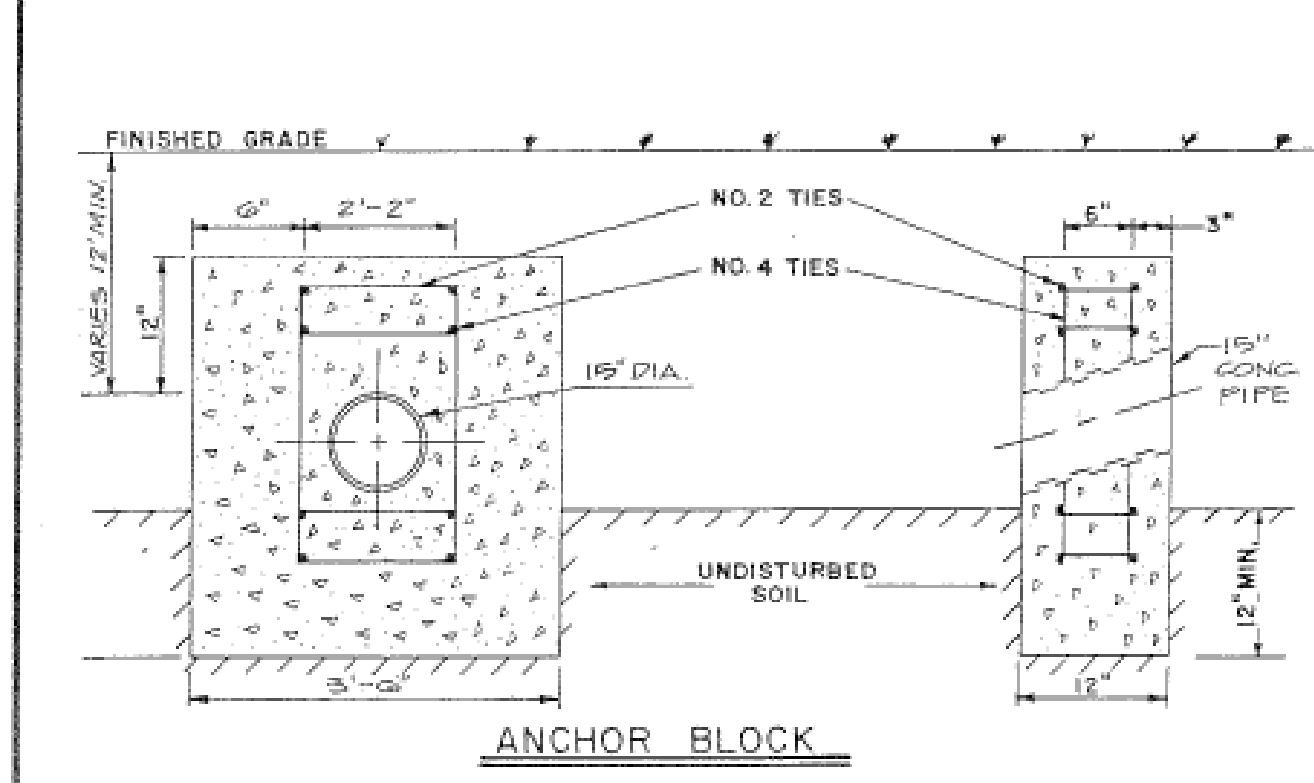
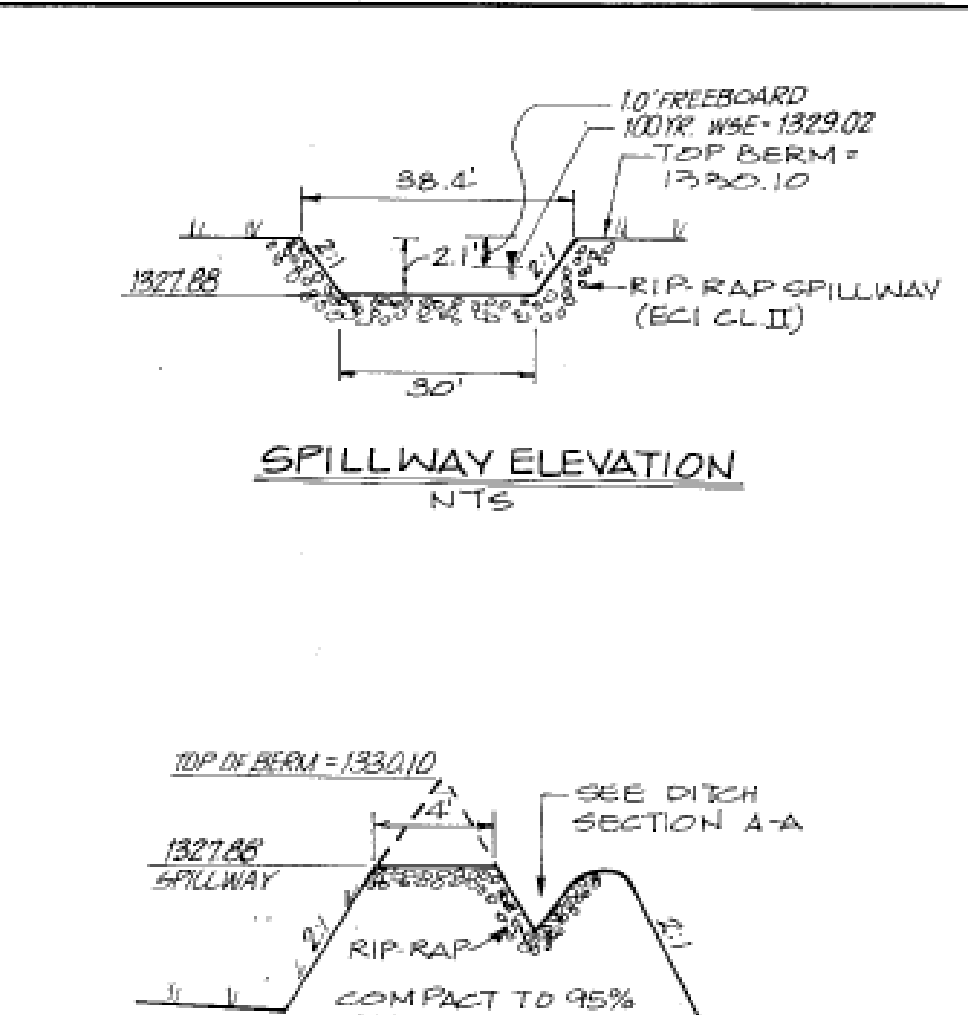
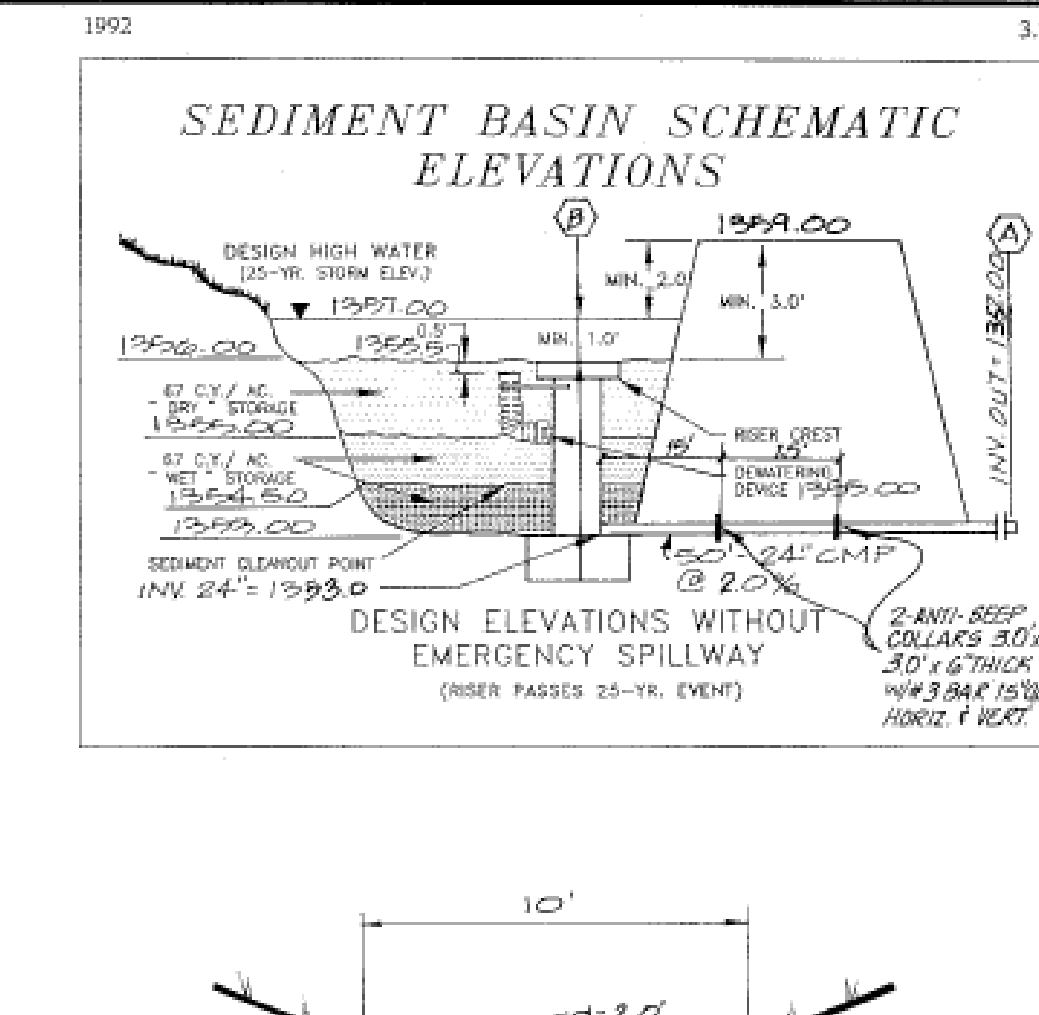
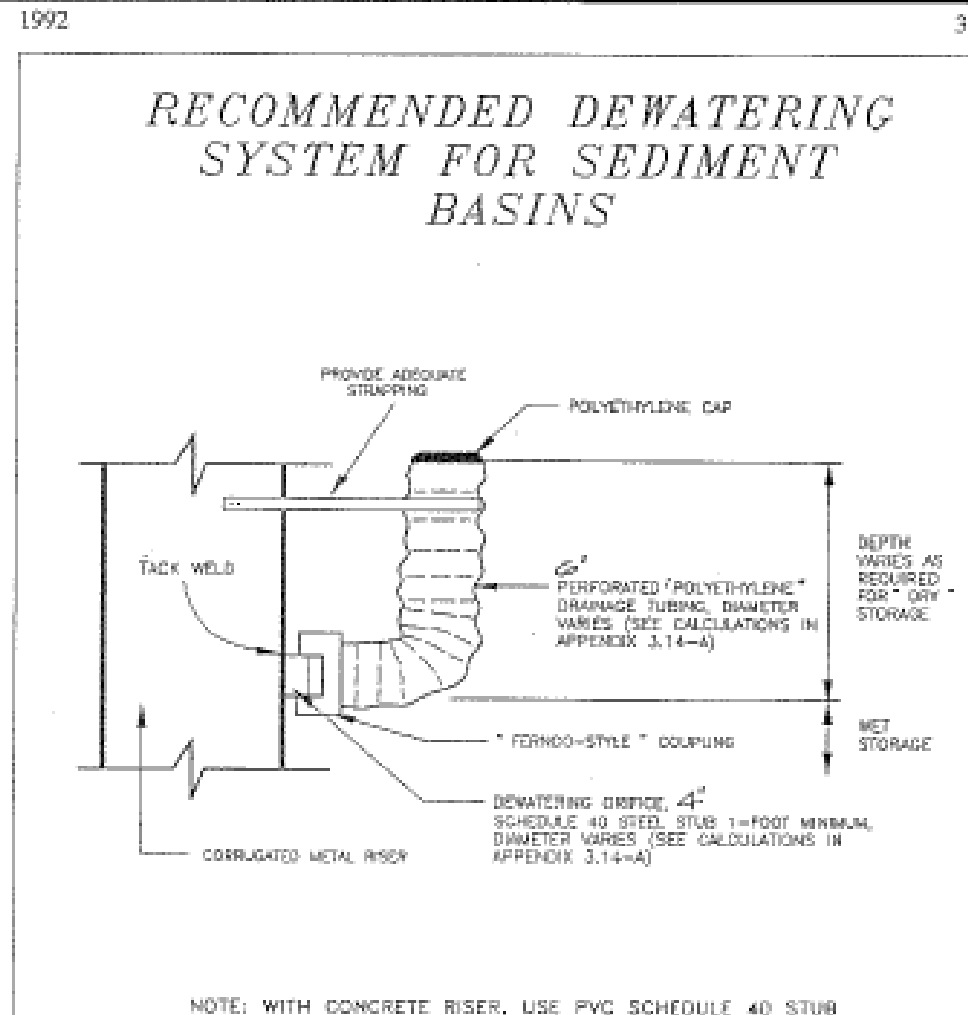


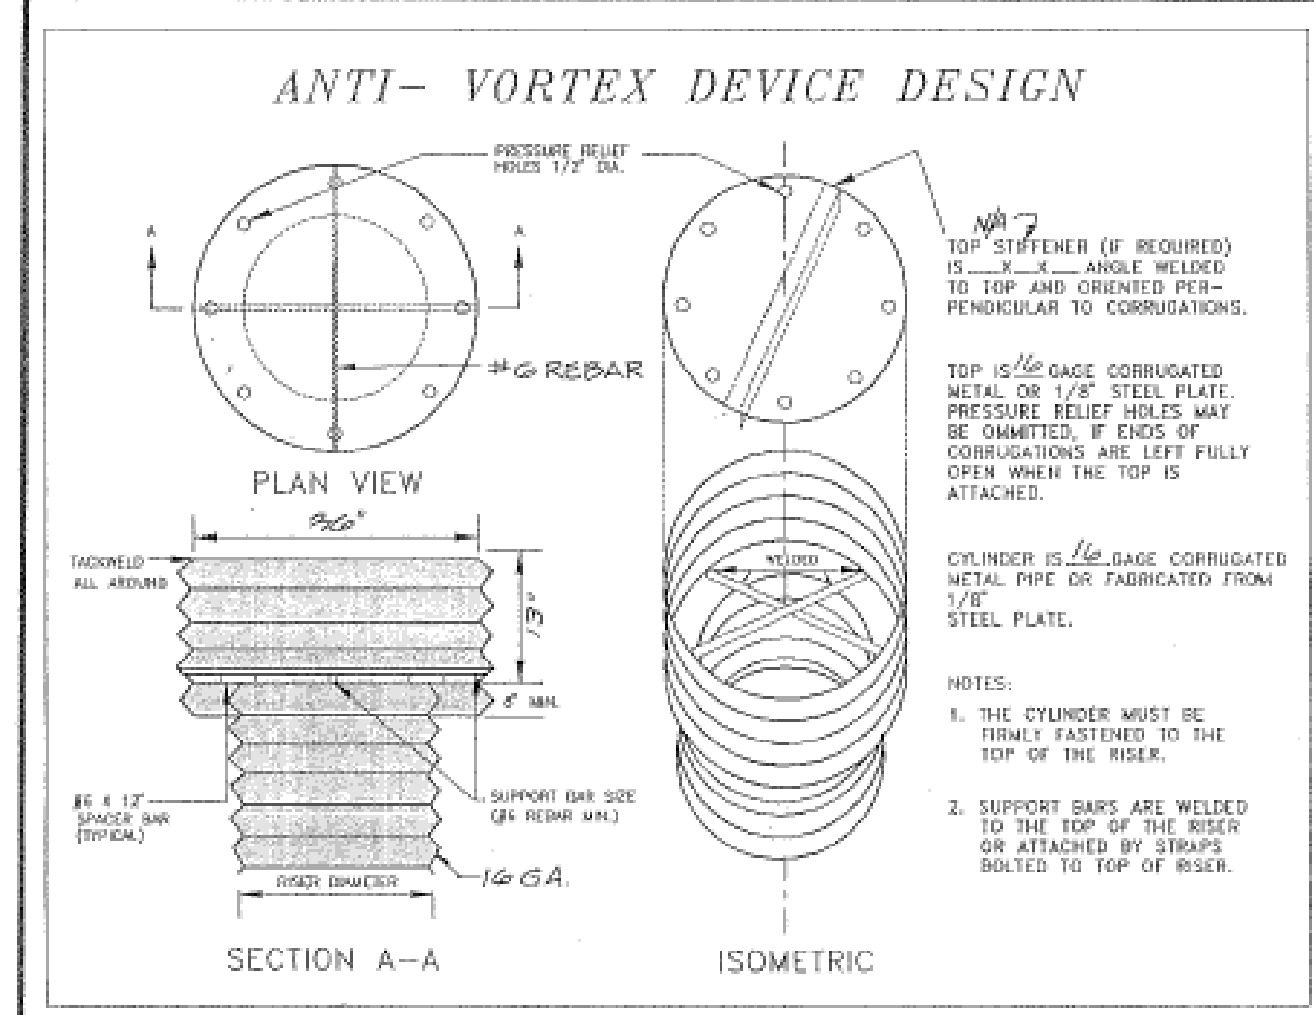

JAMES F. KINDER, JR.
No. 015761
PROFESSIONAL ENGINEER

BALZER BVN
PLANNERS • ARCHITECTS
ENGINEERS • SURVEYORS

1208 Corporate Circle
Roanoke, Virginia 24018
Phone: 703/772-9580
FAX: 703/772-8050

501 Branchway Road
Suite 100
Richmond, Virginia 23226
Phone: 804/782-8046
FAX: 804/782-8037

AS-BUILT WEXFORD PHASE II
STORMWATER MANAGEMENT FACILITY
NOTES & DETAILS
ROANOKE COUNTY, VIRGINIA

DRAWN BY DRB
DESIGNED BY JDE
CHECKED BY JDE
DATE OCT. 10, 1994

REVISIONS

- DEC. 27, 1994
- NOV. 3, 1995
- 5-11-95

SCALE AS NOTED
SHEET NO. 5 of 8

JOB NO. 93199-1