


023-2332.2

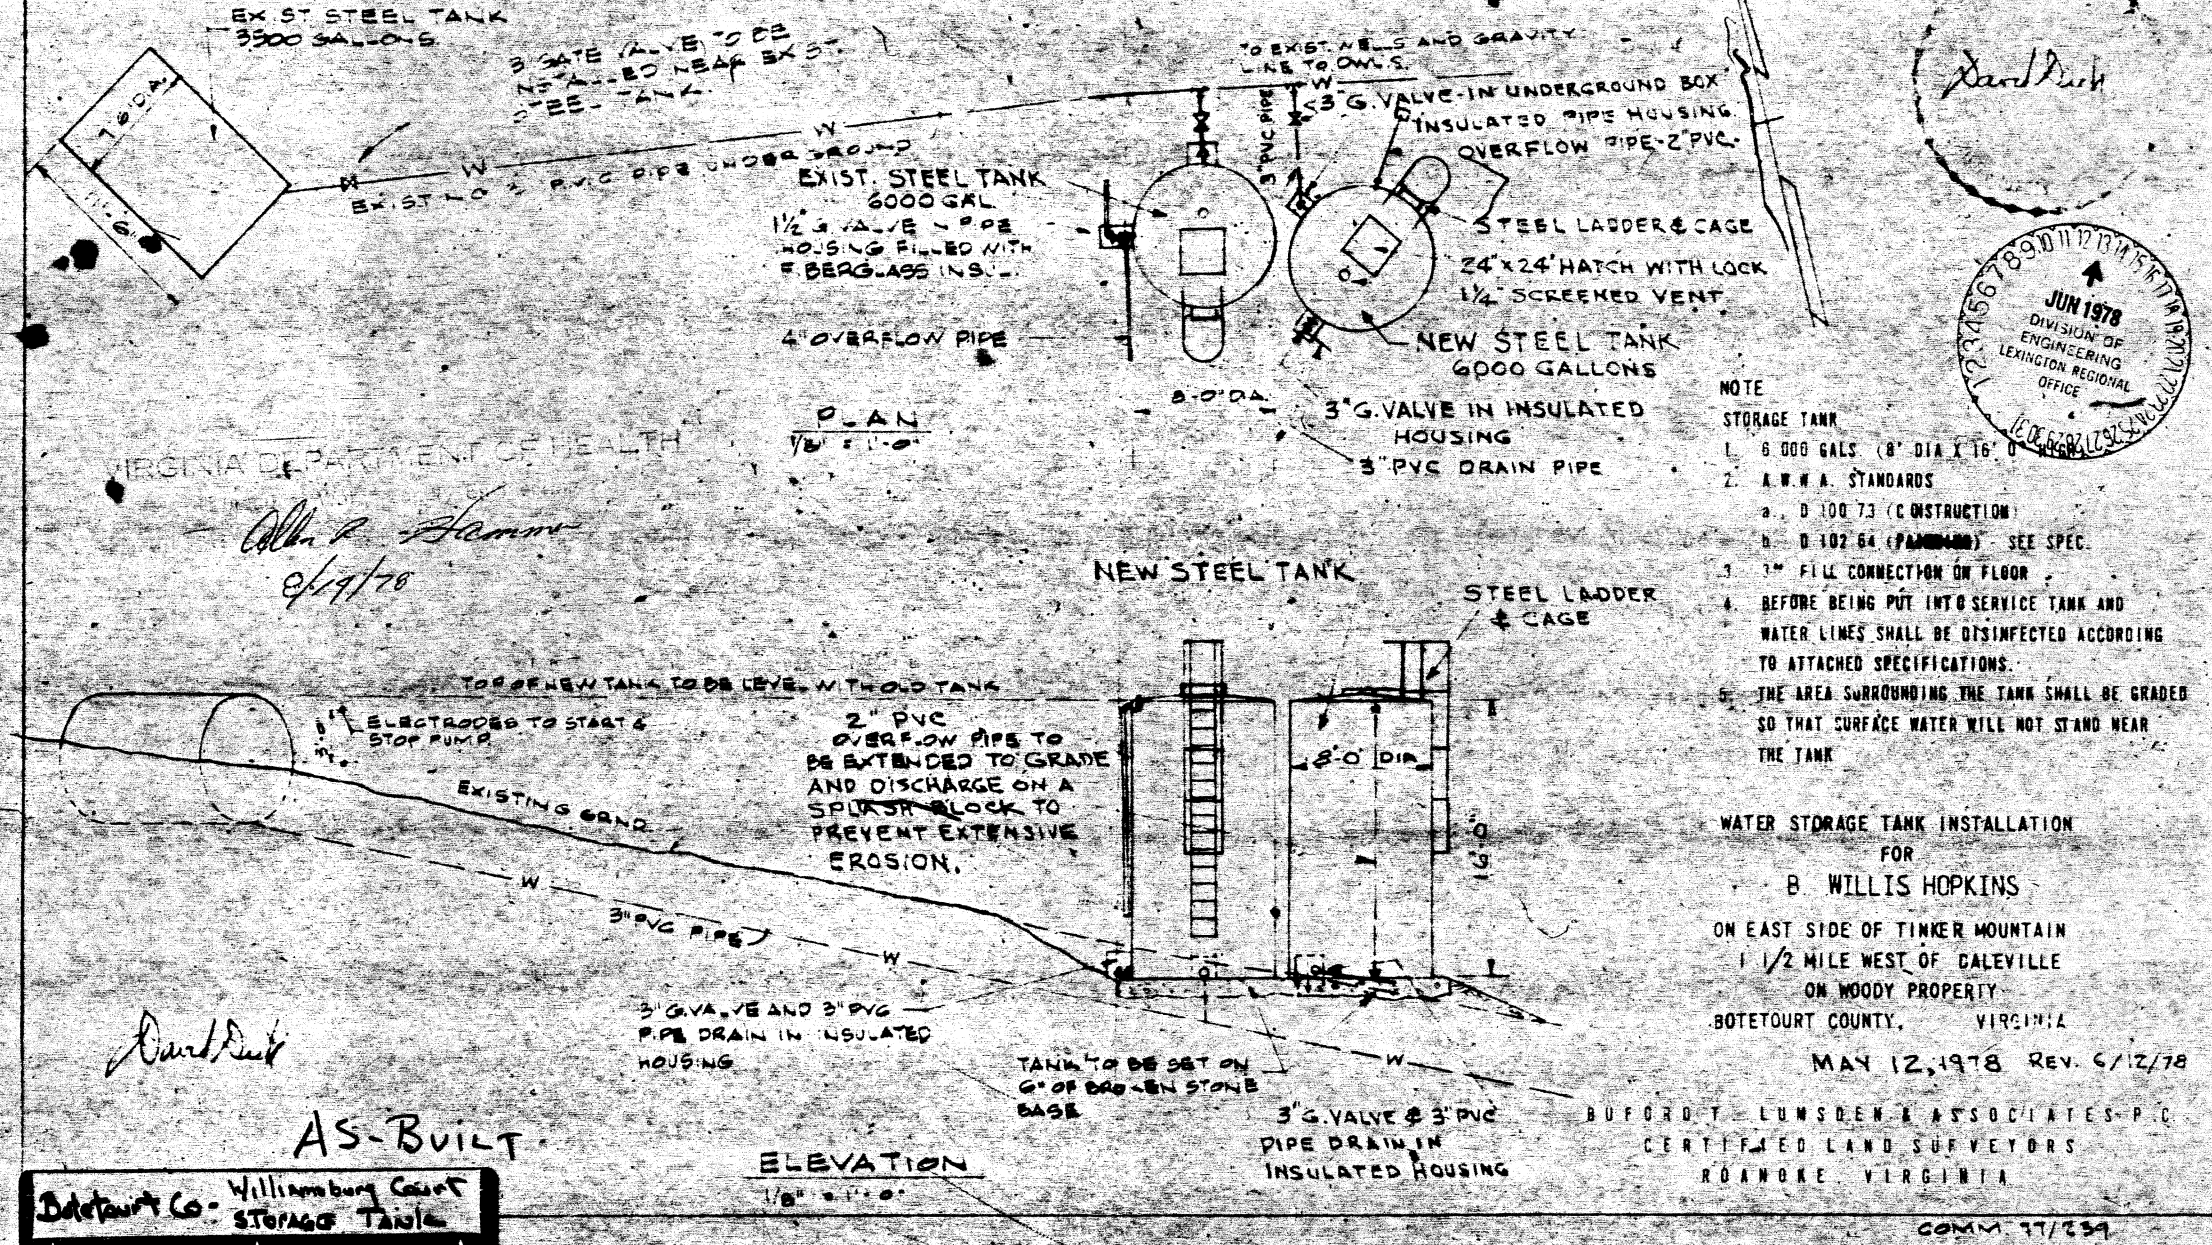


CURVE DATA							
CURVE	LOT	BLK.	ANGLE	TAN.	RAD.	ARC	DISTANCE
A	1	1	90°00'00"	40.00	40.00	62.83	N24°53'36"E 56.57
B	21	1	104°09'59"	25.37	19.76	35.92	N58°01'35"W 31.18
C	1	1	180°00'00"		195.00	612.61	N20°06'24"W 590.00
C	16	1	66°29'30"	127.83	195.00	226.30	S53°21'E 213.81
C	17	1	66°29'30"	127.83	195.00	226.30	S13°08'30"W 213.81
C	18	1	75°30'21"	40.57	195.00	80.00	S58°08'21"W 79.44
D	1	1	180°00'00"		245.00	769.69	N20°06'24"W 390.00
D	4	1	25°01'25"	54.37	245.00	107.00	N57°22'55"E 106.15
D	5	1	29°13'57"	63.89	245.00	125.00	N30°15'15"E 123.65
D	6	1	23°23'10"	50.71	245.00	100.00	N3°56'41"E 99.31
D	7	1	30°24'07"	66.57	245.00	130.00	N22°56'56"W 128.48
D	8	1	30°24'07"	66.57	245.00	130.00	N53°21'01"W 128.48
D	9	1	23°23'10"	50.71	245.00	100.00	N80°14'43"W 99.31
D	10	1	18°10'10"	39.17	245.00	77.69	S78°58'18"W 77.36
C	15	1	25°30'39"	40.58	195.00	80.00	N81°38'55"E 79.46
E	11	1	43°45'42"	16.06	40.00	30.55	N88°13'33"W 29.81
F	12	1	17°17'05"	45.60	300.00	70.50	N4°58'39"E 70.16
G	14	1	43°45'42"	16.06	40.00	30.55	N48°00'46"E 29.81

KNOW ALL MEN BY THESE PRESENTS:
THAT J. B. FIRESTONE CO. IS THE FEE SIMPLE OWNER OF THE LAND SHOWN HEREON BOUNDED BY CORNERS 1 THROUGH 9 INCLUSIVE AND KNOWN AS SECTION 1, WILLIAMSBURG ESTATES.
THE SAID OWNER CERTIFIES THAT THE SUBDIVISION OF THIS LAND AS SHOWN HEREON INTO LOTS, IS ENTIRELY WITH ITS OWN FREE WILL AND CONSENT AND IN ACCORDANCE WITH THE DESIRE OF THE UNDERSIGNED OWNERS PURSUANT TO SECTION 1-477 OF THE CODE OF VIRGINIA OF 1950 AS AMENDED TO DATE.
THE SAID OWNER DOES BY VIRTUE OF RECORDATION OF THIS MAP, DEDICATE IN FEE SIMPLE TO THE COUNTY OF BOTETOURT ALL THE LAND EMBRACED WITHIN THE STREETS OF THIS SUBDIVISION.
IN WITNESS WHEREOF ARE HEREBY PLACED THE FOLLOWING SIGNATURES ON THIS 3 DAY OF AUGUST, 1972.
J. B. Firestone J. B. FIRESTONE, PRESIDENT
Stella M. Richardson STELLA M. RICHARDSON, SECRETARY


STATE OF VIRGINIA
OF
I, JOHN T. PARKER, A NOTARY PUBLIC IN AND FOR THE AFORESAID COUNTY AND STATE DO HEREBY CERTIFY THAT J. B. FIRESTONE AND STELLA M. RICHARDSON WHOSE NAMES AS SUCH ARE SIGNED TO THE FOREGOING WRITING DATED AUG. 3, 1972, HAVE PERSONALLY APPEARED BEFORE ME IN MY JURISDICTION AND ACKNOWLEDGED THE SAME ON AUGUST 3, 1972.
MY COMMISSION EXPIRES DECEMBER 31, 1974.
John T. Parker
NOTARY PUBLIC

IN THE CLERK'S OFFICE FOR THE CIRCUIT COURT OF BOTETOURT COUNTY, VIRGINIA THIS MAP WAS PRESENTED AND WITH THE CERTIFICATE OF ACKNOWLEDGMENT THEREON ANNEXED, ADMITTED TO RECORD AT O'CLOCK, M. ON THIS DAY OF JULY, 1972.
TES: _____ CLERK

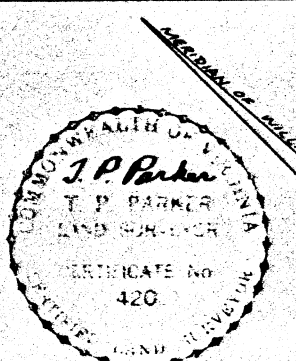


LEGEND
P.U.E. PUBLIC UTILITY EASEMENT
G.A.E. GUY ANCHOR EASEMENT
M.B.L. MINIMUM BUILDING LINE

LEGAL REFERENCE:
SOURCE OF TITLE IS DEED FROM B. WILKS HOPKINS AND HARRIOT F. HOPKINS TO J. B. FIRESTONE CO. DATED AUGUST 1, 1971 AND RECORDED IN DEED BOOK 196, PAGE 804 IN THE CLERK'S OFFICE FOR CIRCUIT COURT OF BOTETOURT COUNTY.

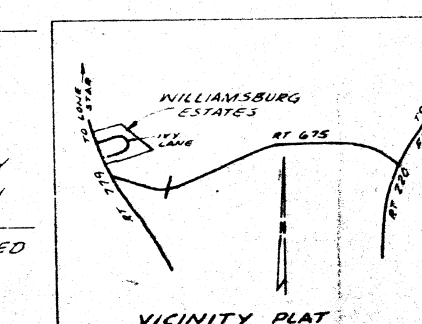


MAP OF SECTION 1

WILLIAMSBURG ESTATES
PROPERTY OF
J. B. FIRESTONE CO.
BOTETOURT CO. VIRGINIA
SCALE 1"=100'
BY T. P. PARKER & SON
ENGINEERS & SURVEYORS
JULY 3, 1972

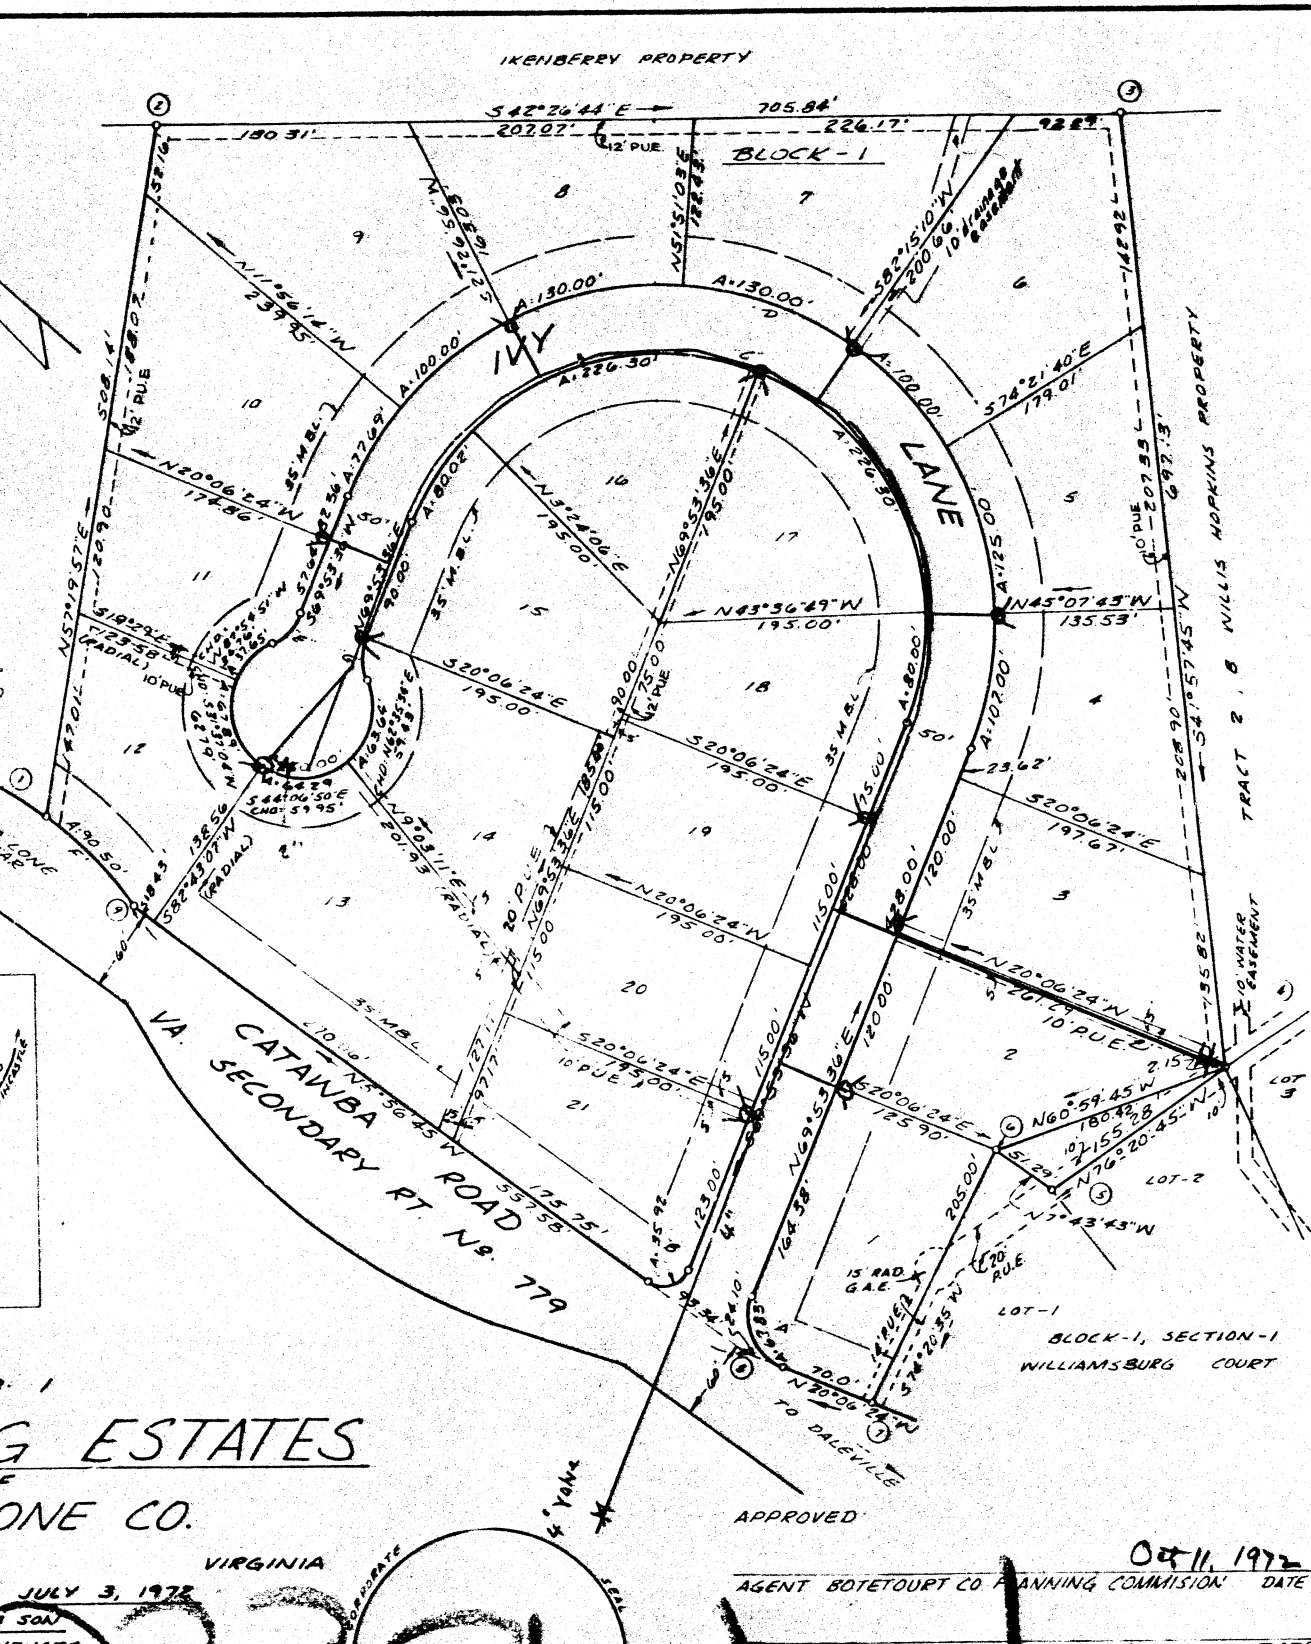


APPROVED: _____
AGENT BOTETOURT CO. PLANNING COMMISSION DATE 08/11/1972
STATE HIGHWAY RESIDENT ENGINEER DATE


132-003-23391.1-1

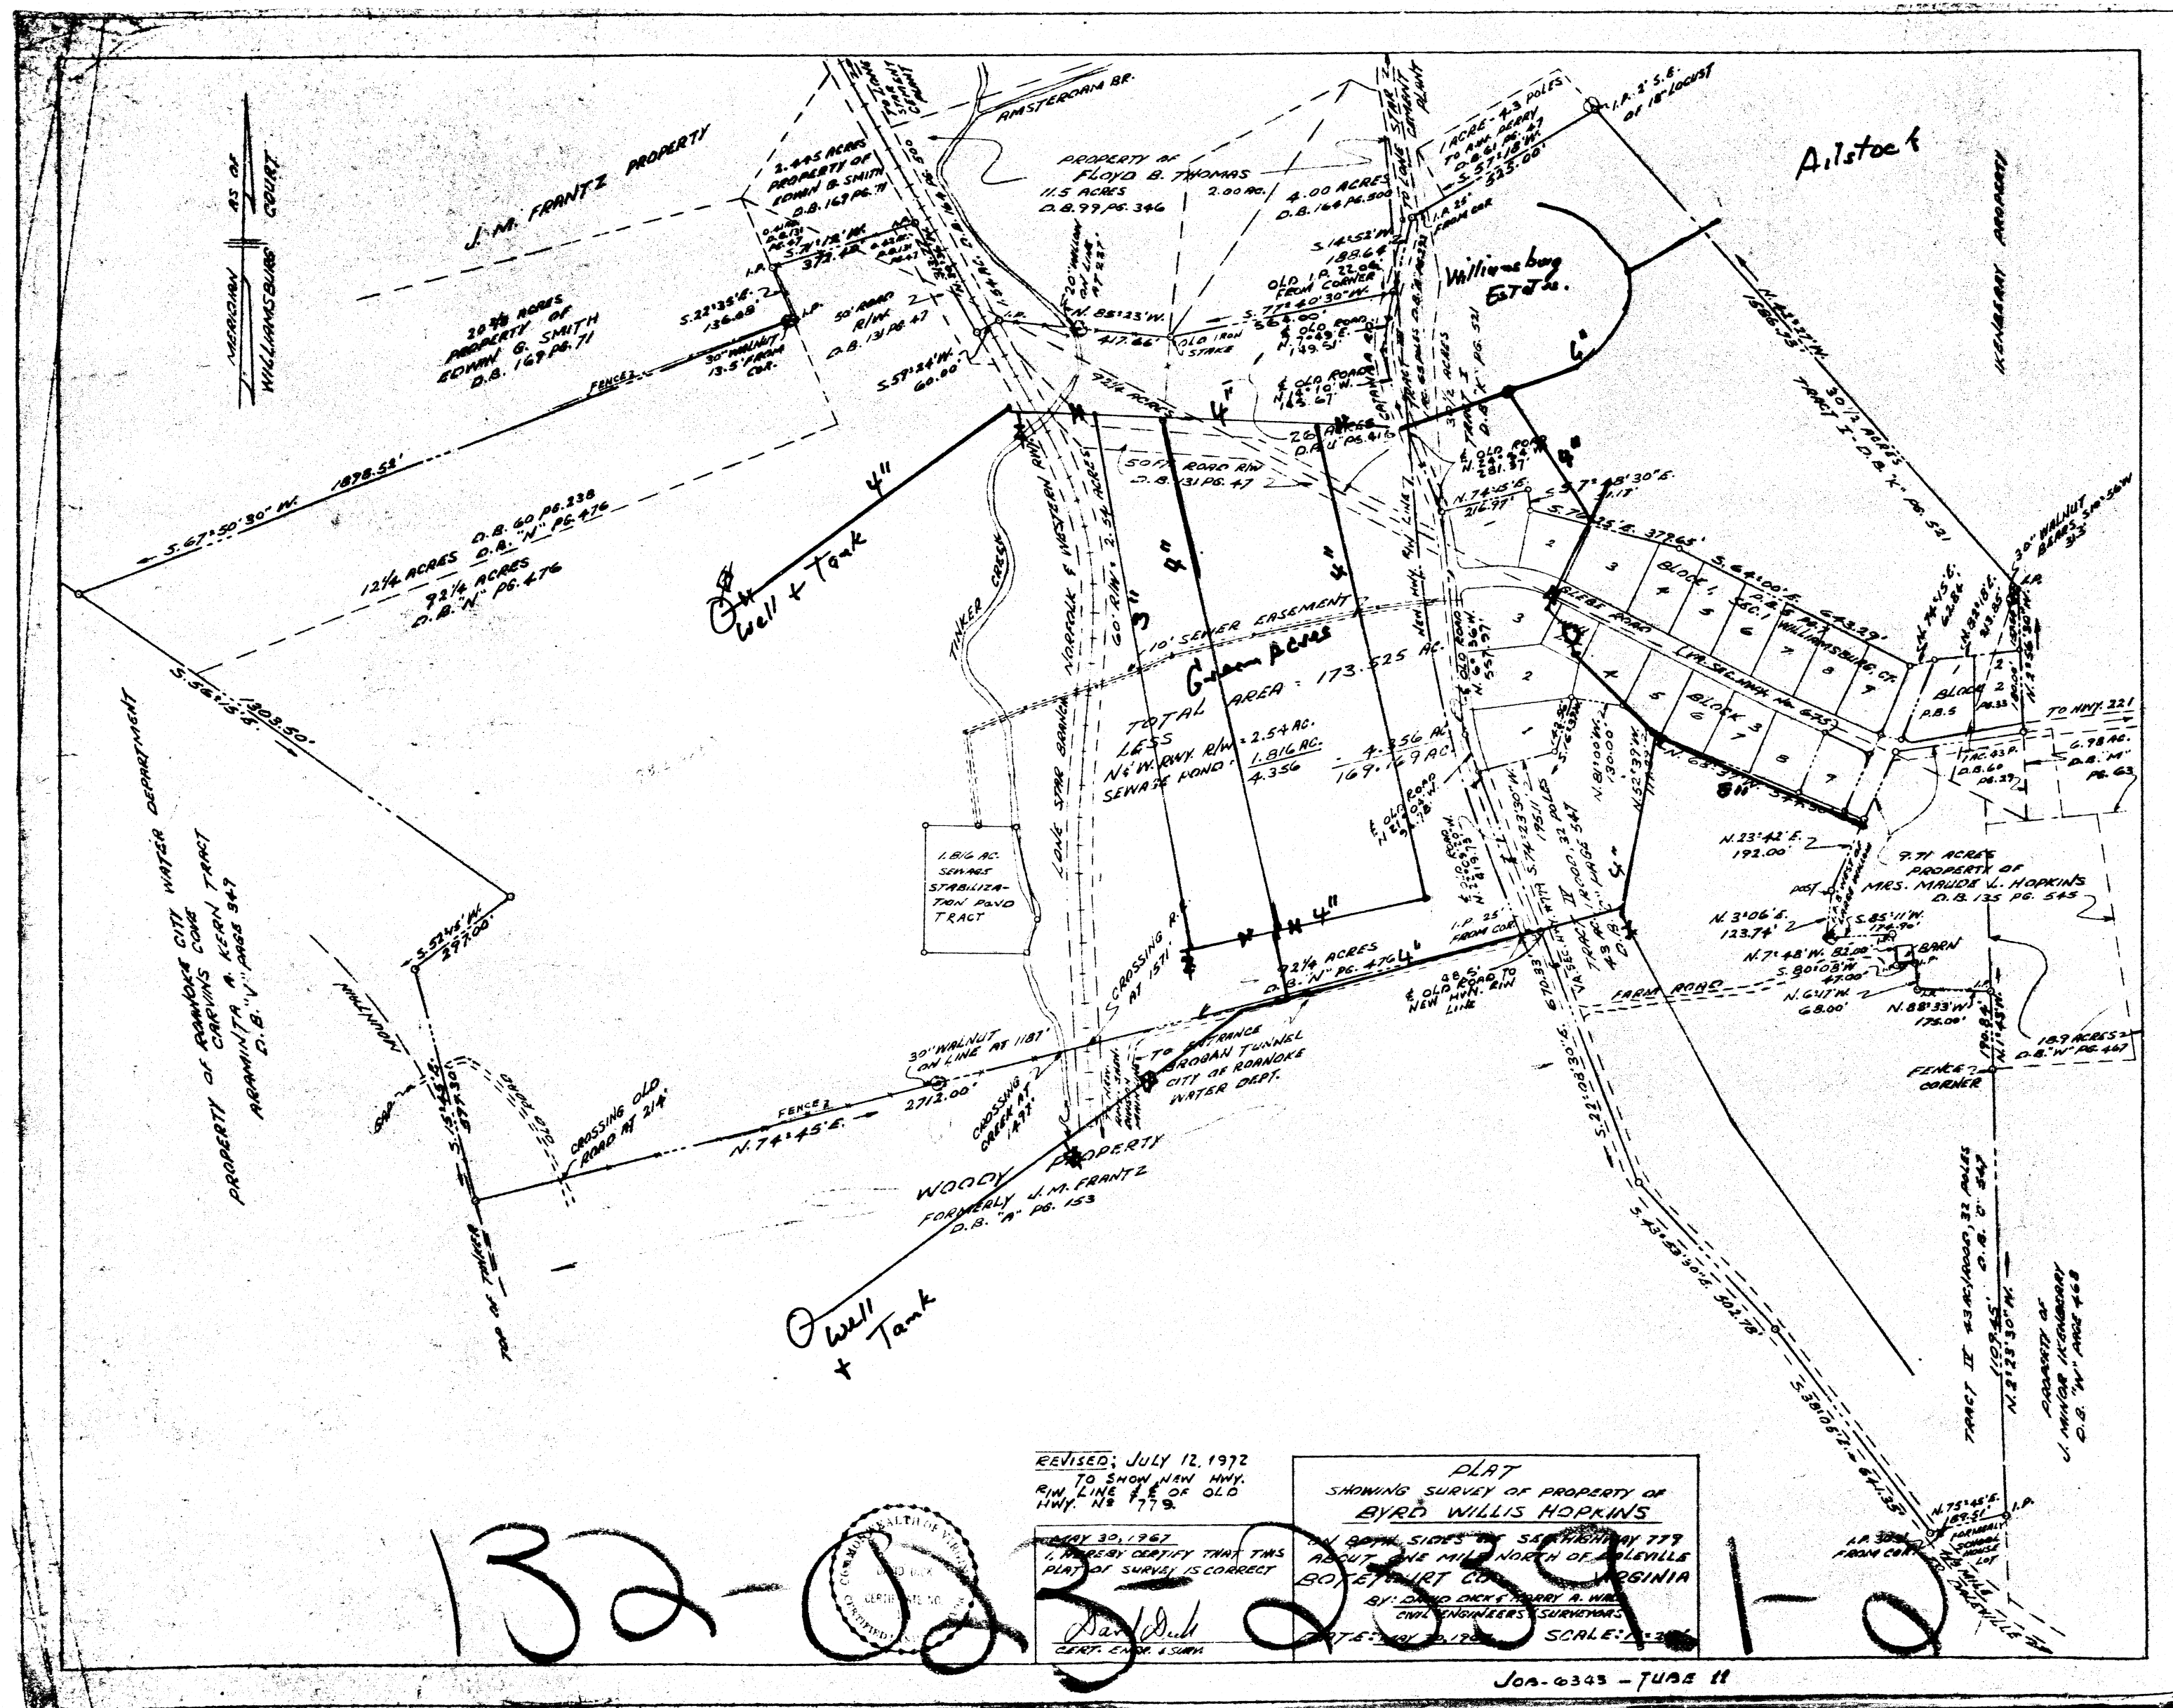




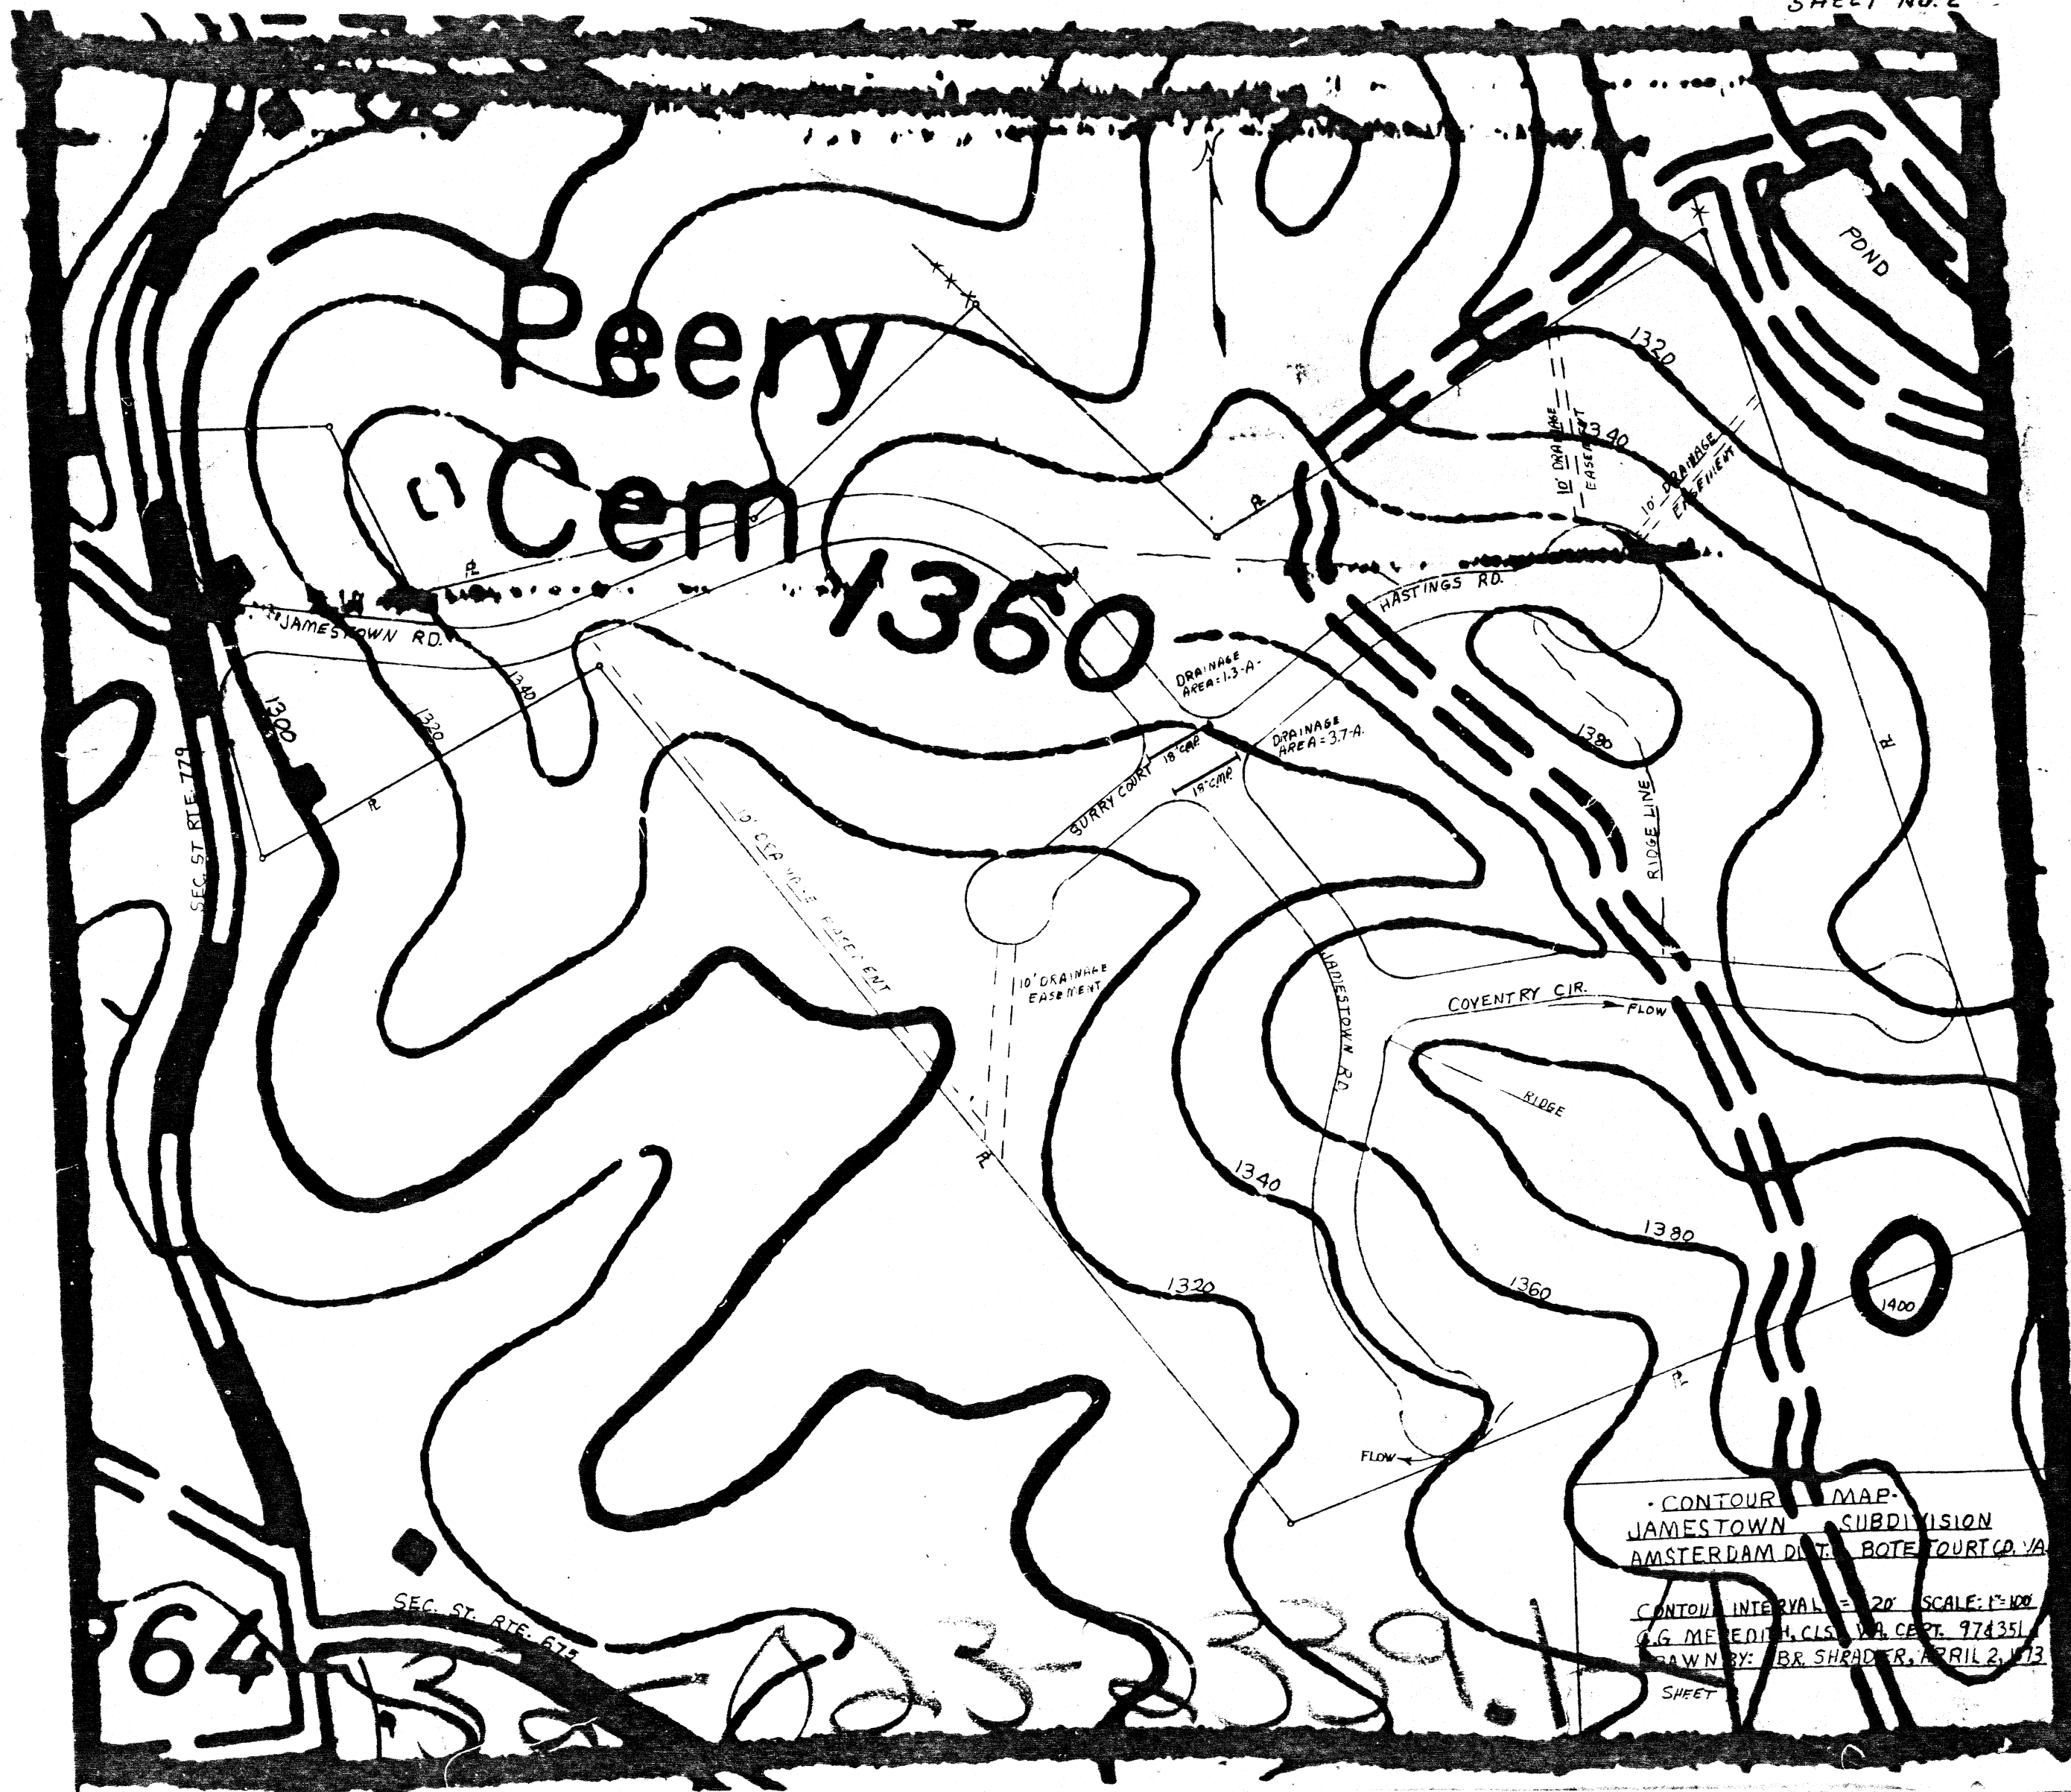


REEL 132



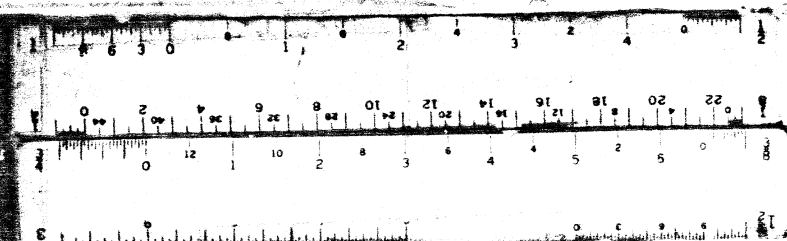


NO.	DATE	BY	REVISION
1	10-1-50	W.E.	PLAN
2	10-1-50	W.E.	REVISION
3	10-1-50	W.E.	REVISION
4	10-1-50	W.E.	REVISION
5	10-1-50	W.E.	REVISION
6	10-1-50	W.E.	REVISION
7	10-1-50	W.E.	REVISION
8	10-1-50	W.E.	REVISION
9	10-1-50	W.E.	REVISION
10	10-1-50	W.E.	REVISION

NO.	DATE	BY	REVISION
1	10-1-50	W.E.	PLAN
2	10-1-50	W.E.	REVISION
3	10-1-50	W.E.	REVISION
4	10-1-50	W.E.	REVISION
5	10-1-50	W.E.	REVISION
6	10-1-50	W.E.	REVISION
7	10-1-50	W.E.	REVISION
8	10-1-50	W.E.	REVISION
9	10-1-50	W.E.	REVISION
10	10-1-50	W.E.	REVISION



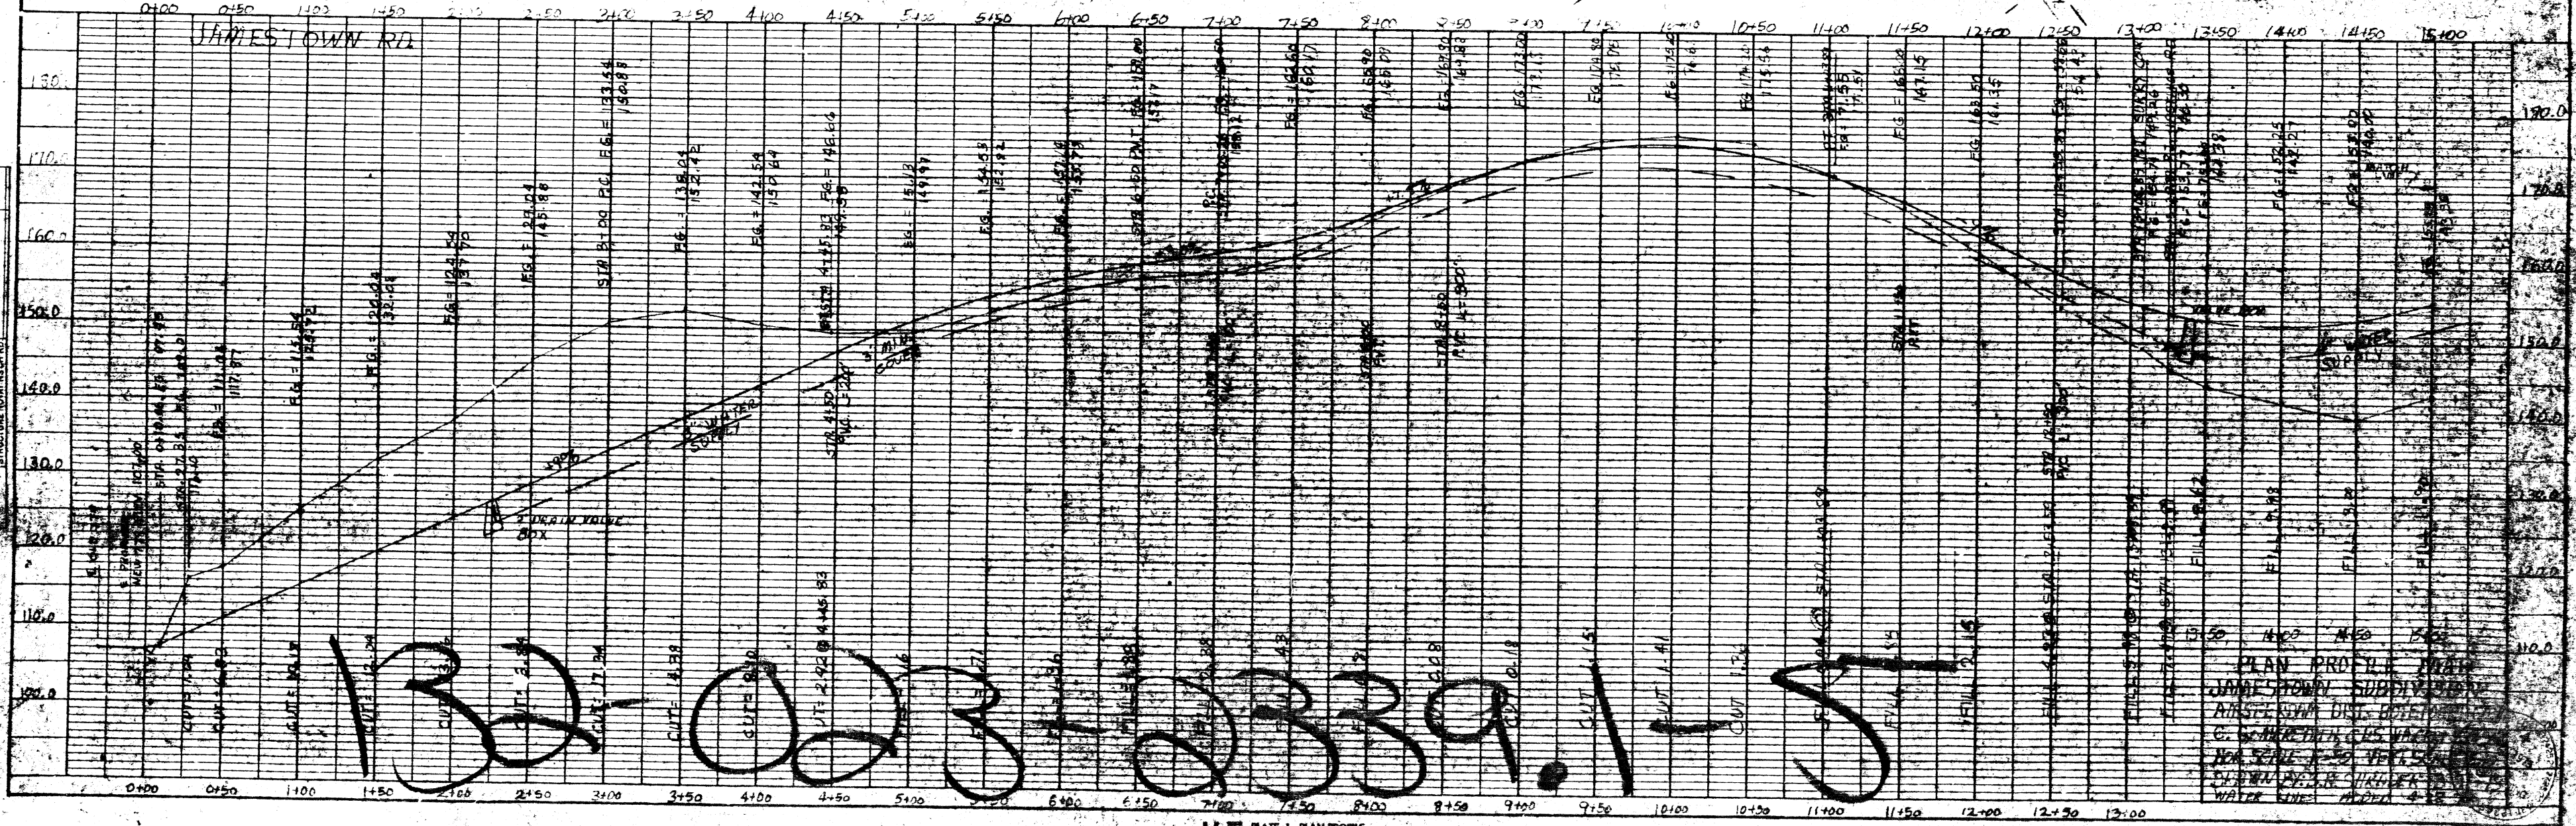
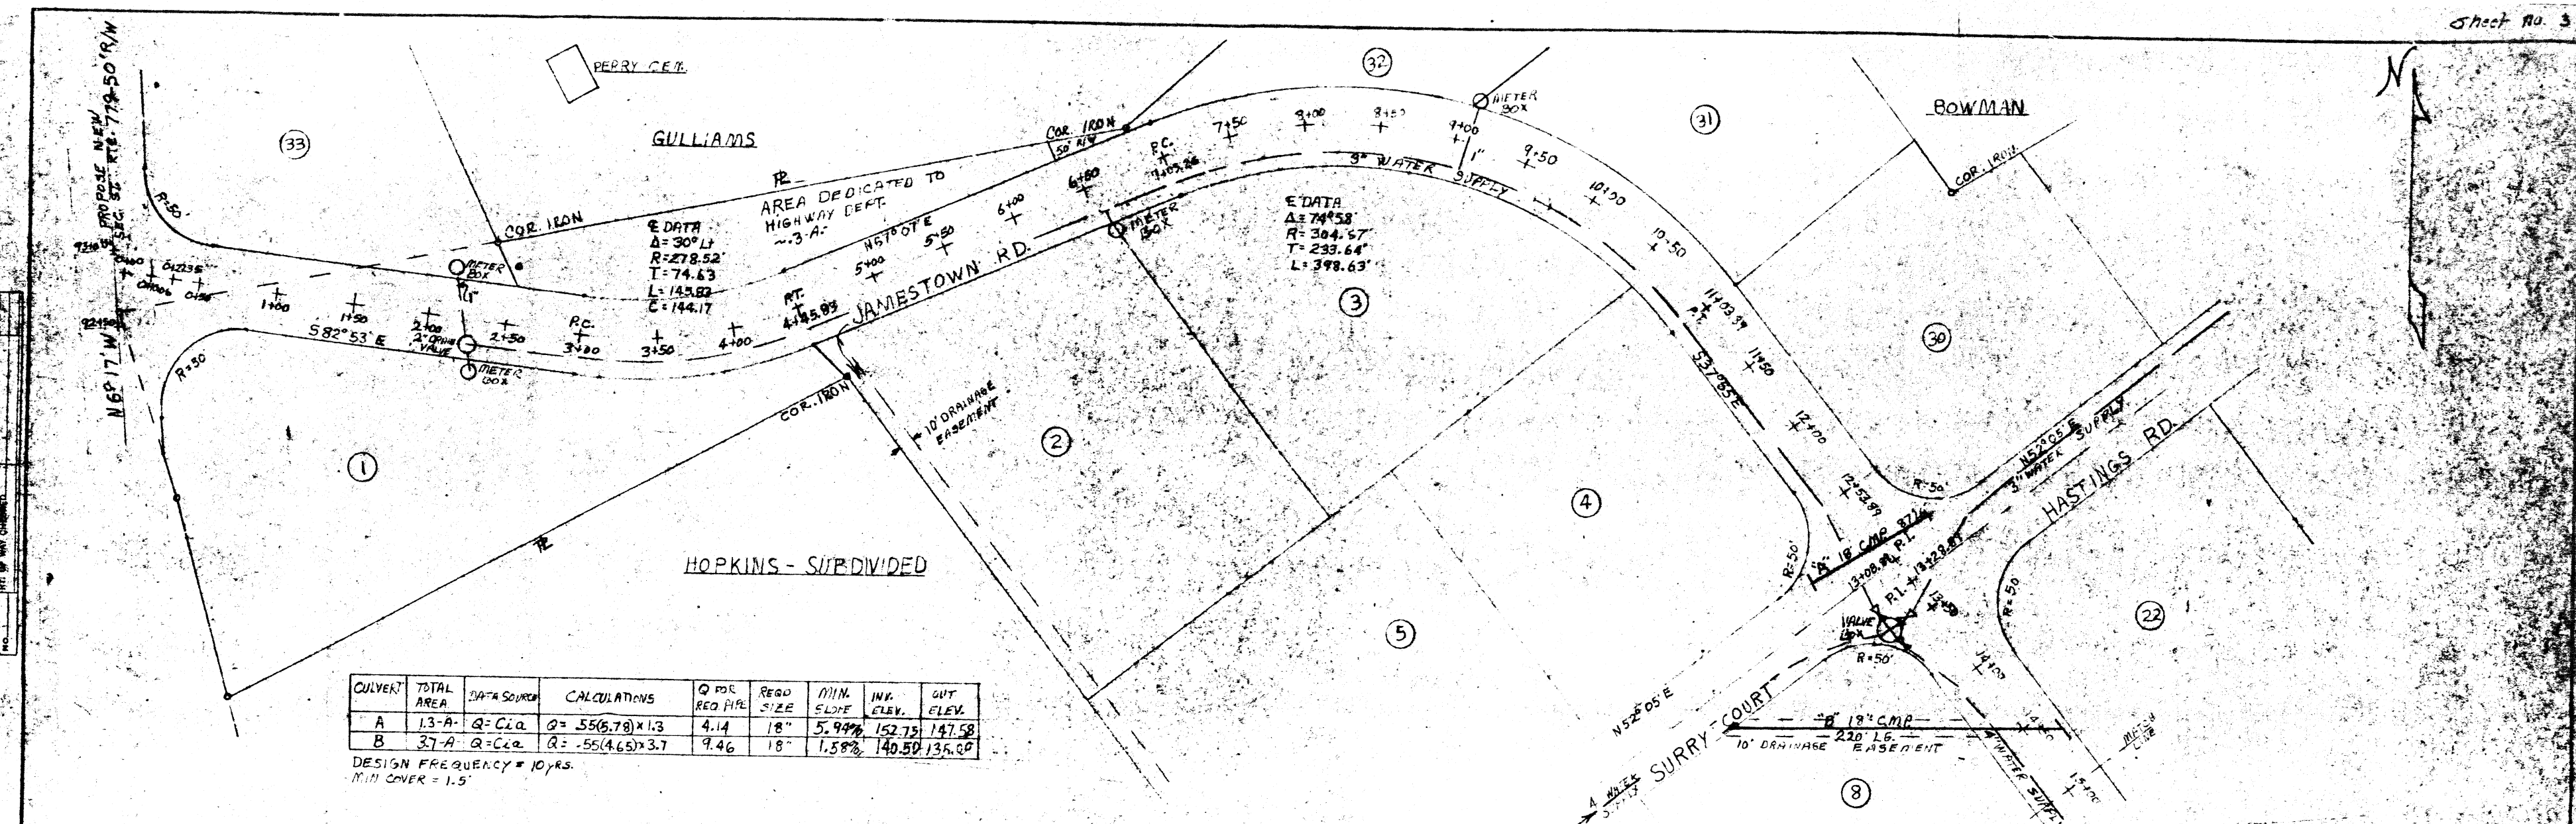


REF 132

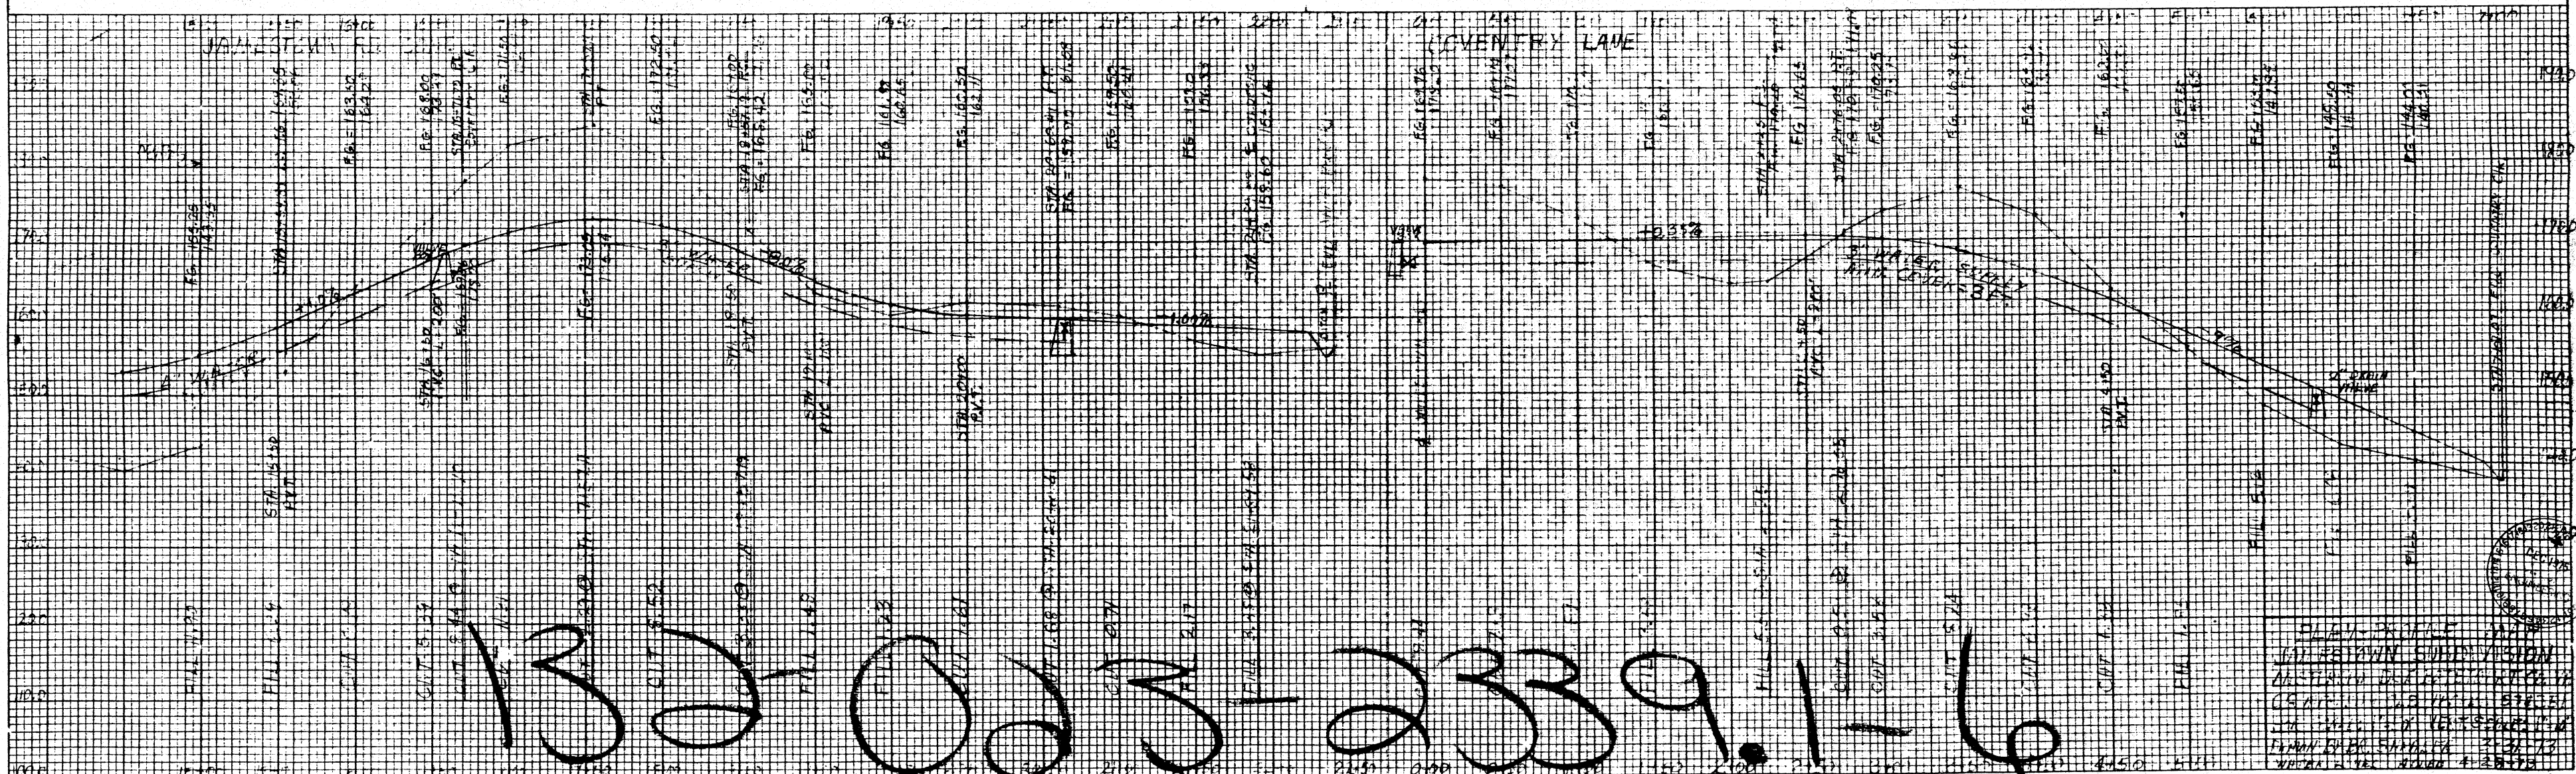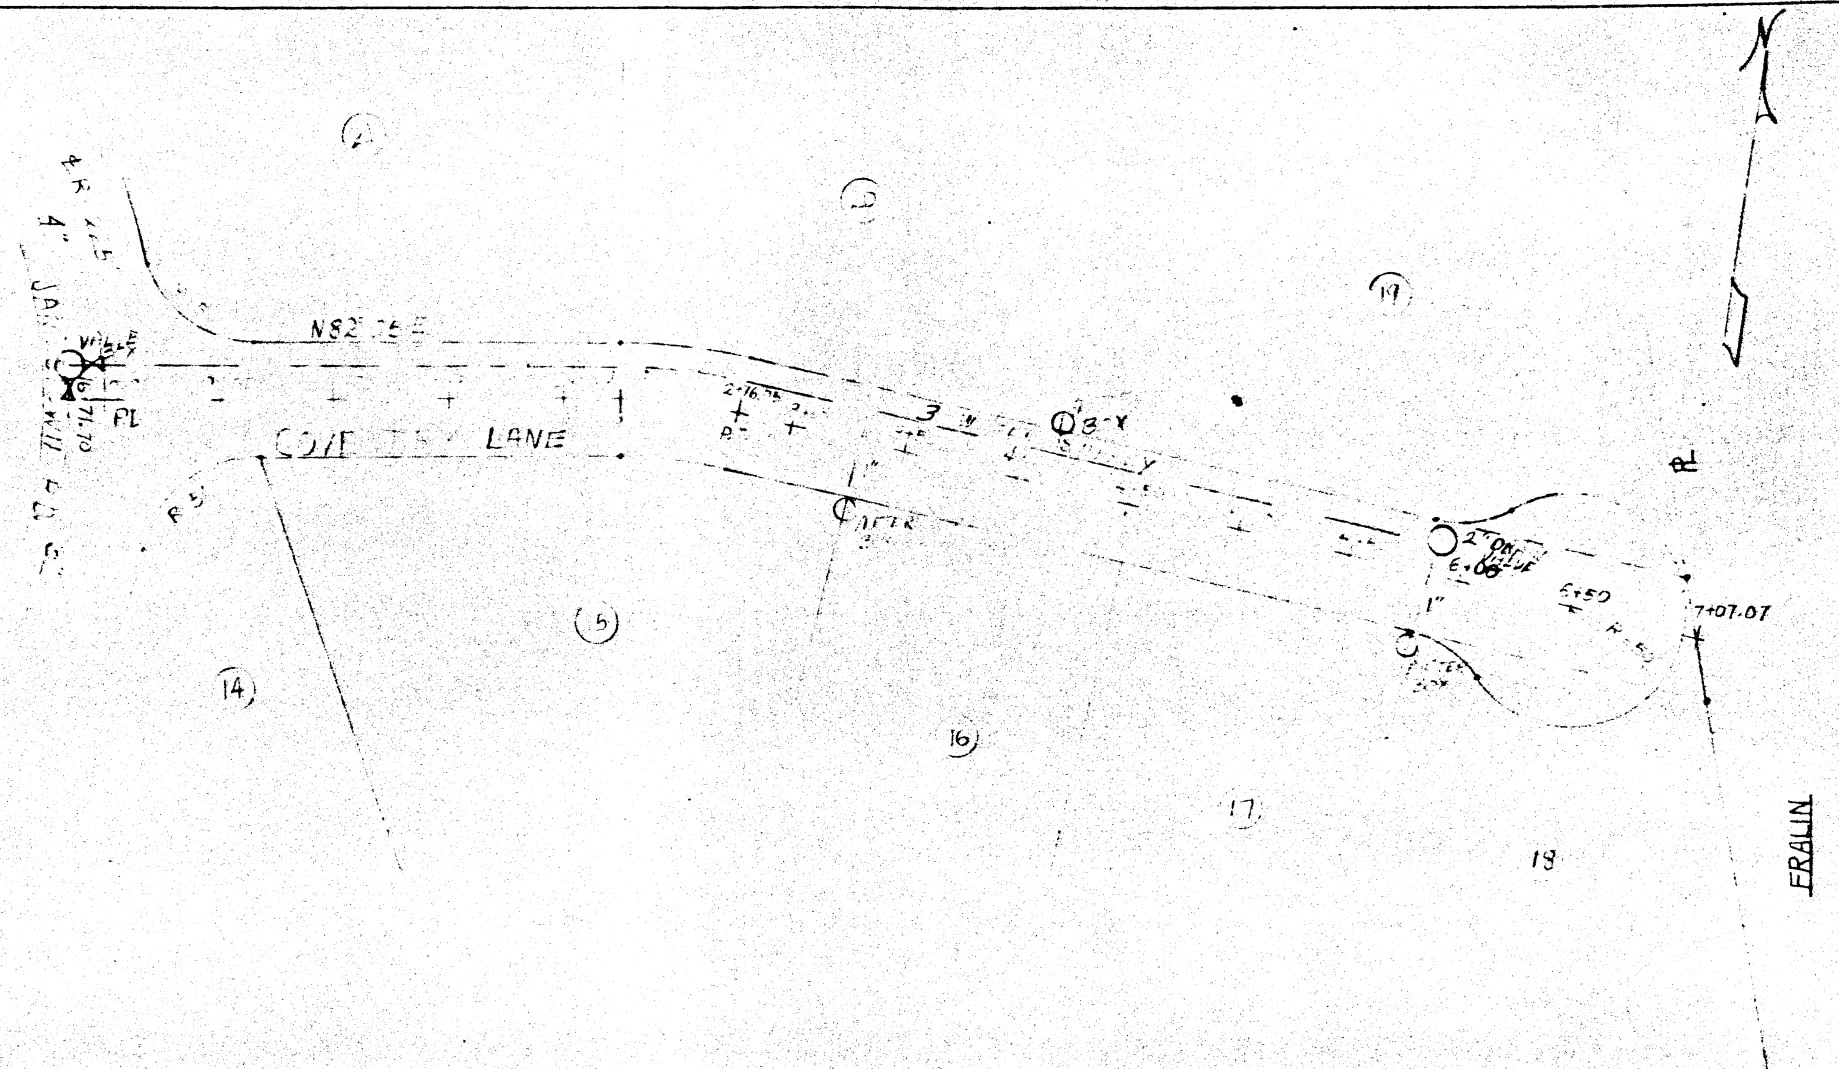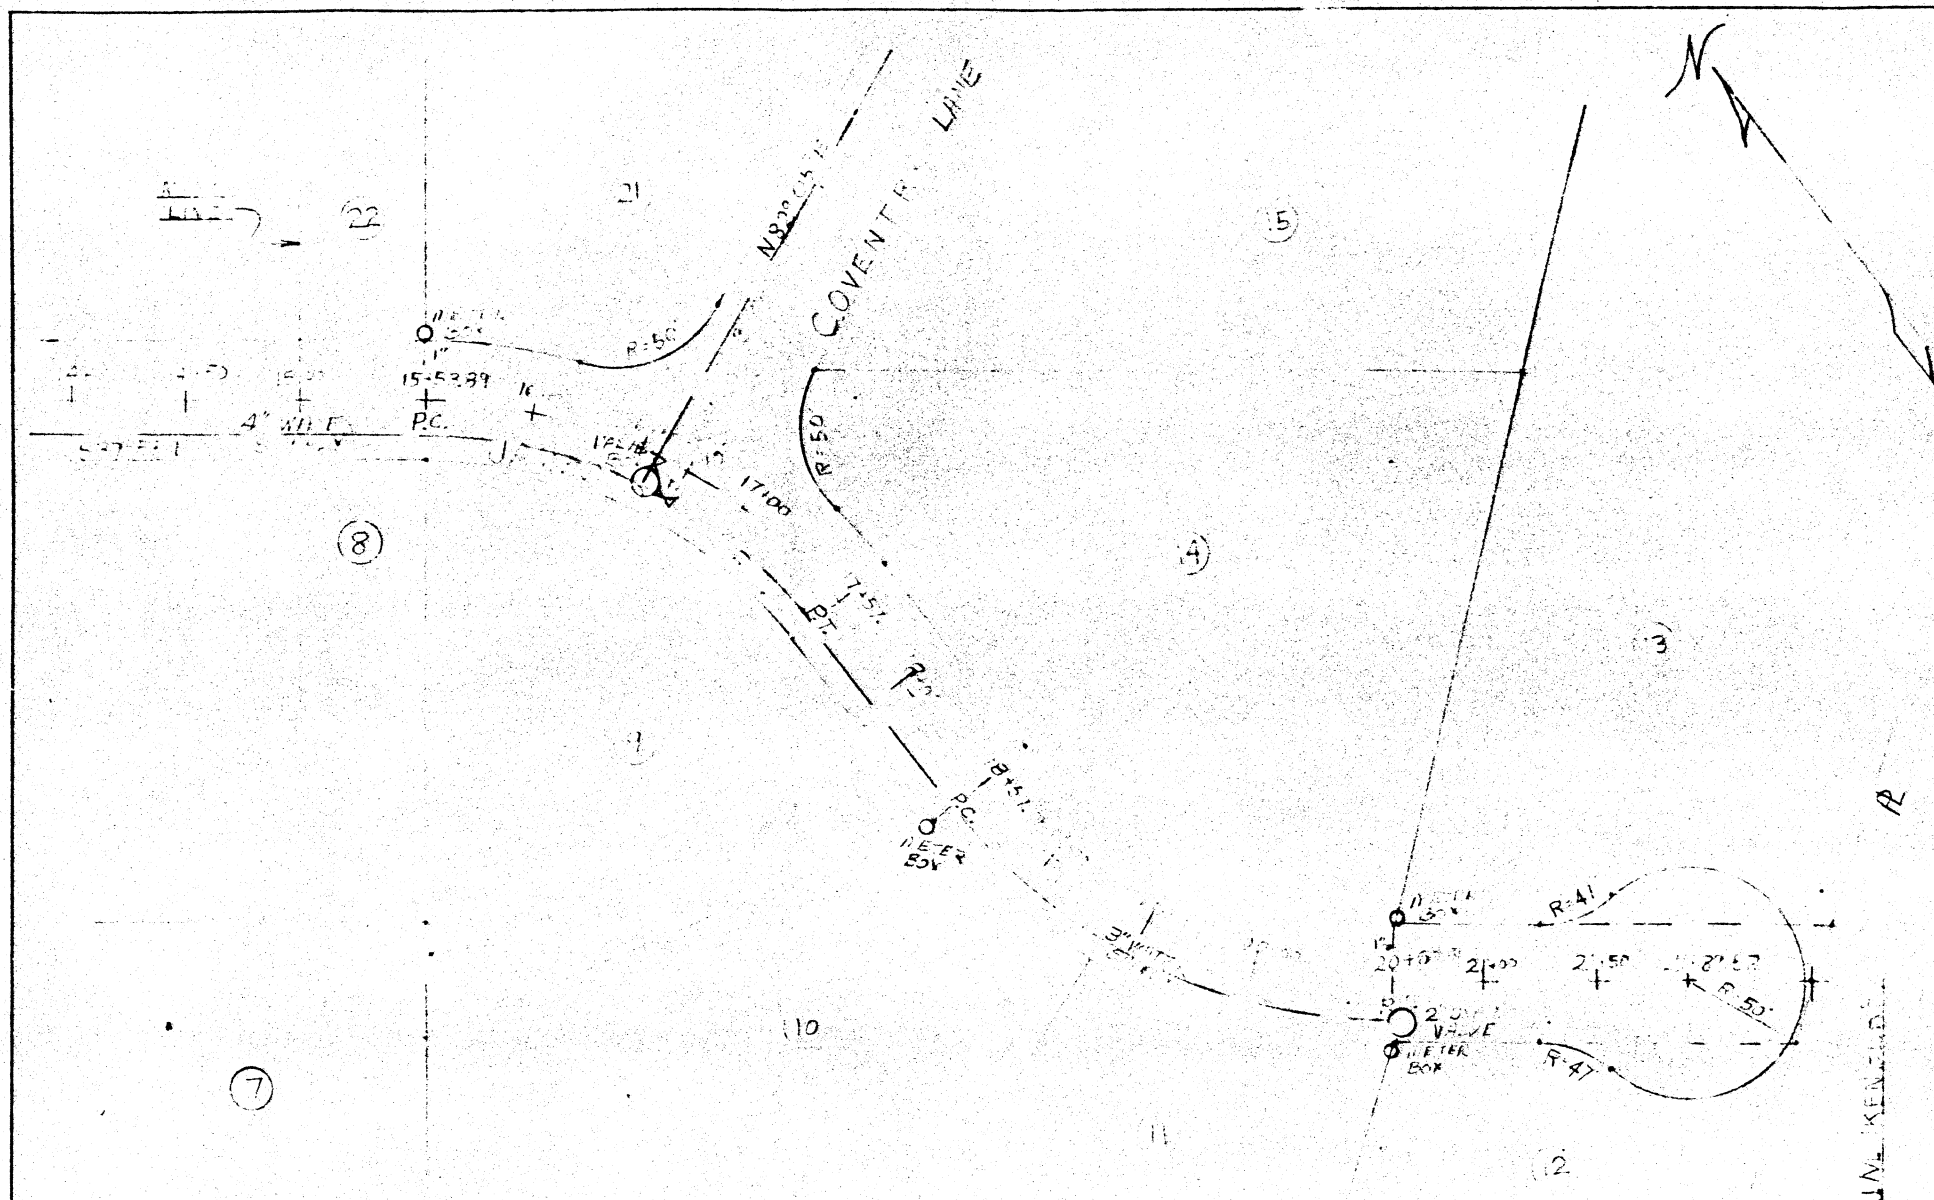





K-Σ PLATE 4, CROSS SECTION
KEUFFEL & ESSER CO.

132

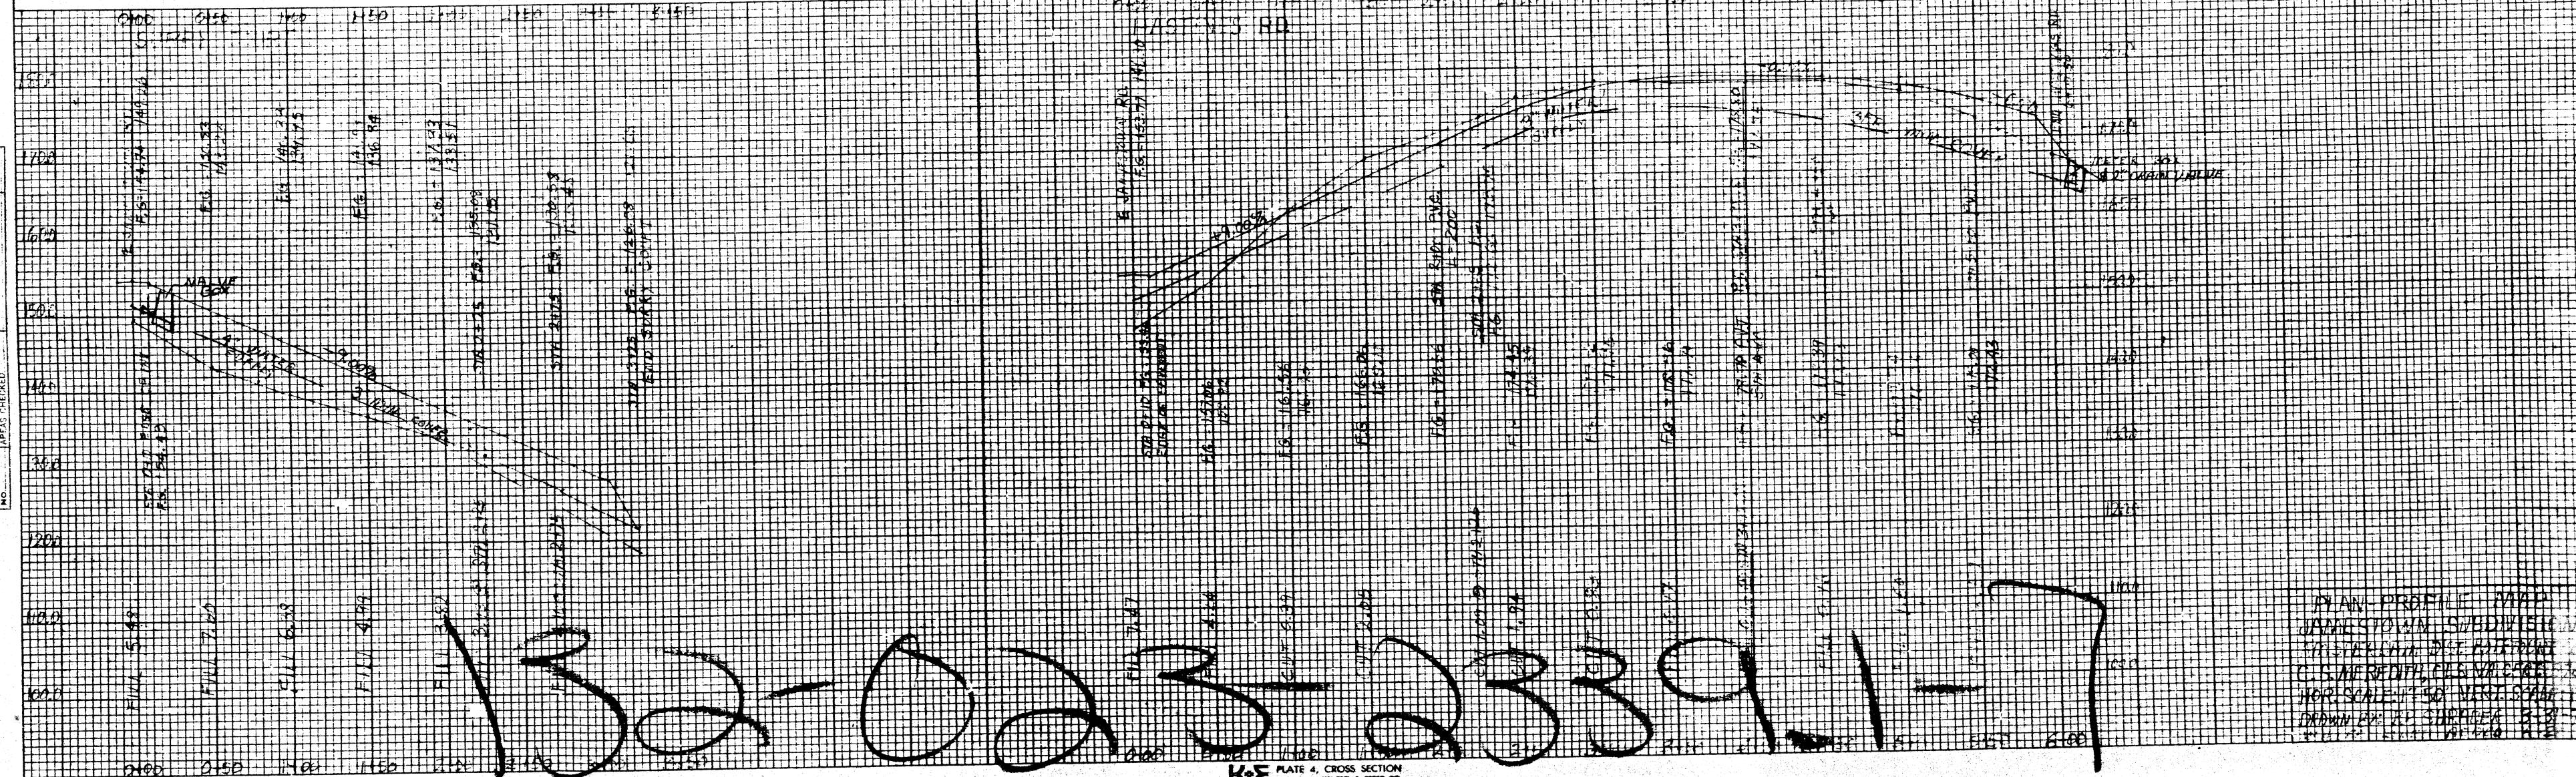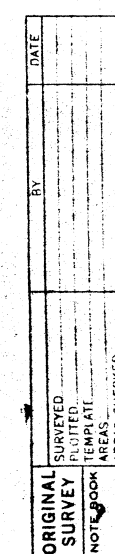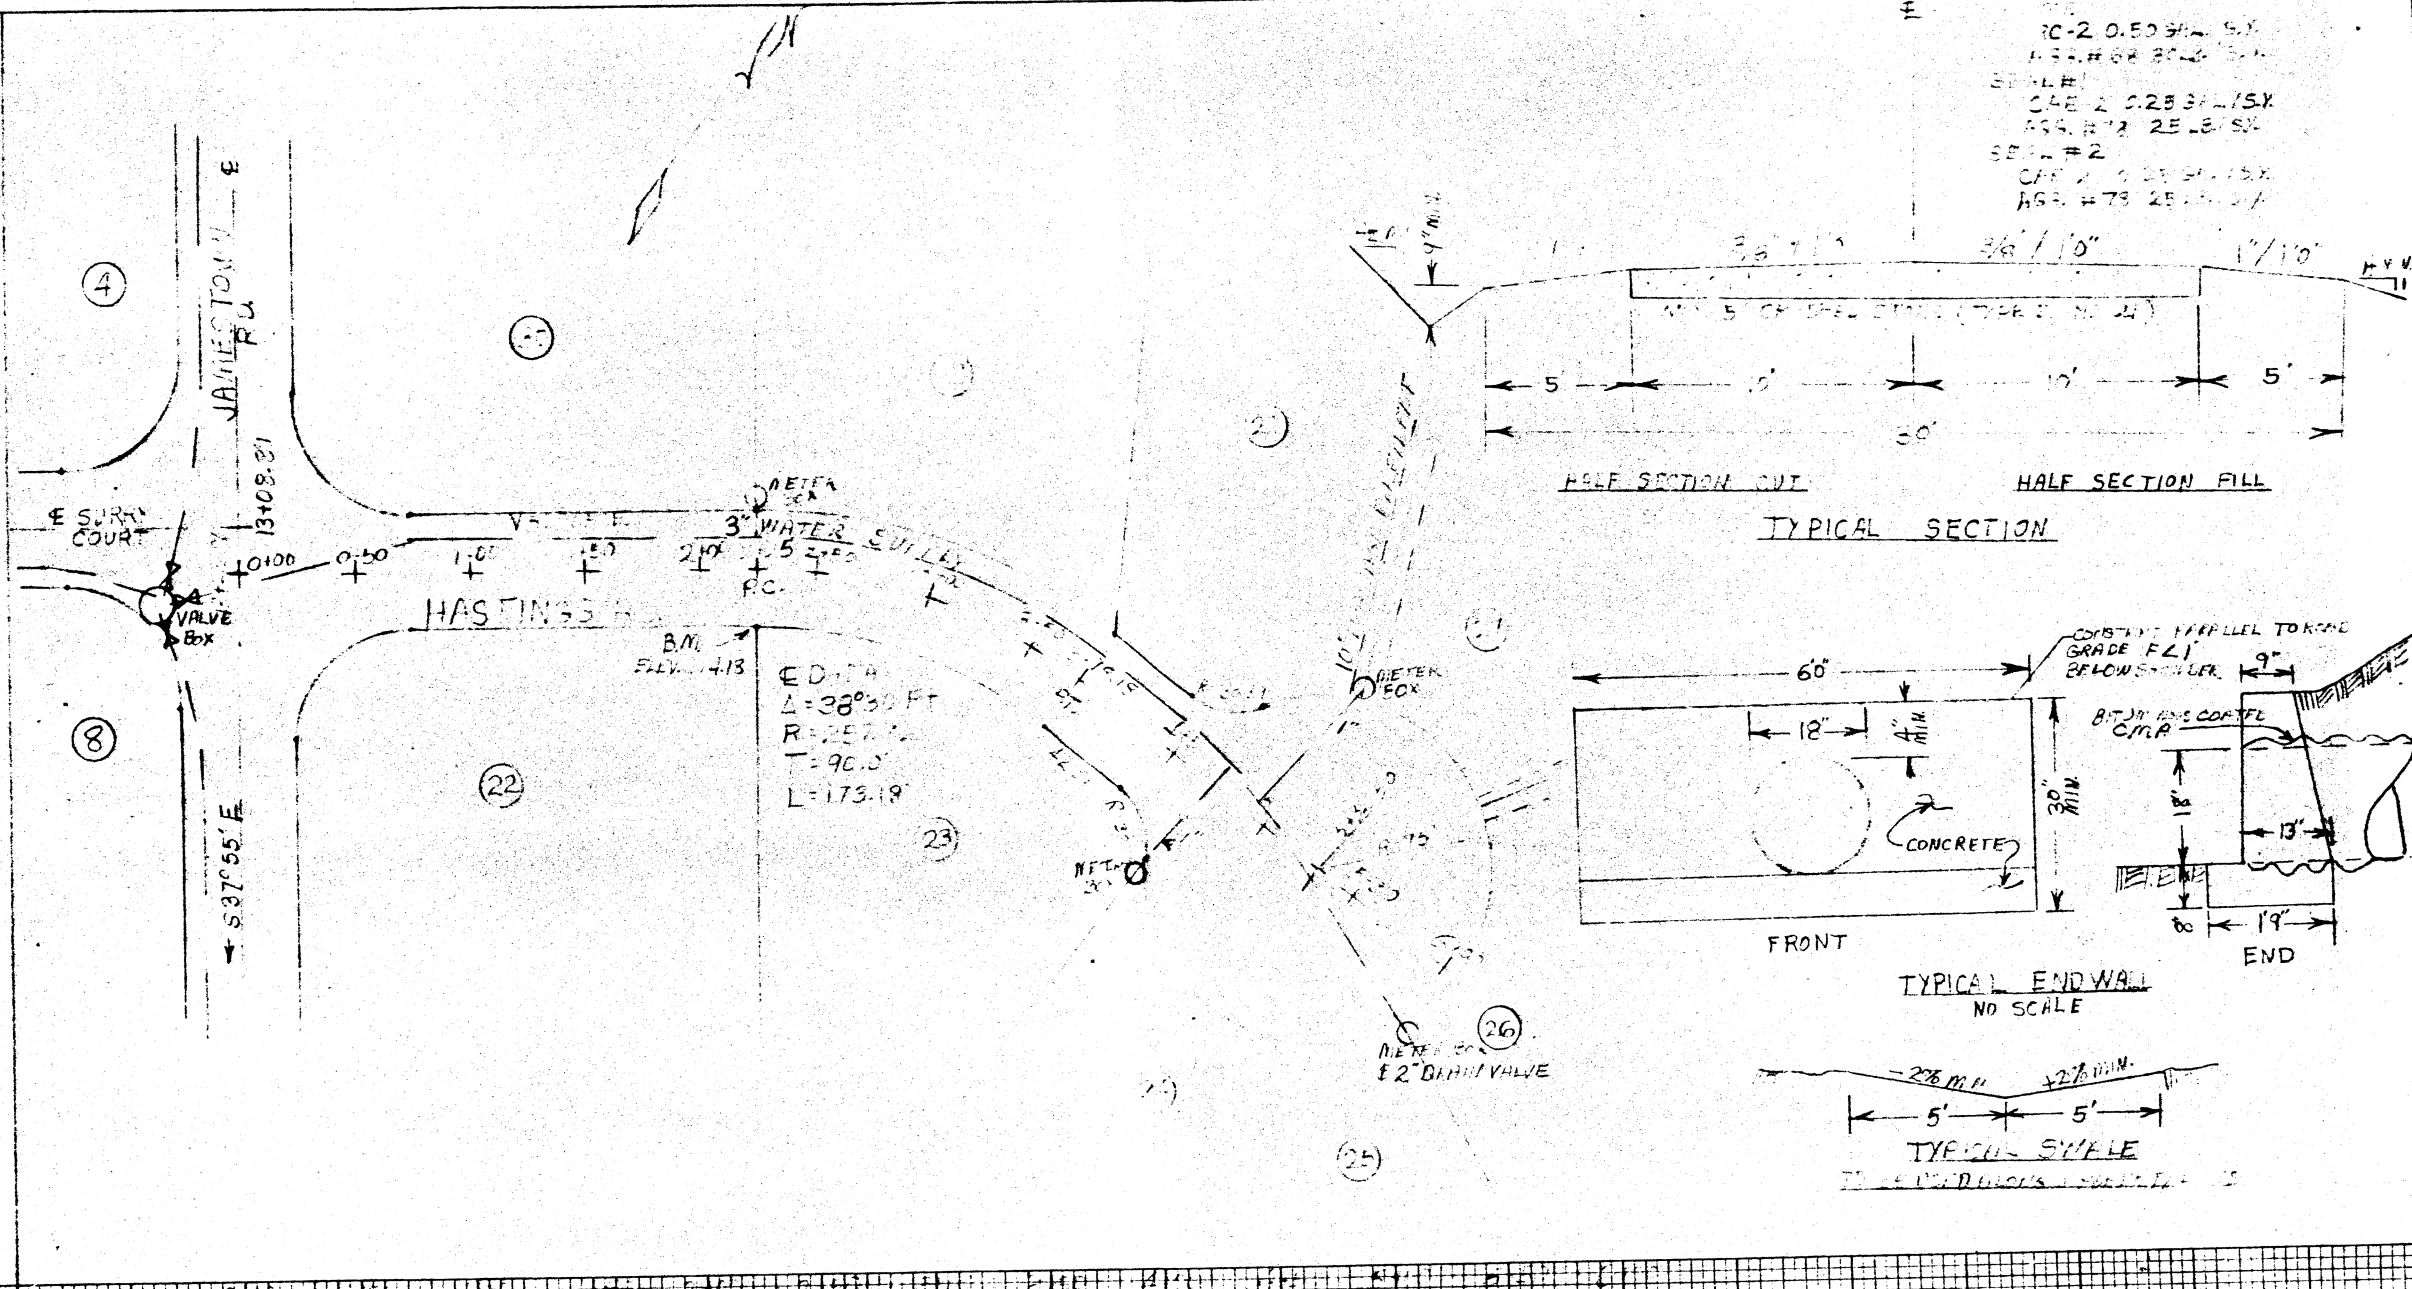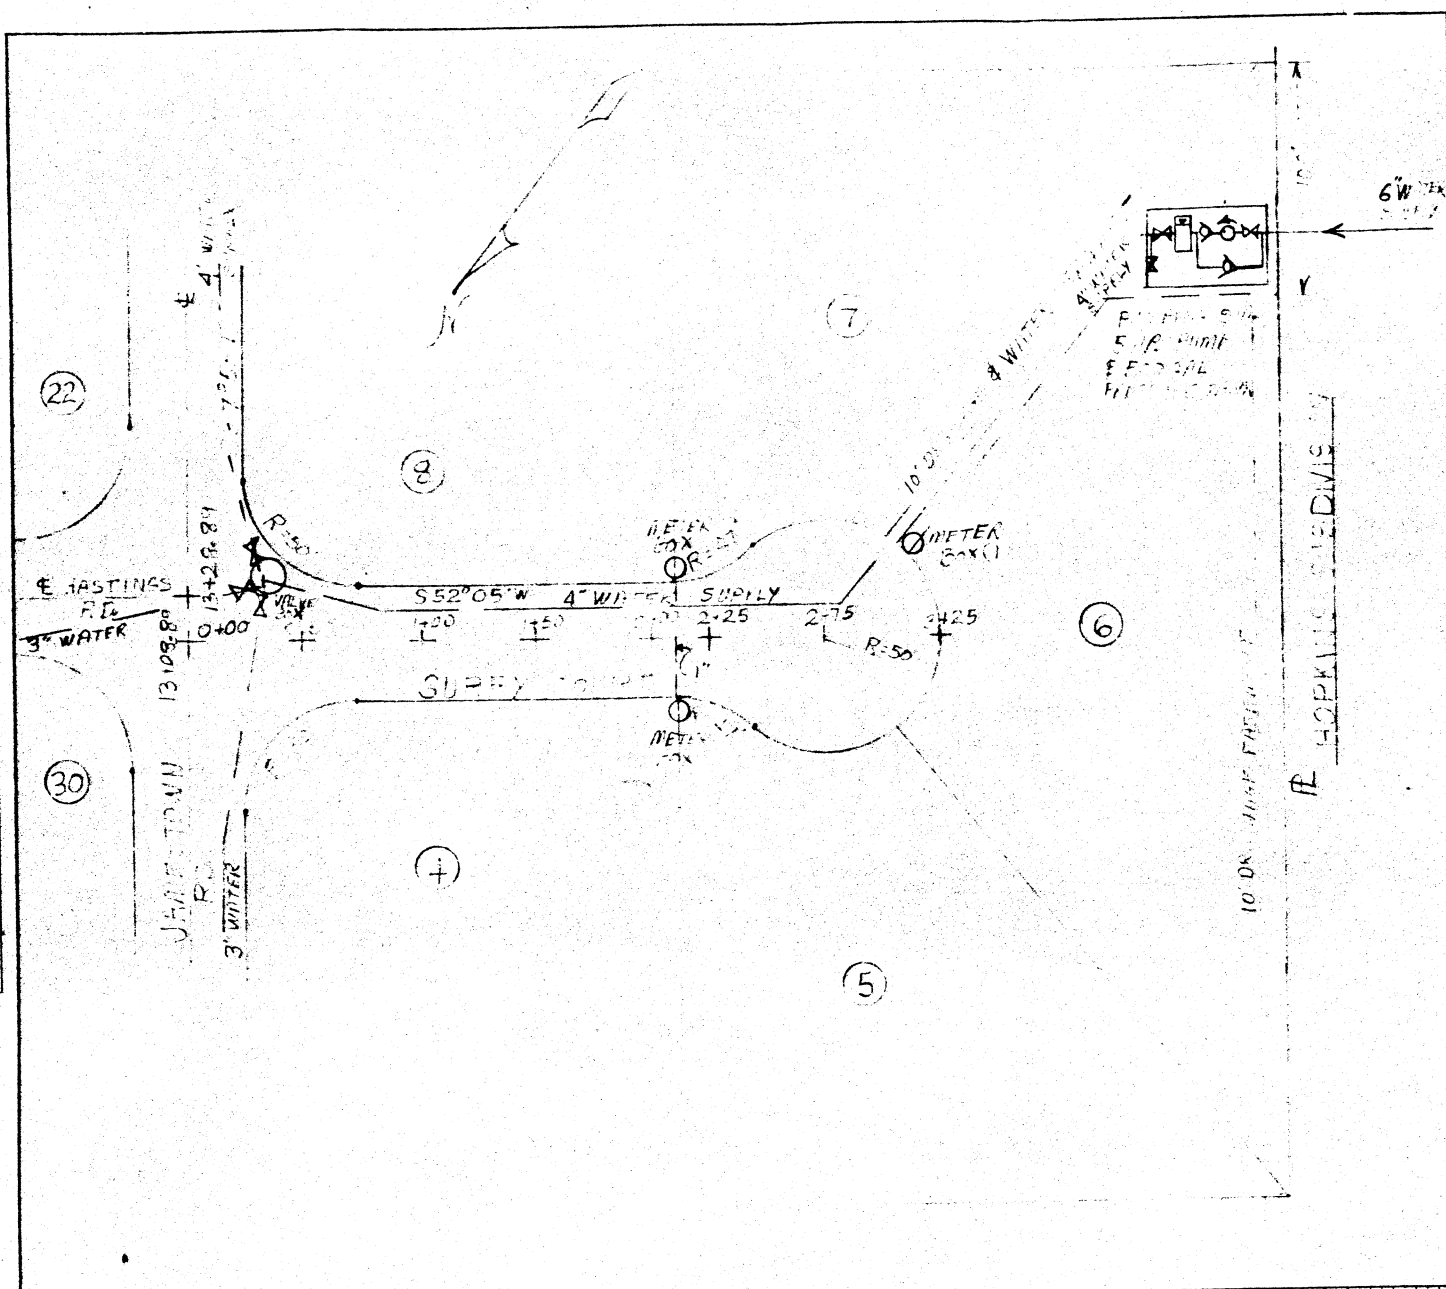

REF 132

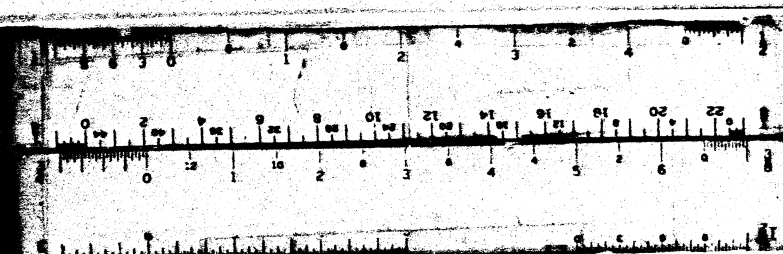

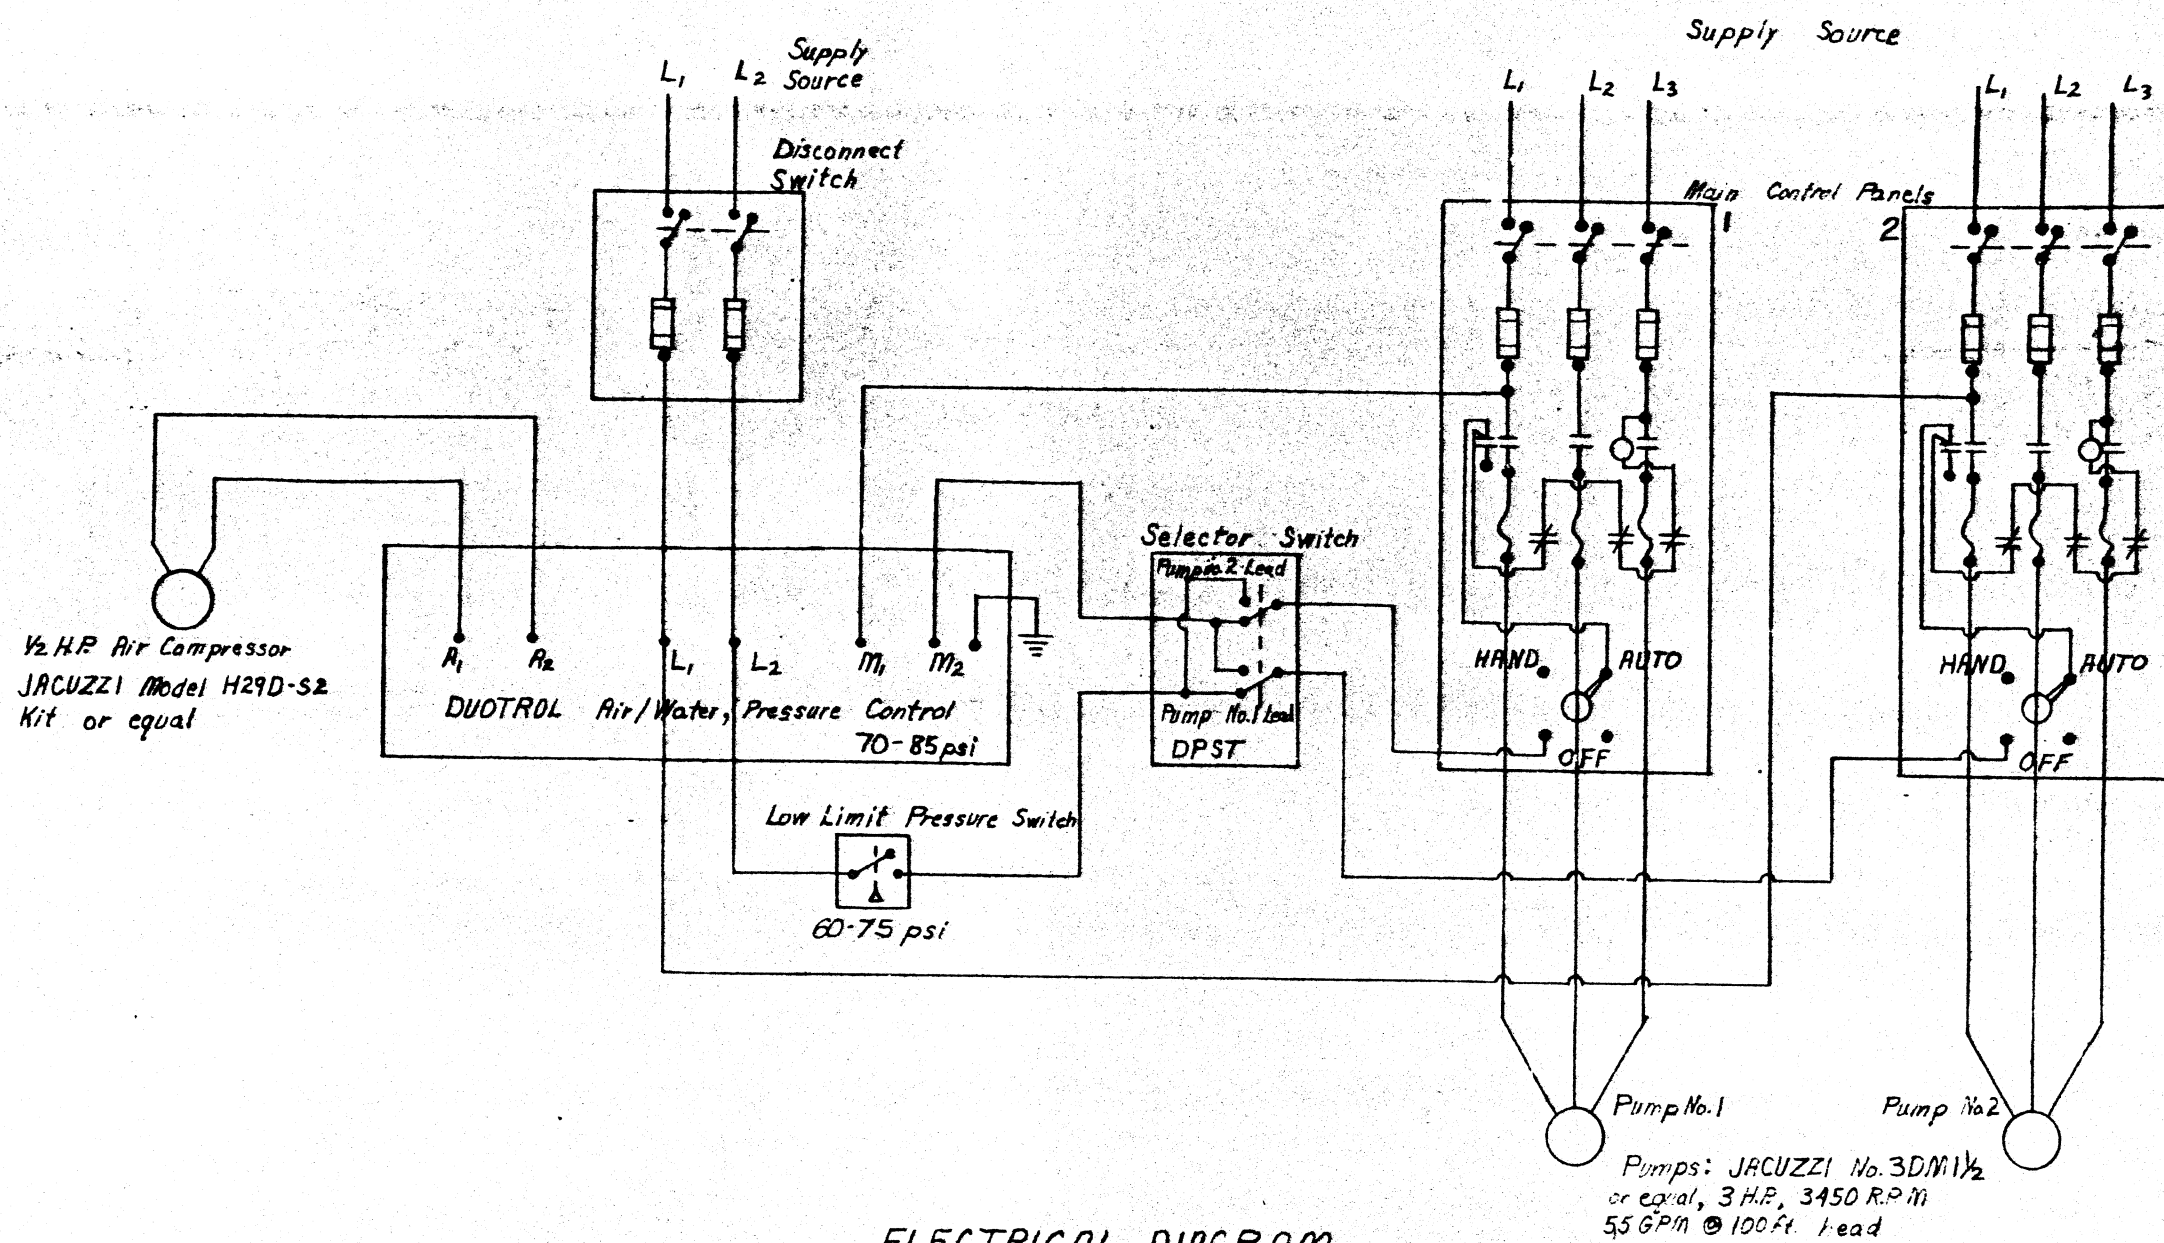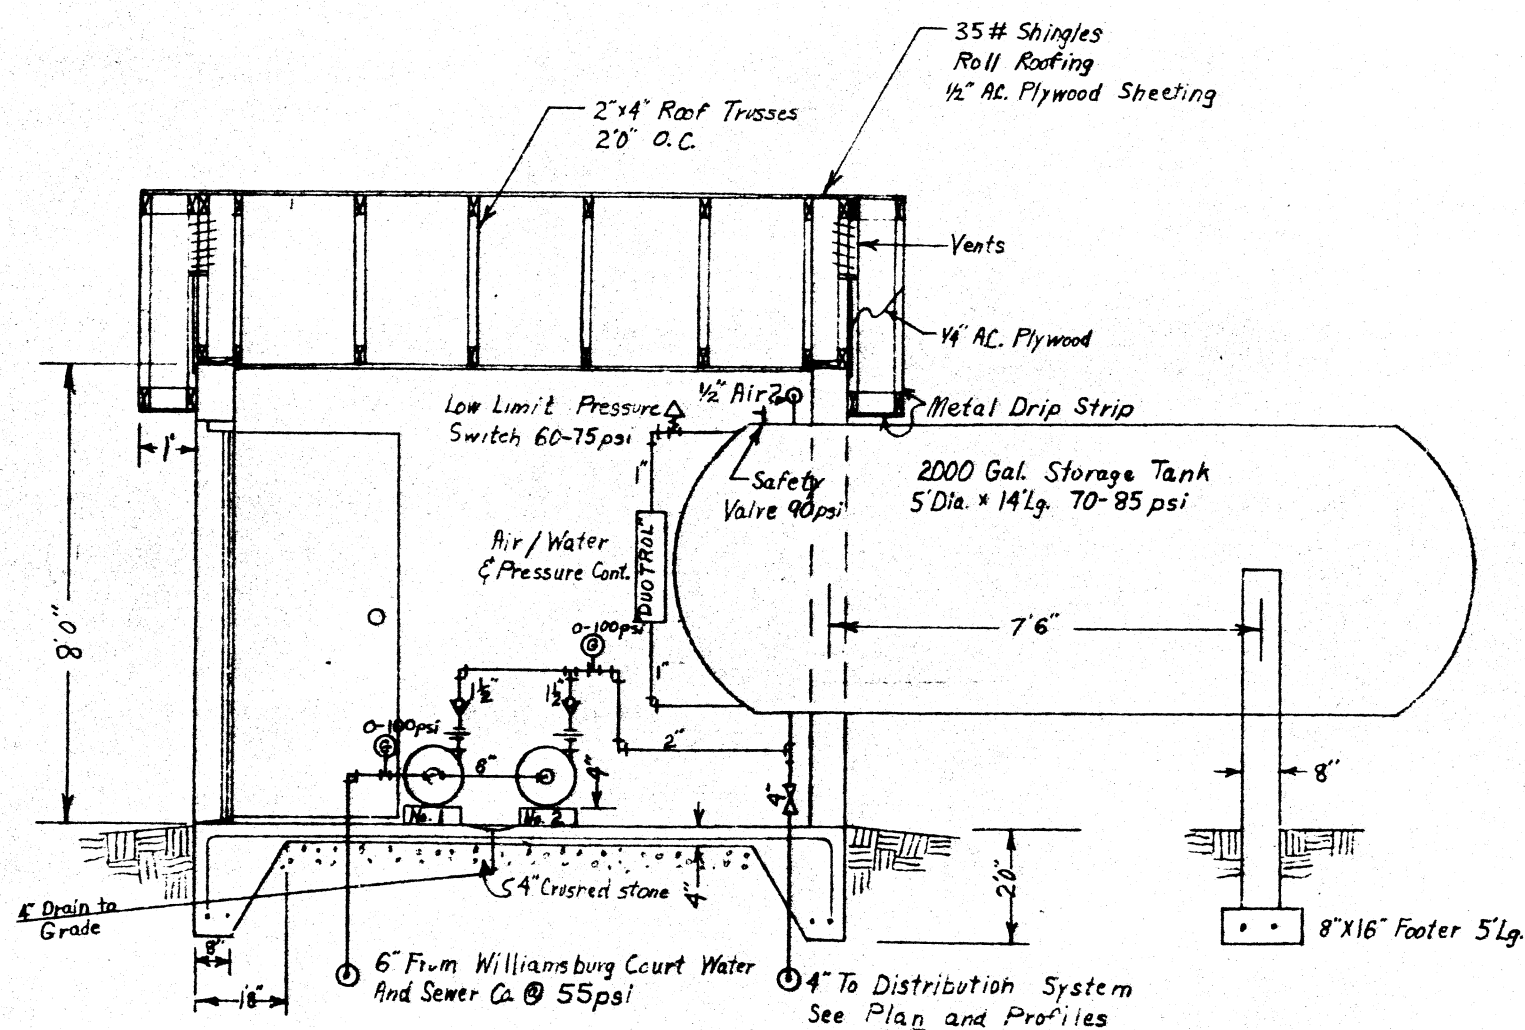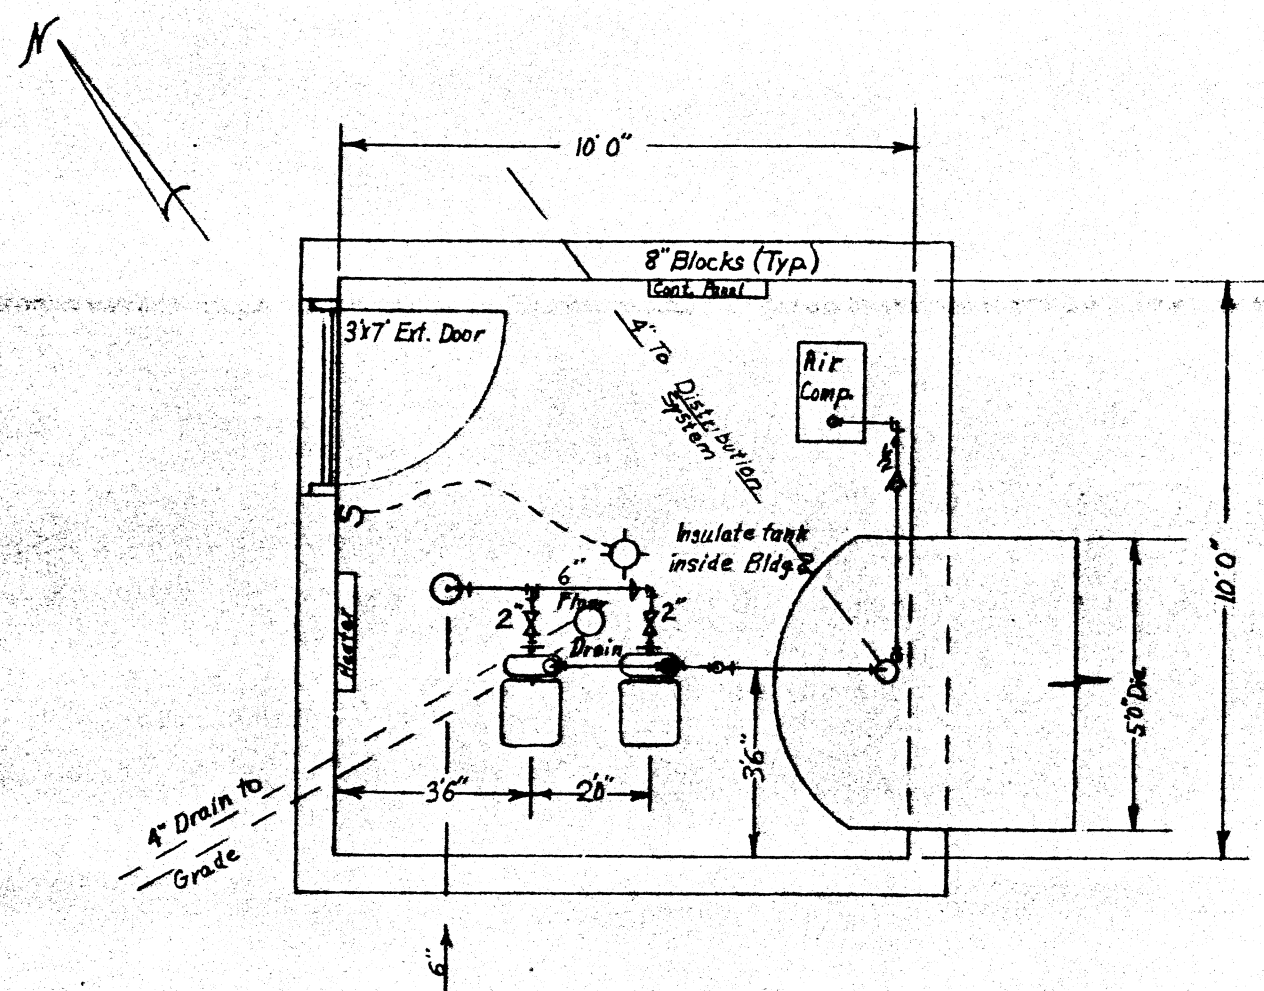

NOTES:
When selector switch is in position shown, pump no. 1 operates as lead pump and pump no. 2 will operate only if pump no. 1 fails to maintain pressure.
When selector switch is in other position, pump no. 2 operates as lead pump and pump no. 1 will operate only if pump no. 2 fails to maintain pressure.

Electrical work shall be done in accordance with The National Electric Code.

Building and pipe work shall be in accordance with state & local codes.

Pressure tank shall comply with American Water Works Association requirements.

Design Data:
33 Single Family Residents x 2.5 g.p.m./connection = 83 g.p.m. peak requirement


Pipe materials shall be C.I. under booster bldg. and to 5 ft. from bldg., other underground pipe may be plastic as approved by the Va. Dept. of Health.

APPROVED: _____ Date: _____
Va. Dept. of Health


DRINKING WATER BOOSTER STATION
FOR
JAMESTOWN SUBDIVISION
Amsterdam Dist. Botetourt Co. Va.
C. G. Meredith C.I.S. Roanoke, Va.
Drawn by: B.R. Shrader, June 18, 1973

132-023-2339.1-8

REEL 132

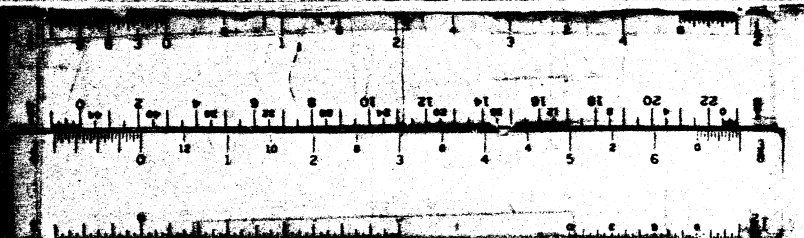

PLAT OF
GREENACRES
 PROPERTY OF L. G. N., INC.
 BOTETOURT CO., VIRGINIA
 SCALE: 1" = 50' NOV. 17, 1972
 BY: T. D. PARKER & SON
 ENGINEERS & SURVEYORS

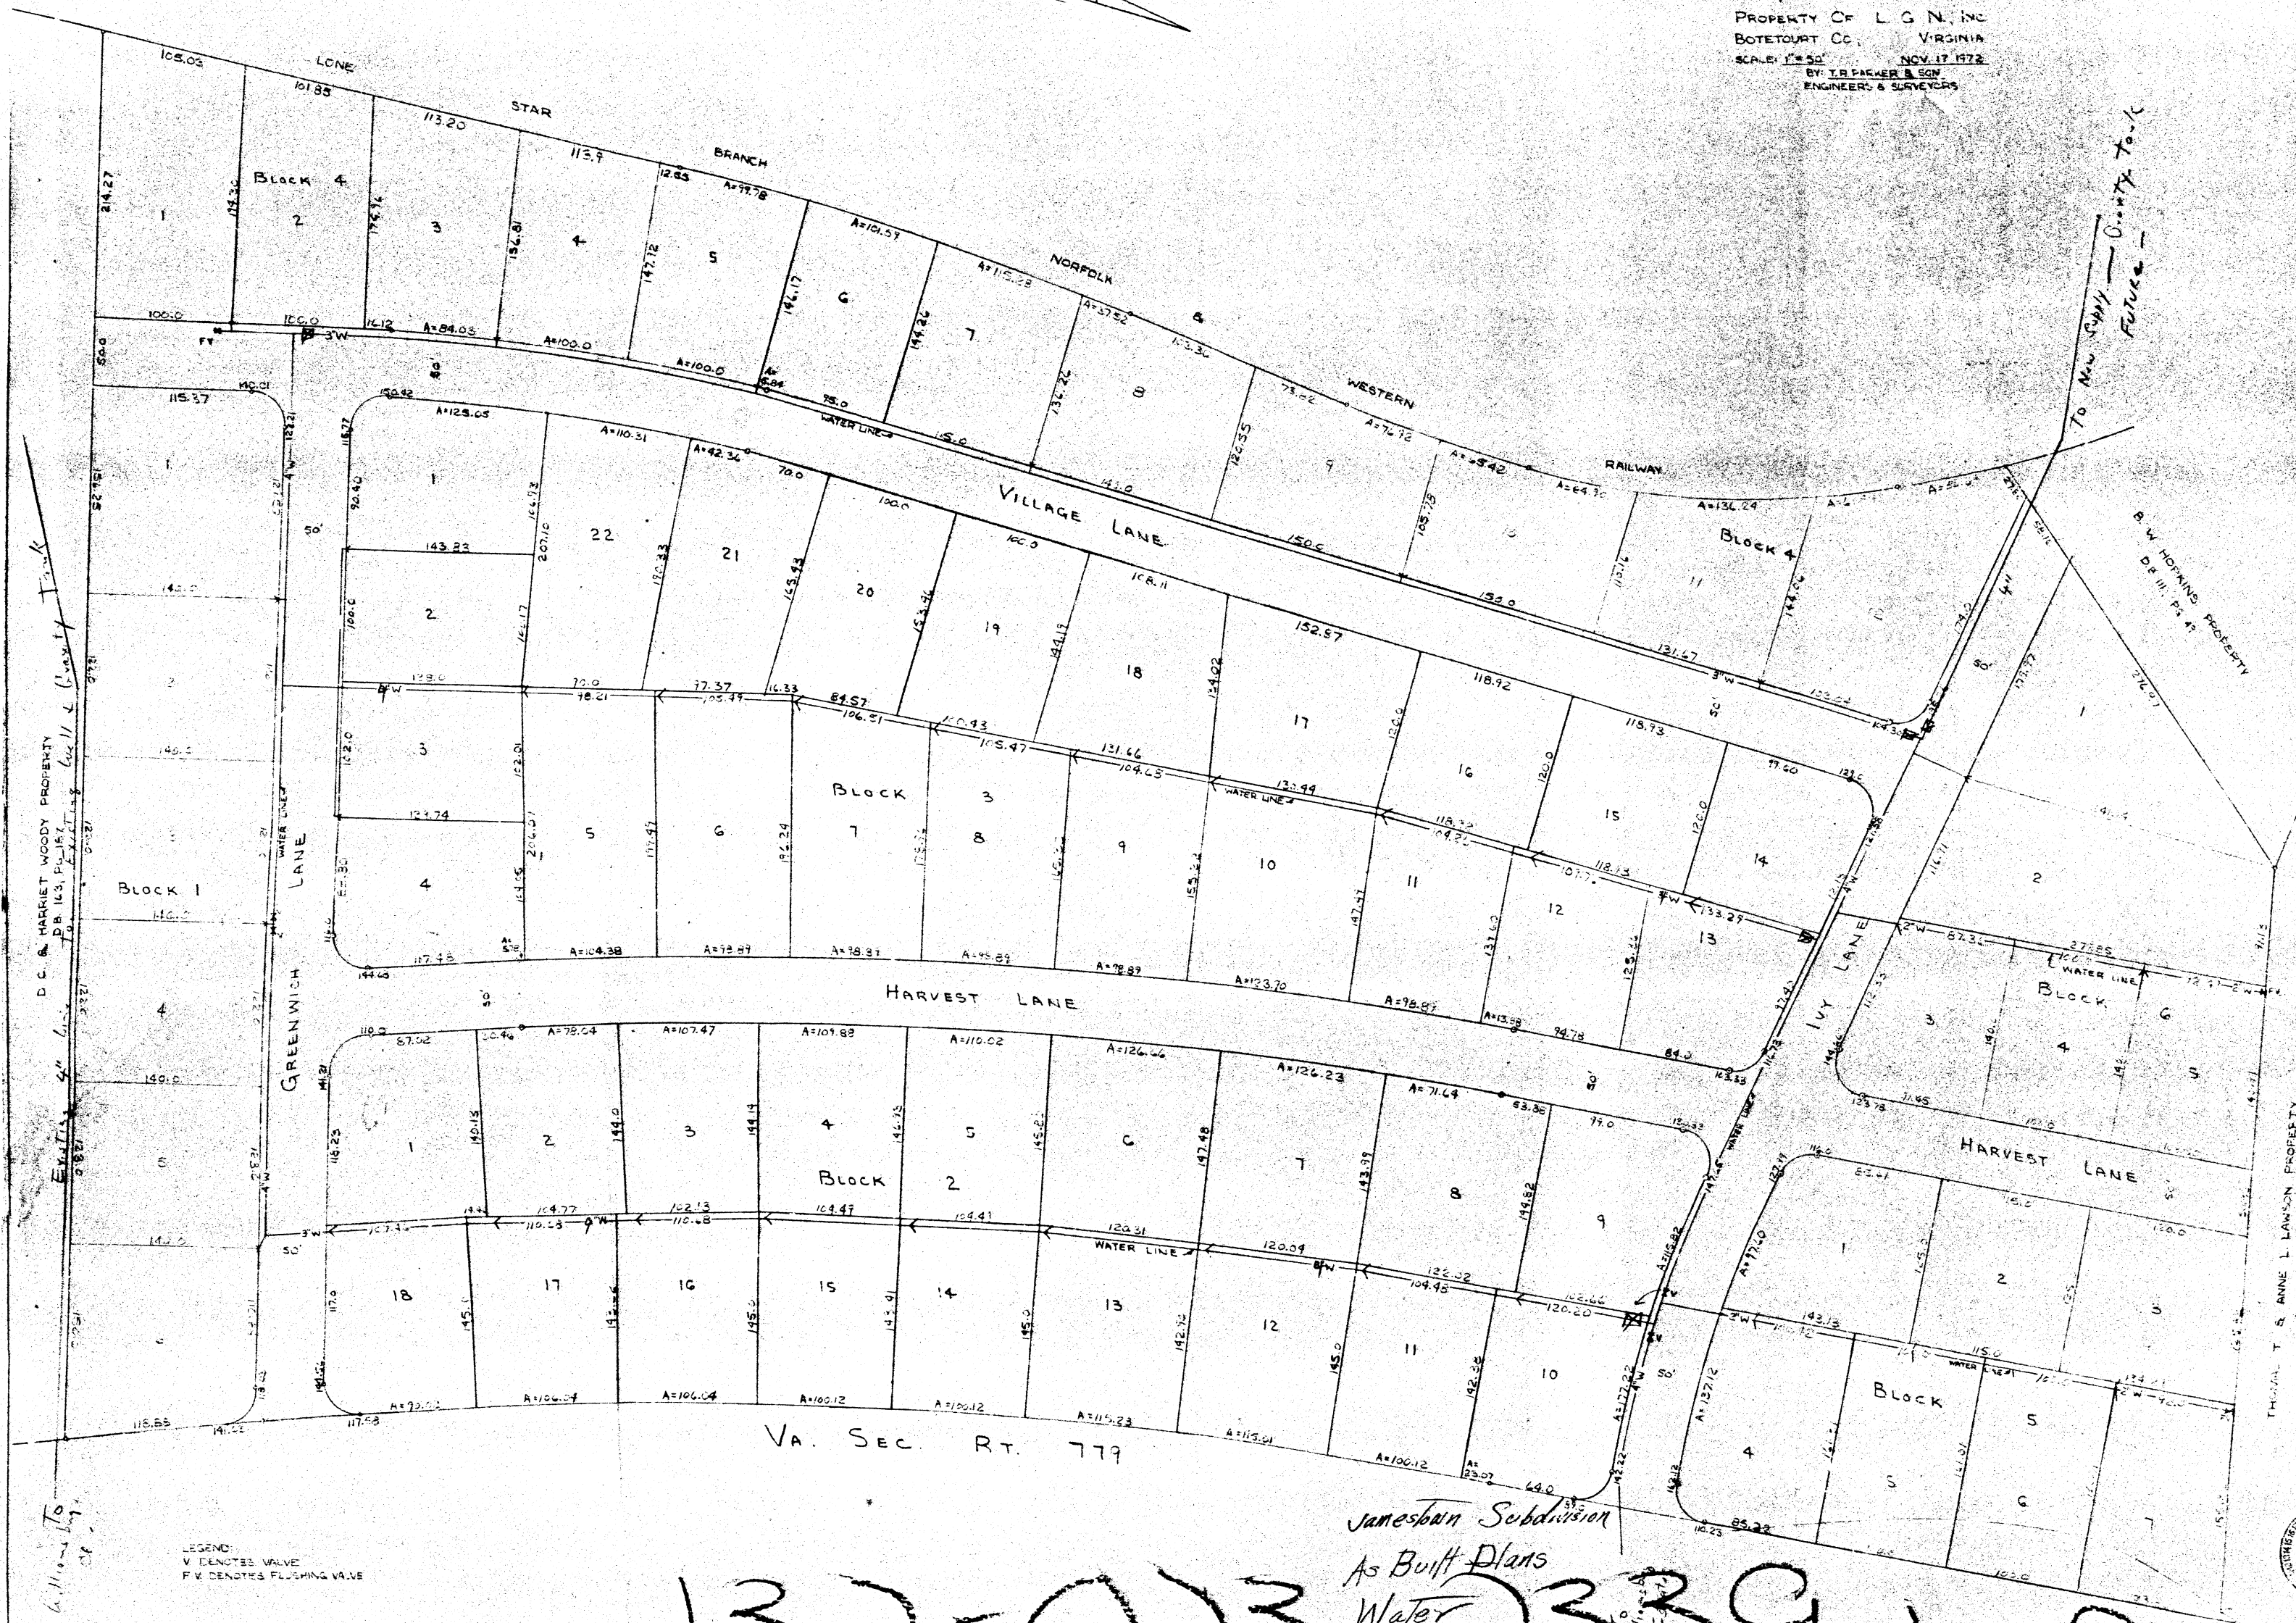


LEGEND:
 V DENOTES VALVE
 F.V. DENOTES FLUSHING VALVE

Botetourt Co. - Williamsburg
 Estates - Jamestown Subd.
 As Built Plans


132-023-2339.1-9
 Jamestown Subdivision
 As Built Plans
 Water




NOTES:
 1. WELL NO. 4 FIELD - 7.5 GPM
 2. WELL NO. 4 PUMP - 1/2 HP - 24 STAGE
 3. SINGLE PHASE 200 VOLT SUPPLY
 4. NEW WELL IS SUPPLEMENTAL SUPPLY FOR EMERGENCY OR STATION
 5. USES CONTROLS ARE TO BE MANUALLY OPERATED AND VULN
 6. SEPARATELY FROM EXISTING SYSTEM

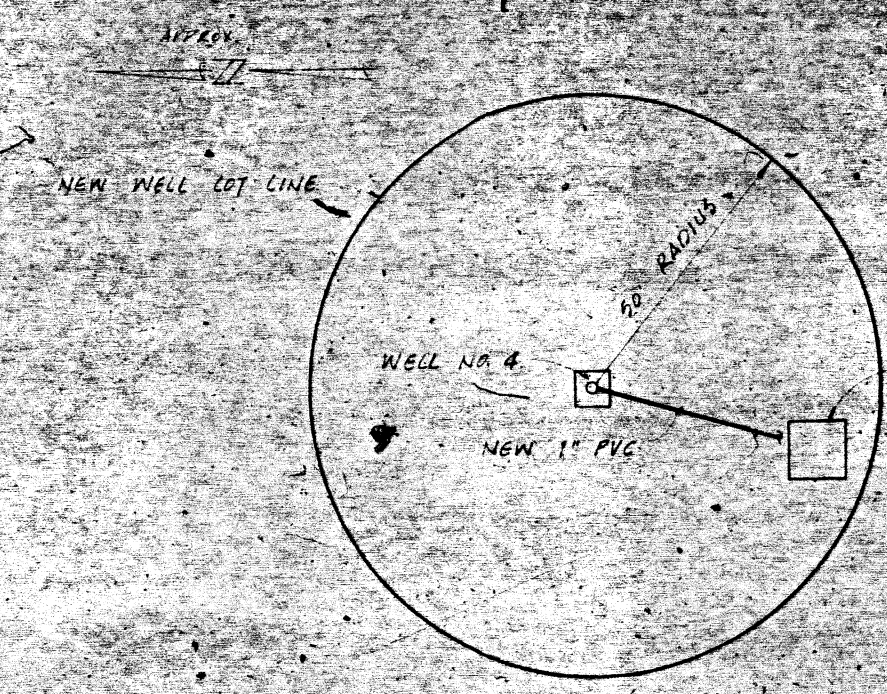


SITE PLAN
 SCALE: 1" = 20'

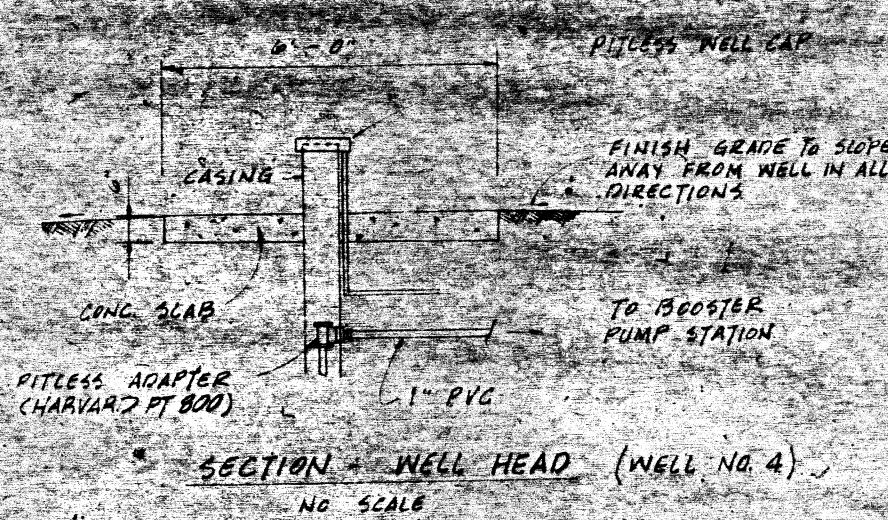

SECTION - WELL HEAD (WELL NO. 4)
 NO SCALE

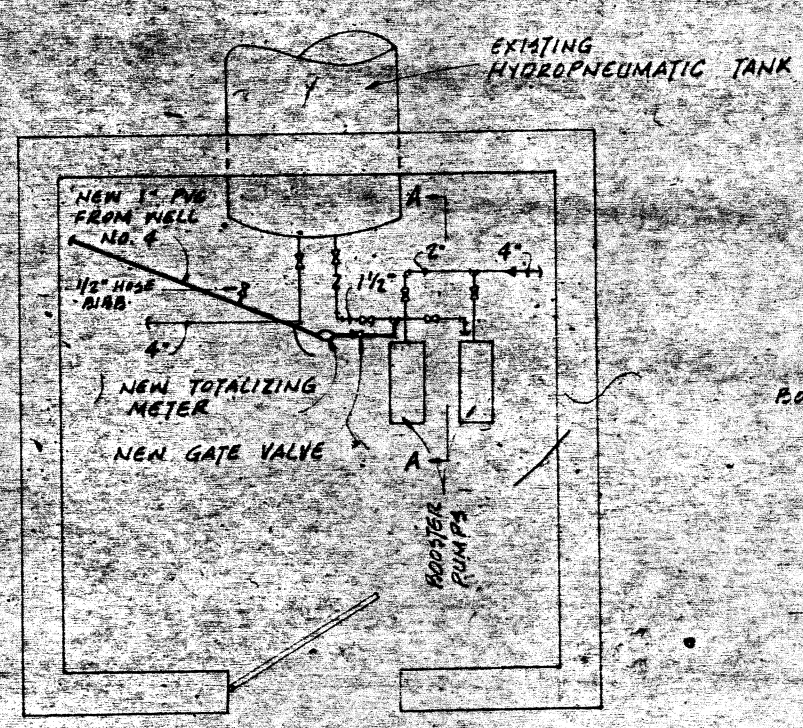

SCHEMATIC LAYOUT
 EXISTING BOOSTER PUMP STATION
 NO SCALE

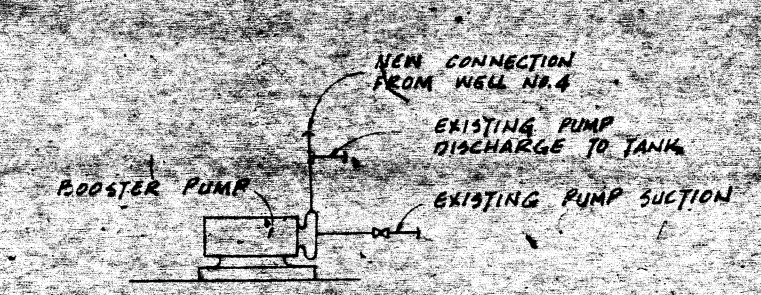

SECTION A-A
 CONNECTION AT BOOSTER PUMP

VIRGINIA DEPARTMENT OF HEALTH
 Approved by: *[Signature]* Director
 Date: 7/5/87



PLAN
 SHOWING
 SUPPLEMENTAL WATER SUPPLY
 FOR
WILLIAMSBURG COURT WATER COMPANY
 BOTETOURT COUNTY, VIRGINIA

SCALE: AS SHOWN DATE: 3 JULY 1987
 REV. 13 OCT. 1987

AUFORD & GIFFORD'S ASSOCIATES, P.C.
 ENGINEERS AND SURVEYORS
 FARMERS, VIRGINIA



019-23323 181

Botetourt County