
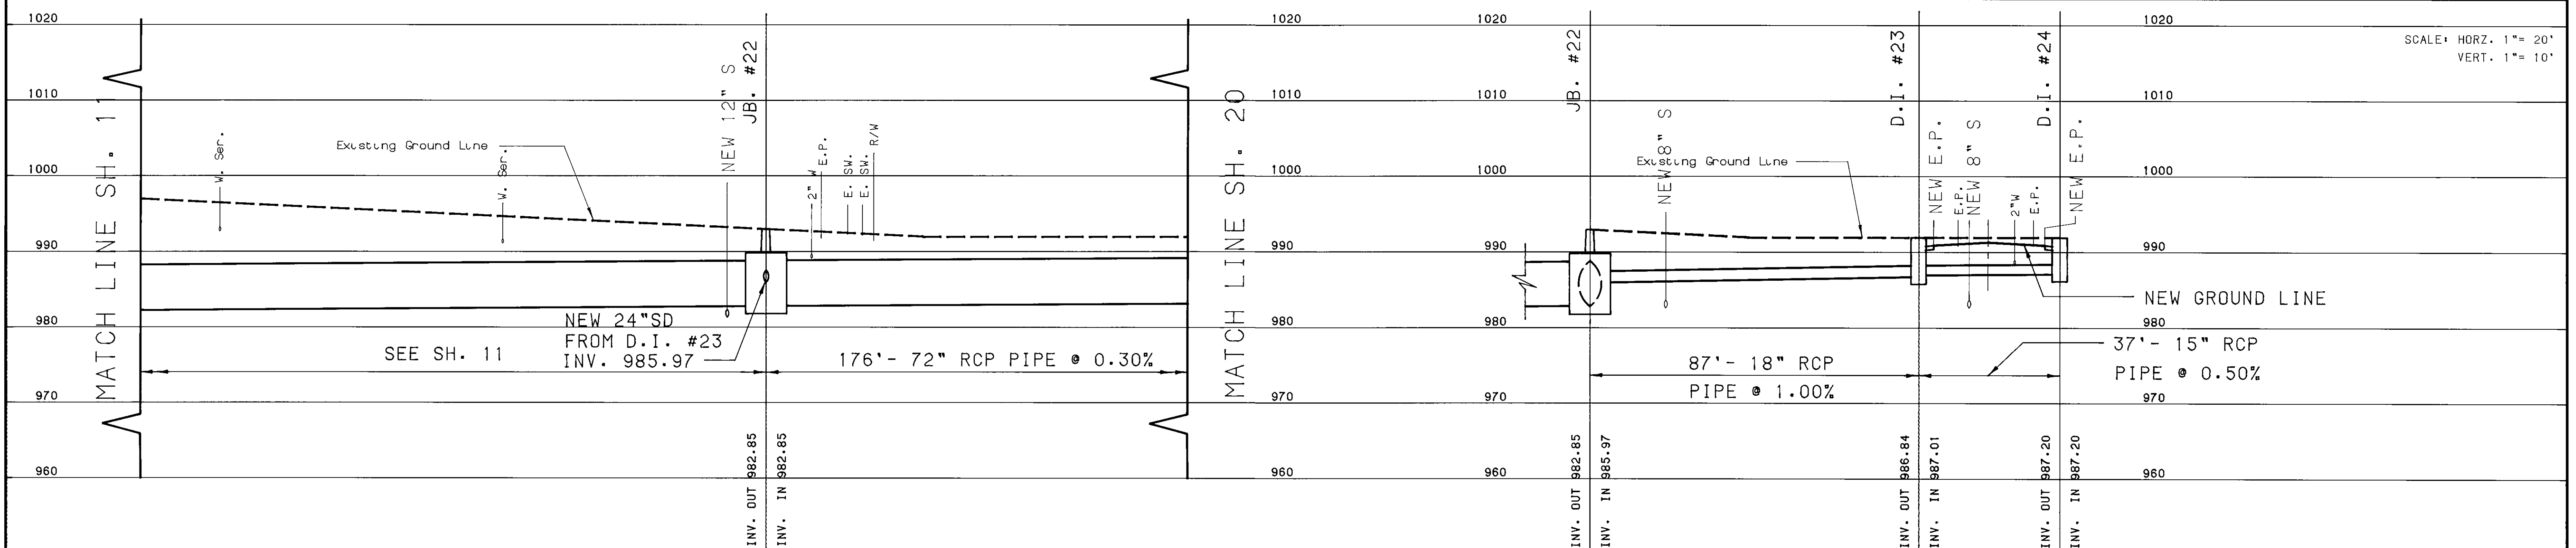


(FOR SANITARY PROFILE SEE SHEETS 53 AND 54) MATCH LINE STA. 46+60 SH. 20

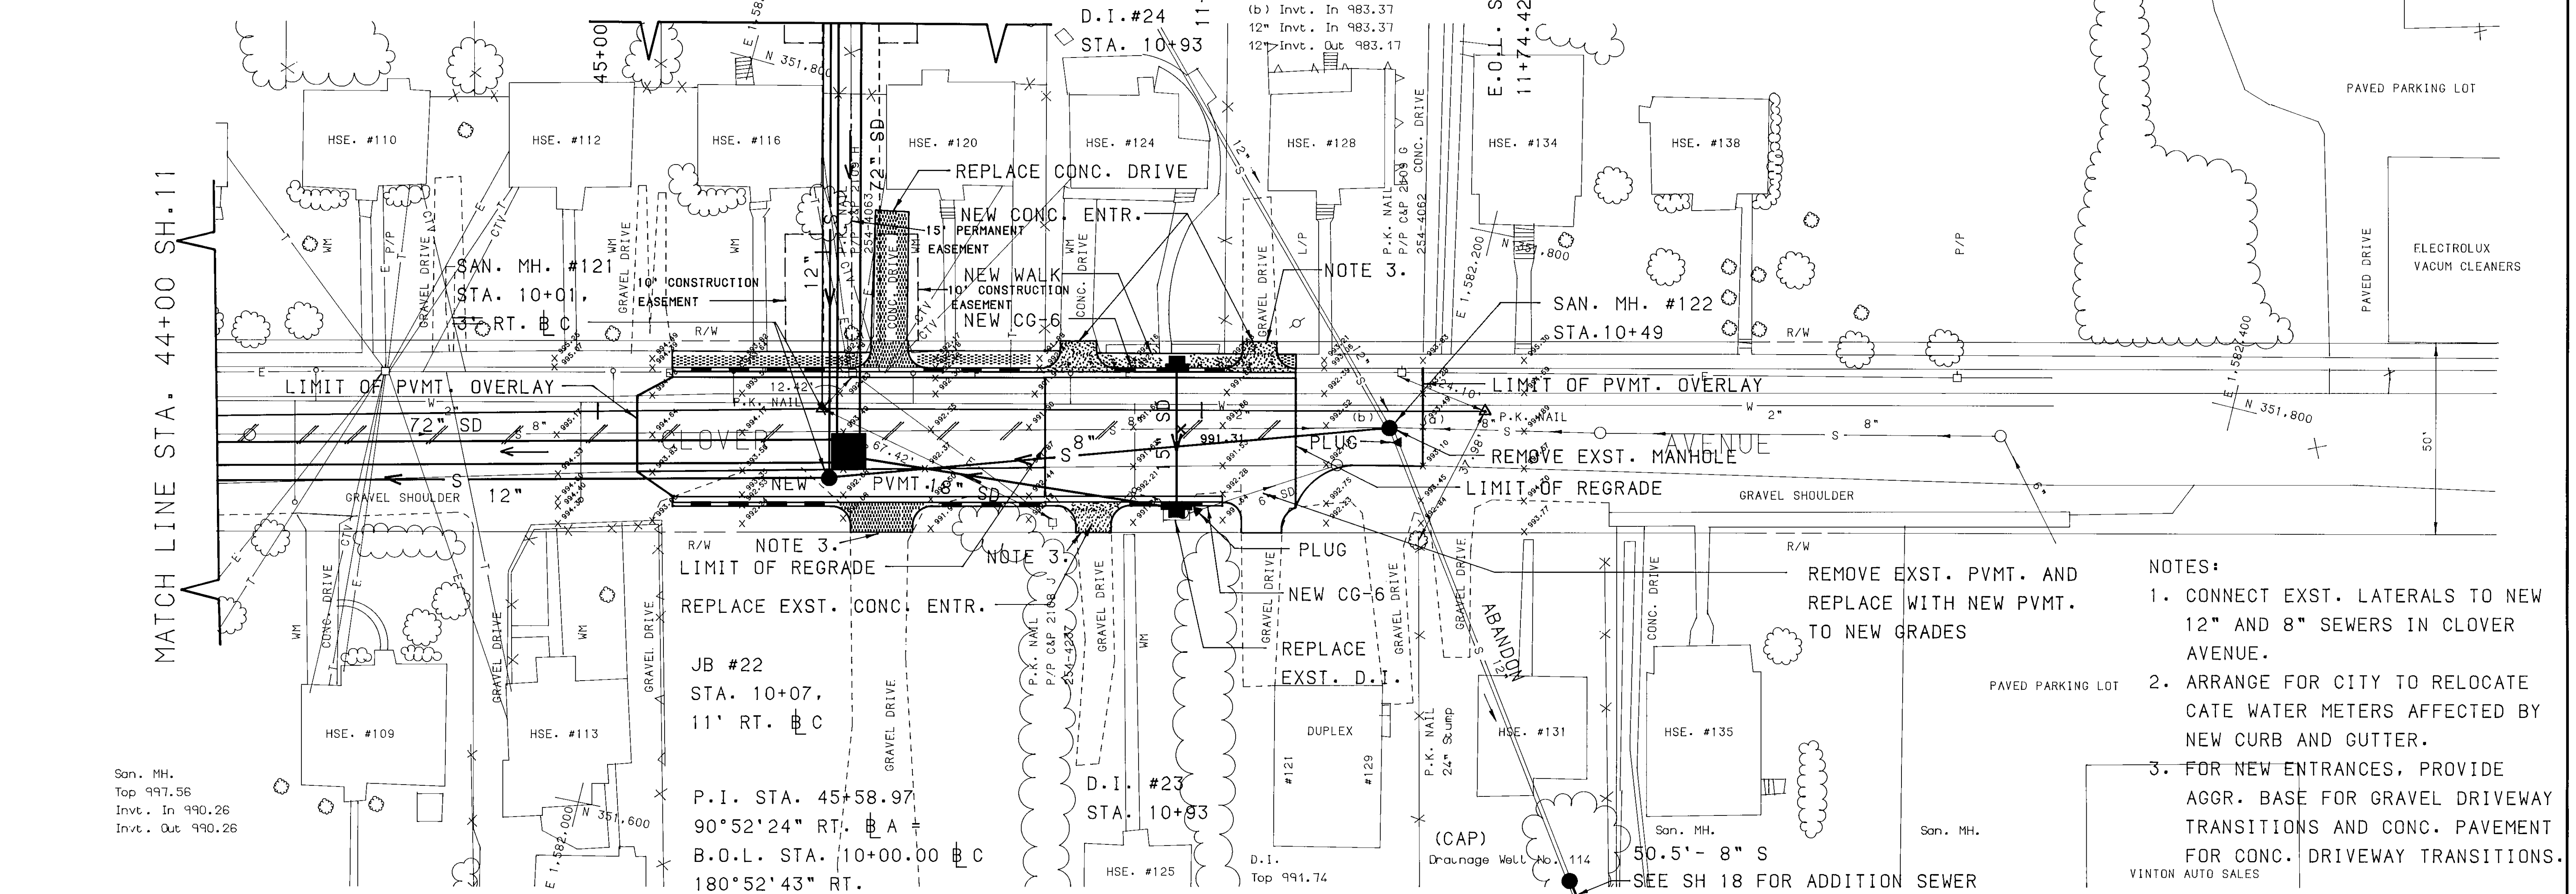

 Mattern & Craig CONSULTING ENGINEERS - SURVEYORS 701 FIRST STREET, ROANOKE, VIRGINIA 24016. (703) 345-0342	DESIGNED:	 	REVISION	DATE	DESCRIPTION	BY	APP.	DATE JULY 1987 COMM. 580/581	WILLIAMSON ROAD STORM DRAIN- PHASE 2 CONTRACT II-A ROANOKE, VIRGINIA	SHEET 19
	CHECKED:		1	DEC. 89	RECORD DRAWING	JLJ	SWH			
	APPROVED:									
PLAN AND PROFILE										