

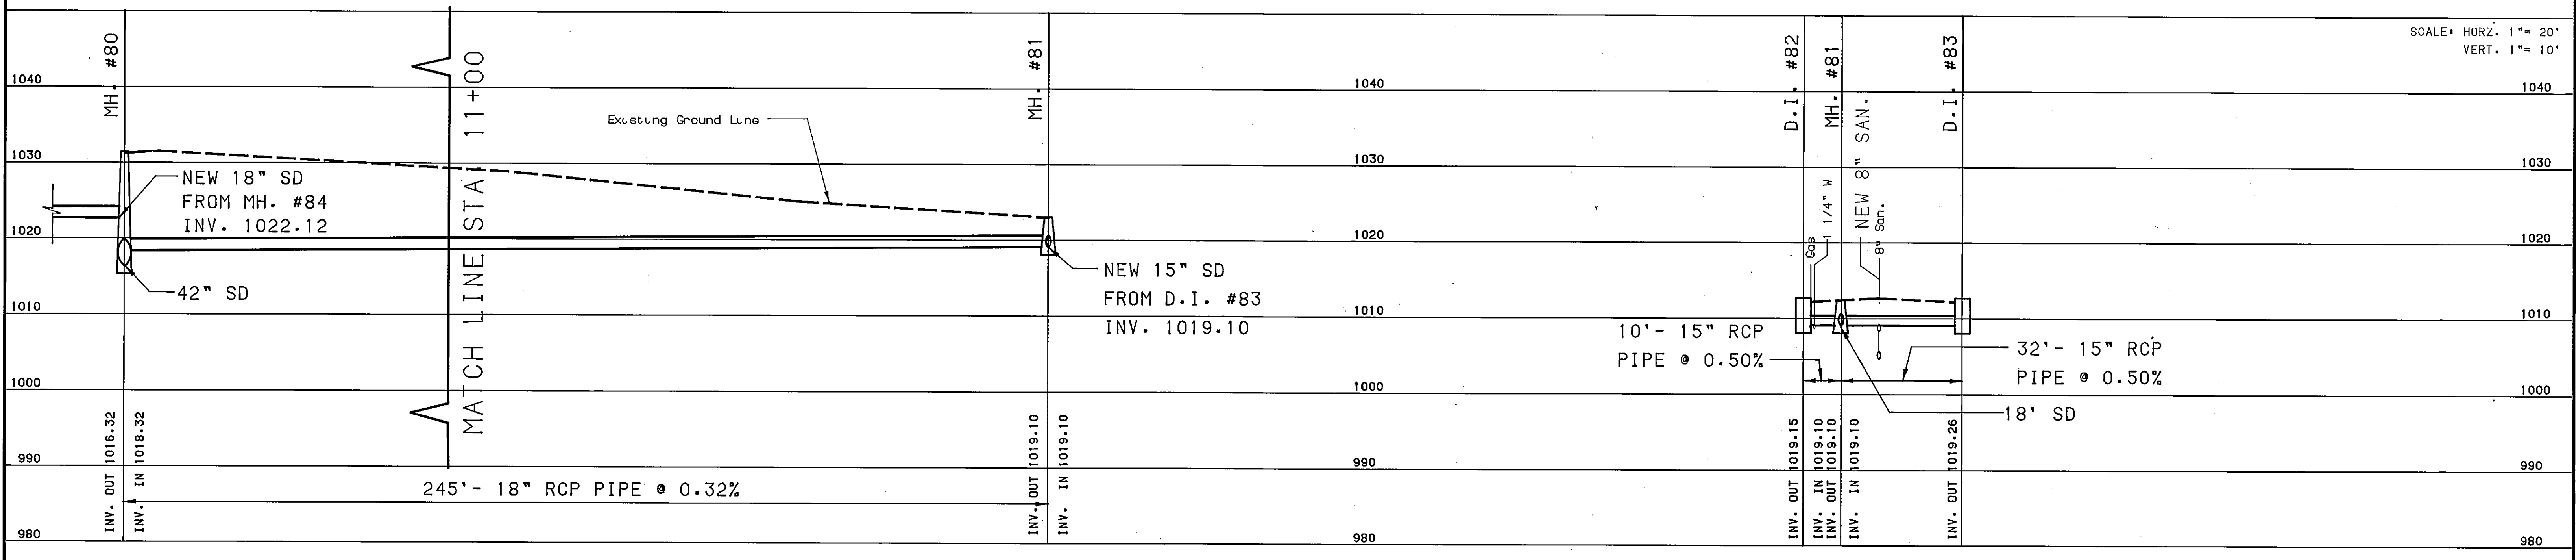


(FOR SANITARY PROFILE SEE SHEET 61)

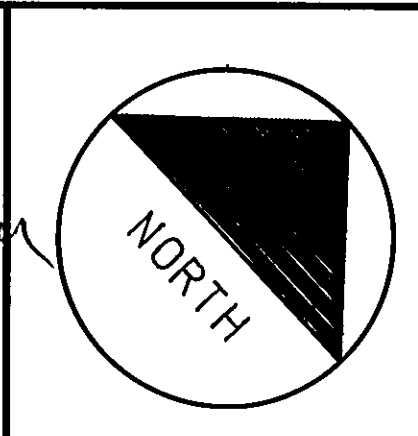

DESIGNED: ARB/SWH
 CHECKED: GRN
 APPROVED:

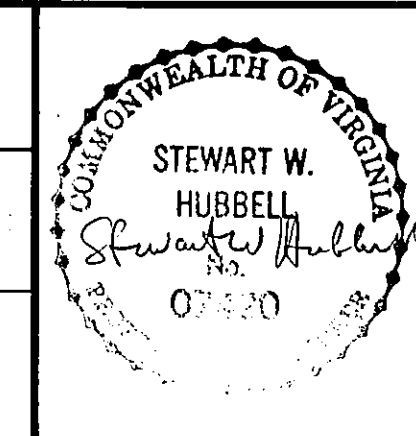

REVISION	DATE	DESCRIPTION	BY	APP.
1	DEC. 89	RECORD DRAWING	JLJ	SWH

DATE
JULY 1987
 COMM.
580/581

WILLIAMSON ROAD STORM DRAIN- PHASE 2
CONTRACT II-A
ROANOKE, VIRGINIA
PLAN AND PROFILE

SHEET
45