

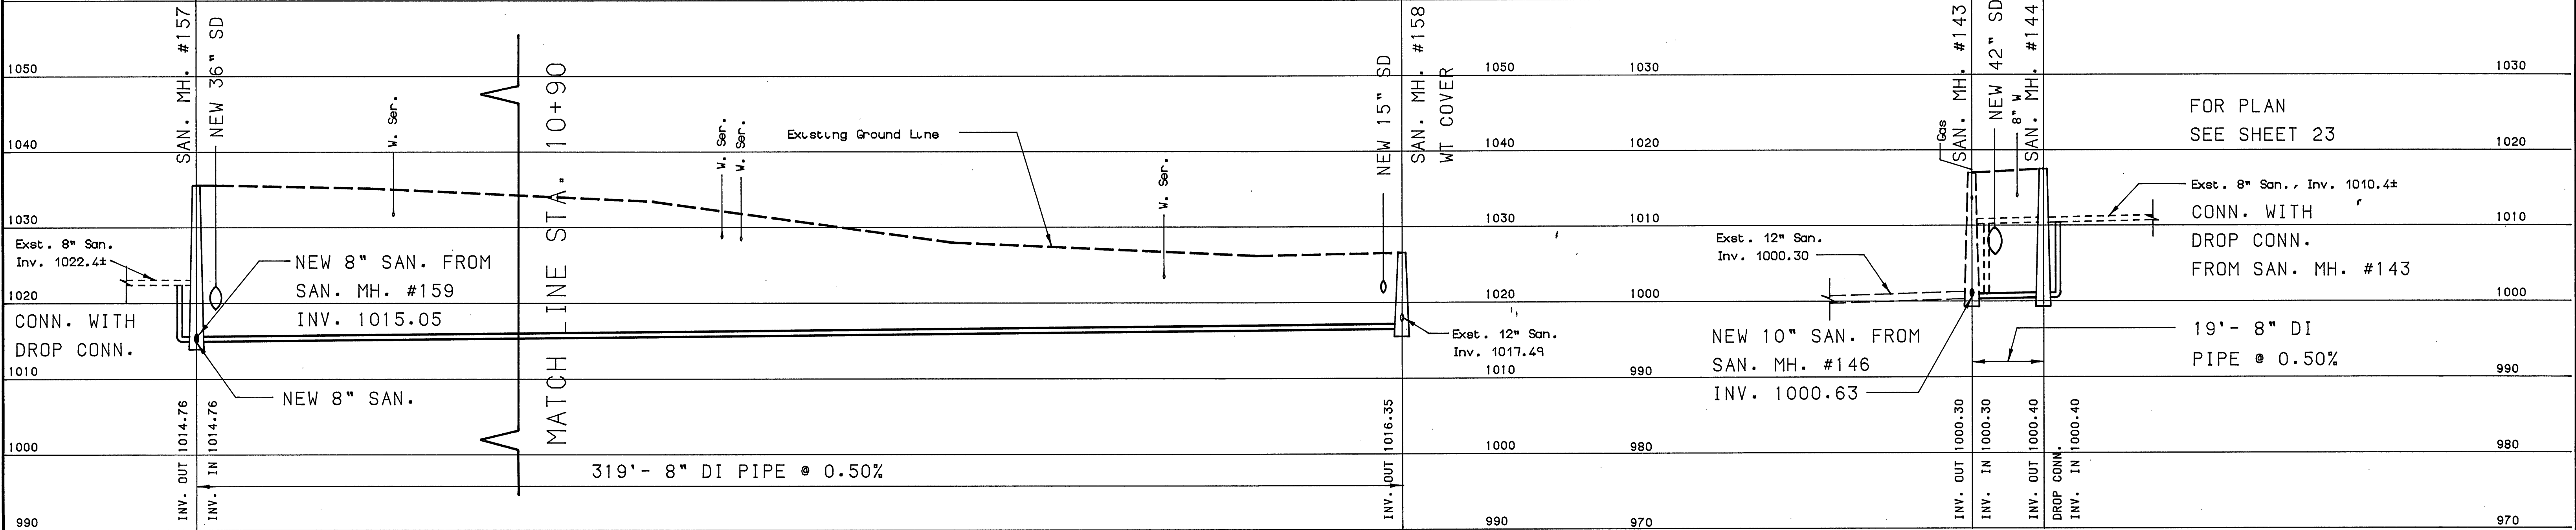
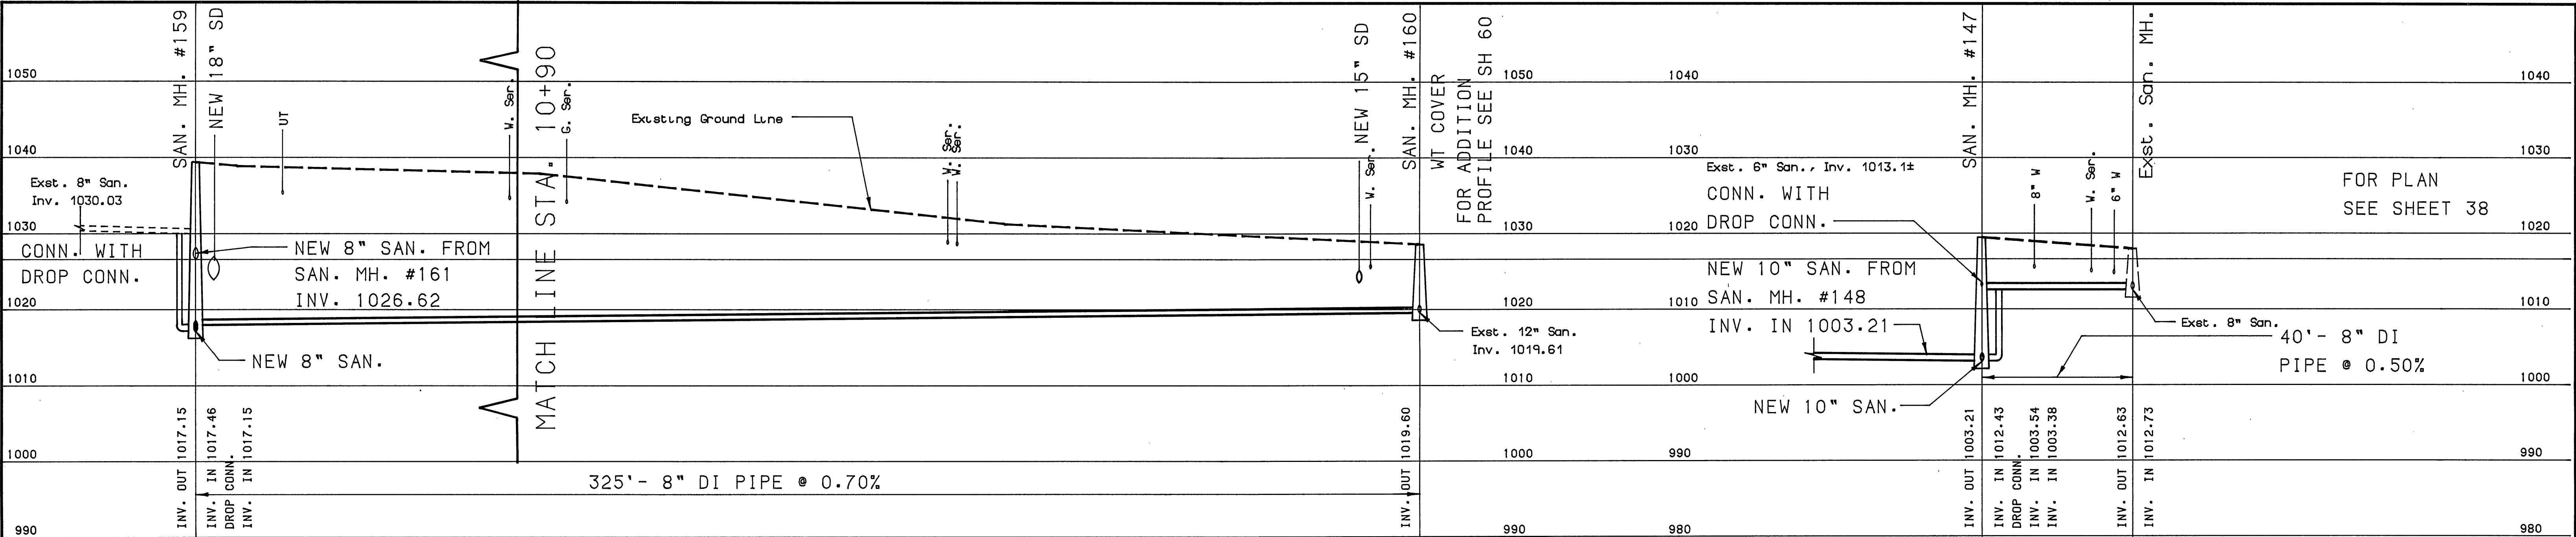


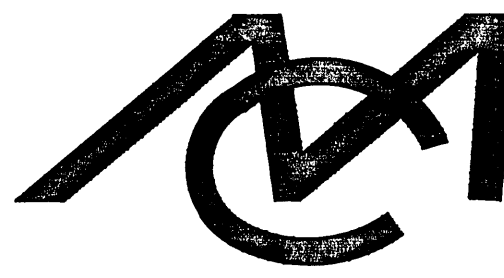

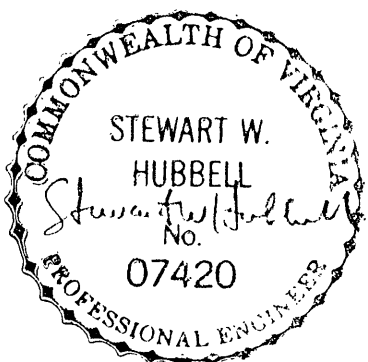

Mattern & Craig
CONSULTING ENGINEERS - SURVEYORS
701 FIRST STREET, ROANOKE, VIRGINIA 24016, (703) 345-9342

DESIGNED:	ARB/SWH		REVISION	DATE	DESCRIPTION	BY	APP.	DATE JULY 1987 COMM. 581	WILLIAMSON ROAD STORM DRAIN- PHASE 2 CONTRACT II-A ROANOKE, VIRGINIA	SHEET 61-A
CHECKED:	GRN		1	DEC. 89	RECORD DRAWING	JLJ	SWH			
APPROVED:										

PROFILE- SANITARY SEWER