


WESTERN VIRGINIA WATER AUTHORITY WILLIAMSON ROAD WATER MAIN REPLACEMENT & ROANOKE GAS COMPANY GAS MAIN REPLACEMENT

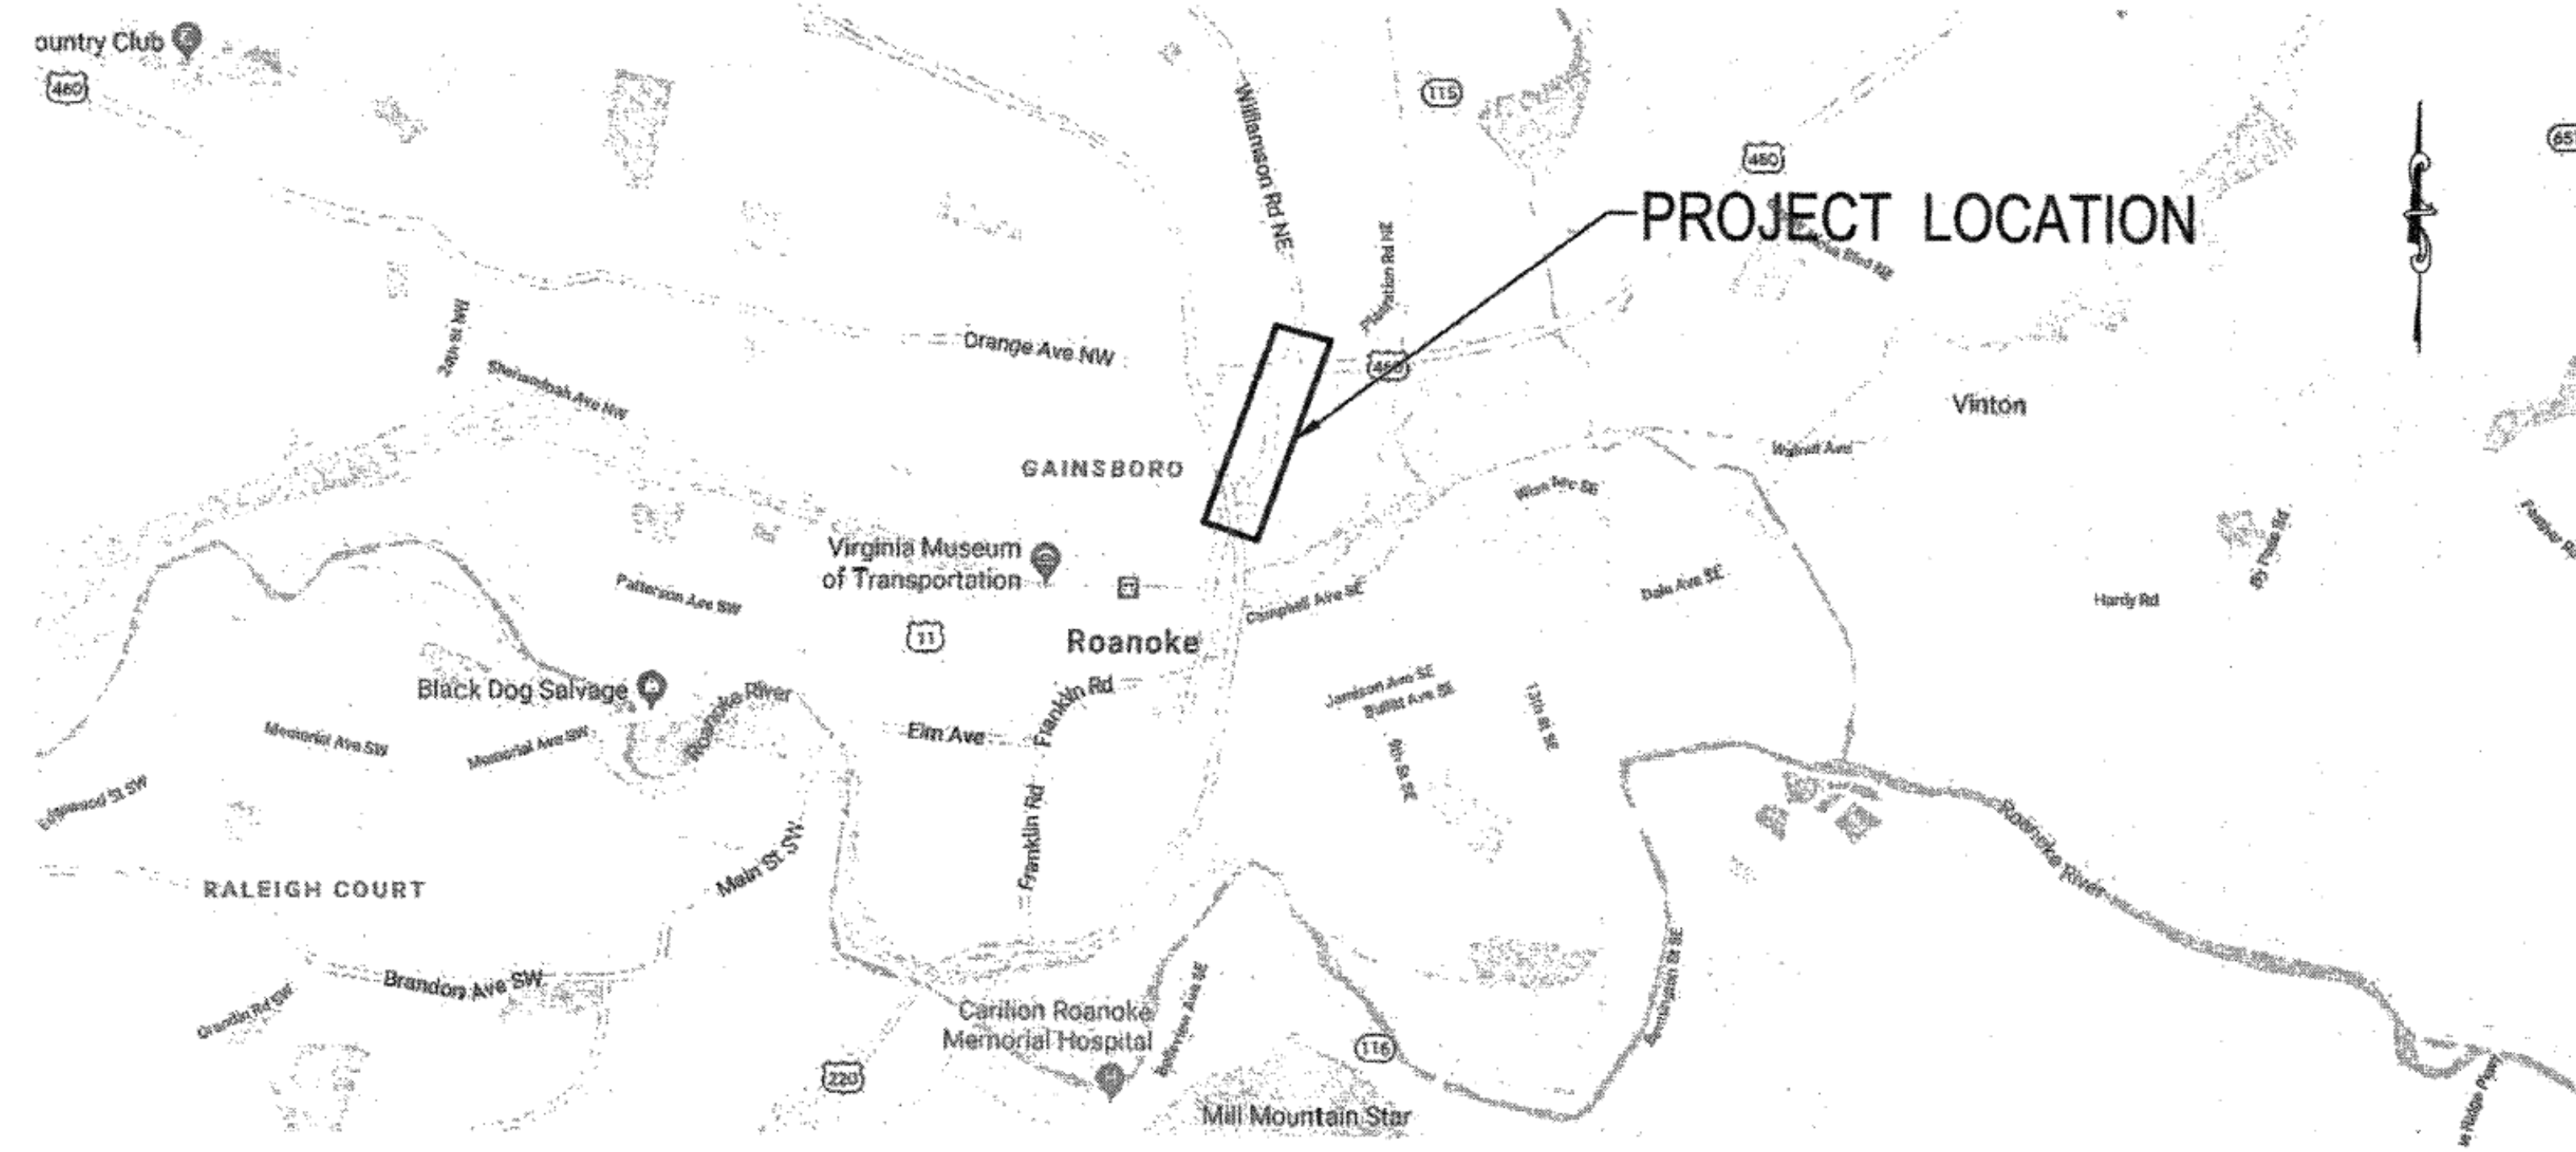

PLAN # WCIP-120
COURTLAND AVE AND ORANGE AVE


SEE SHEET 7 FOR PORTION OF
WATER MAIN INSTALLED BY
WESTERN VIRGINIA WATER
AUTHORITY FIELD OPERATIONS.
AS-BUILT: 03/18/2021

DRAWING TITLE	SHEET NUMBER
COVER	1
GENERAL NOTES & PROPOSED LEGEND	2
SURVEY SCHEDULES, NOTES, & EXISTING LEGEND	3
STANDARD DETAILS	4
STANDARD DETAILS	5
SHEET LAYOUT & FIRE HYDRANT COVERAGE MAP	6
12" D.I. WATER MAIN PLAN - PROFILE, STA. 9+95 TO STA. 14+50	7
12" D.I. WATER MAIN PLAN - PROFILE, STA. 14+50 TO STA. 18+00	8
12" D.I. WATER MAIN PLAN - PROFILE, STA. 18+00 TO STA. 22+00	9
12" D.I. WATER MAIN PLAN - PROFILE, STA. 22+00 TO STA. 25+38(END)	10
TEMPORARY TRAFFIC CONTROL PLAN NOTES	11
TEMPORARY TRAFFIC CONTROL PLAN FIGURE 1	12
TEMPORARY TRAFFIC CONTROL PLAN FIGURE 2	13
TEMPORARY TRAFFIC CONTROL PLAN FIGURE 3	14
TEMPORARY TRAFFIC CONTROL PLAN FIGURE 4	15
TEMPORARY TRAFFIC CONTROL PLAN FIGURE 5	16

SEPTEMBER 2020

Matthew Dwyer
APPROVED FOR CONSTRUCTION, RGC

Robert [Signature]
APPROVED FOR CONSTRUCTION, WWA

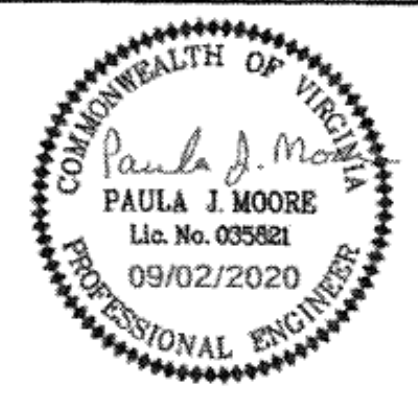

WESTERN VIRGINIA WATER AUTHORITY
601 South Jefferson Street, Suite 300
Roanoke, Virginia 24011

DES: PJM	SCALE: N/A
DRAWN: JES	HORIZ: N/A
CHECK: PJM	VERT: N/A
DATE: 9/02/2020	

WILLIAMSON ROAD
WATER MAIN REPLACEMENT &
ROANOKE GAS COMPANY GAS MAIN REPLACEMENT

REV	DATE	DESCRIPTION

COVER	DRAWING	SHEET
	-	1