
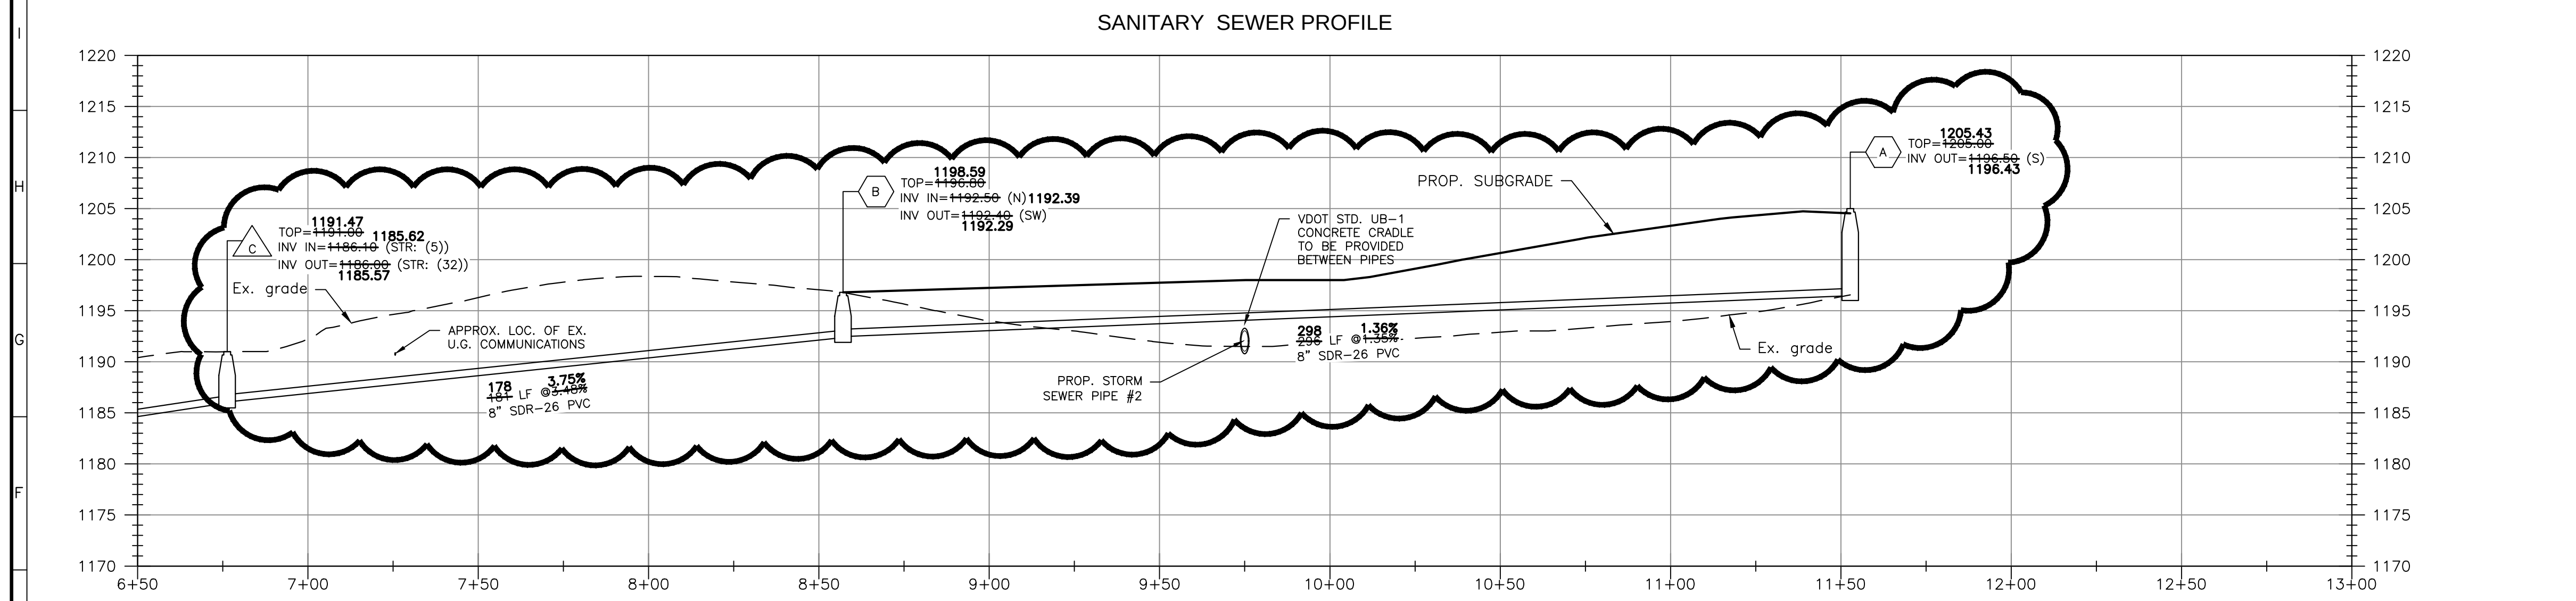



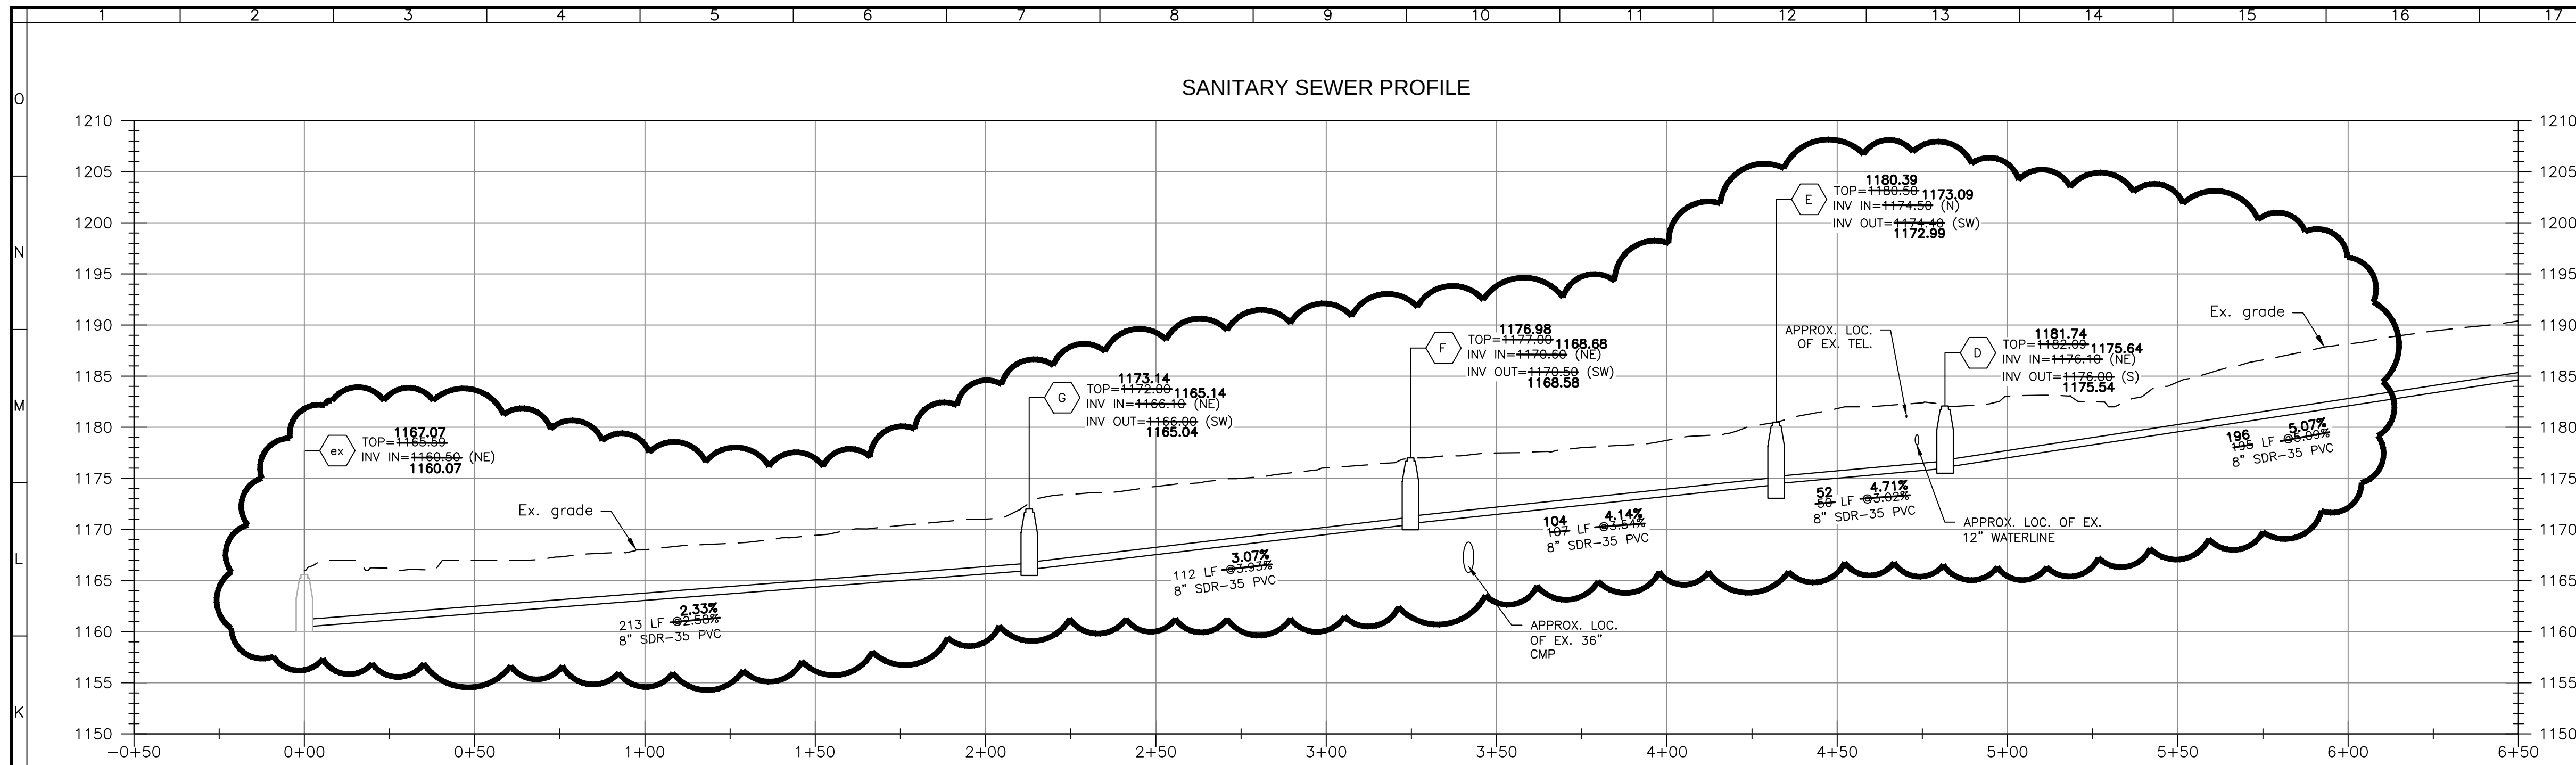


PROPOSED SANITARY SEWER SCHEDULE

- (A) S.S. MANHOLE
TOP=1205.43
INV. OUT=1196.5
298 LF OF 8" SDR-26 AT 1.36% 1.36%
- (B) S.S. MANHOLE
TOP=1198.59
INV. IN=1192.5
INV. OUT=1192.5
178 LF OF 8" SDR-26 AT 3.48% 3.75%
- (C) S.S. MANHOLE
TOP=1191.47
INV. IN=1186.4
INV. OUT=1185.7
196 LF OF 8" SDR-35 AT 5.09% 5.07%
- (D) S.S. MANHOLE
TOP=1181.74
INV. IN=1176.16
INV. OUT=1175.54
52 LF OF 8" SDR-35 AT 3.92% 4.71%
- (E) S.S. MANHOLE
TOP=1180.39
INV. IN=1174.56
INV. OUT=1172.99
104 LF OF 8" SDR-35 AT 3.54% 4.14%
- (F) S.S. MANHOLE
TOP=1176.98
INV. IN=1168.68
INV. OUT=1168.58
112 LF OF 8" SDR-35 AT 3.03% 3.07%
- (G) S.S. MANHOLE
TOP=1173.14
INV. IN=1166.49
INV. OUT=1165.04
213 LF OF 8" SDR-35 AT 2.58% 2.33%

NOTES:
1. G.C. TO CONFIRM ALL TIE-IN LOCATIONS TO EXISTING LINES PRIOR TO CONSTRUCTION AND NOTIFY THE ENGINEER OF ANY DISCREPANCIES.
2. G.C. SHALL ENSURE THAT ALL APPROPRIATE PERMITS ARE IN PLACE PRIOR TO CONSTRUCTION.
3. ALL NEW SANITARY SEWER STRUCTURES AND PIPES SHALL BE INSTALLED IN ACCORDANCE WITH WVWA REGULATIONS.


AS-BUILT DRAWING NOTE:
AS-BUILT DRAWING FOR SANITARY SEWER AND WATERLINE IMPROVEMENTS ARE FOR AS-BUILT PURPOSES ONLY. NO IMPROVEMENTS OTHER THAN WATER AND SANITARY SEWER STRUCTURES WERE AS-BUILT OR INDICATED AS SUCH ON THE SUBJECT PLAN SET. UNDERGROUND PIPING WAS NOT LOCATED. LOCATION SHOWN IS APPROXIMATE BASED ON SURFACE FEATURES AND INFORMATION PROVIDED BY CONTRACTOR.

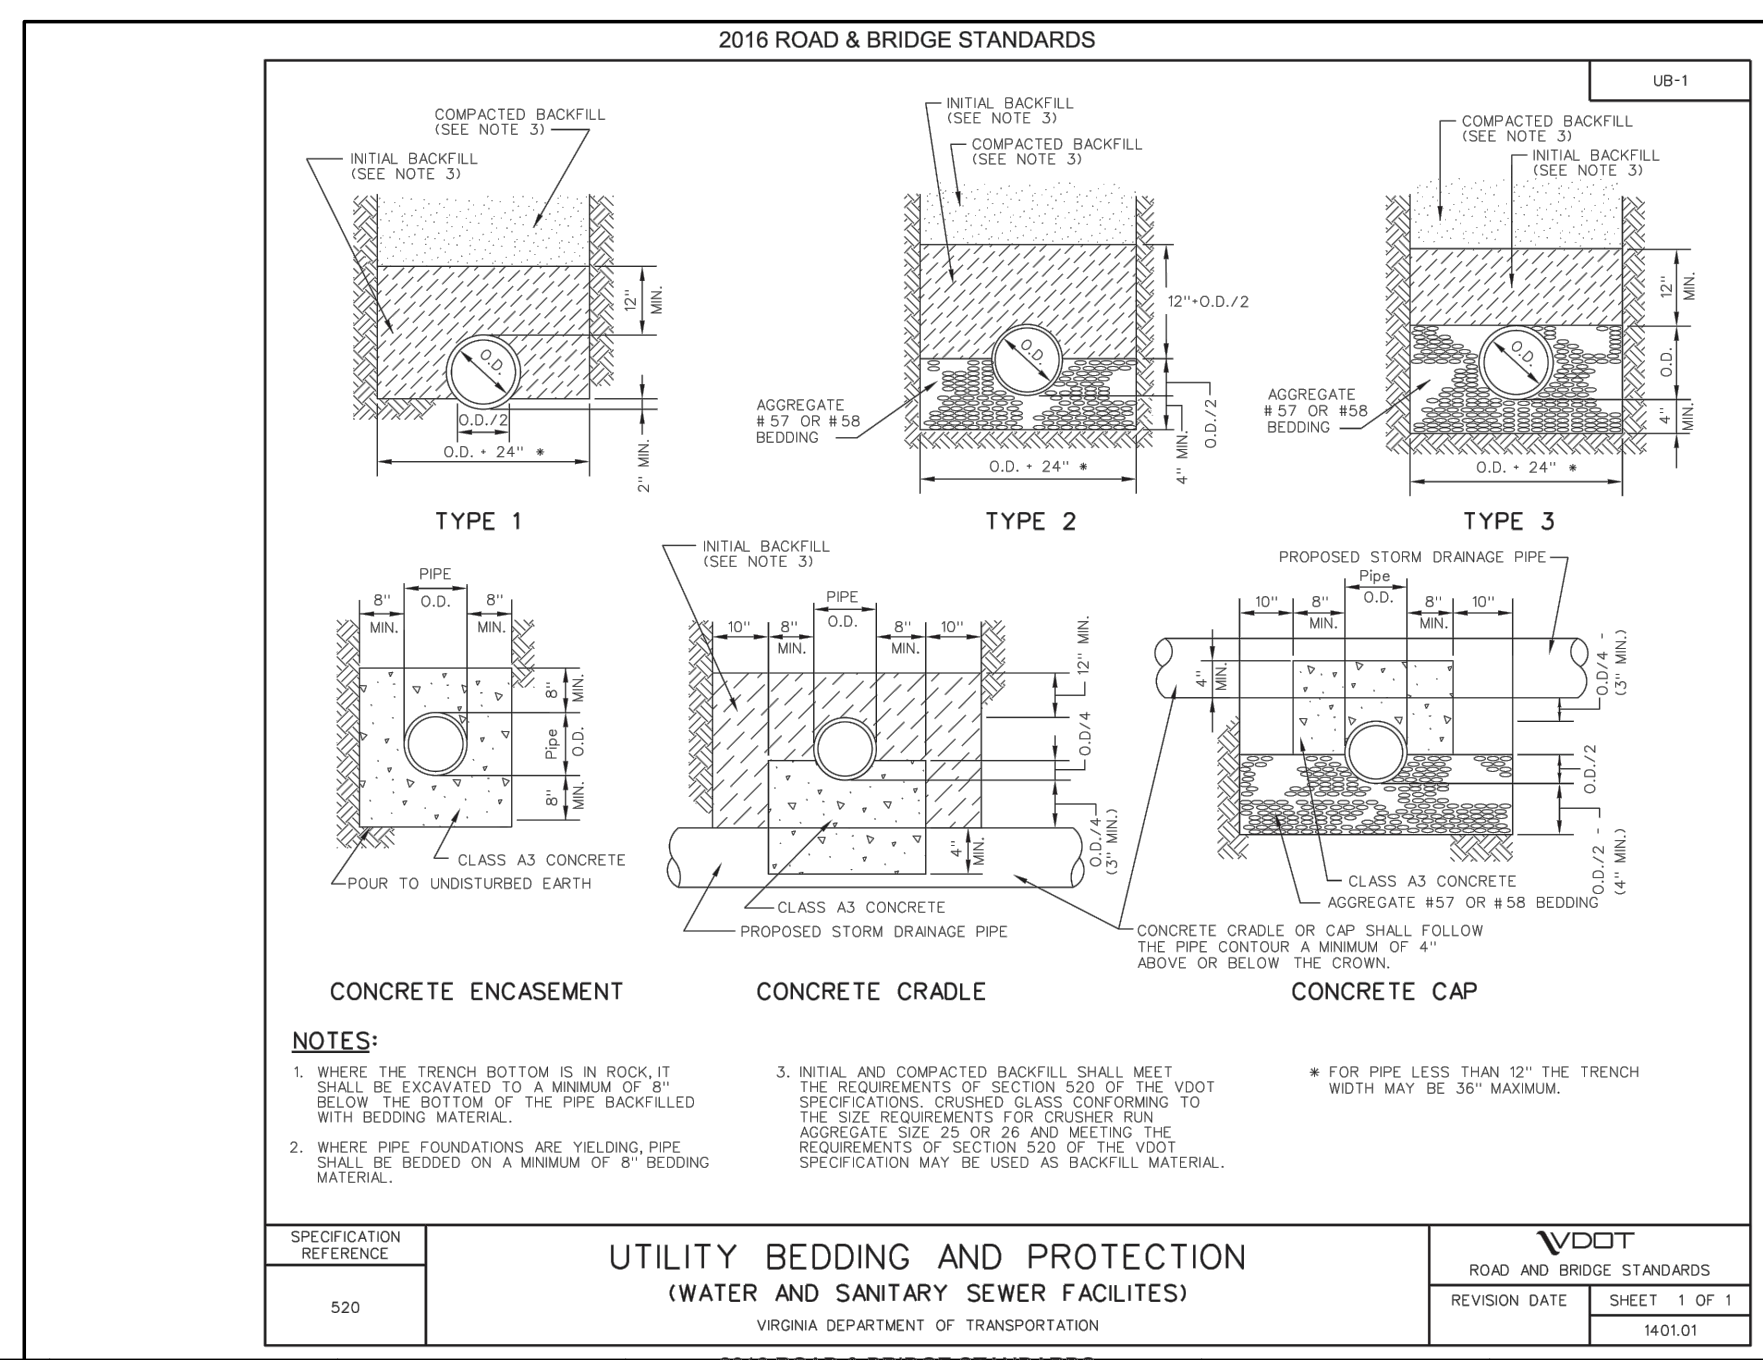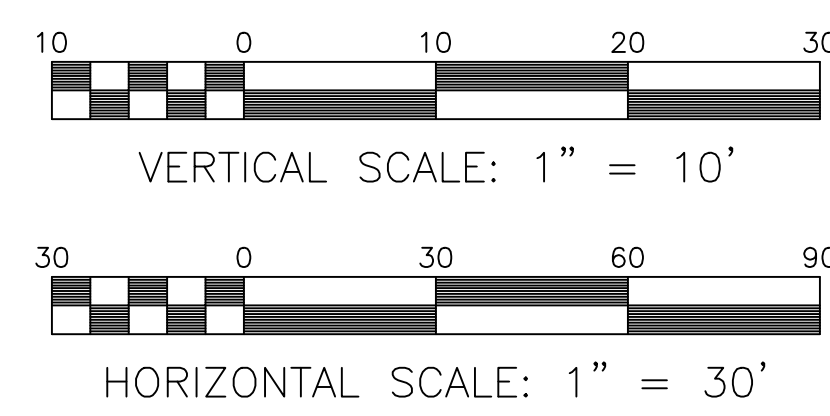

Roanoke
New River Valley
Richmond
Staunton
Harrisonburg

RESIDENTIAL LAND DEVELOPMENT ENGINEERING
SITE DEVELOPMENT ENGINEERING
LAND USE PLANNING & ZONING
LANDSCAPE ARCHITECTURE
ARCHITECTURE
STRUCTURAL ENGINEERING
TRANSPORTATION ENGINEERING
ENVIRONMENTAL & SOIL SCIENCE
WETLAND DELINEATIONS & STREAM EVALUATIONS

Balzer and Associates, Inc.
1208 Corporate Circle
Roanoke, VA 24018
540-772-9580
FAX 540-772-8050

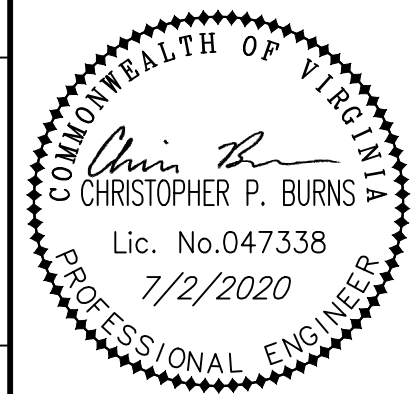

WOOD HAVEN TECHNOLOGY PARK
INFRASTRUCTURE IMPROVEMENTS
SANITARY SEWER PROFILE AS-BUILT
CATAWBA DISTRICT
ROANOKE COUNTY, VIRGINIA

DRAWN BY: CPB
DESIGNED BY: CPB
CHECKED BY: SMH
DATE: 7/2/2020
SCALE: AS NOTED
REVISIONS:

SHEET NO.
AB3
JOB NO. 04180095.00