


BID OPTIONS:

BASE BID: 500,000 GAL TANK; L.W.L.=1146'
ALTERNATE BID A: 1,000,000 GAL TANK; L.W.L.=1146'
ALTERNATE BID B: 1,000,000 GAL TANK; L.W.L.=1180'

NOTES:

1. H.W.L. AND NORMAL L.W.L. TO VARY WITH BID OPTION AND MANUFACTURER'S DESIGN.
2. TANK AND PEDESTAL DIAMETER TO VARY WITH BID OPTION AND MANUFACTURER'S DESIGN.

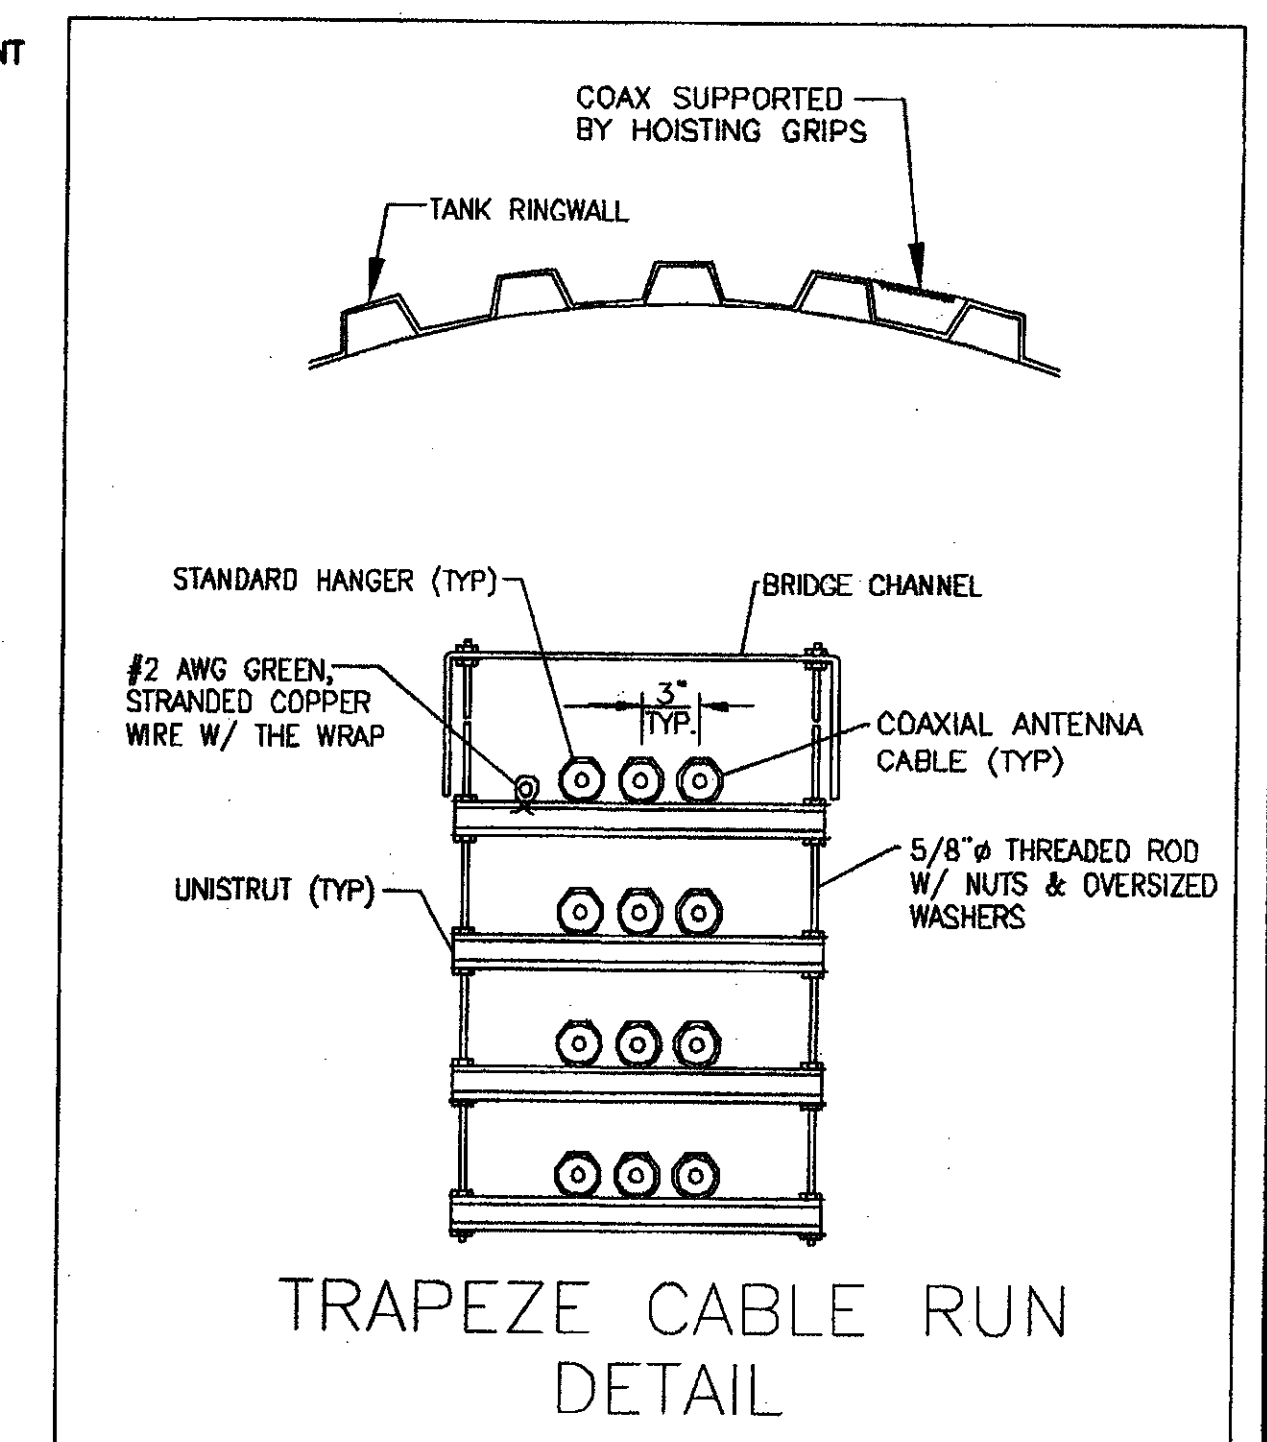

ELEVATION DETAIL

1" = 10' FULL SIZE PLANS
1" = 20' HALF SIZE PLANS



ANDERSON & ASSOCIATES, INC.

Professional Design Services
www.andassoc.com

Virginia - North Carolina - Tennessee

100 Ardmore St.
Blacksburg, Va. 24060
540-552-5592

DATE : 17 MAY 02
DESIGNED : TWD
DRAWN : SCS
CHECKED : TWD

REVISIONS:
19 AUG 02

SMITH MOUNTAIN LAKE

PHASE 1 WATER SYSTEM
BEDFORD COUNTY, VIRGINIA

TANK ELEVATION DETAILS

DOCUMENT NO.

18745 - 036

SHEET

36 OF 38

durford / Aug 27, 2002 4:11pm / 18745 tank design.dwg: SHEET 36