


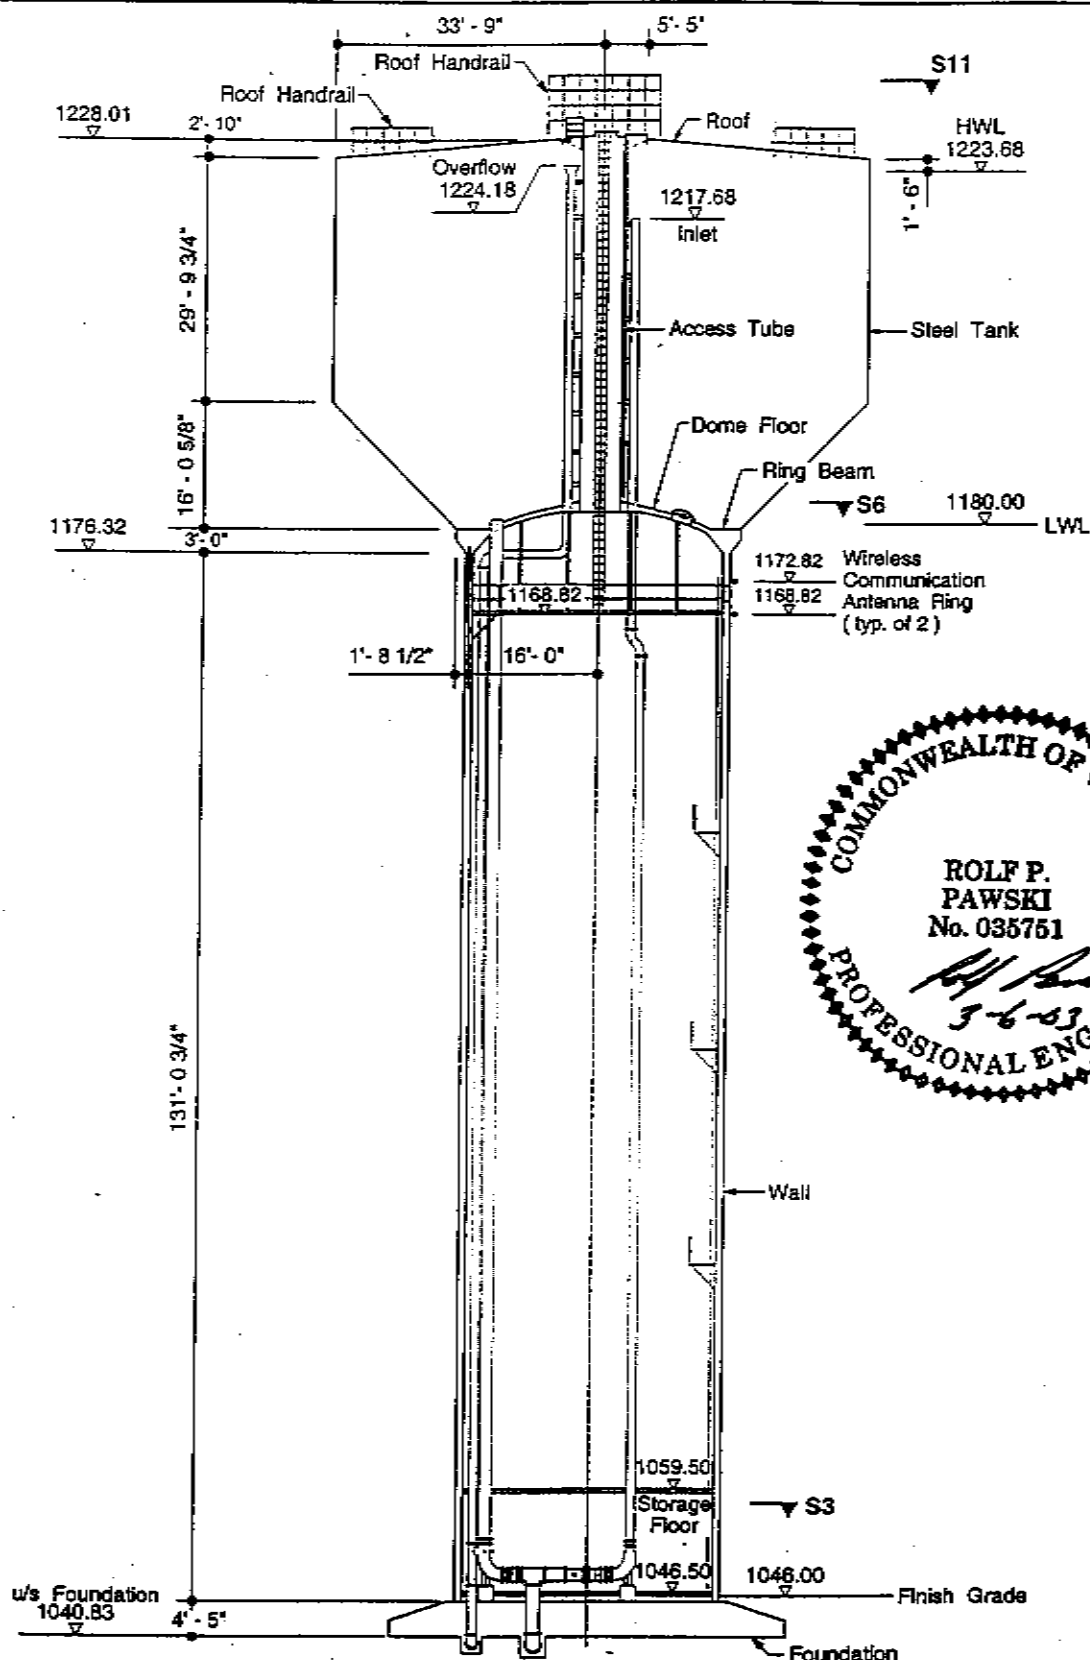

NOTES

1. Plan views correspond to sections indicated. Refer to sections for details, material specifications and procedures.

Rev.	Date	BEDFORD COUNTY, VIRGINIA 1.0 MG ELEVATED WATER STORAGE TANK (L.S.LP Job No. 1032)	TANK SECTION		
A	01/31/03	LANDMARK	Date 10 / 02	Dwn. CADD	S2 - A
				Chk.	