


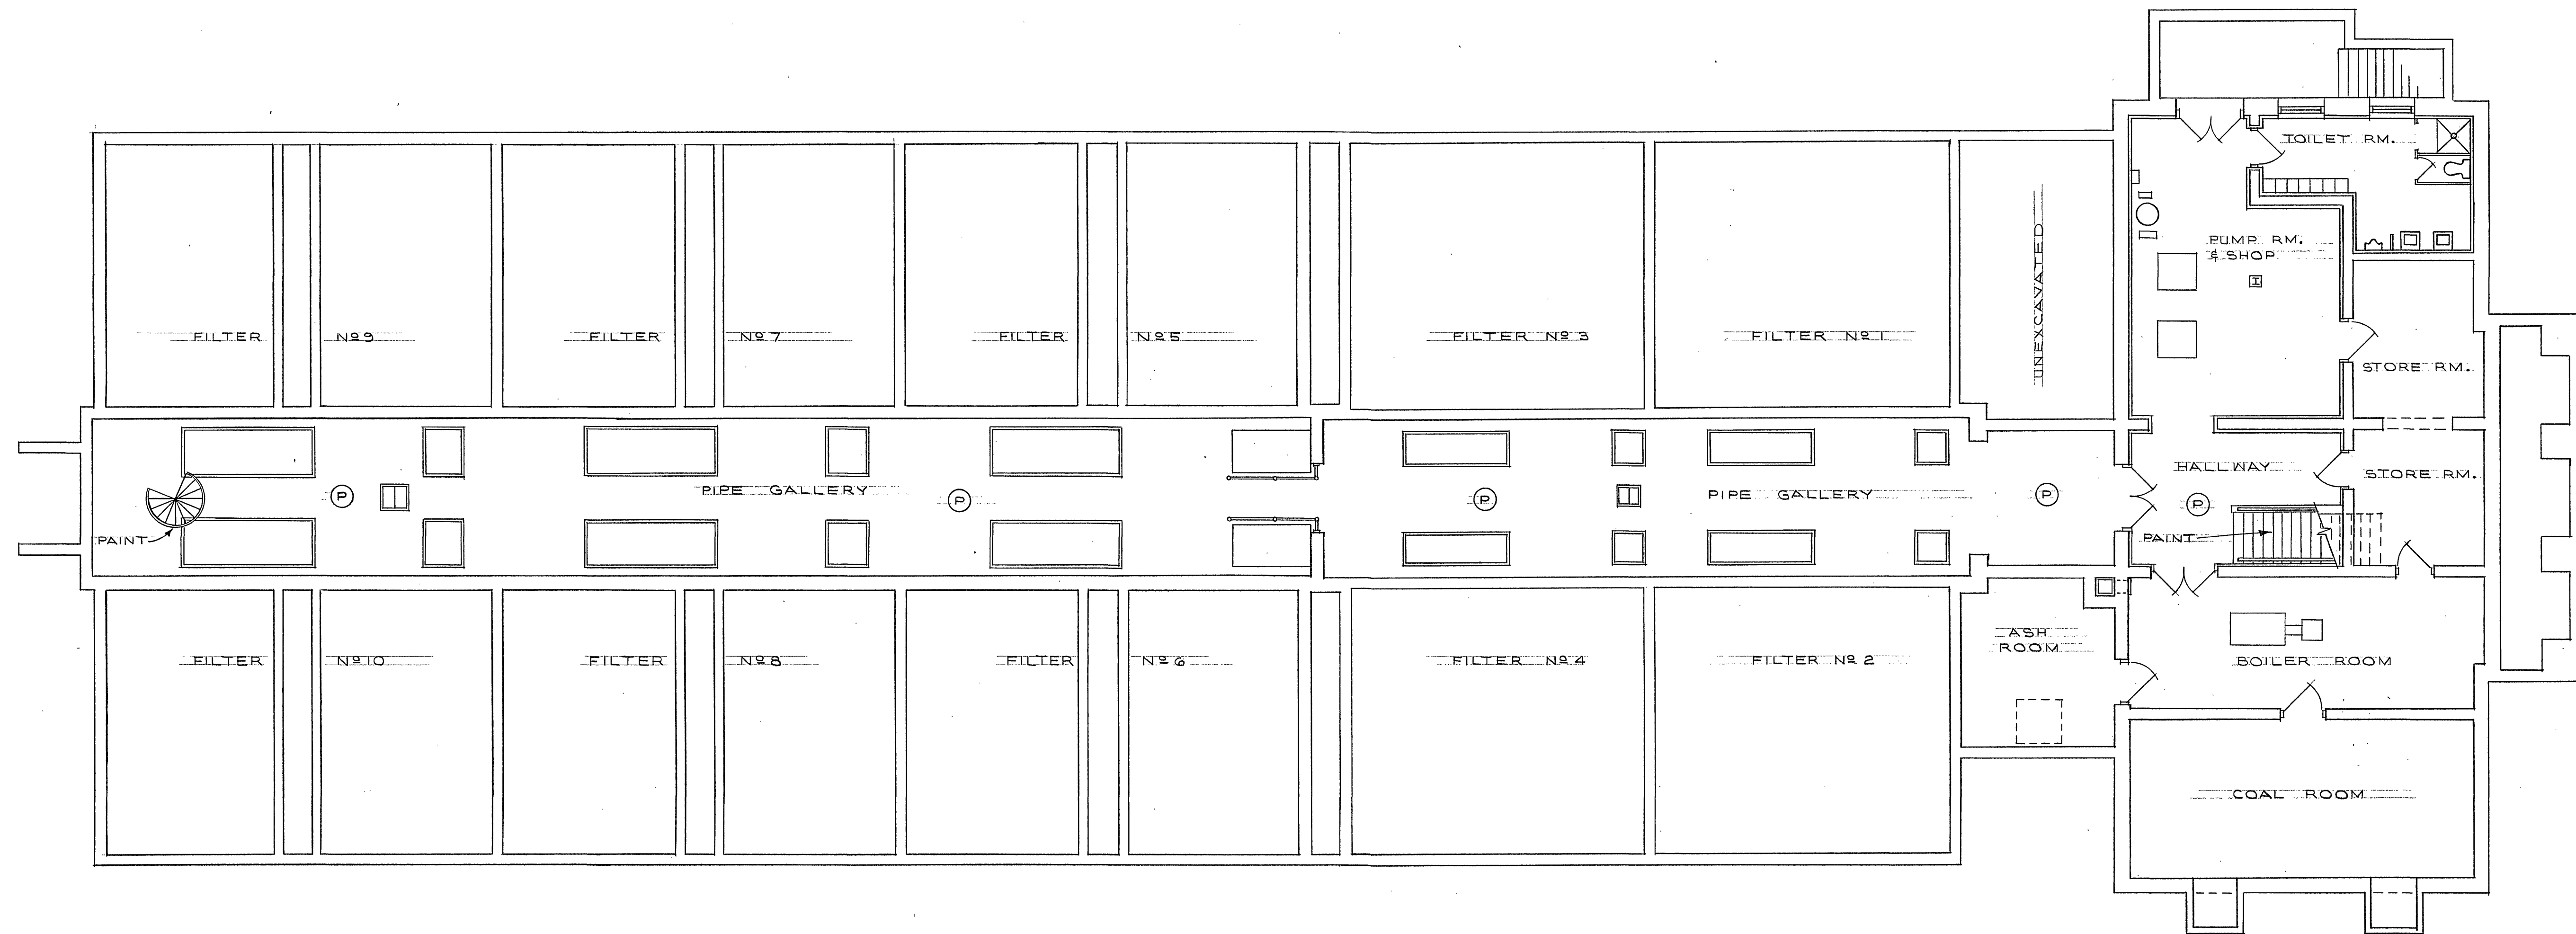

BASEMENT PLAN

SCALE: 1/8" = 1'-0"

REV. 1 NOTE: (P) INDICATES THE AREA TO BE PAINTED.

11-29-76	1	INTERIOR PAINTING	LBV
DATE	REV.	DESCRIPTION	BY
BASEMENT PLAN			
CITY ENGINEER			
DRAWN OF			LBV
CHECKED			LBC
APPROVED			
DATE			5-9-76
JOB NO.			4266
SHEET			1
CONTRACTOR MUST VERIFY ALL DIMENSIONS AT PROJECT BEFORE PROCEEDING WITH WORK			OF 5

NEW INTERIOR PAINTING

TOF 3