


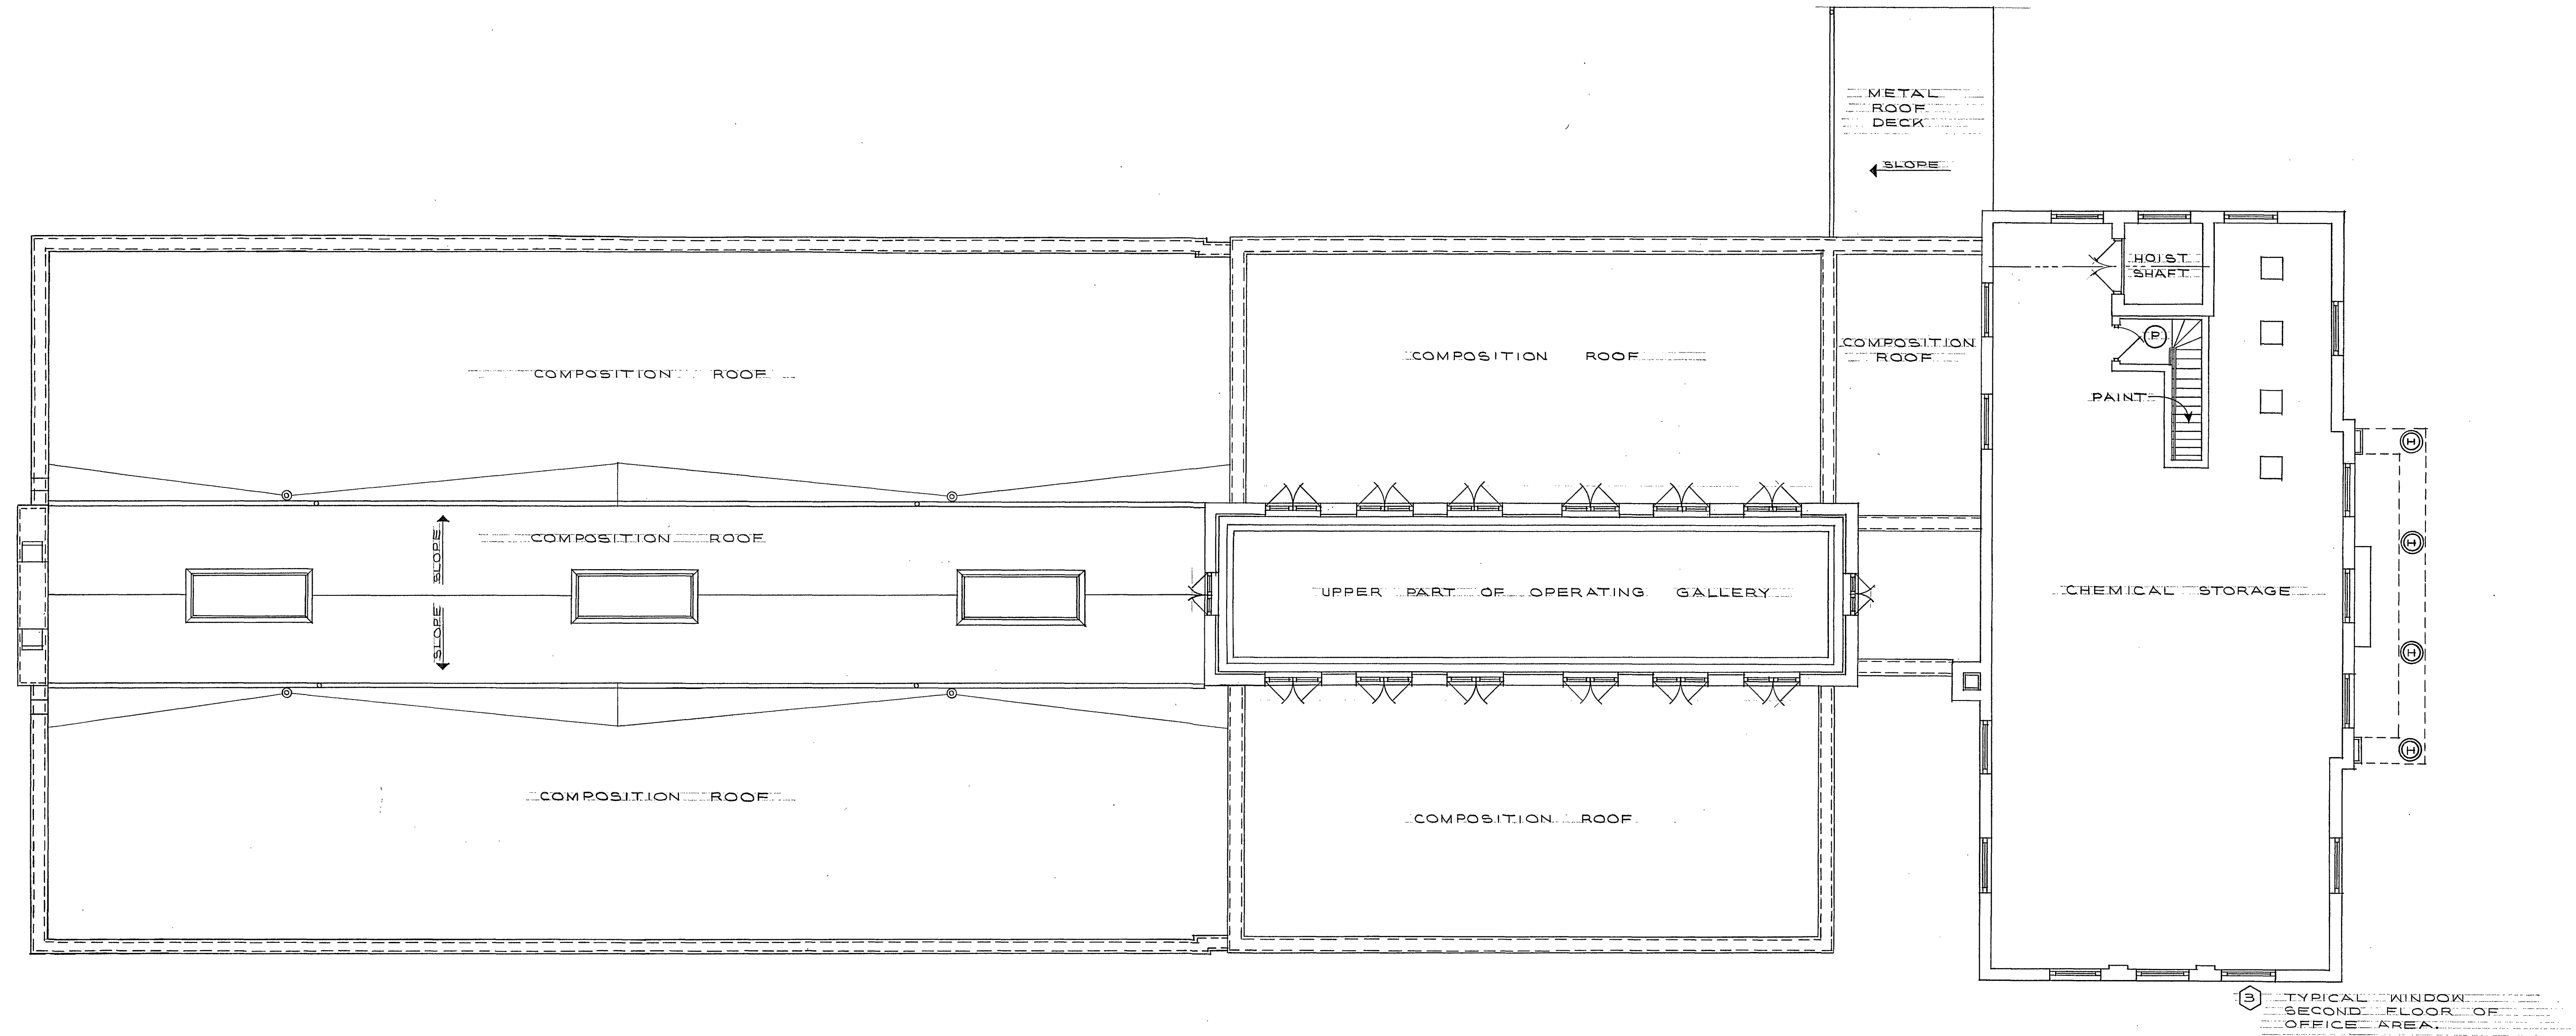

SECOND FLOOR PLAN & PARTIAL ROOF PLAN

SCALE: 1/8" = 1'-0"

REV. 1 NOTE: (P) INDICATES THE AREA TO BE PAINTED.

11-29-76	1	INTERIOR PAINTING	LBV
DATE	REV.	DESCRIPTION	BY
SECOND FLOOR PLAN			
CITY ENGINEER			
DRAWN LBV			CHECKED LBC
APPROVED			DATE 9-3-76
CITY OF ROANOKE			JOB NO. 4266
OFFICE OF CITY ENGINEER			SHEET 3
ROANOKE, VIRGINIA			OF 5

NEW INTERIOR PAINTING 30 F. 3.

CONTRACTOR MUST VERIFY ALL DIMENSIONS AT PROJECT BEFORE PROCEEDING WITH WORK