


Approx
wash meter recorder
location.

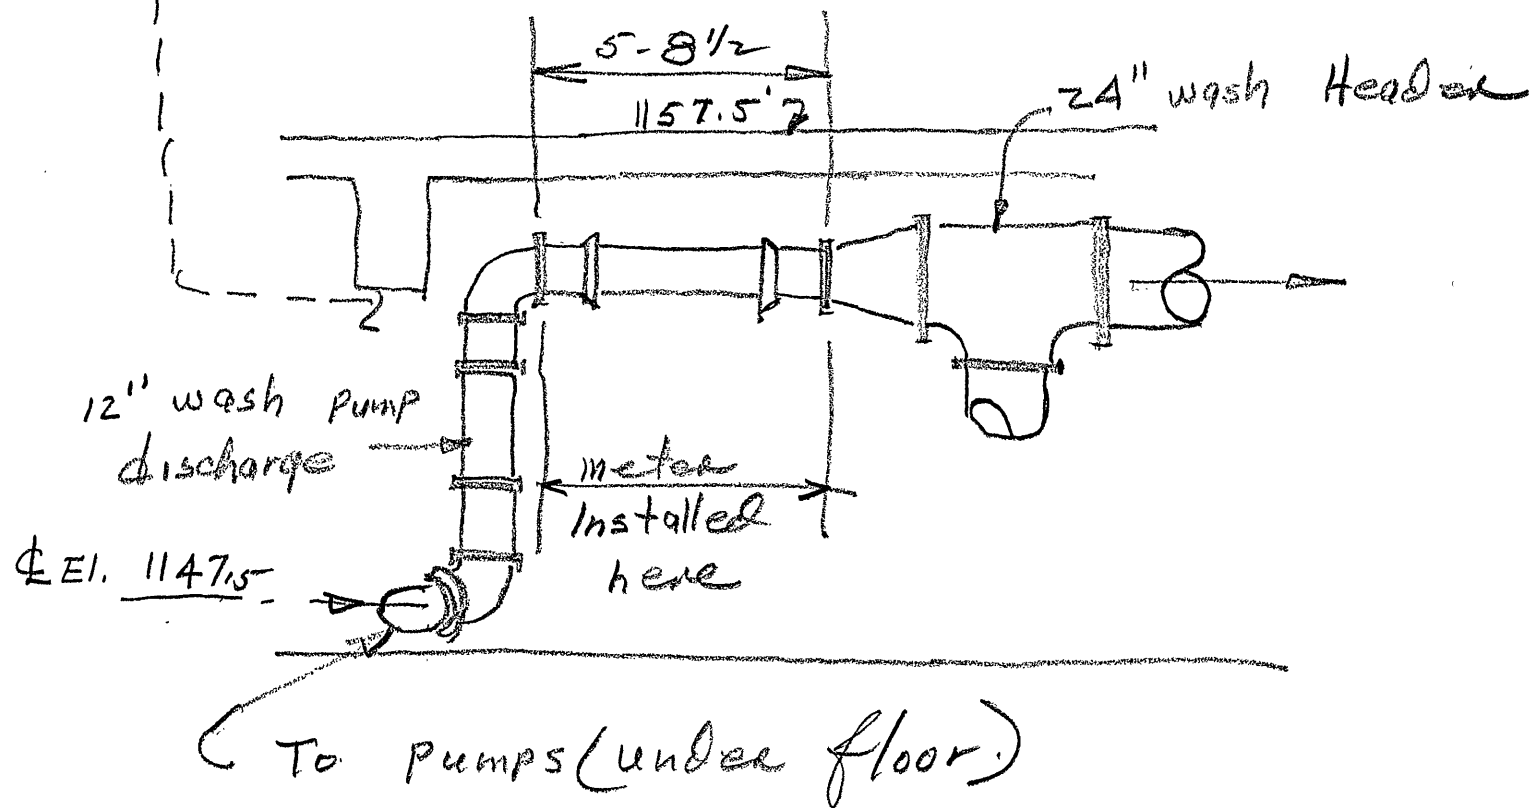

OFFICE OF CITY ENGINEER
ROANOKE, VIRGINIA

7-14-78