


PROJECT LOCATION MAP

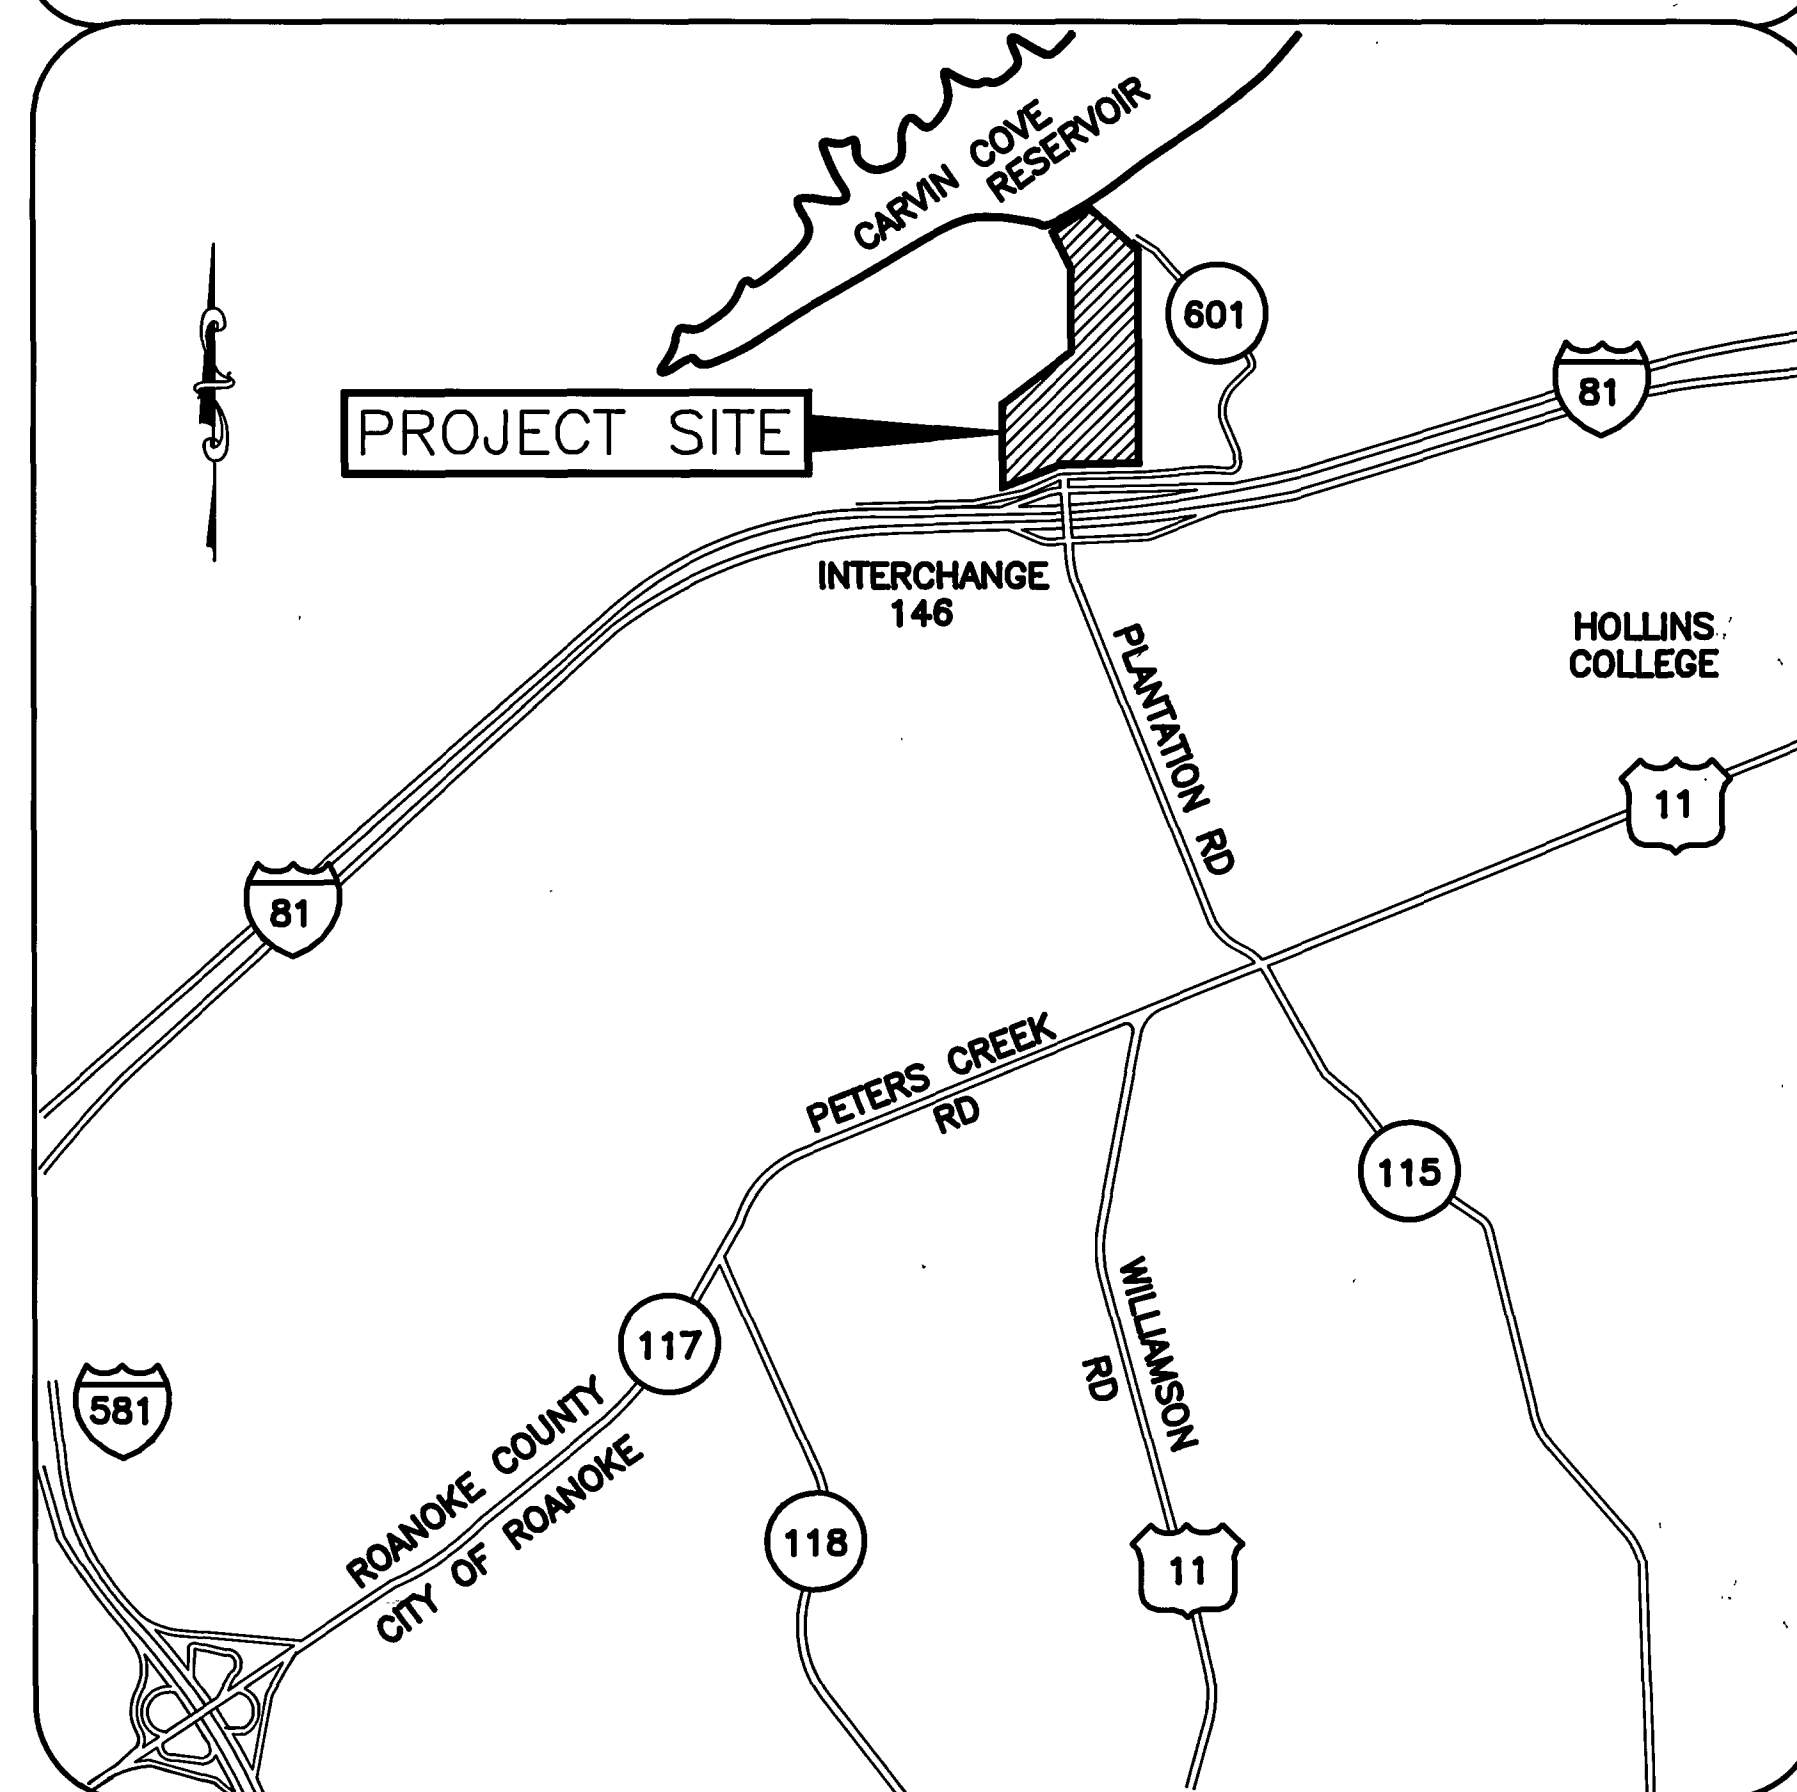

OFFICE OF CITY ENGINEER
ROOM 350
MUNICIPAL BUILDING
215 CHURCH AVENUE, S.W.
ROANOKE, VIRGINIA 24011

INDEX OF SHEETS

SHEET			SECTION
1			COVER SHEET
G1	THRU	G7	GENERAL
AR1	THRU	AR8	DAM ACCESS ROAD
IS1	THRU	IS8	INTAKE STRUCTURE
RW1	THRU	RW7	RAW WATER LINE
PS1	THRU	PS10	LOW LIFT PUMP STATION
EP1	THRU	EP17	EXISTING PRETREATMENT FACILITIES
PB1	THRU	PB7	12 MGD PRETREATMENT BASINS
FR1	THRU	FR9	4 MGD FINISHED WATER RESERVOIR
FL1	THRU	FL9	FILTERS AND FILTER PIPING
A1	THRU	A13	ARCHITECTURAL
M1	THRU	M12	MECHANICAL
E1	THRU	E17	ELECTRICAL
K1	THRU	K4	CHEMICAL FEED
BH1			BOXLEY HILLS PUMP STATION
SR1	THRU	SR8	SCADA SYSTEM

FOR COMPLETE SHEET LIST SEE SHEET G-1


CONSULTING ENGINEERS

Mattern & Craig
CONSULTING ENGINEERS - SURVEYORS
701 FIRST STREET S.W.
ROANOKE, VIRGINIA 24016
PHONE: 703-345-9342 FAX: 703-345-7691

COMMISSION NUMBER: 1138

ALVORD BURDICK & HOWSON
CONSULTING ENGINEERS SINCE 1902
20 NORTH WACKER DRIVE, SUITE 1401
CHICAGO, ILLINOIS 60606
PHONE: 312-236-9147 FAX: 312-236-0692

COMMISSION NUMBER: 9130

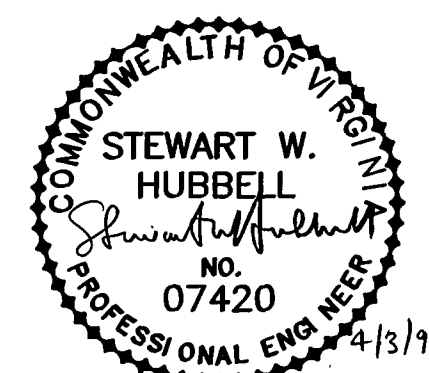

PROJECT NAME

CARVINS COVE FILTER PLANT
IMPROVEMENTS
PHASE I

PROJECT NUMBER: 6199

REVISION BY	DESCRIPTION:	DATE
REVISION BY	DESCRIPTION:	DATE
REVISION BY	DESCRIPTION:	DATE
REVISION BY	DESCRIPTION:	DATE

APPROVED FOR CONSTRUCTION

ROANOKE CITY ENGINEER

DATE

DIRECTOR OF PUBLIC WORKS

DATE

DIRECTOR OF PUBLIC UTILITIES AND OPERATIONS

DATE

MANAGER OF WATER DEPARTMENT

DATE

DATE

ADVERTISED DATE:

SET NUMBER:

SHEET NUMBER: 1 OF 138

RECORD DRAWING

MARCH, 1992