
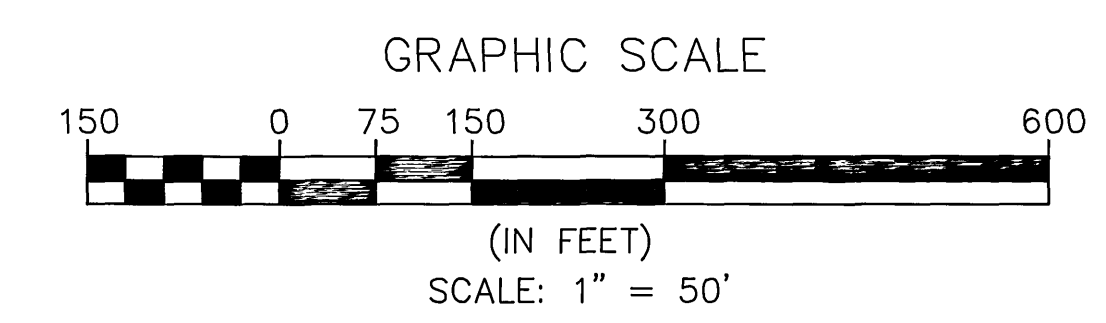
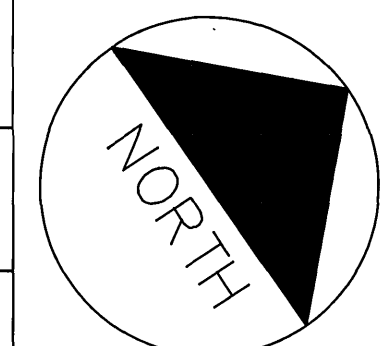


NOTE:
 BOXLEY HILLS PUMP STATION – (SEE SHEET BH1)
 SCADA LOCATIONS – (SEE SHEET SR1)

THE CONTRACT LIMIT LINES SHALL BE THAT AREA REQUIRED TO BE DISTURBED DUE TO THE CONSTRUCTION AS INDICATED IN THESE CONTRACT DOCUMENTS AND SHALL BE COMPLETELY WITHIN THE CITY OF ROANOKE'S PROPERTY AND EASEMENTS.

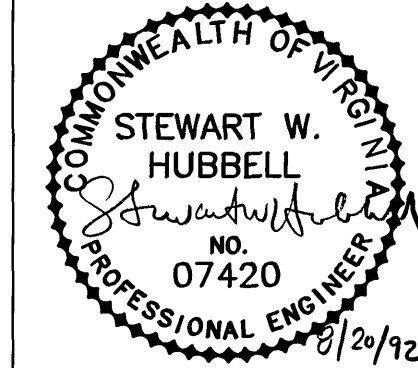

RECORD DRAWING

MATTERN & CRAIG CONSULTING ENGINEERS • SURVEYORS ROANOKE VIRGINIA	DESIGNED:	RWB			REV.	DATE	DESCRIPTION	BY	APP.	CARVINS COVE FILTER PLANT IMPROVEMENTS – PHASE I ROANOKE, VIRGINIA	DATE MARCH 1992
	DRAWN:	TAM									COMM. NO. 1138
ALVORD, BURDICK & HOWSON ENGINEERS CHICAGO	CHECKED:	SWH								GENERAL KEY SHEET	SHEET G3