


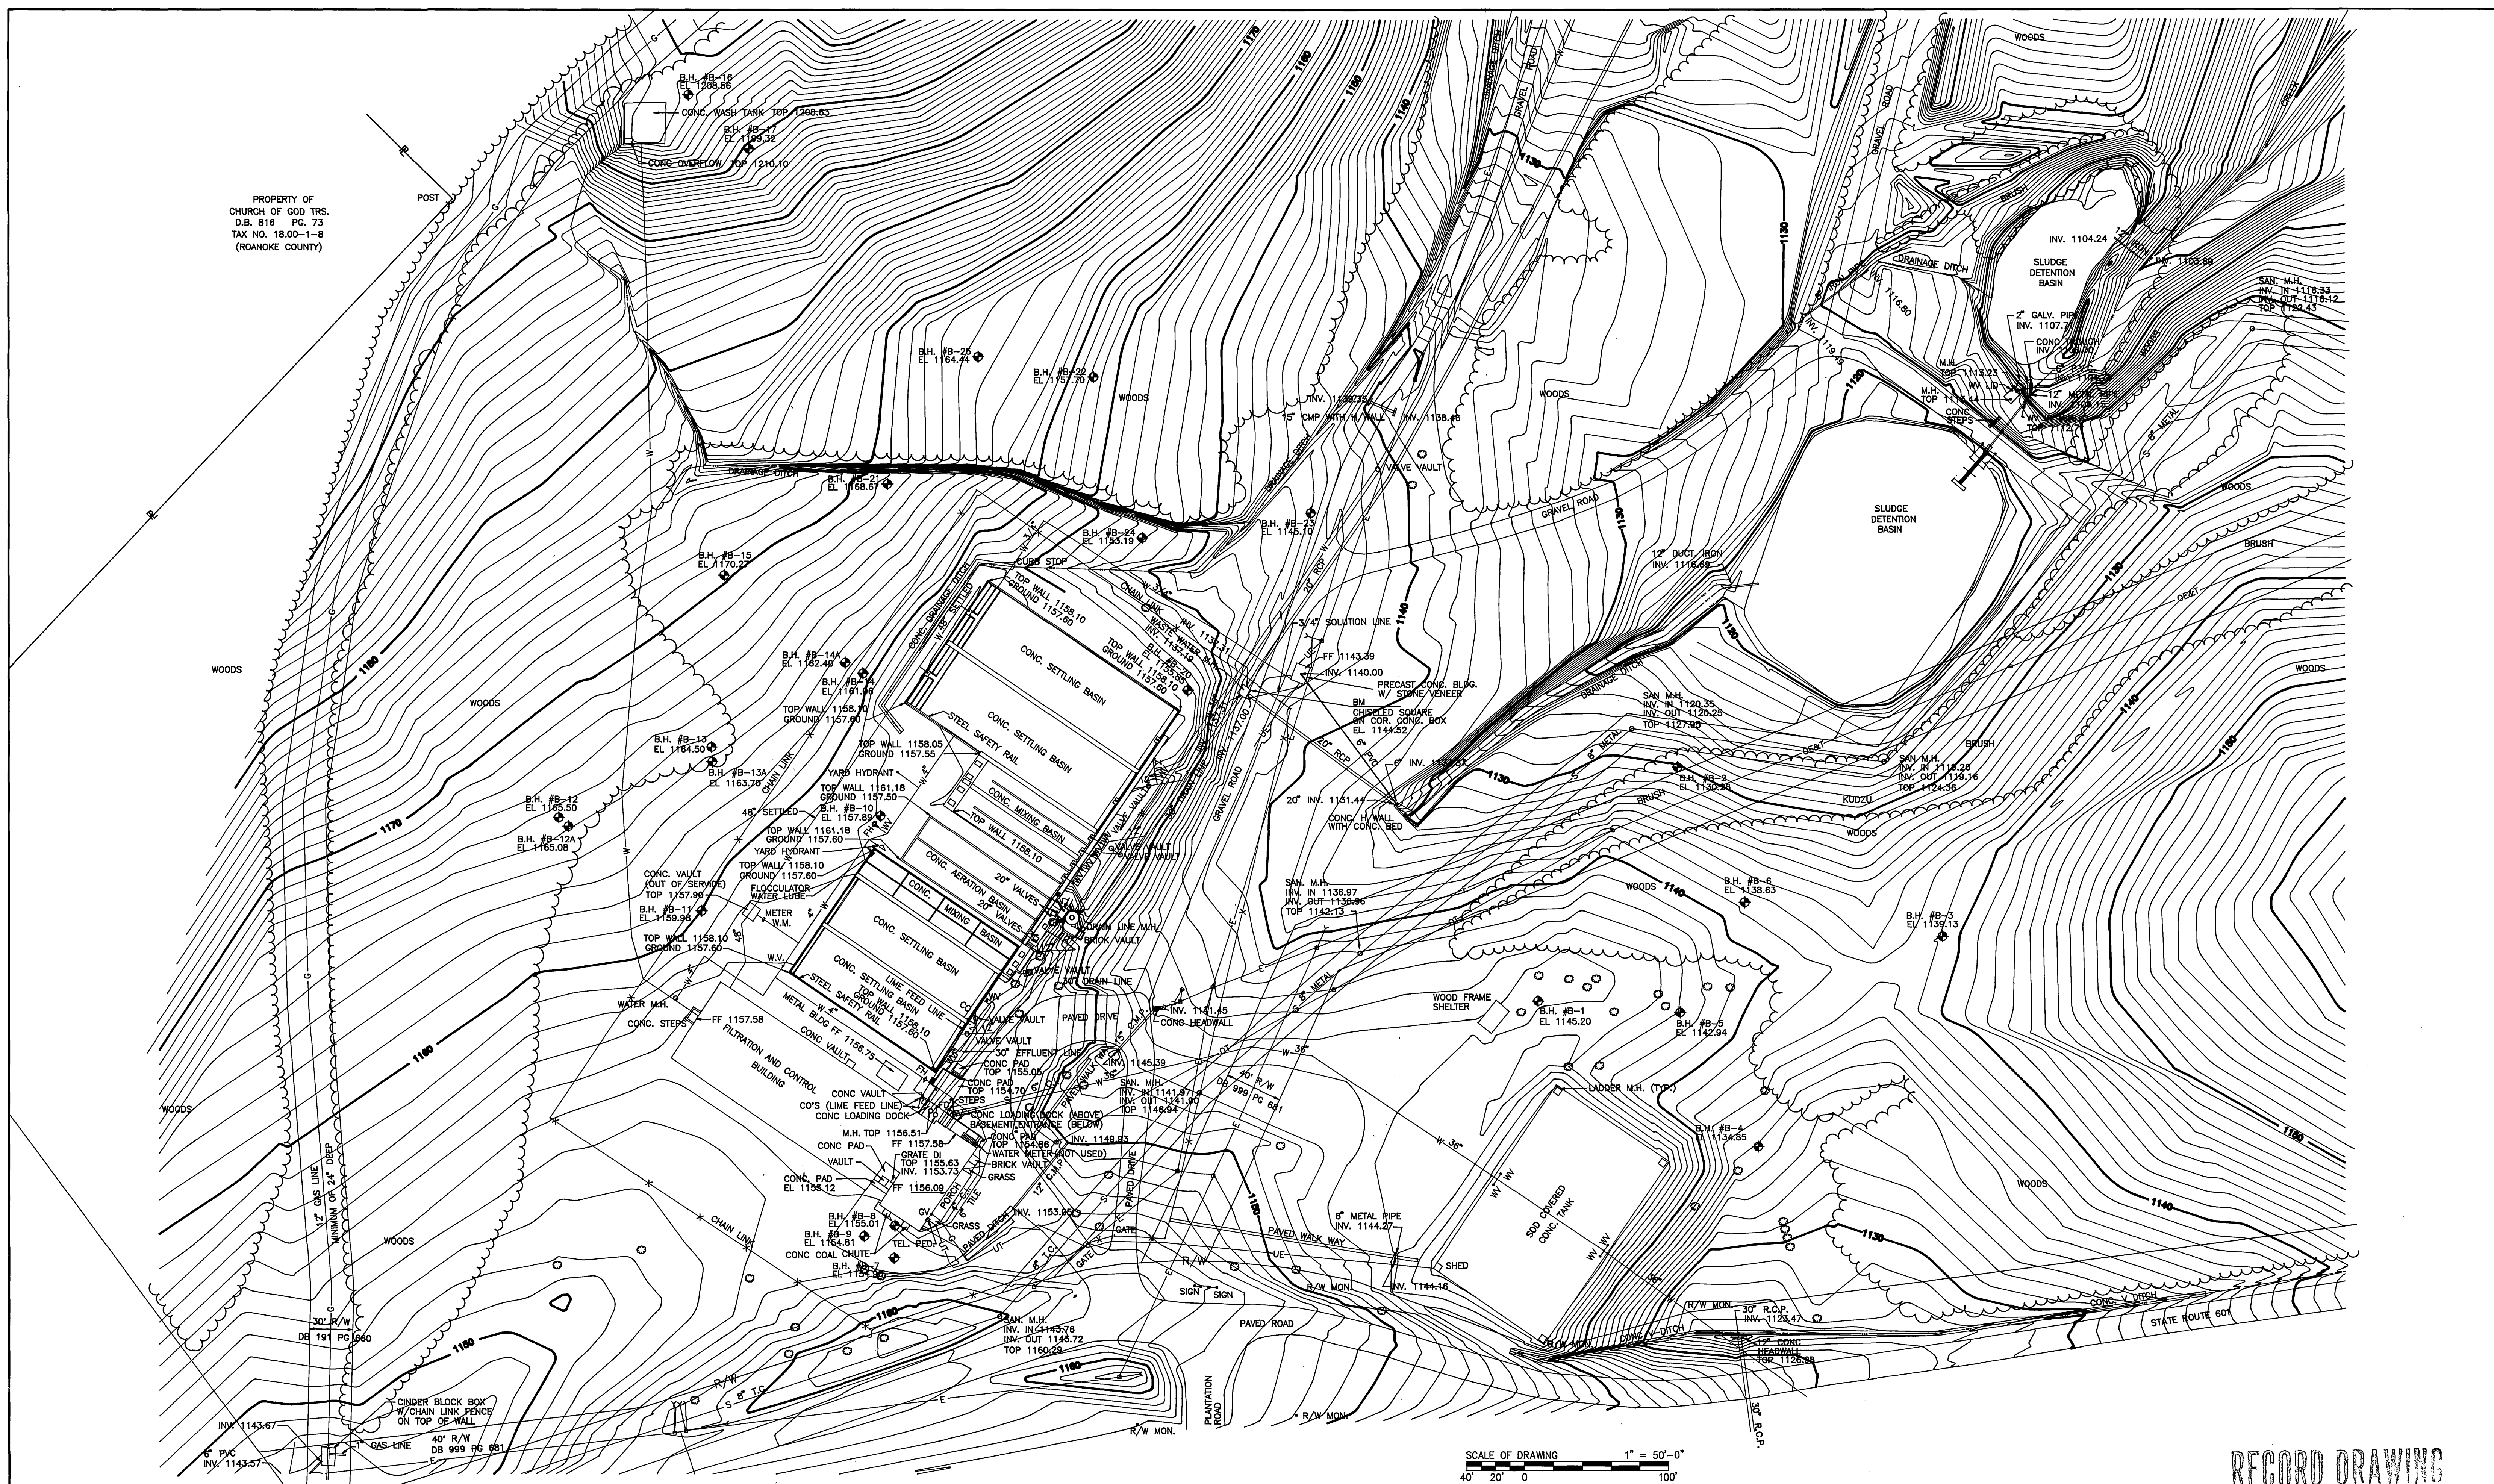

MATTERN & CRAIG
CONSULTING ENGINEERS • SURVEYORS
ROANOKE VIRGINIA

ALVORD, BURDICK & HOWSON
ENGINEERS CHICAGO

DESIGNED: M. & C.

DRAWN: M. & C.

CHECKED: Y.T.L.

[illegible]

CARVINS COVE FILTER PLANT IMPROVEMENTS – PHASE I

ROANOKE, VIRGINIA

EXISTING TREATMENT PLANT TOPO

DATE
PRIL 1992

COMM. NO.
9130

SHEET

G4 |