


NOTES:

1. SEDIMENT AND EROSION CONTROL MEASURES FOR THE DAM ACCESS ROAD, RAW WATER LINE AND LOW LIFT PUMP STATION ARE SHOWN ON THE PLAN SHEETS ASSOCIATED WITH THOSE FACILITIES.
2. THE CONTRACTOR SHALL NOTIFY THE ROANOKE COUNTY ENGINEERING & INSPECTIONS DEPARTMENT PRIOR TO EMPTYING THE PONDS.

EROSION CONTROL LEGEND

	DD	DIVERSION DIKE
	SB	STRAW BALE BARRIER
	SF	SILT FENCE
	CE	CONSTRUCTION ENTRANCE
	TS	TEMPORARY SEEDING
	CD	CHECK DAM
	IP	INLET PROTECTION

SCALE: 1" = 50'
0' 50' 100'

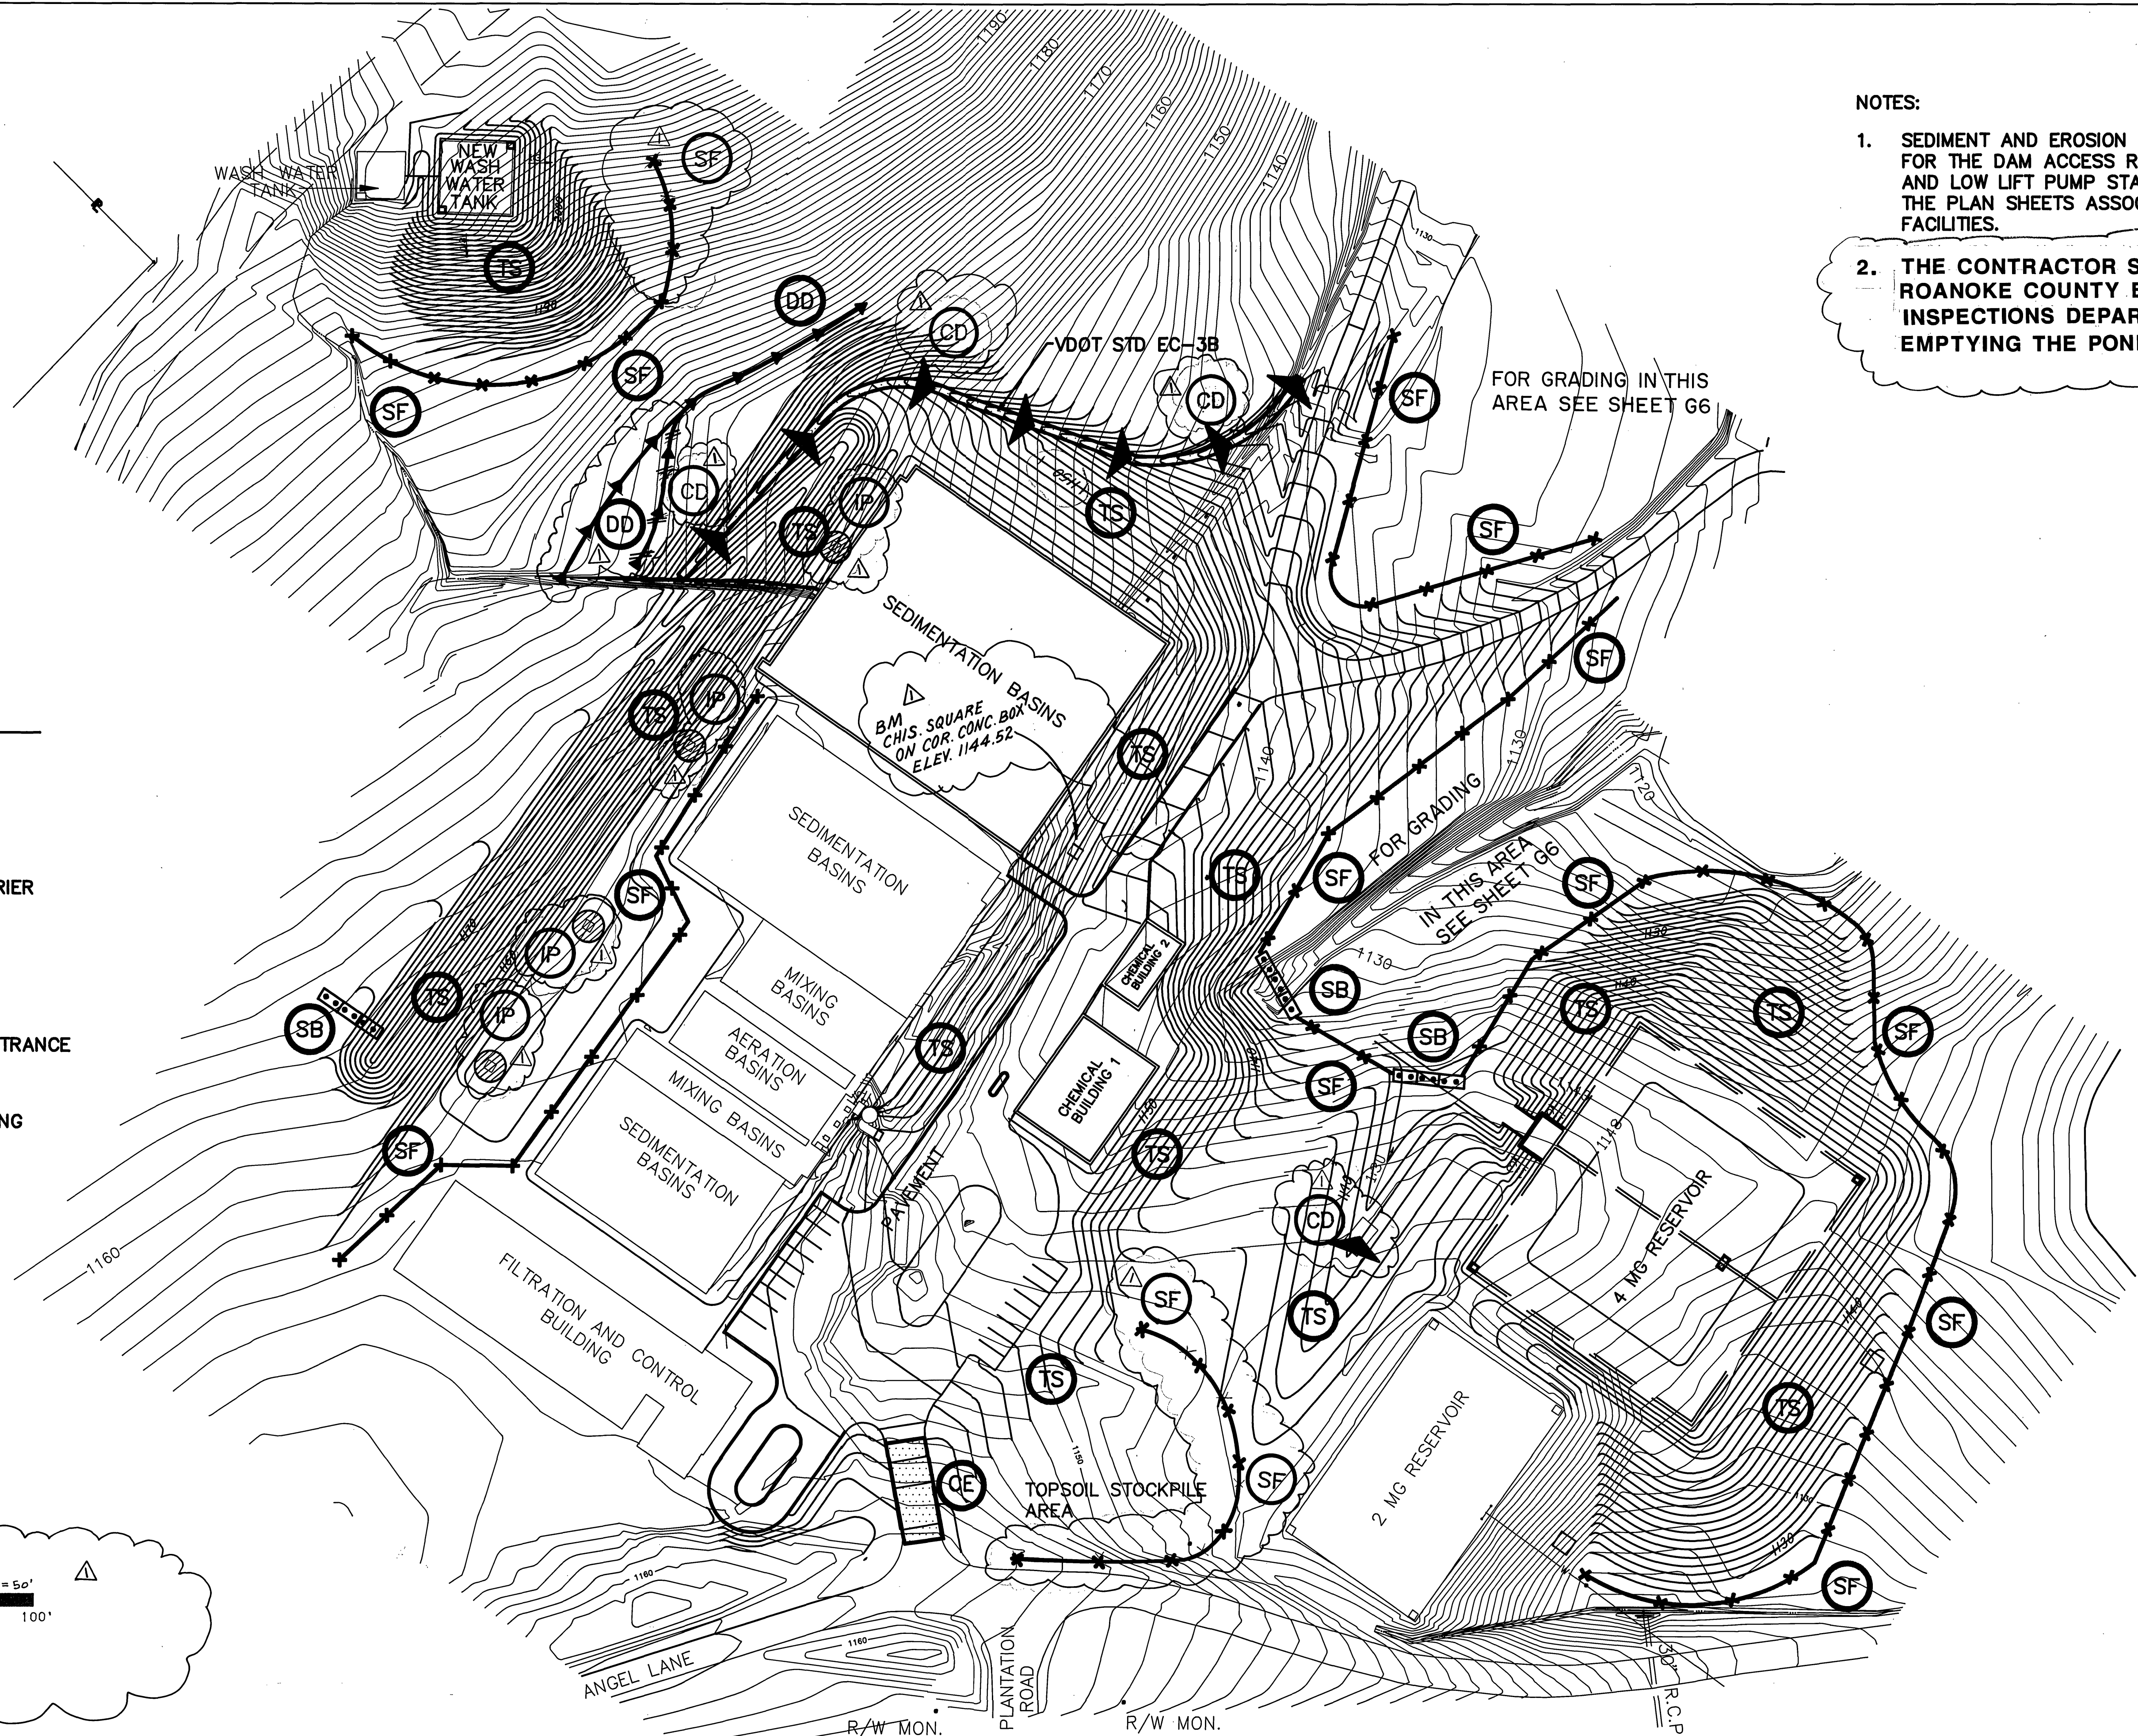


RECORD DRAWING

MATTERN & CRAIG
CONSULTING ENGINEERS • SURVEYORS
ROANOKE VIRGINIA

ALVORD, BURDICK & HOWSON
ENGINEERS CHICAGO

DESIGNED:
TAM
DRAWN:
TAM
CHECKED:
SWH

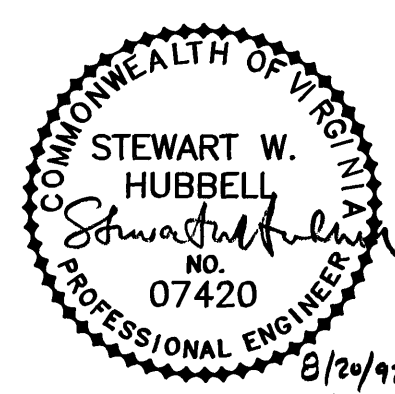

REV.	DATE	DESCRIPTION	BY	APP.
1	12/10/92	ROANOKE CO. COMMENTS C.O. #1	WCB	SWH

CARVINS COVE FILTER PLANT IMPROVEMENTS — PHASE I
ROANOKE, VIRGINIA

FILTER PLANT SITE
SEDIMENT & EROSION CONTROL PLAN

DATE
MARCH 1992
COMM. NO.
1138
SHEET
G5