



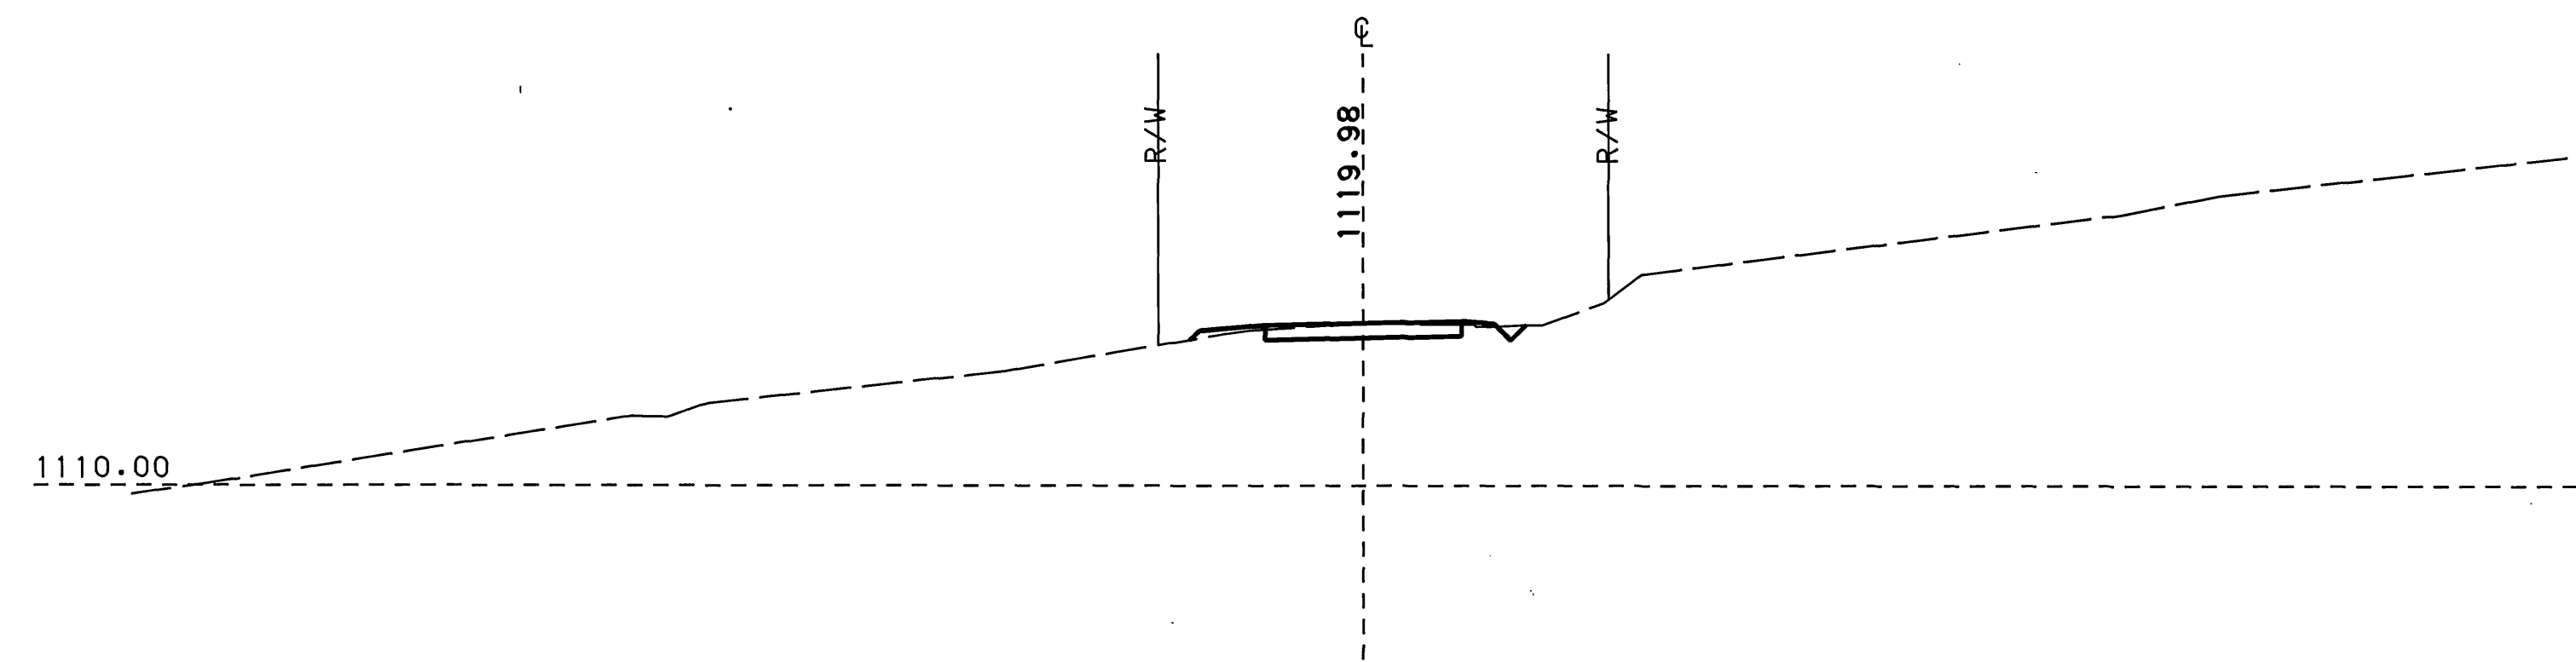


13+24.40

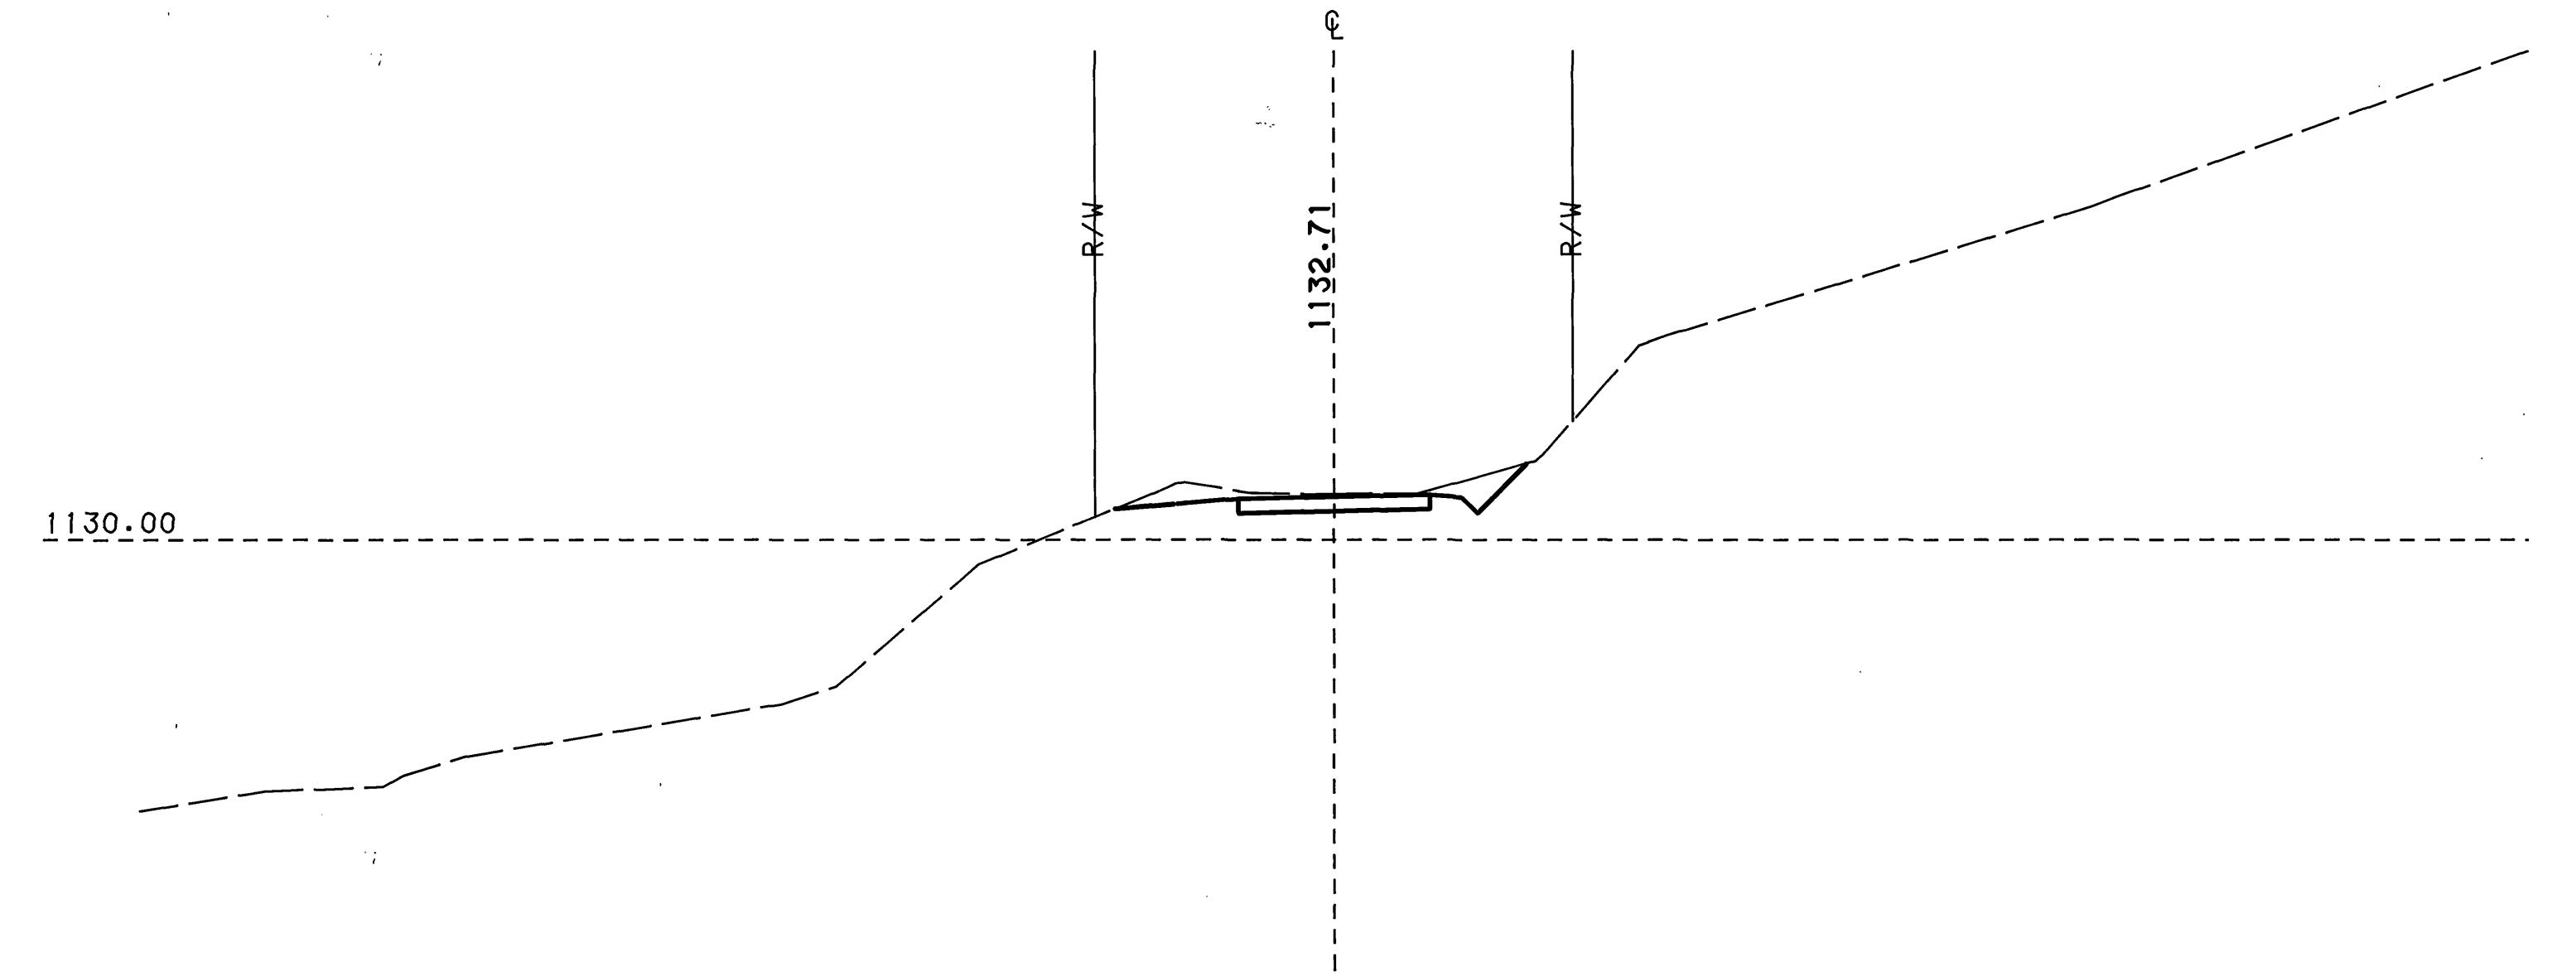


15+00.00

- NOTES
1. WORK FROM STA. 12+00 TO 15+00 SHALL STAY WITHIN INDICATED R/W.
 2. SEE SH. AR3 FOR TYPICAL ROAD SECTIONS AT VARIOUS STATIONS.

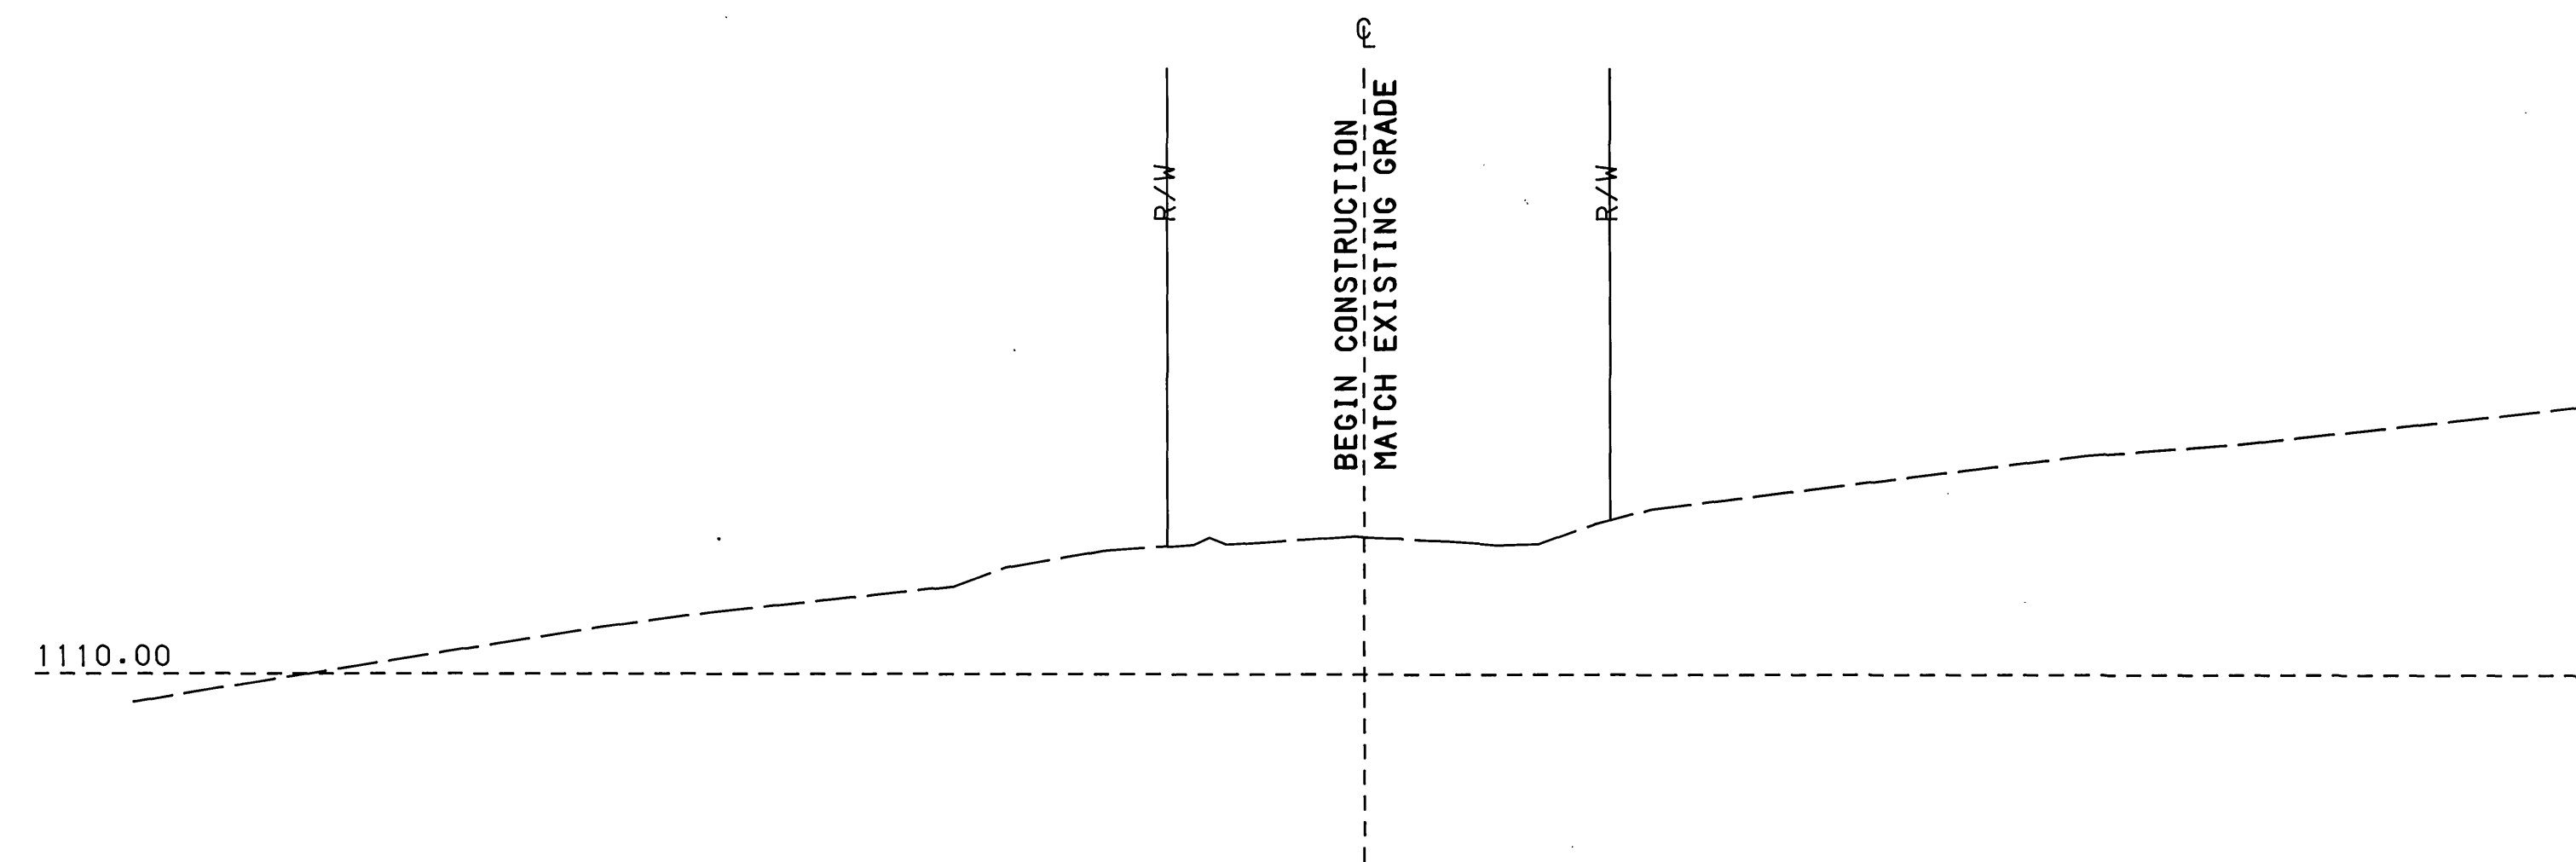

13+00.00

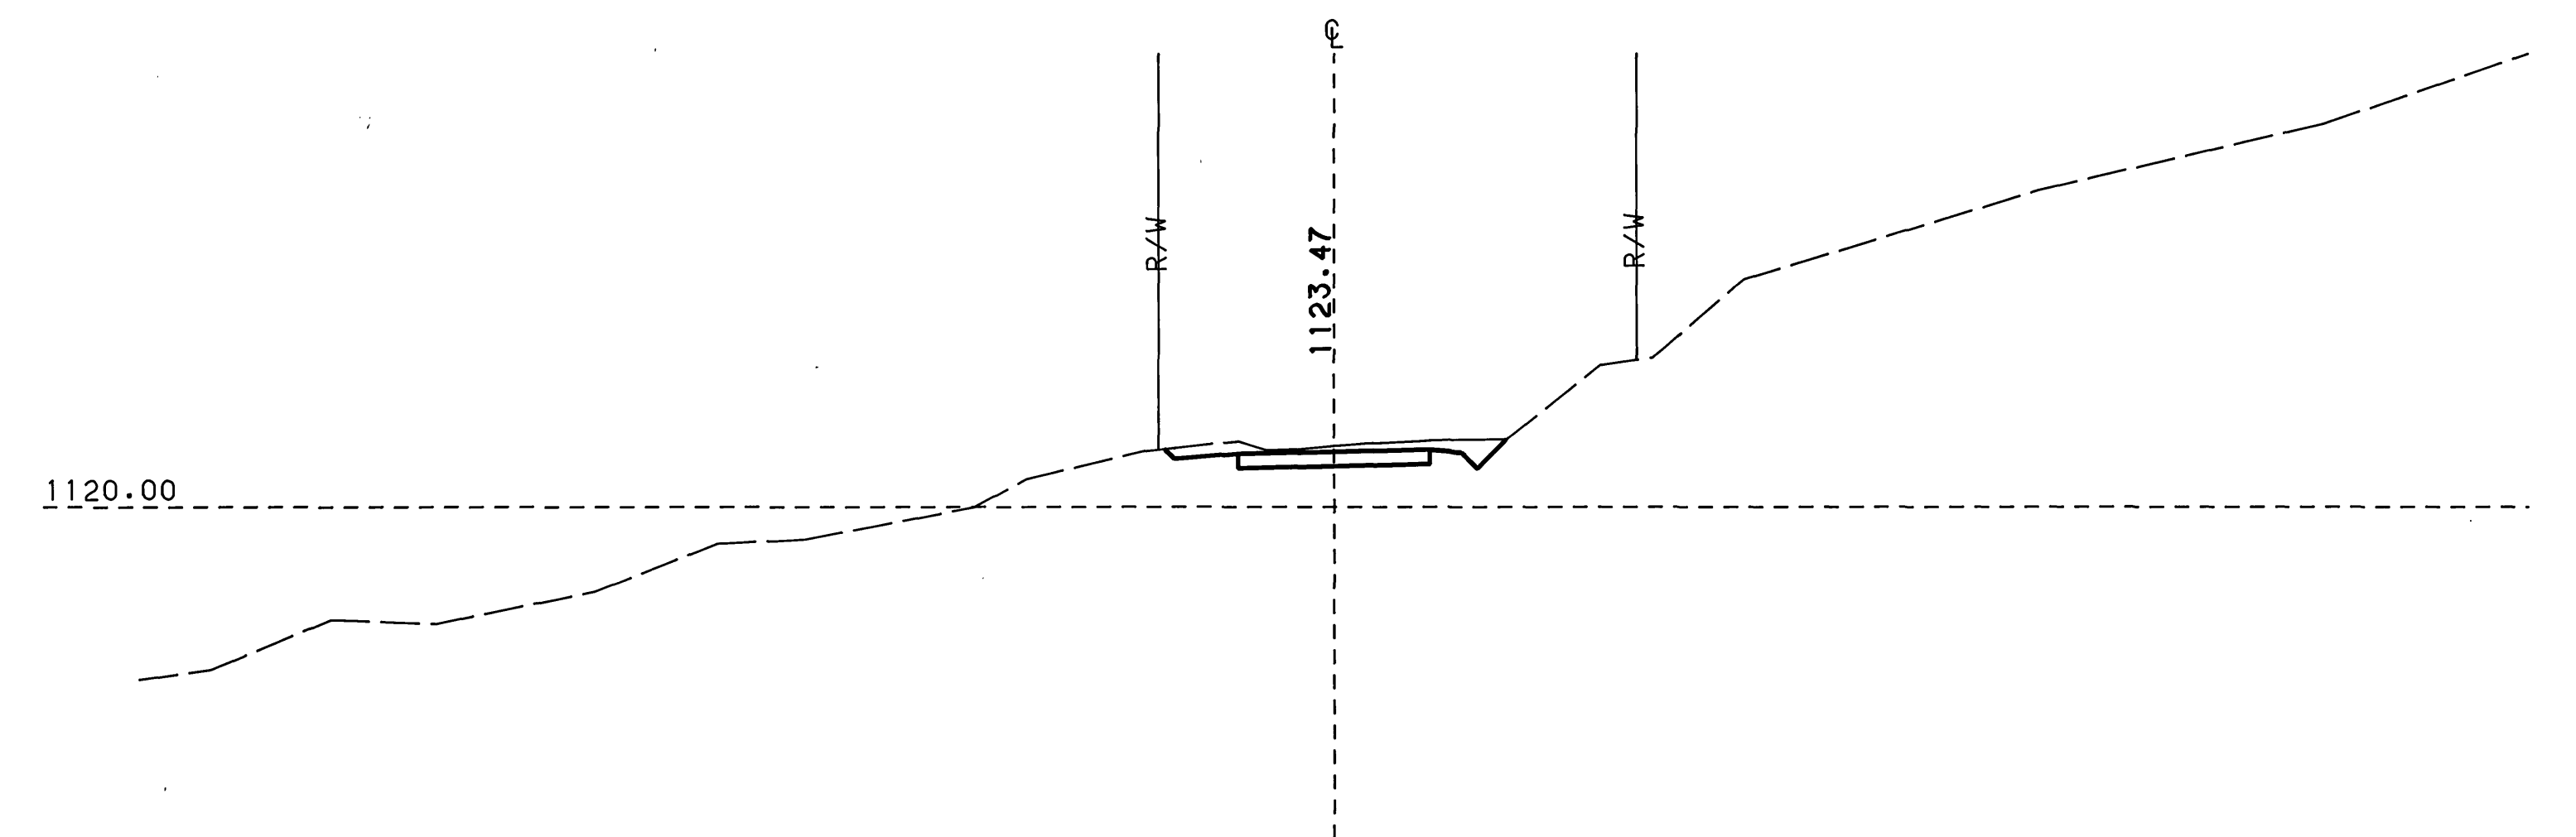

14+00.00

RECORD DRAWING

SCALE: H: 1"=10'
V: 1"=10'

MATTERN & CRAIG CONSULTING ENGINEERS • SURVEYORS ROANOKE VIRGINIA	DESIGNED:		REV	DATE	DESCRIPTION	BY	APP.	CARVINS COVE FILTER PLANT IMPROVEMENTS - PHASE I ROANOKE, VIRGINIA	DATE MARCH 1992
	DRAWN:								COMM. NO. 1138
ALVORD, BURDICK & HOWSON ENGINEERS CHICAGO	CHECKED:							ACCESS ROAD CROSS-SECTIONS	SHEET AR4
	SWH								AR4