
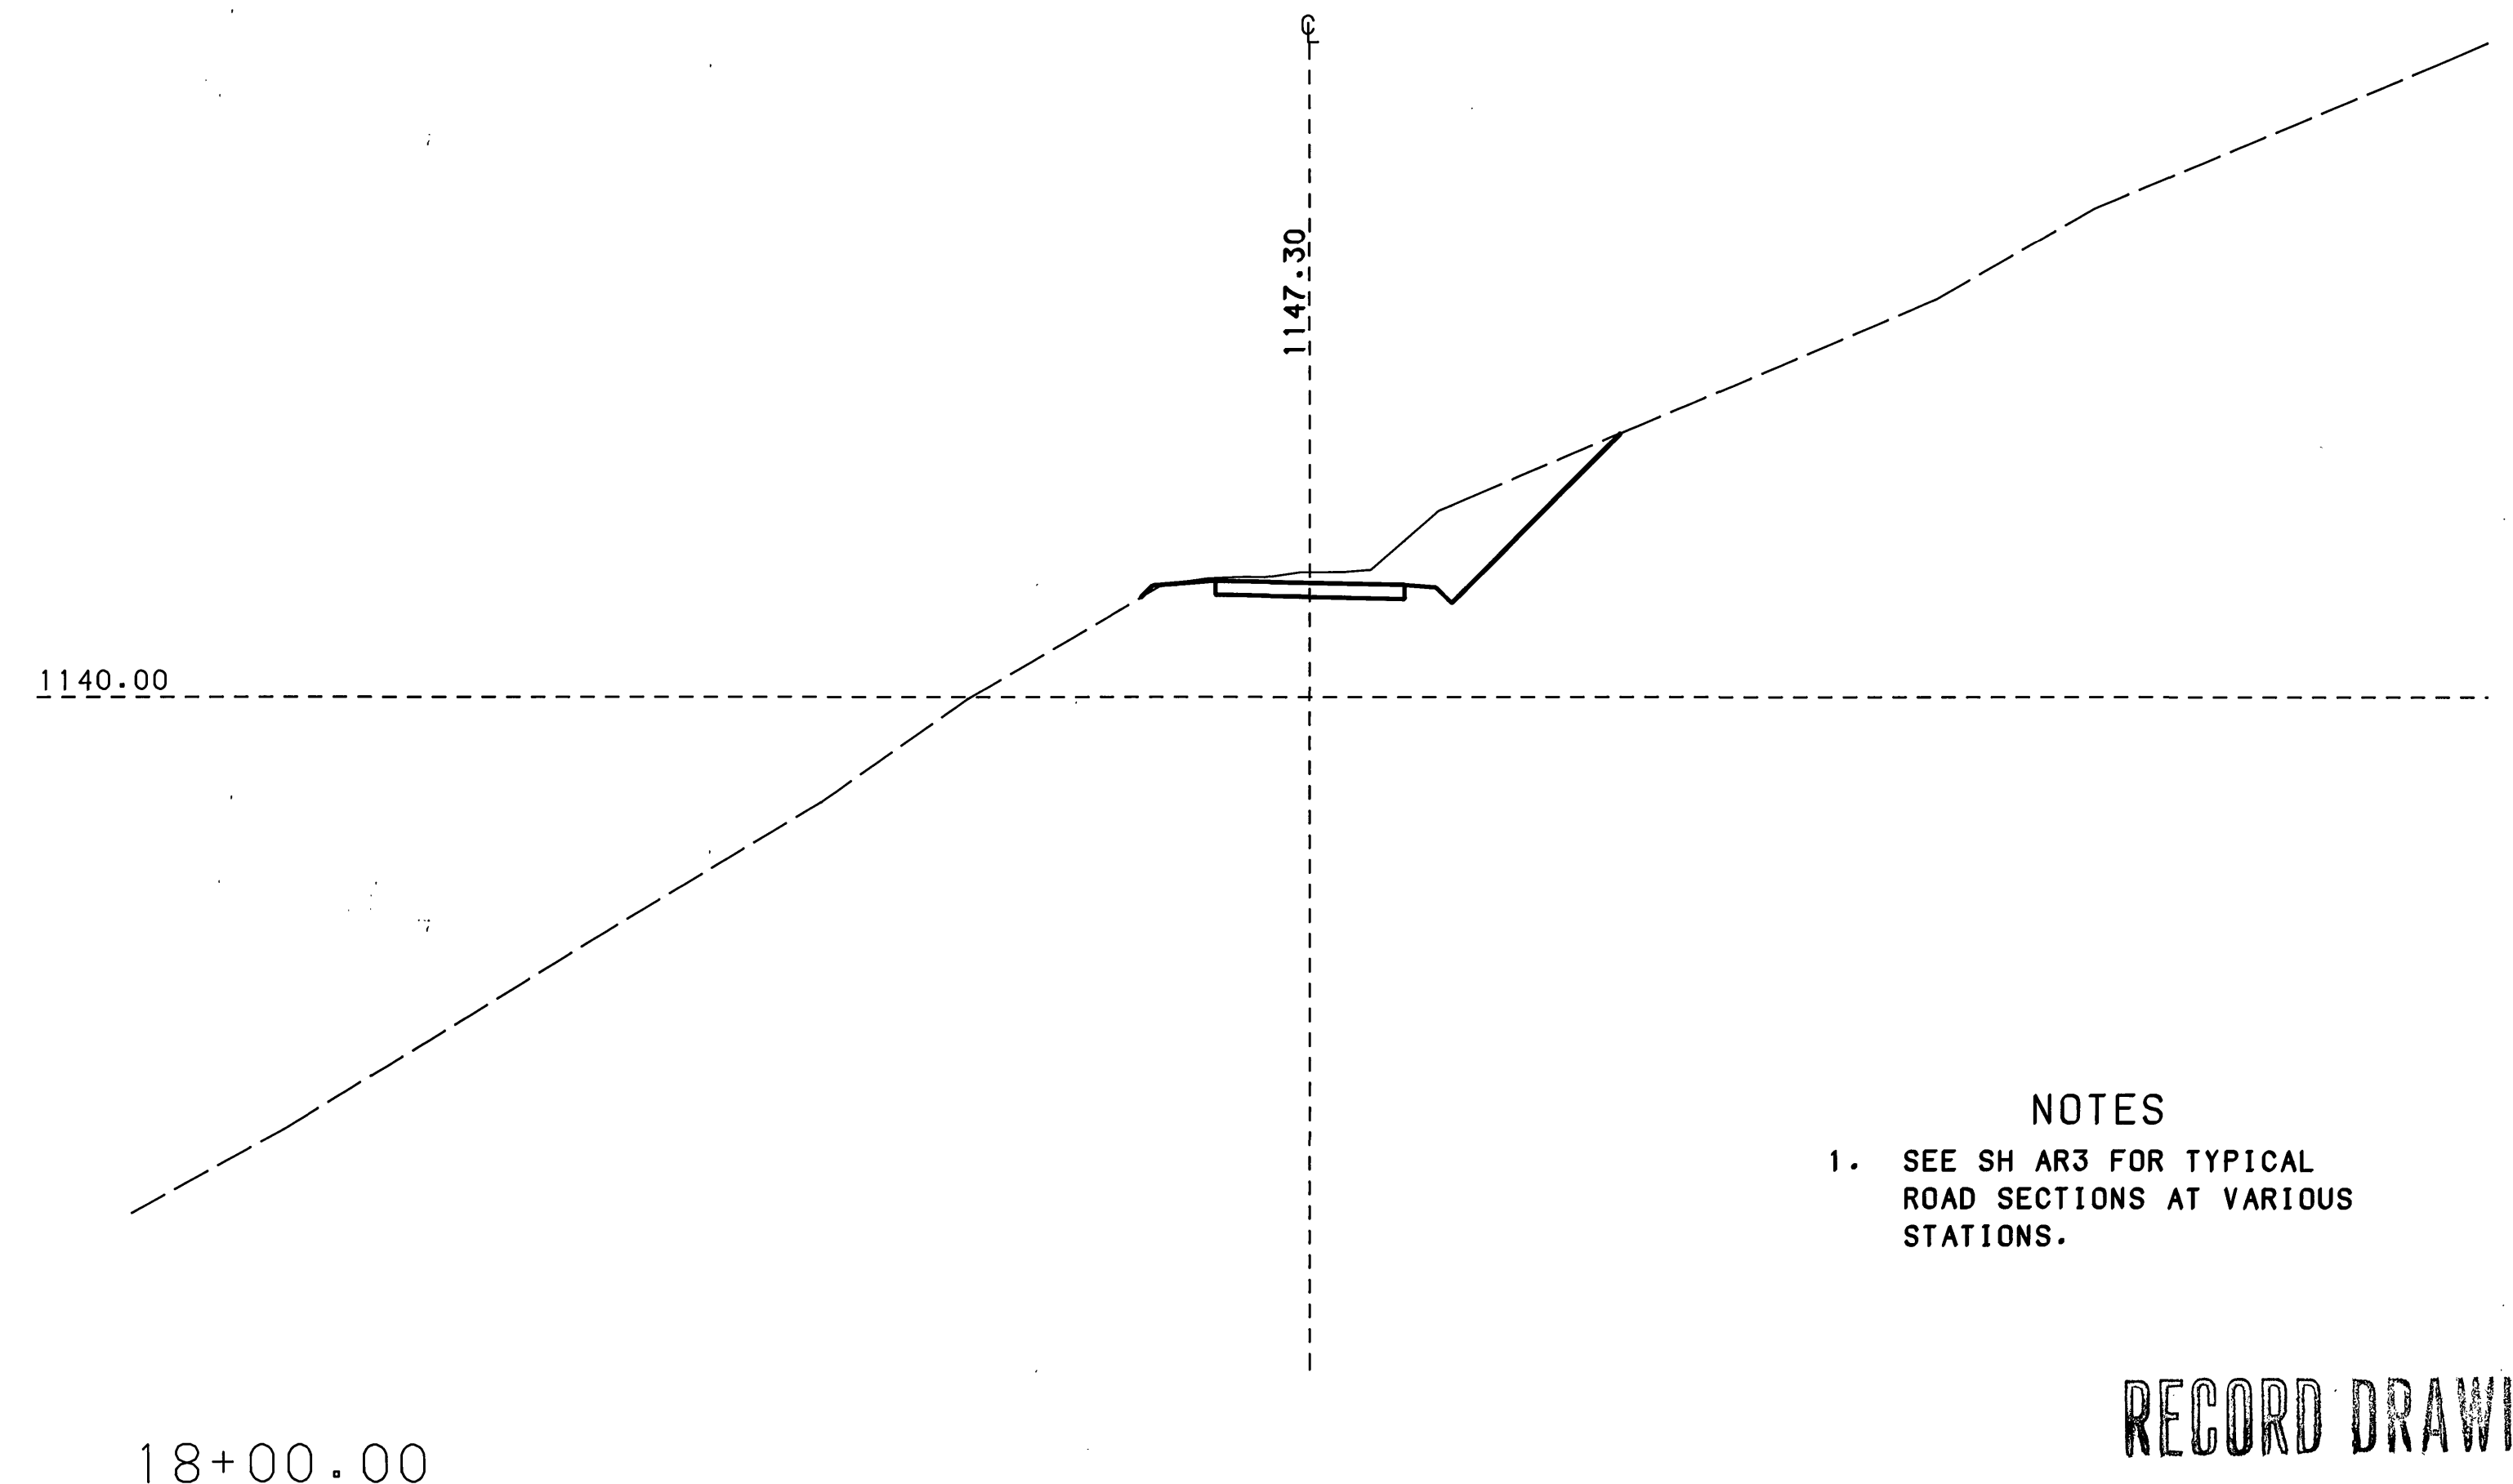
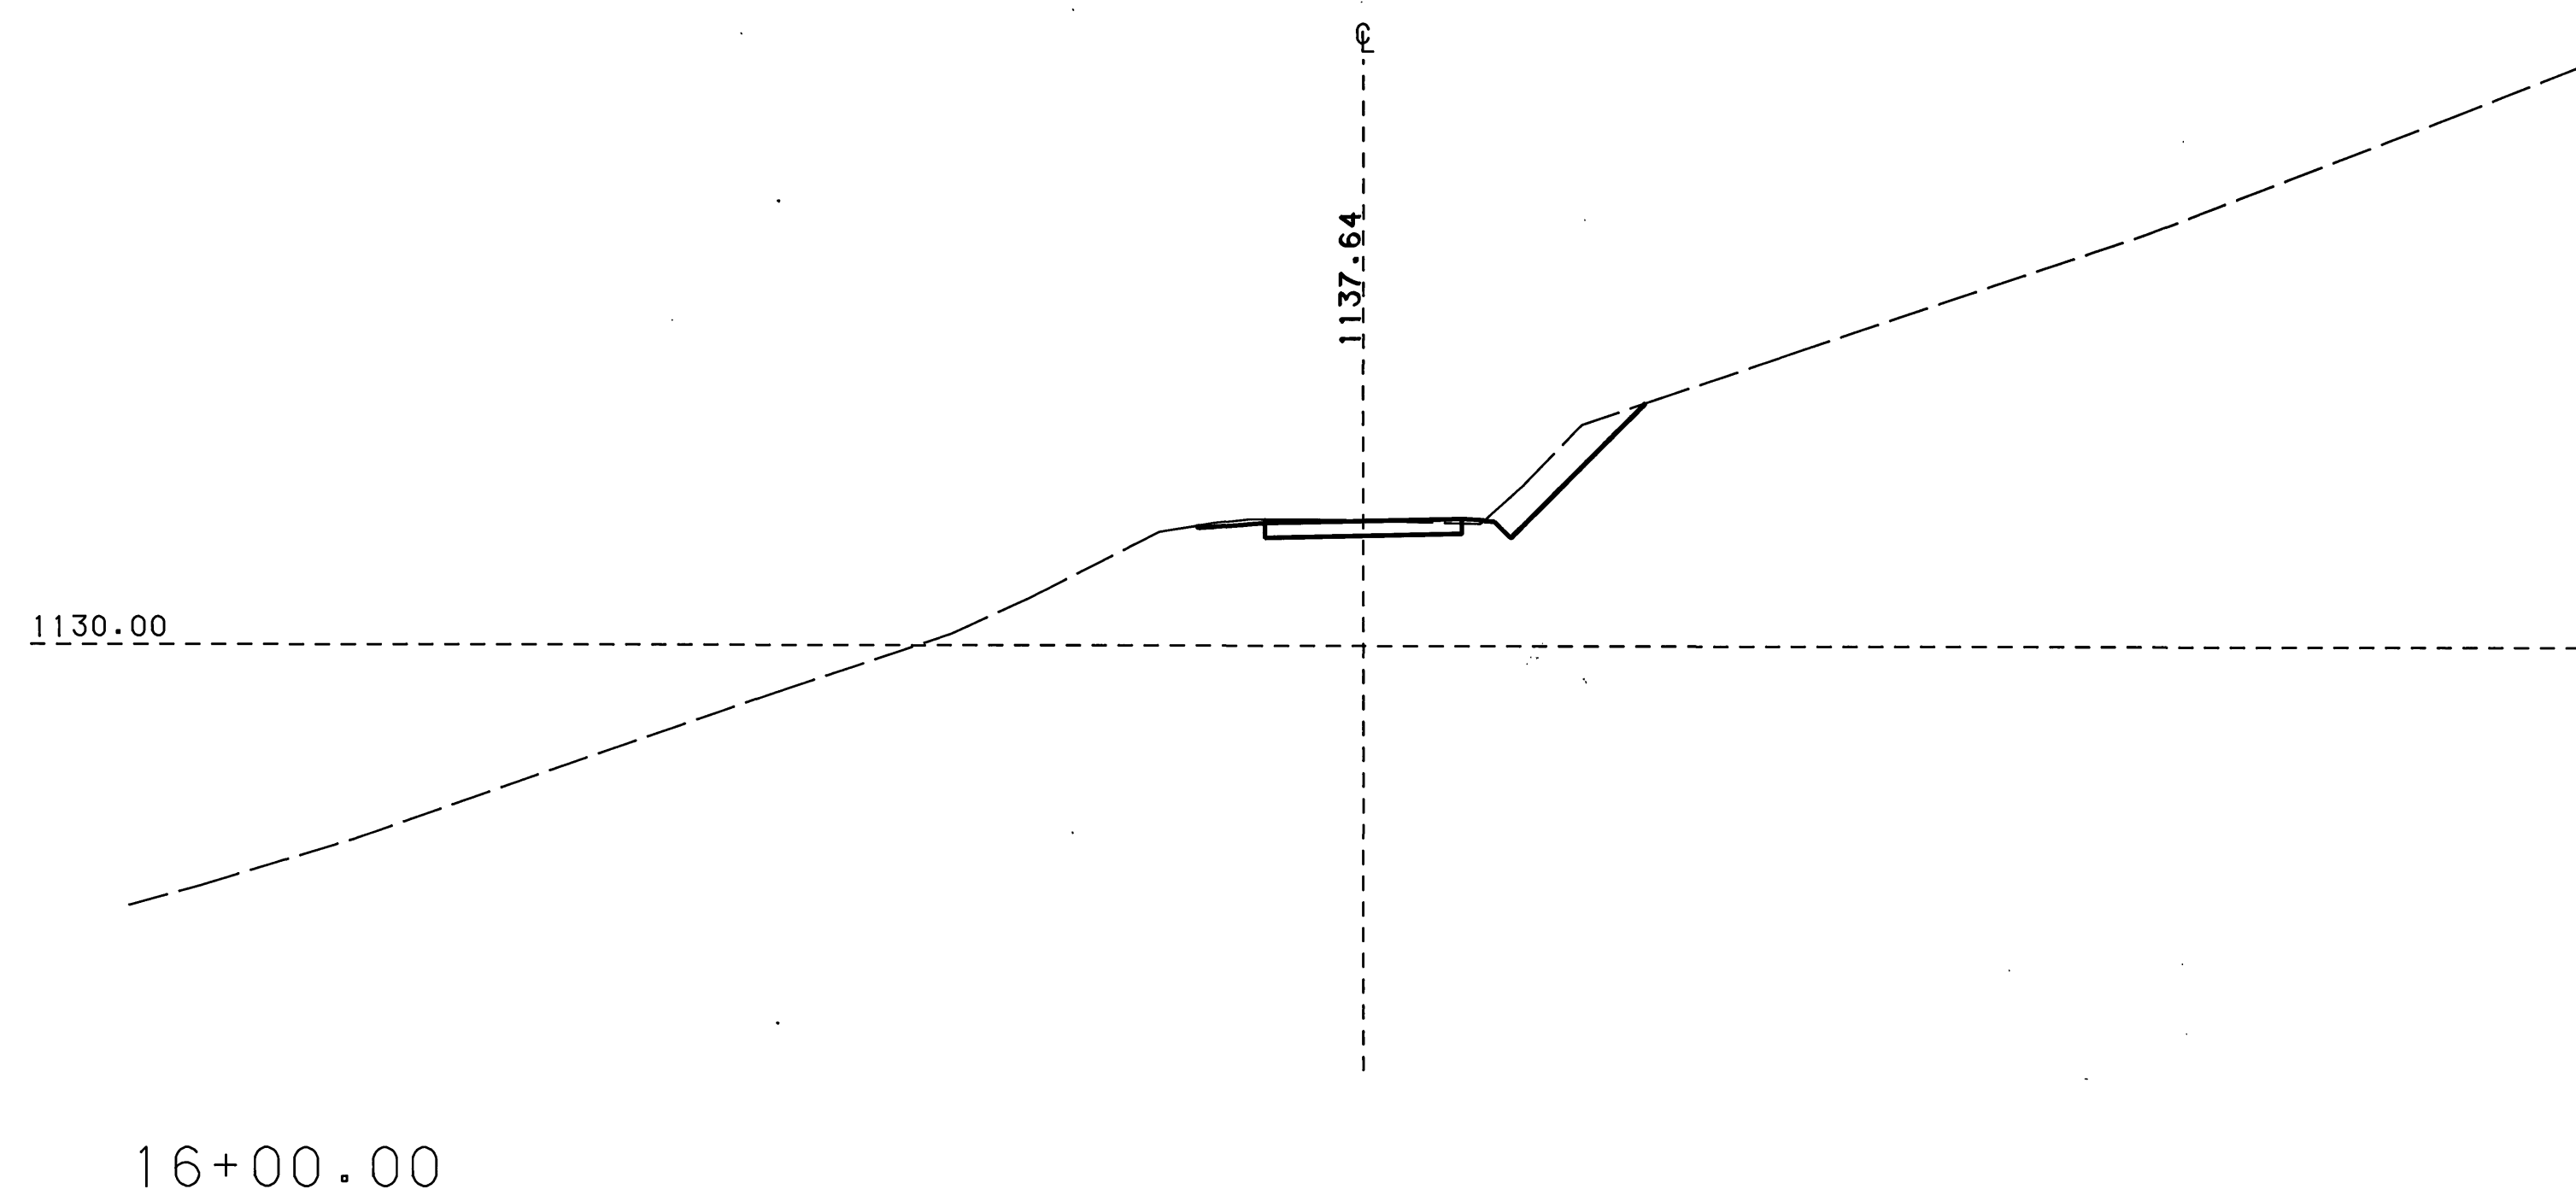
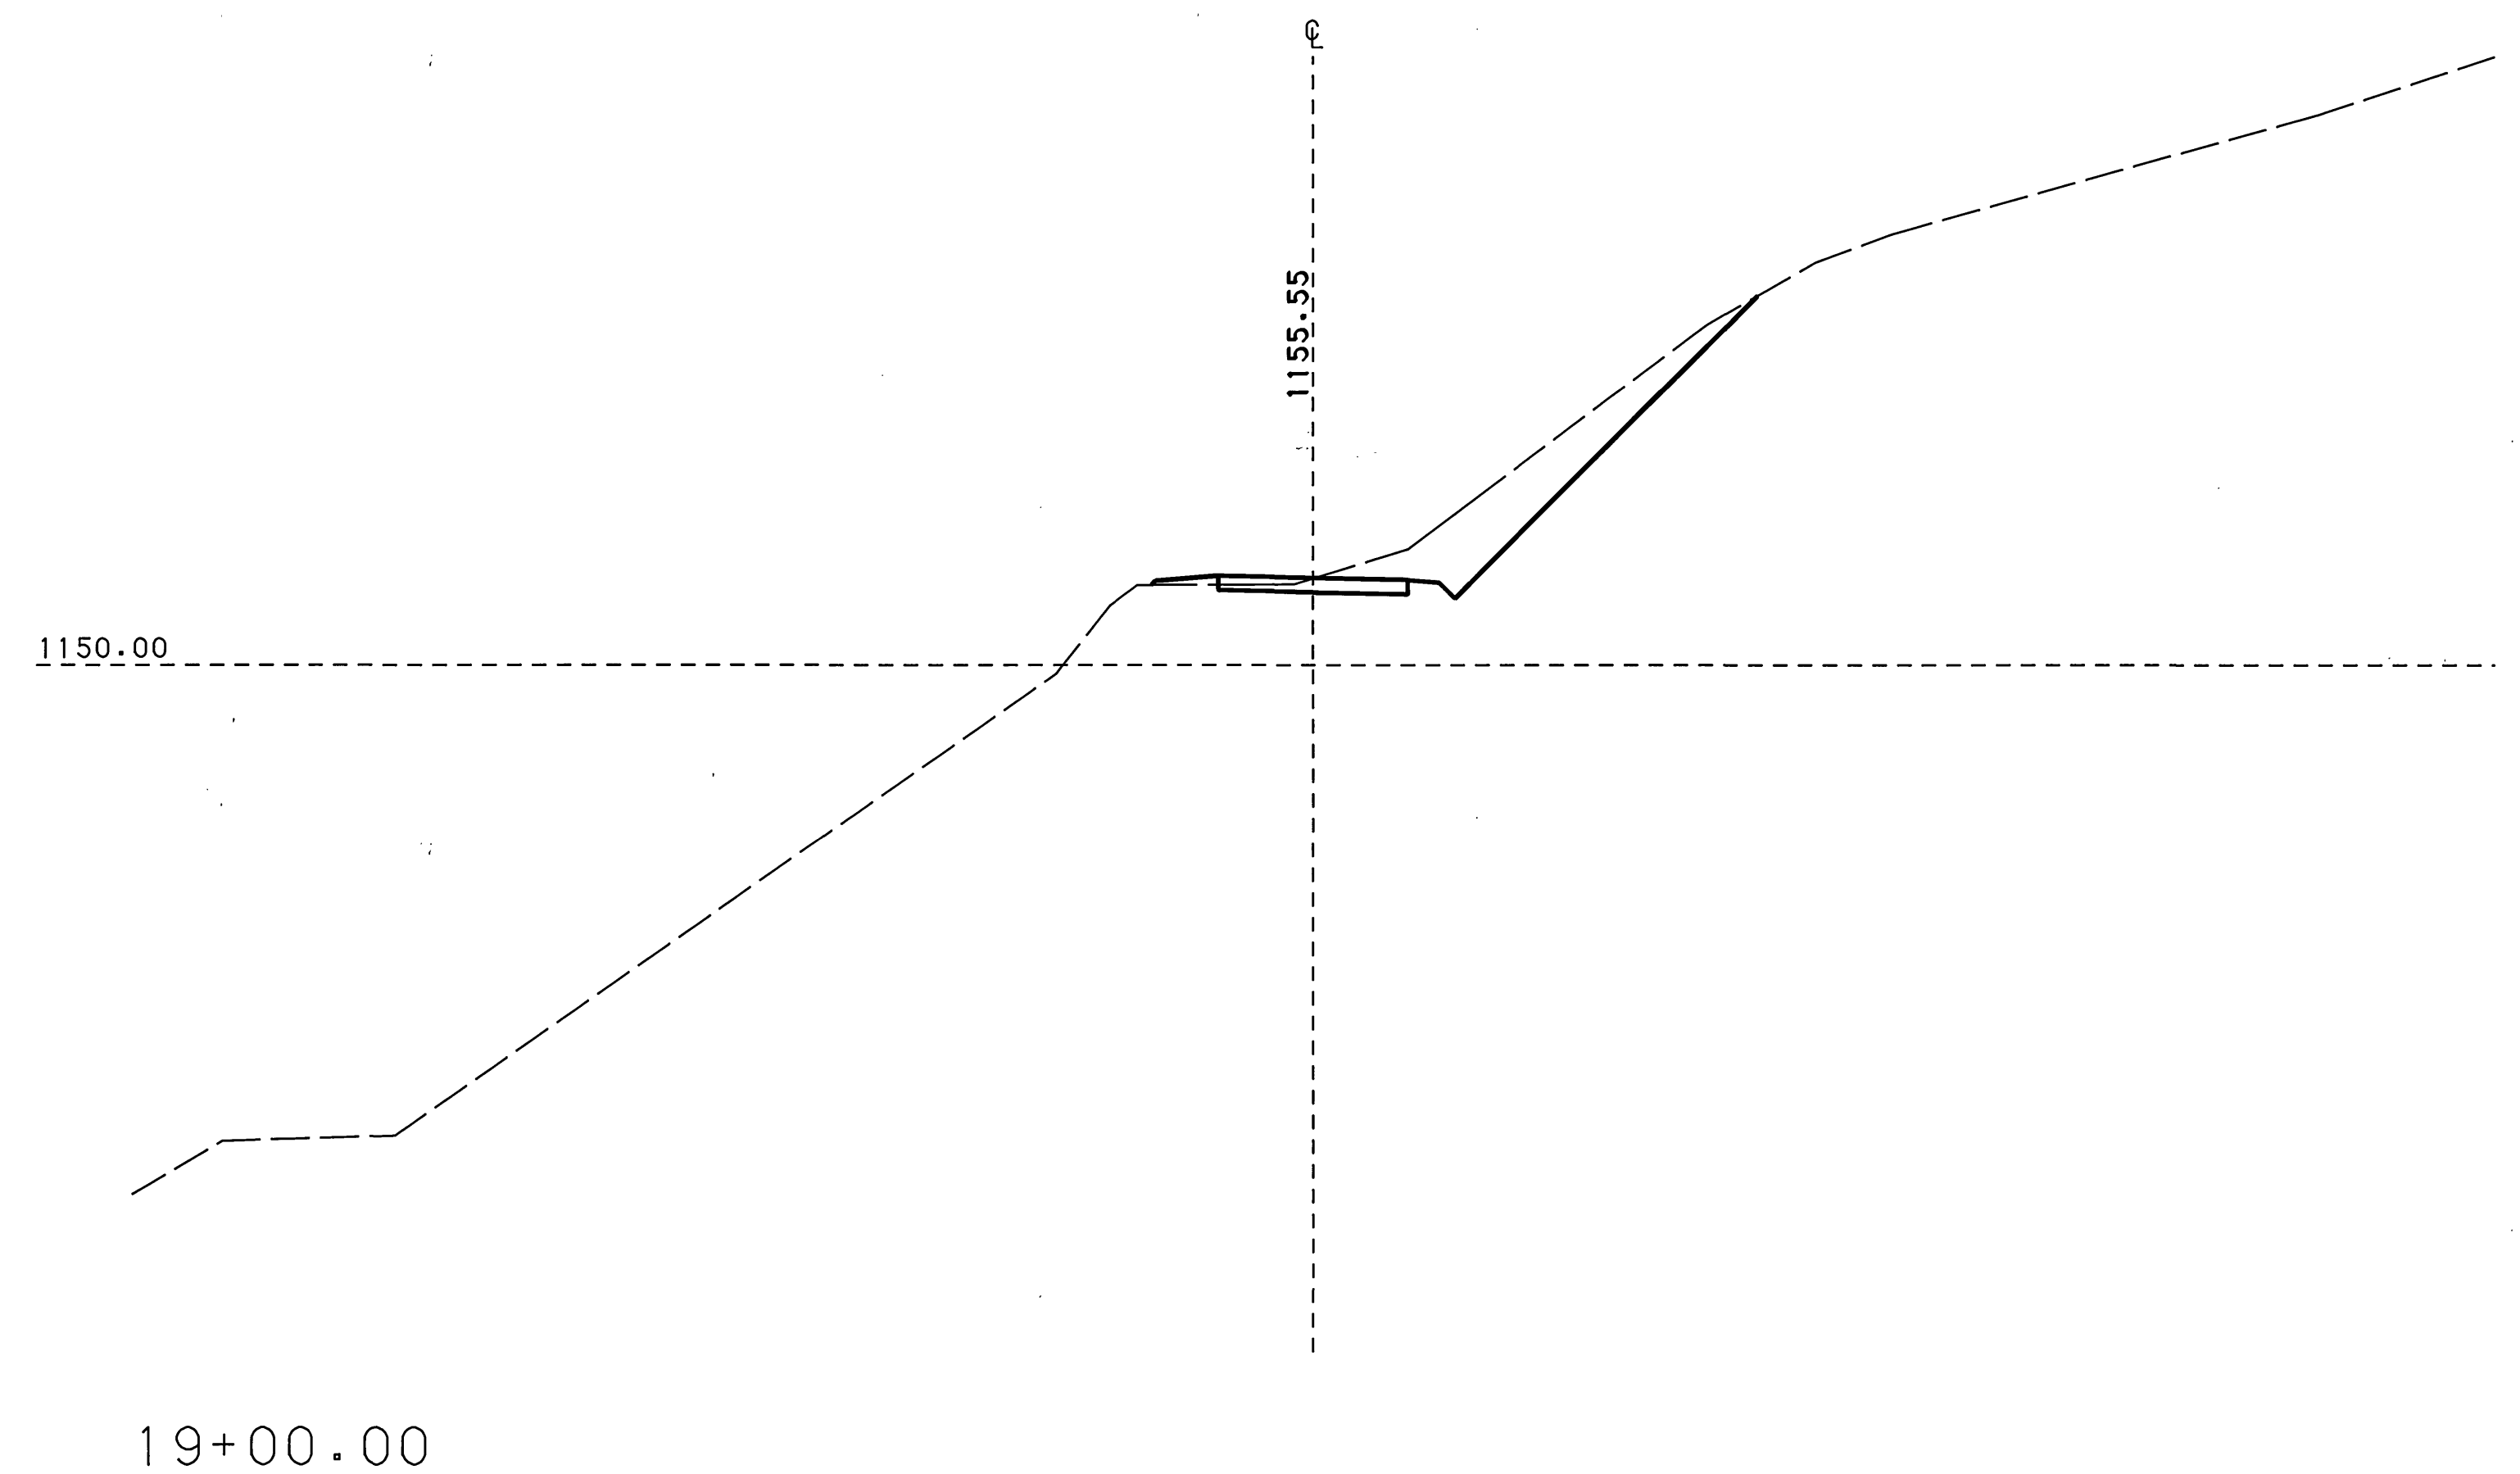


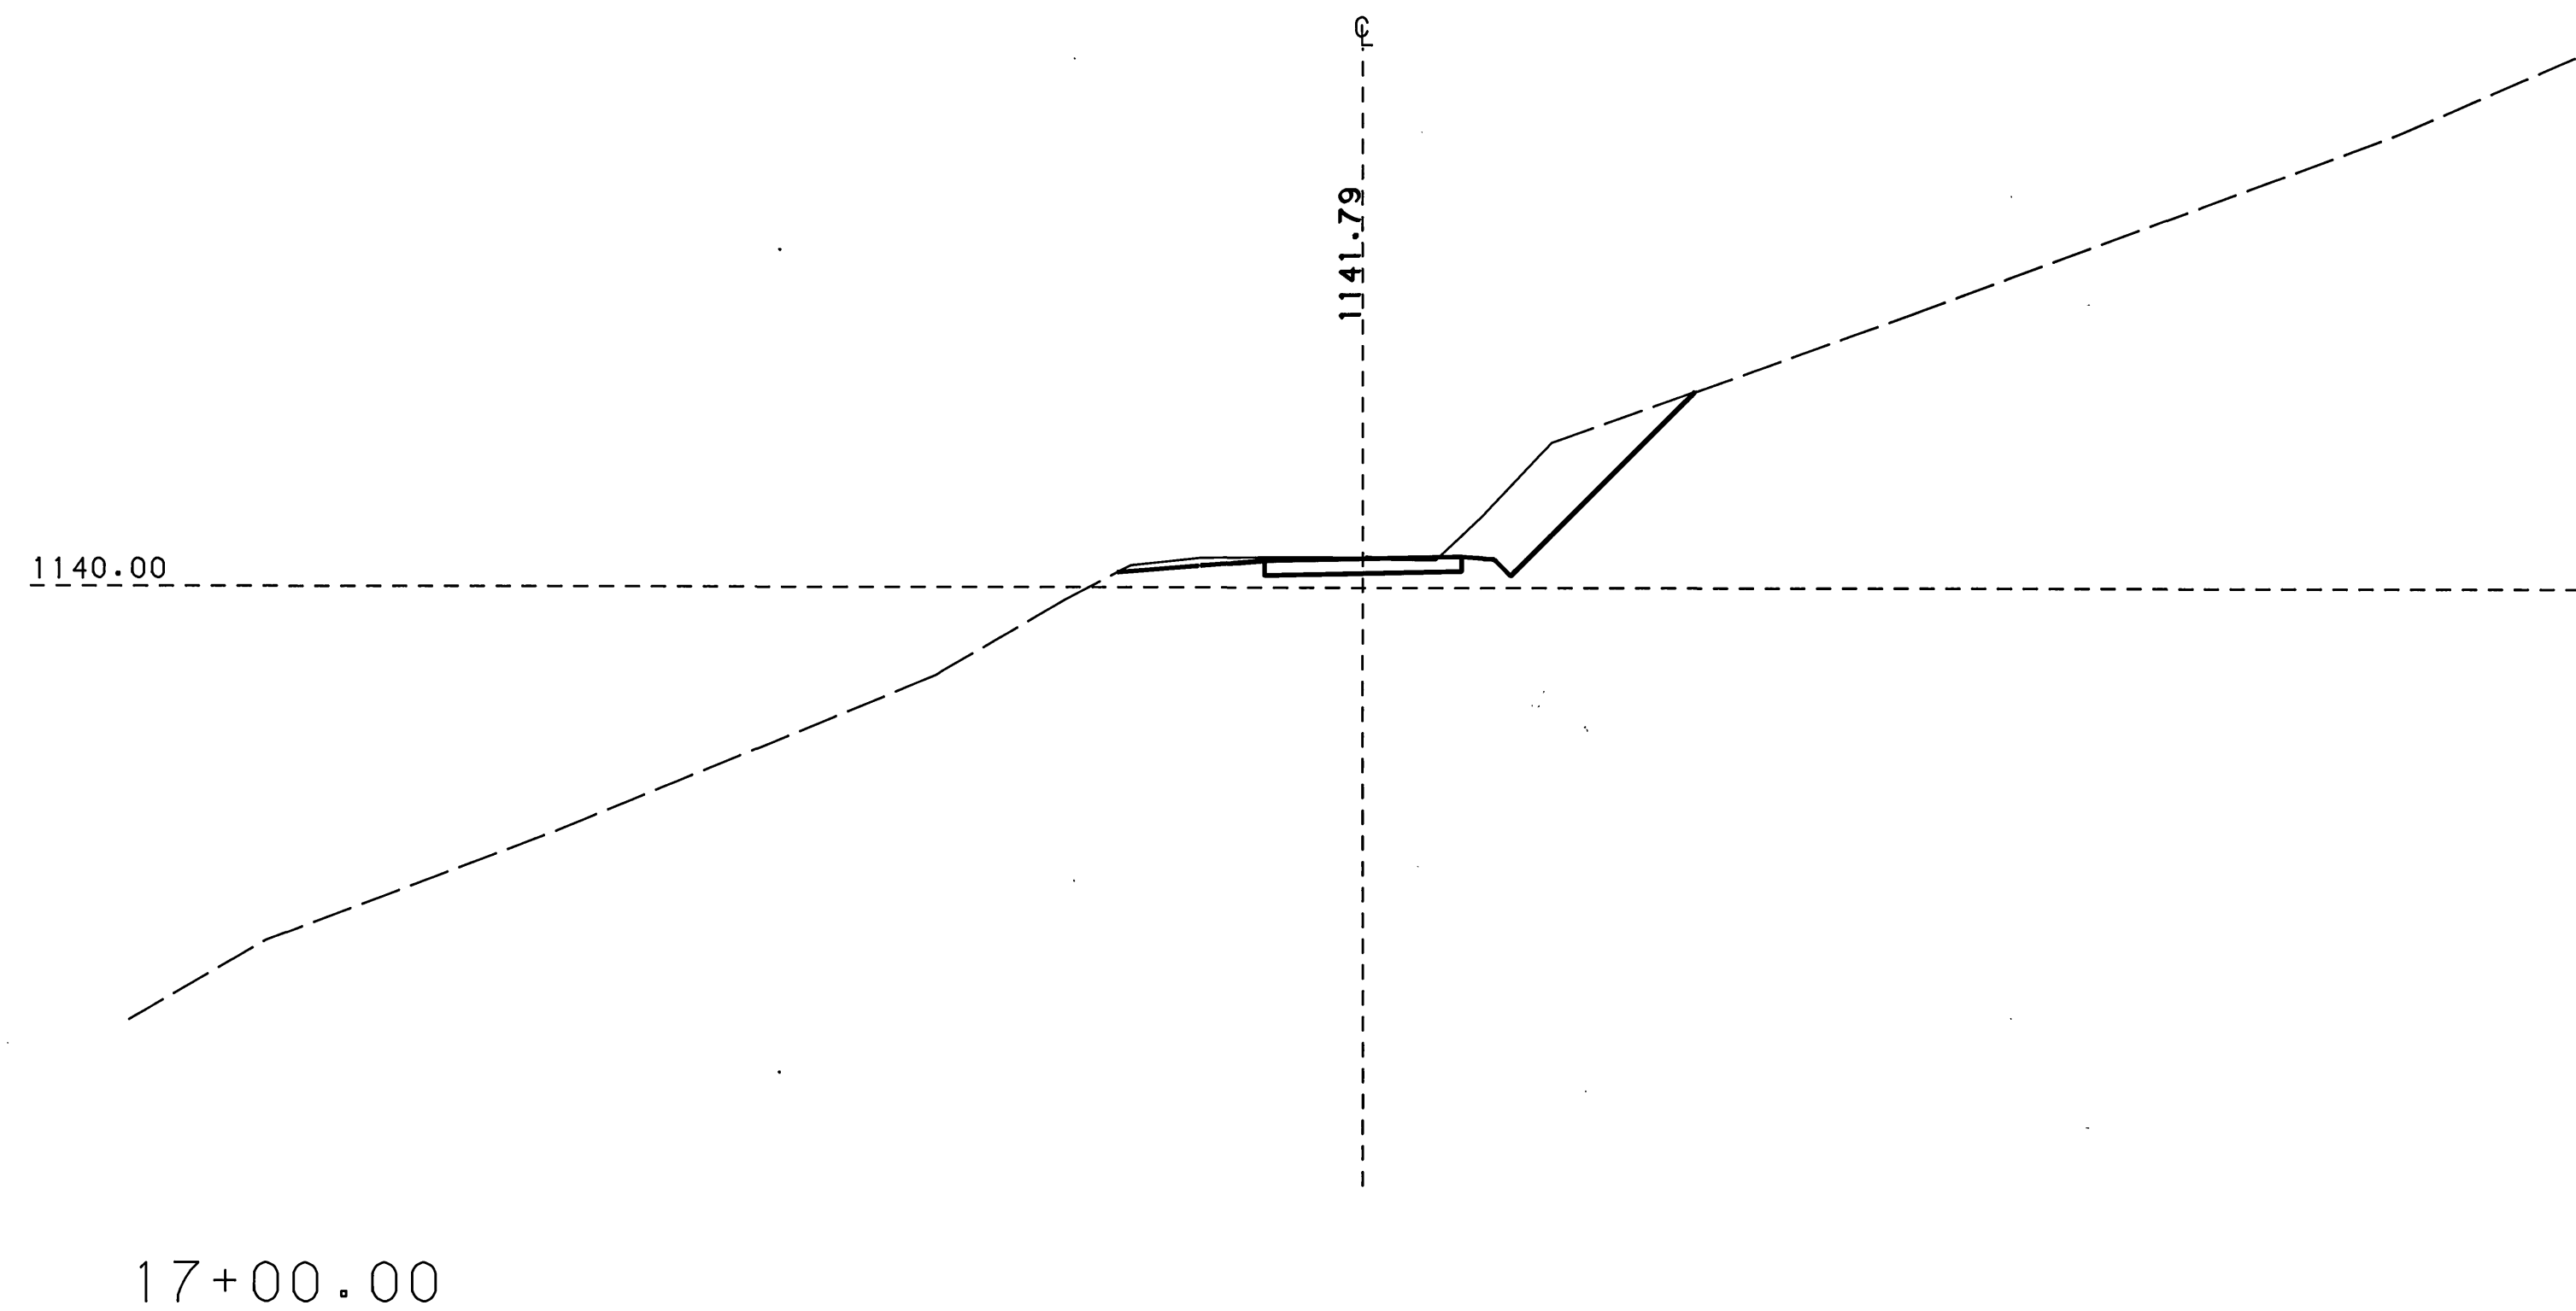

- NOTES
1. SEE SH AR3 FOR TYPICAL ROAD SECTIONS AT VARIOUS STATIONS.

RECORD DRAWING

SCALE: H: 1"=10'
V: 1"=10'

MATTERN & CRAIG CONSULTING ENGINEERS • SURVEYORS ROANOKE VIRGINIA	DESIGNED:		REV	DATE	DESCRIPTION	BY	APP.	CARVINS COVE FILTER PLANT IMPROVEMENTS - PHASE I ROANOKE, VIRGINIA	DATE
	DME								MARCH 1992
ALVORD, BURDICK & HOWSON ENGINEERS CHICAGO	DRAWN:							ACCESS ROAD CROSS-SECTIONS	COMM. NO.
	ASB								1138
	CHECKED:								SHEET
	SWH								AR5