




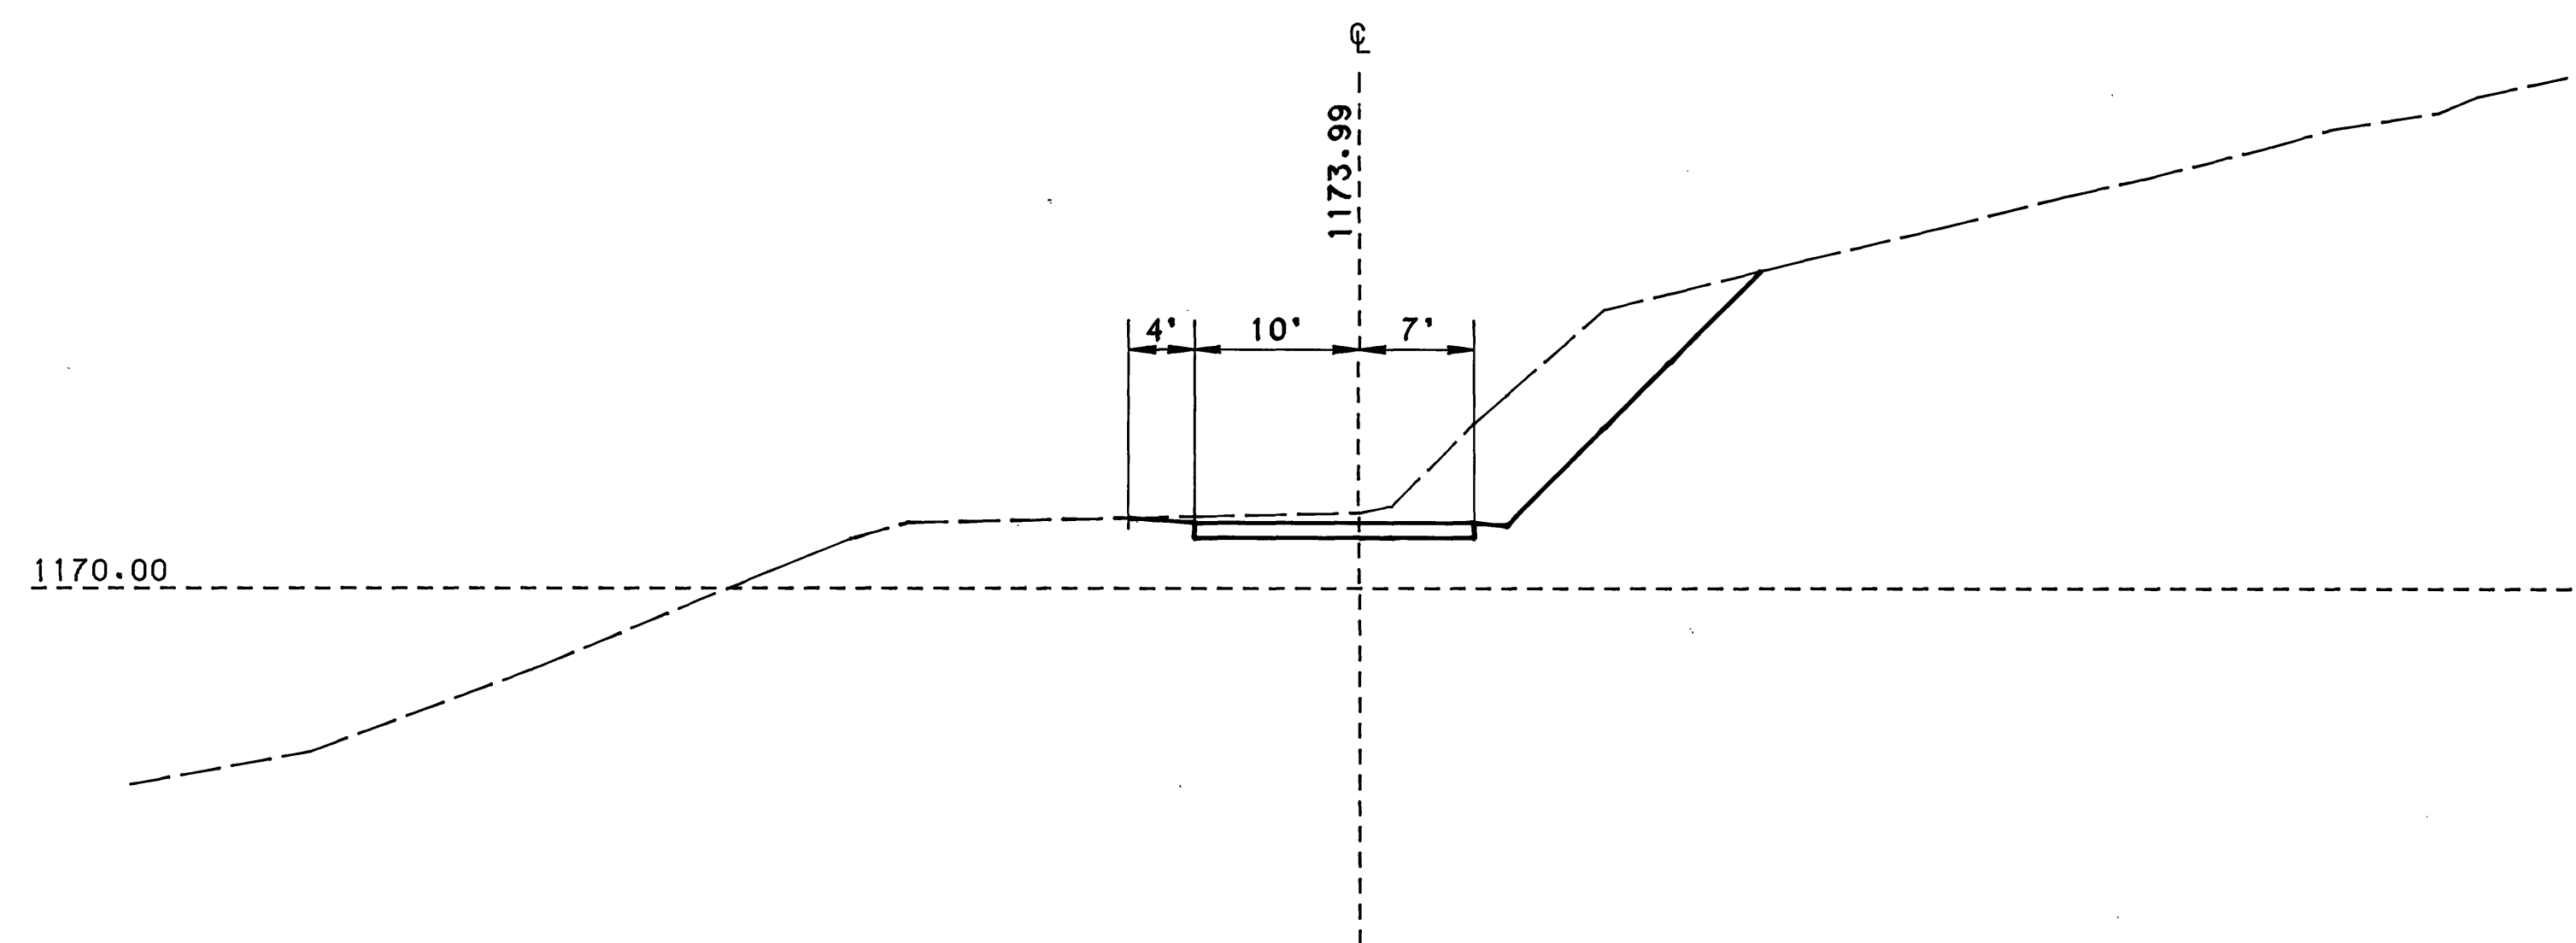


20+97.00 (AHEAD)

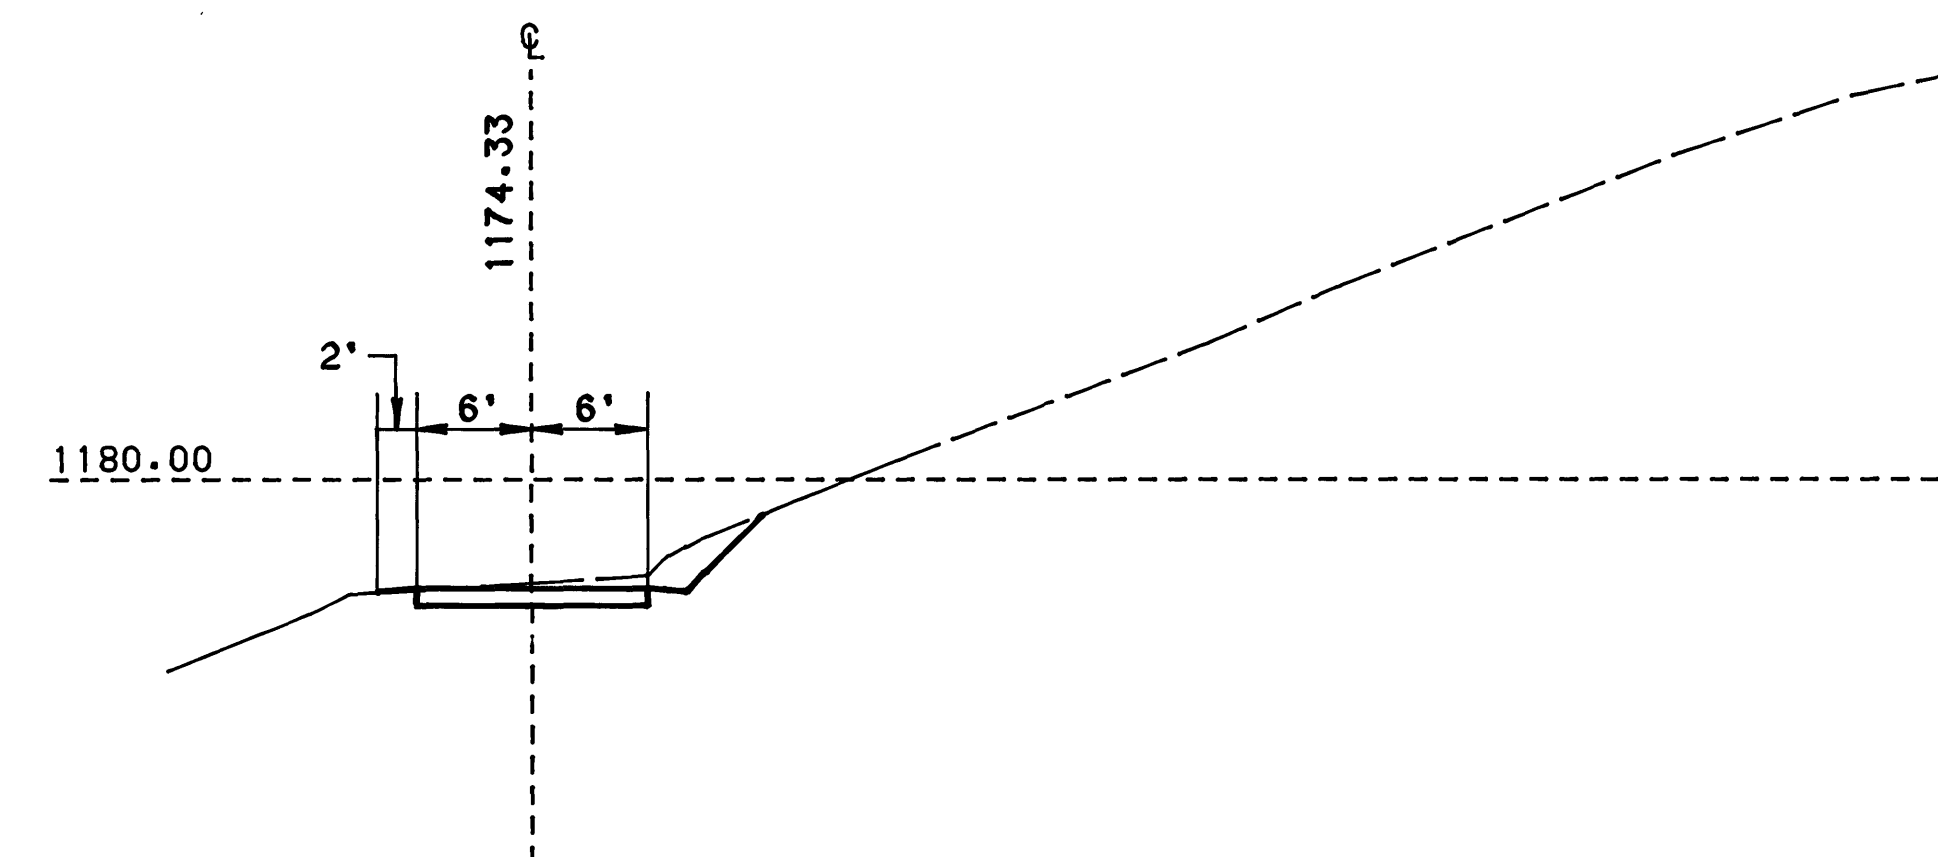

21+15.00

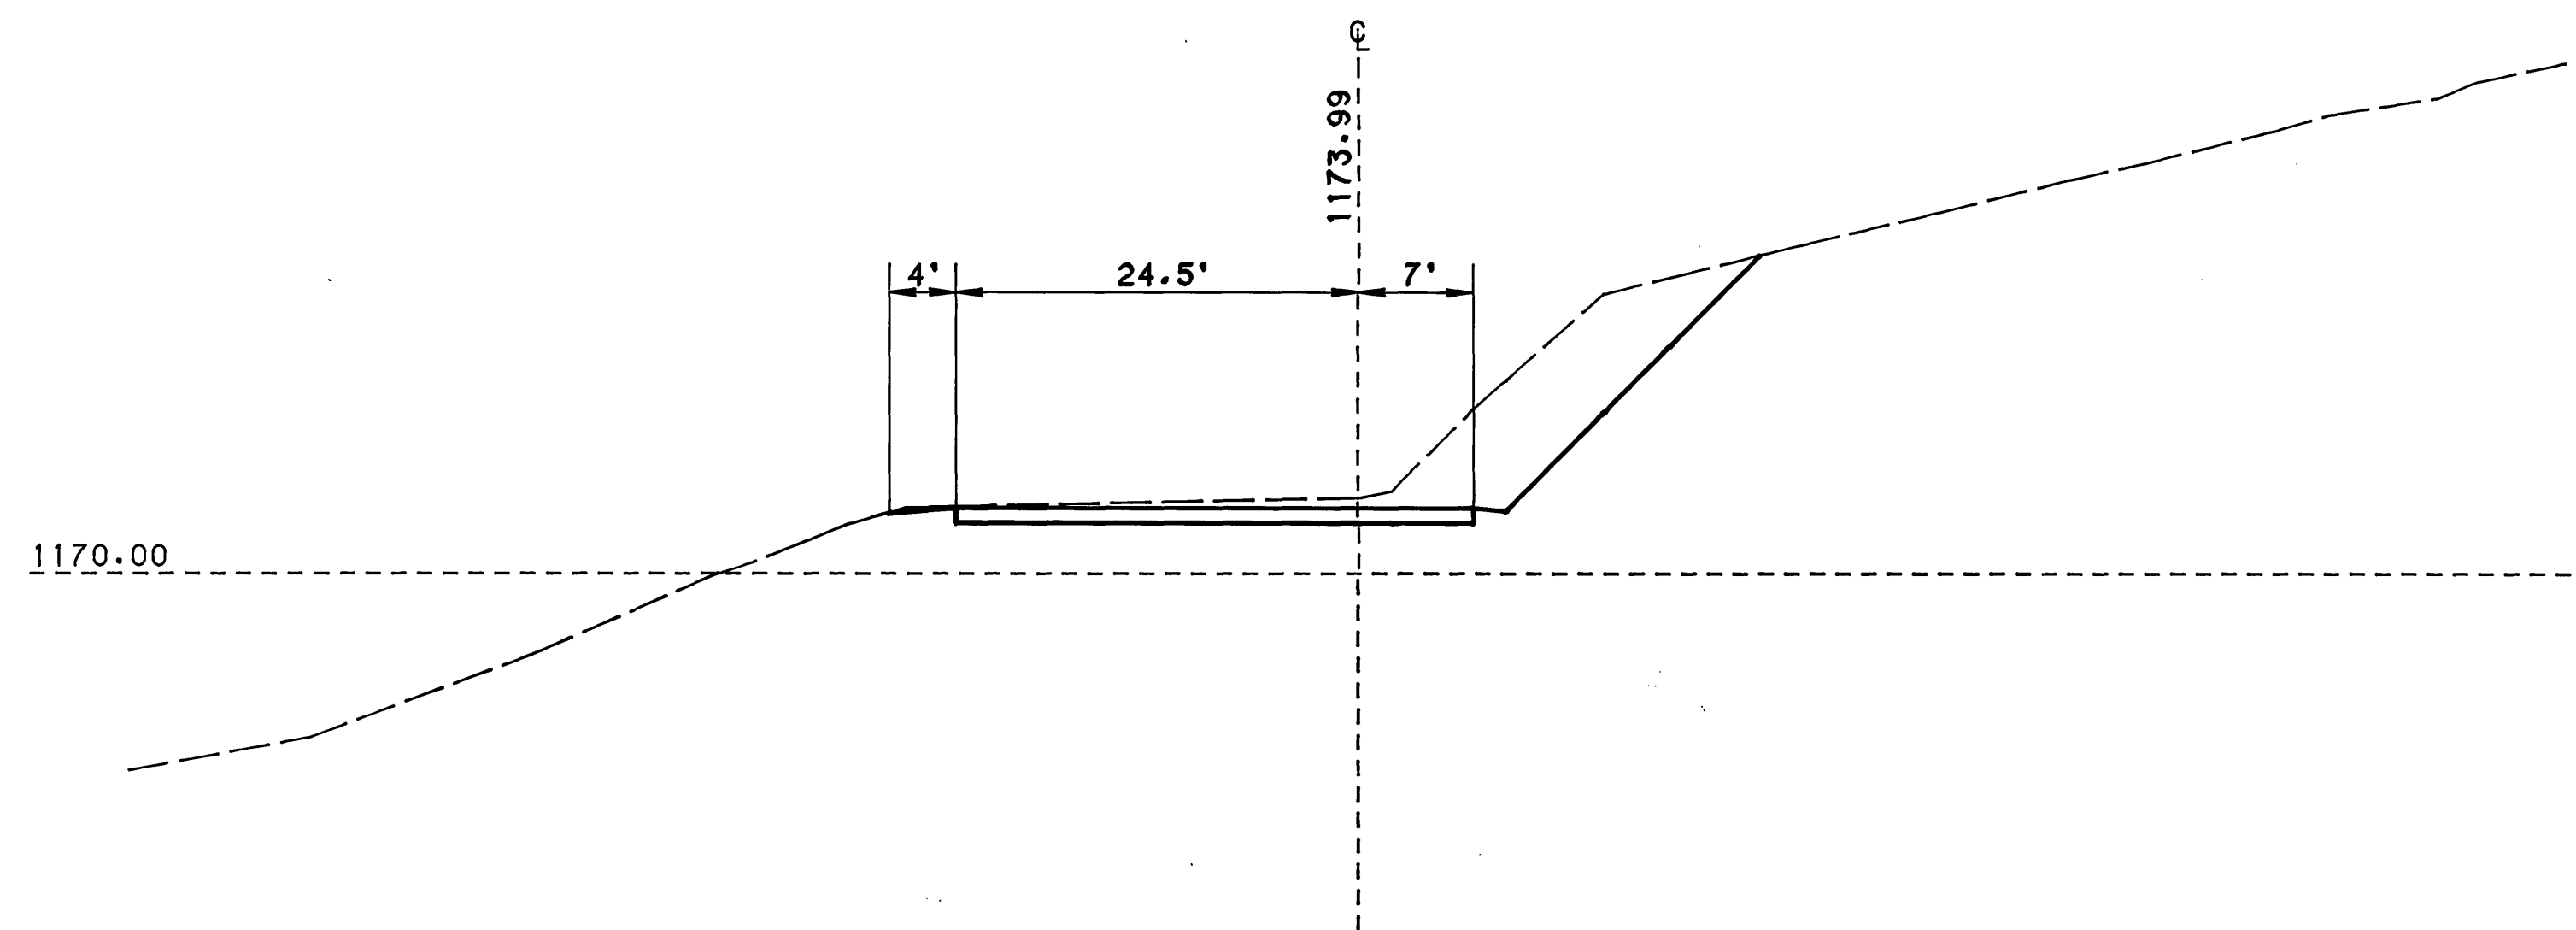

20+97.00 (BACK)

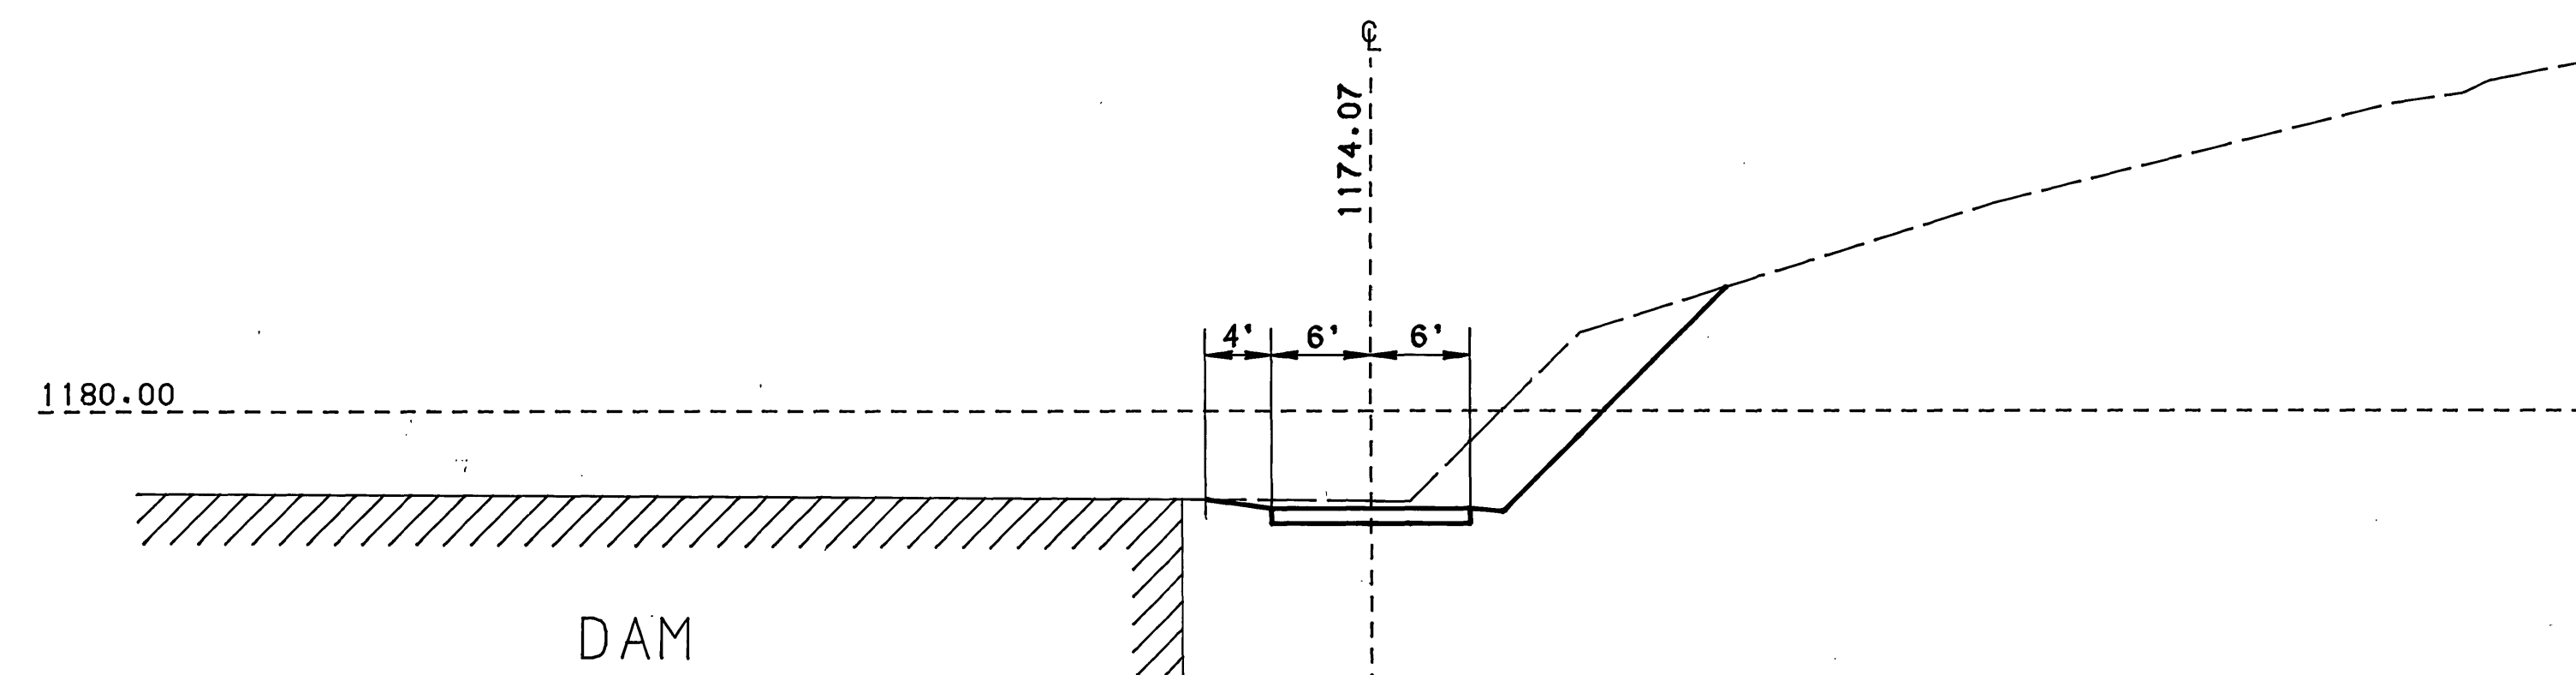

21+00.00

- NOTES
- SEE SH AR3 FOR TYPICAL ROAD SECTIONS AT VARIOUS STATIONS.

RECORD DRAWING

SCALE: H: 1"=10'
V: 1"=10'

MATTERN & CRAIG CONSULTING ENGINEERS • SURVEYORS ROANOKE VIRGINIA	DESIGNED: DME		REV	DATE	DESCRIPTION	BY	APP.	CARVINS COVE FILTER PLANT IMPROVEMENTS - PHASE I ROANOKE, VIRGINIA	DATE MARCH 1992
	DRAWN: ASB								COMM. NO. 1138
ALVORD, BURDICK & HOWSON ENGINEERS CHICAGO	CHECKED: SWH							ACCESS ROAD CROSS-SECTIONS	SHEET AR8
									AR8