

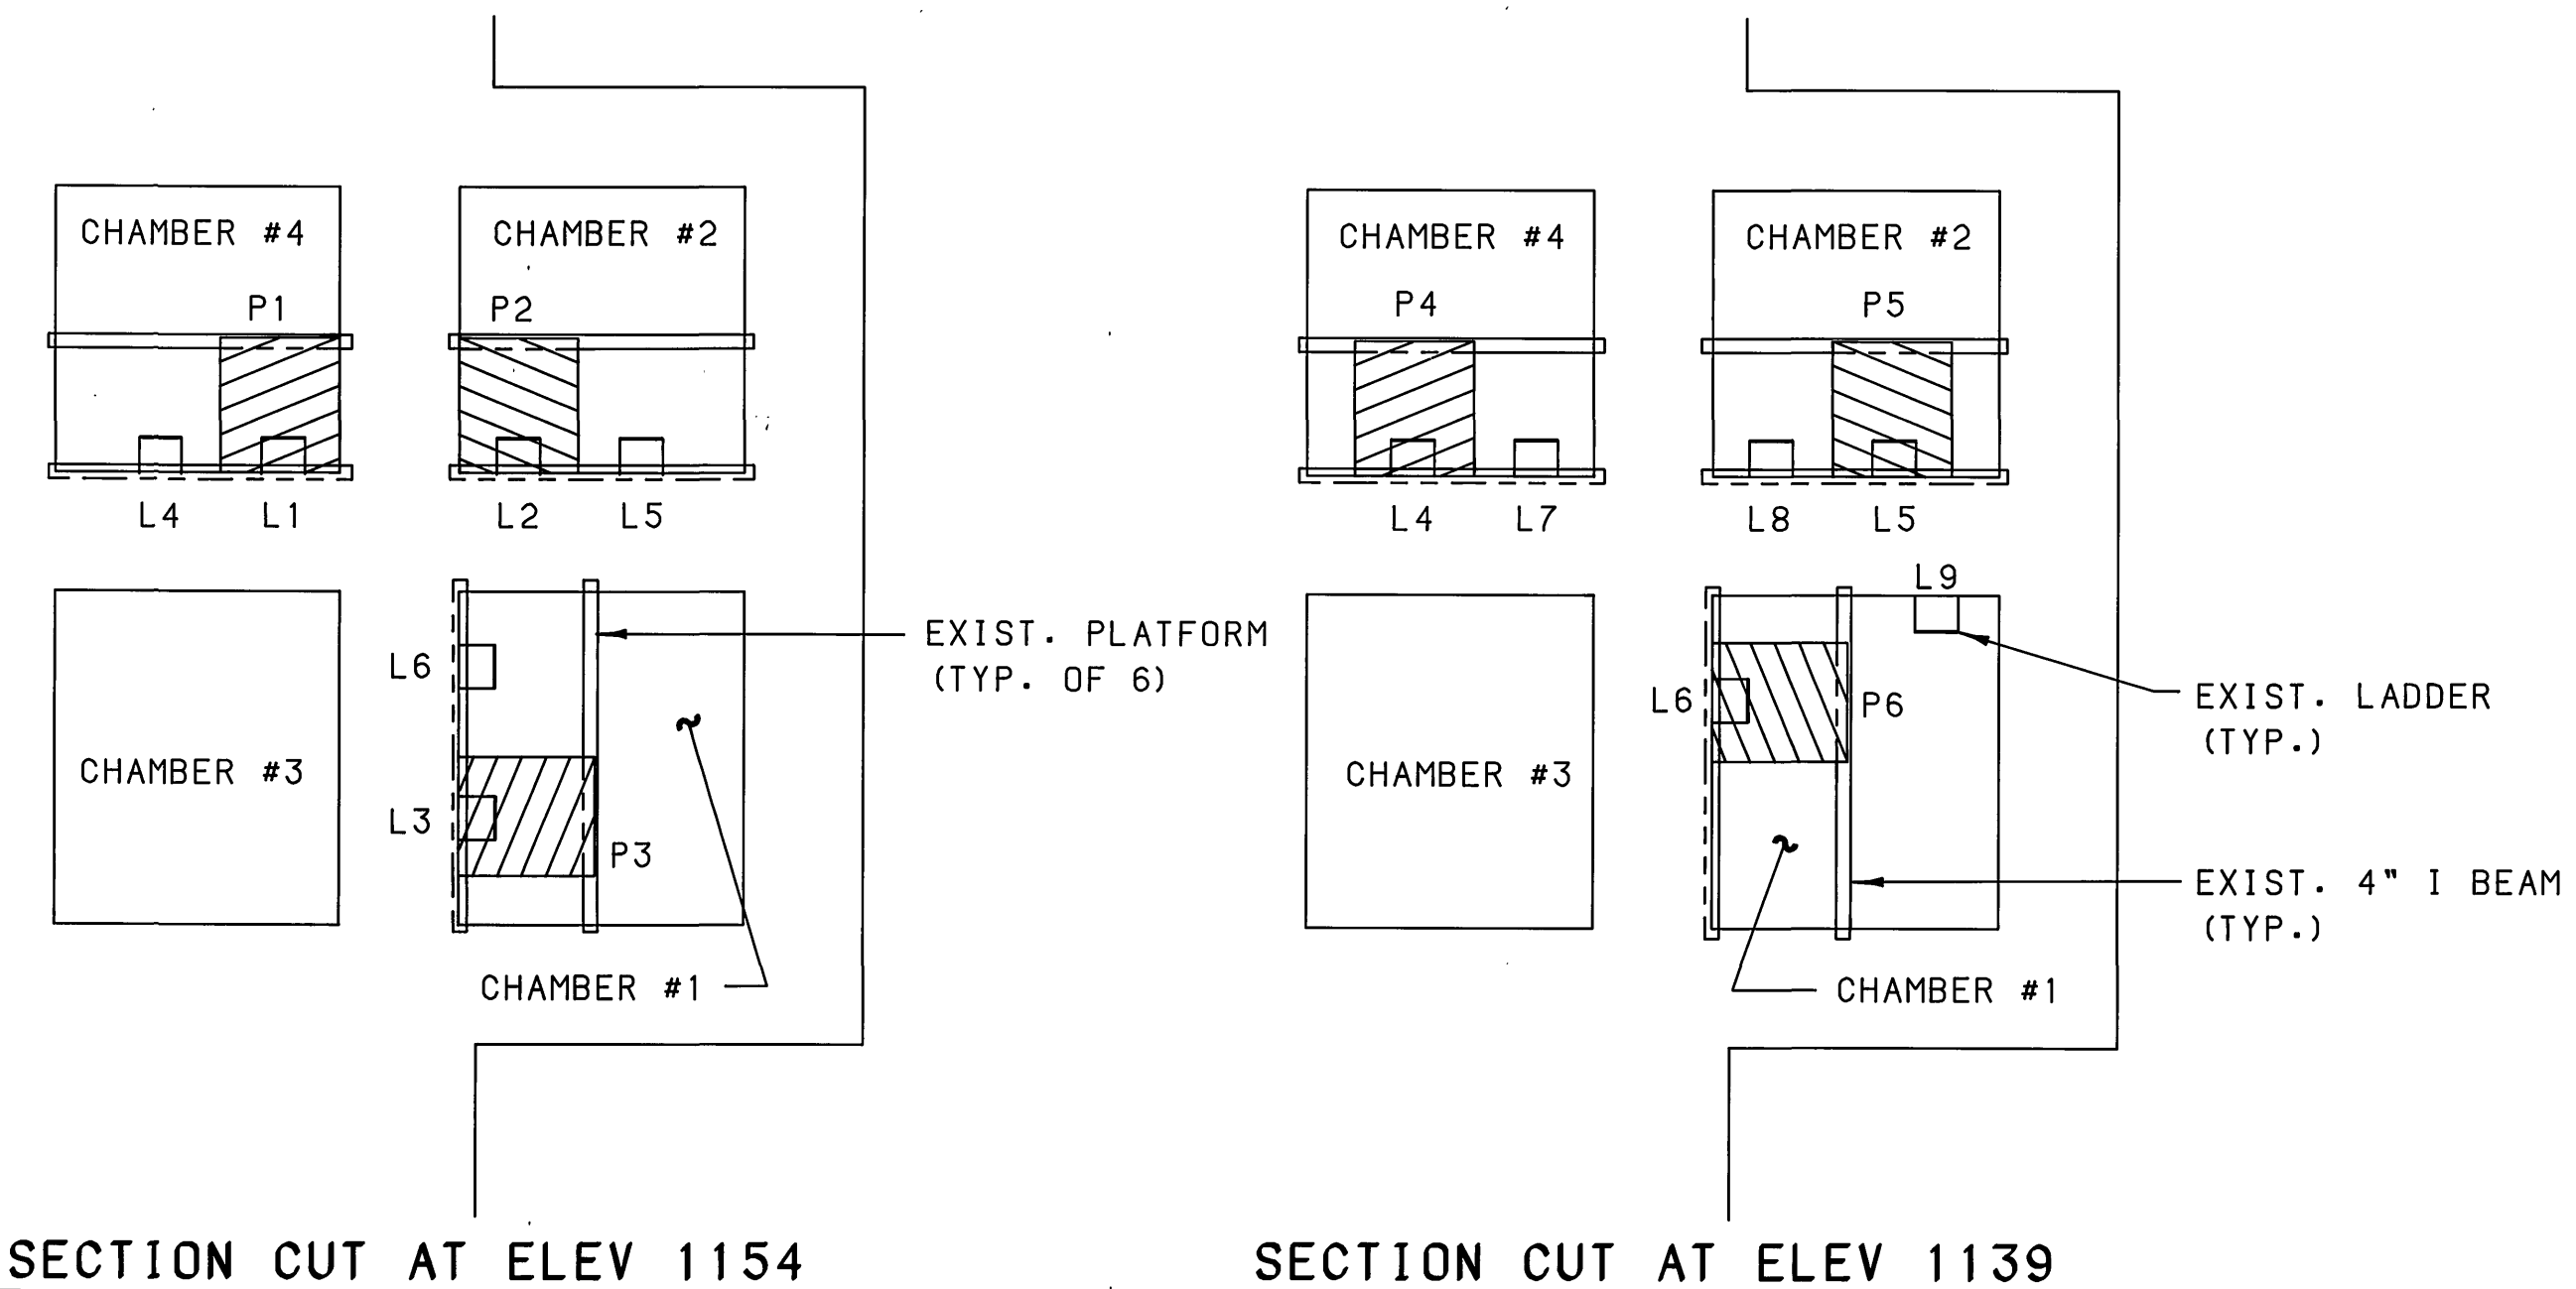


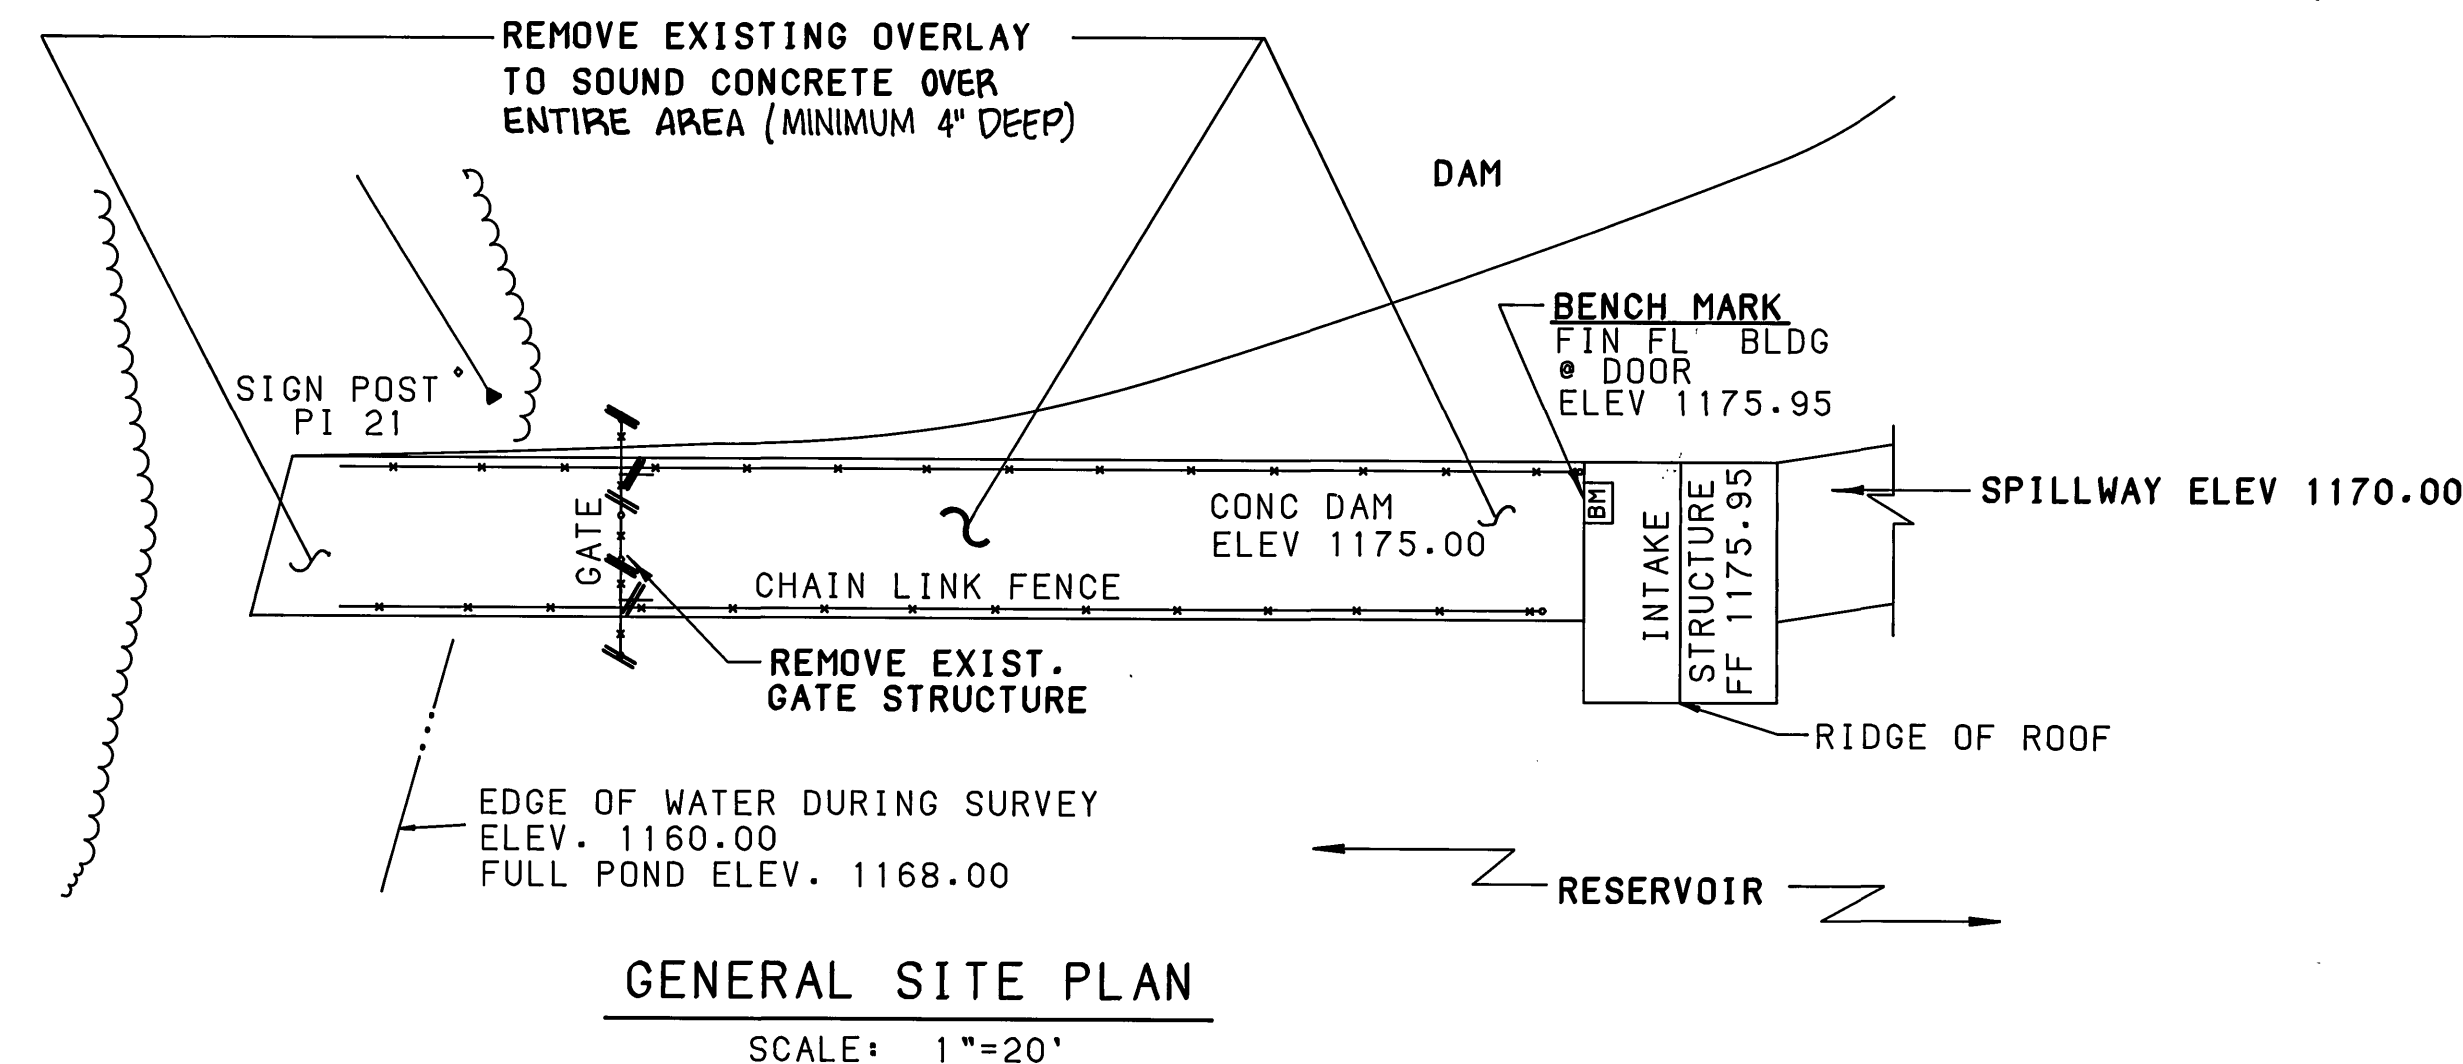


LADDER & PLATFORM DEMOLITION SCHEDULE

CHAMBER	LADDER	EXIST LENGTH	PLATFORM	EXIST ELEV
1	L3	17'-6"	P3	1156.00
	L6	20'-0"	P6	1138.33
	L9	25'-0"	BOTTOM OF CHAMBER	1116.00
2	L2	17'-6"	P2	1156.00
	L5	20'-0"	P5	1138.33
	L8	25'-0"	BOTTOM OF CHAMBER	1116.50
4	L1	21'-3"	P1	1156.00
	L4	25'-0"	P4	1138.33
	L7	25'-0"	BOTTOM OF CHAMBER	1109.00


ALL PLATFORMS ARE 2'-10" x 2'-6" AND SUPPORTED ON 2 4" I BEAMS. THE CONTRACTOR IS TO REMOVE ALL EXISTING LADDERS, PLATFORMS AND SUPPORTS.

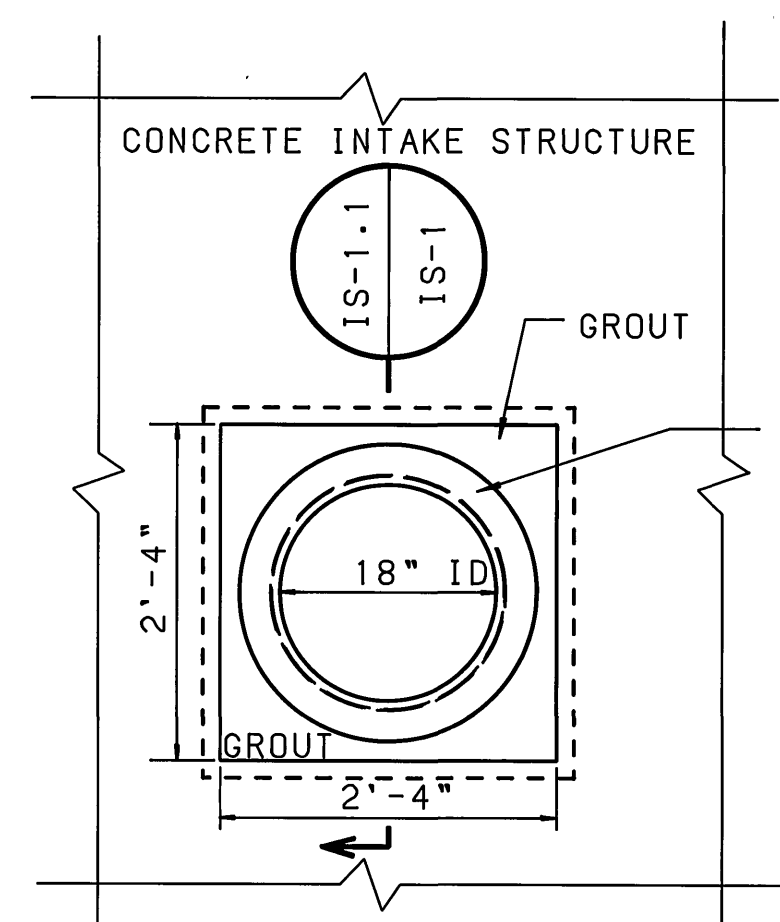

INTAKE ORIFICE DEMOLITION
SCALE: 3/4"=1'-0"

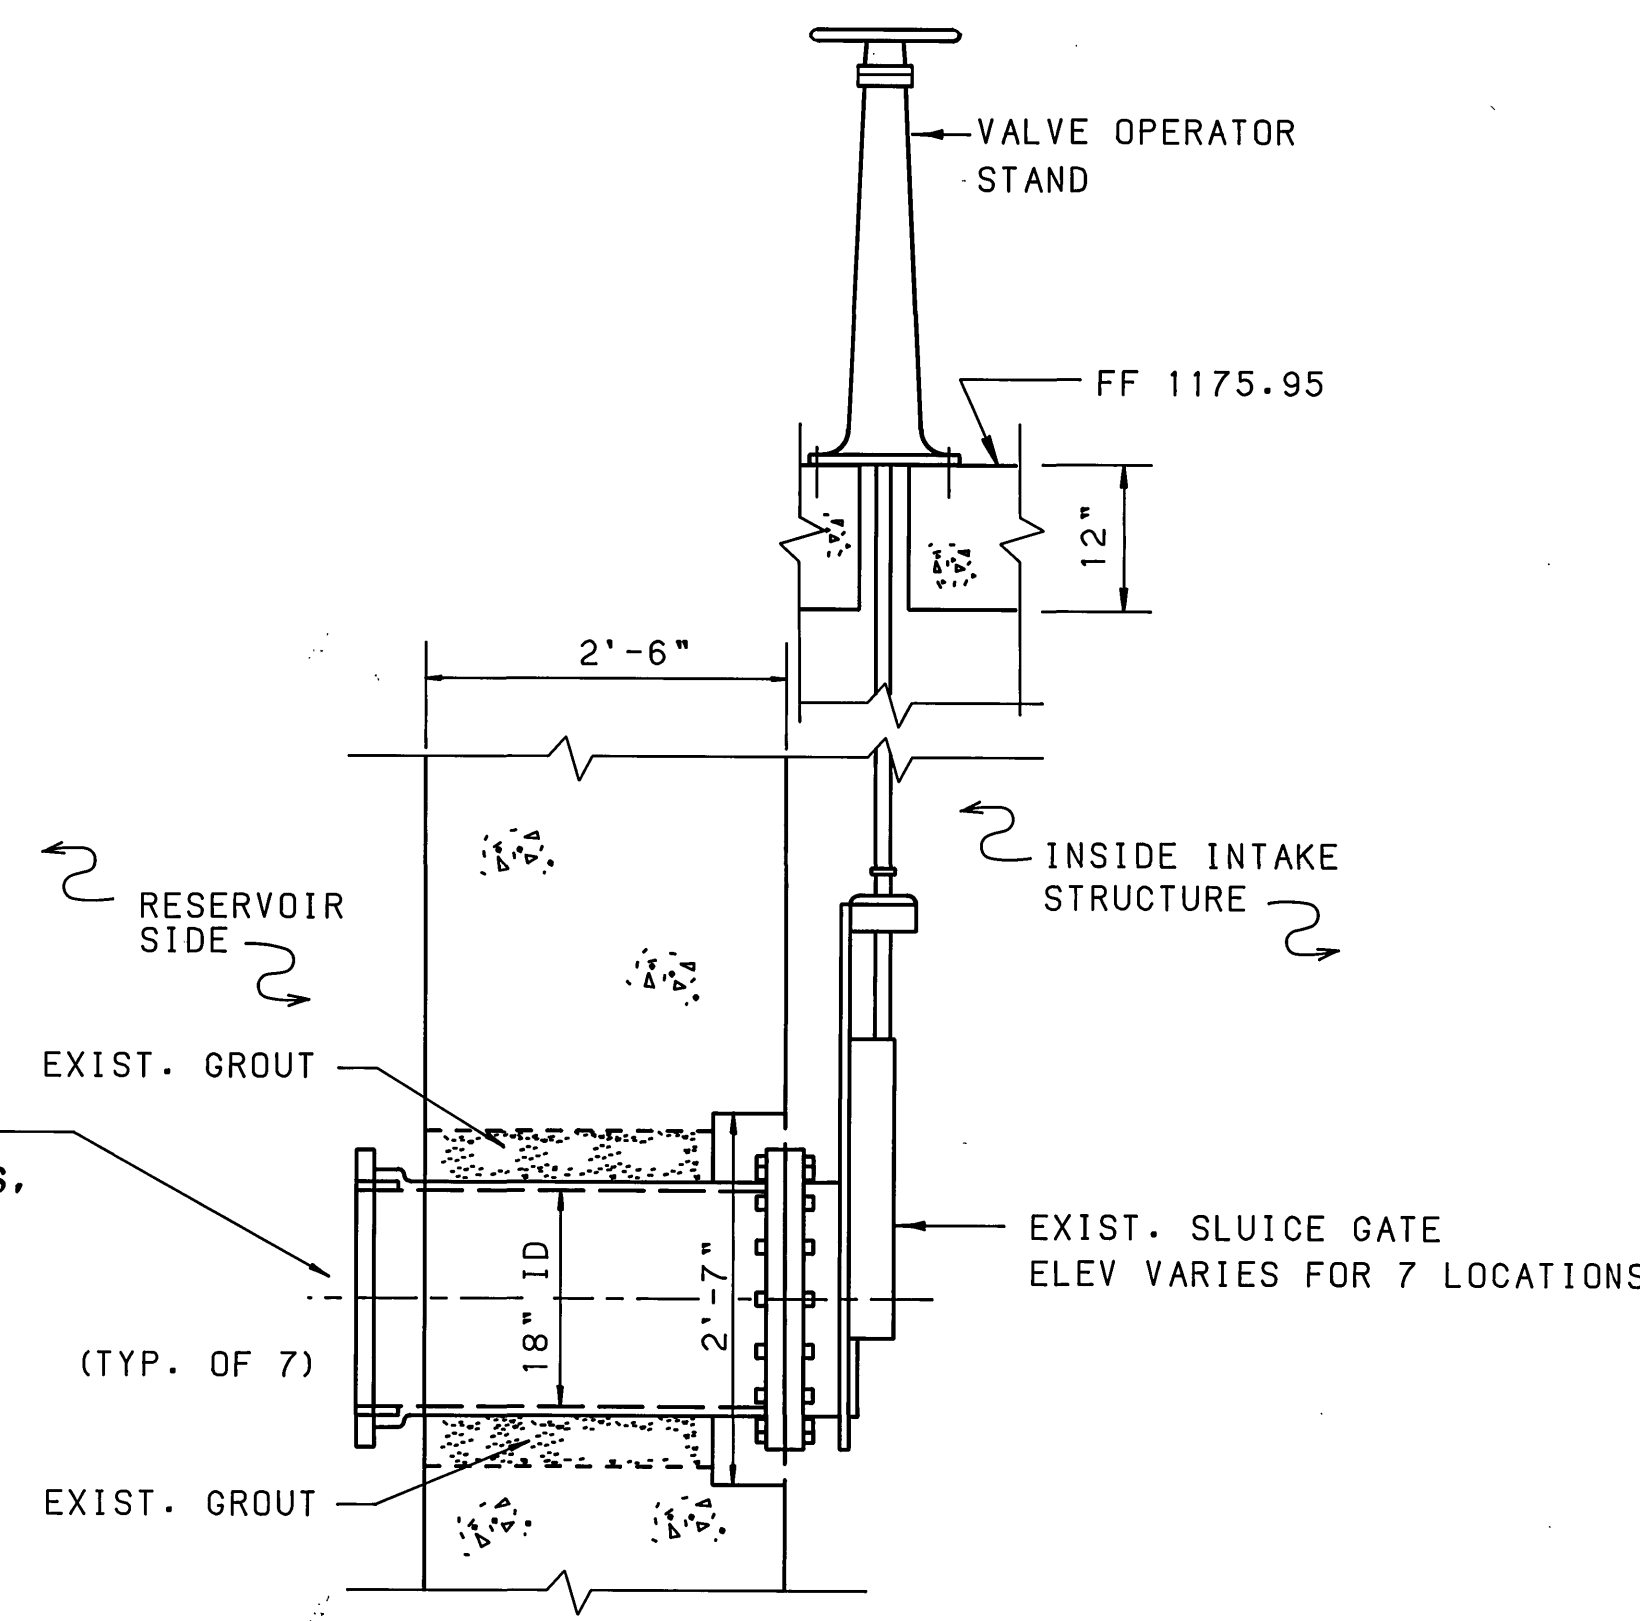

SECTION - INTAKE ORIFICE DEMOLITION IS1.1
SCALE: 3/4"=1'-0"

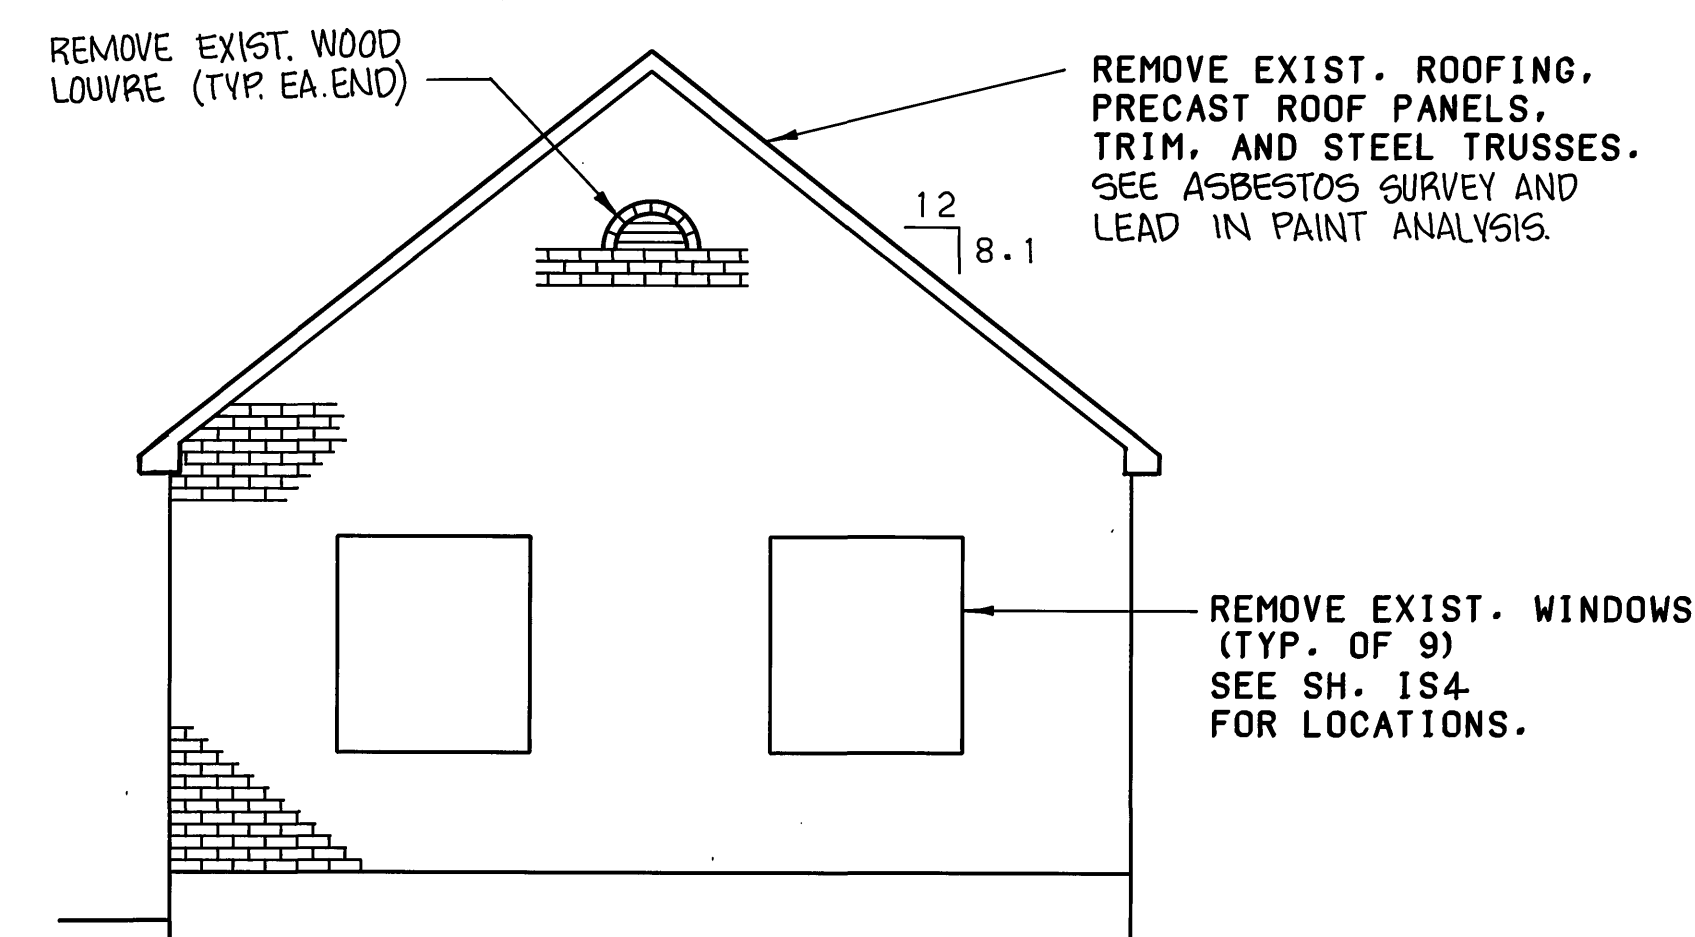

INTAKE STRUCTURE BUILDING - DEMOLITION
SCALE: 1/4"=1'-0"

RECORD DRAWING

MATTERN & CRAIG CONSULTING ENGINEERS • SURVEYORS ROANOKE VIRGINIA	DESIGNED:			REV	DATE	DESCRIPTION	BY	APP.	CARVINS COVE FILTER PLANT IMPROVEMENTS - PHASE I ROANOKE, VIRGINIA	DATE
	DRAWN:			1	8/92	MISC.	TAM	RWB		COMM. NO.
ALVORD, BURDICK & HOWSON ENGINEERS CHICAGO	CHECKED:								INTAKE STRUCTURE DEMOLITION	SHEET
	SWH									1138
									IS2	