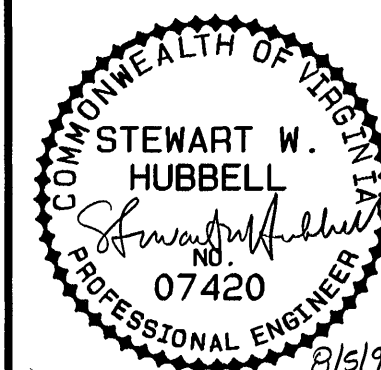



<div>MATTERN &amp; CRAIG CONSULTING ENGINEERS • SURVEYORS ROANOKE VIRGINIA</div>		DESIGNED: RWB	<div></div>	REV	DATE	DESCRIPTION	BY	APP.	CARVINS COVE FILTER PLANT IMPROVEMENTS - PHASE I ROANOKE, VIRGINIA		DATE MARCH 1992 COMM. NO. 1138
<div>ALVORD, BURDICK &amp; HOWSON ENGINEERS CHICAGO</div>		DRAWN: DSG		1	8/92	MISCELLANEOUS	DSG	RWB	<div>INTAKE STRUCTURE PLAN, ELEVATIONS &amp; SECTIONS</div>	SHEET IS3A	
		CHECKED: SWH		2	5/93	C.O. #3	CLD	RWB			