


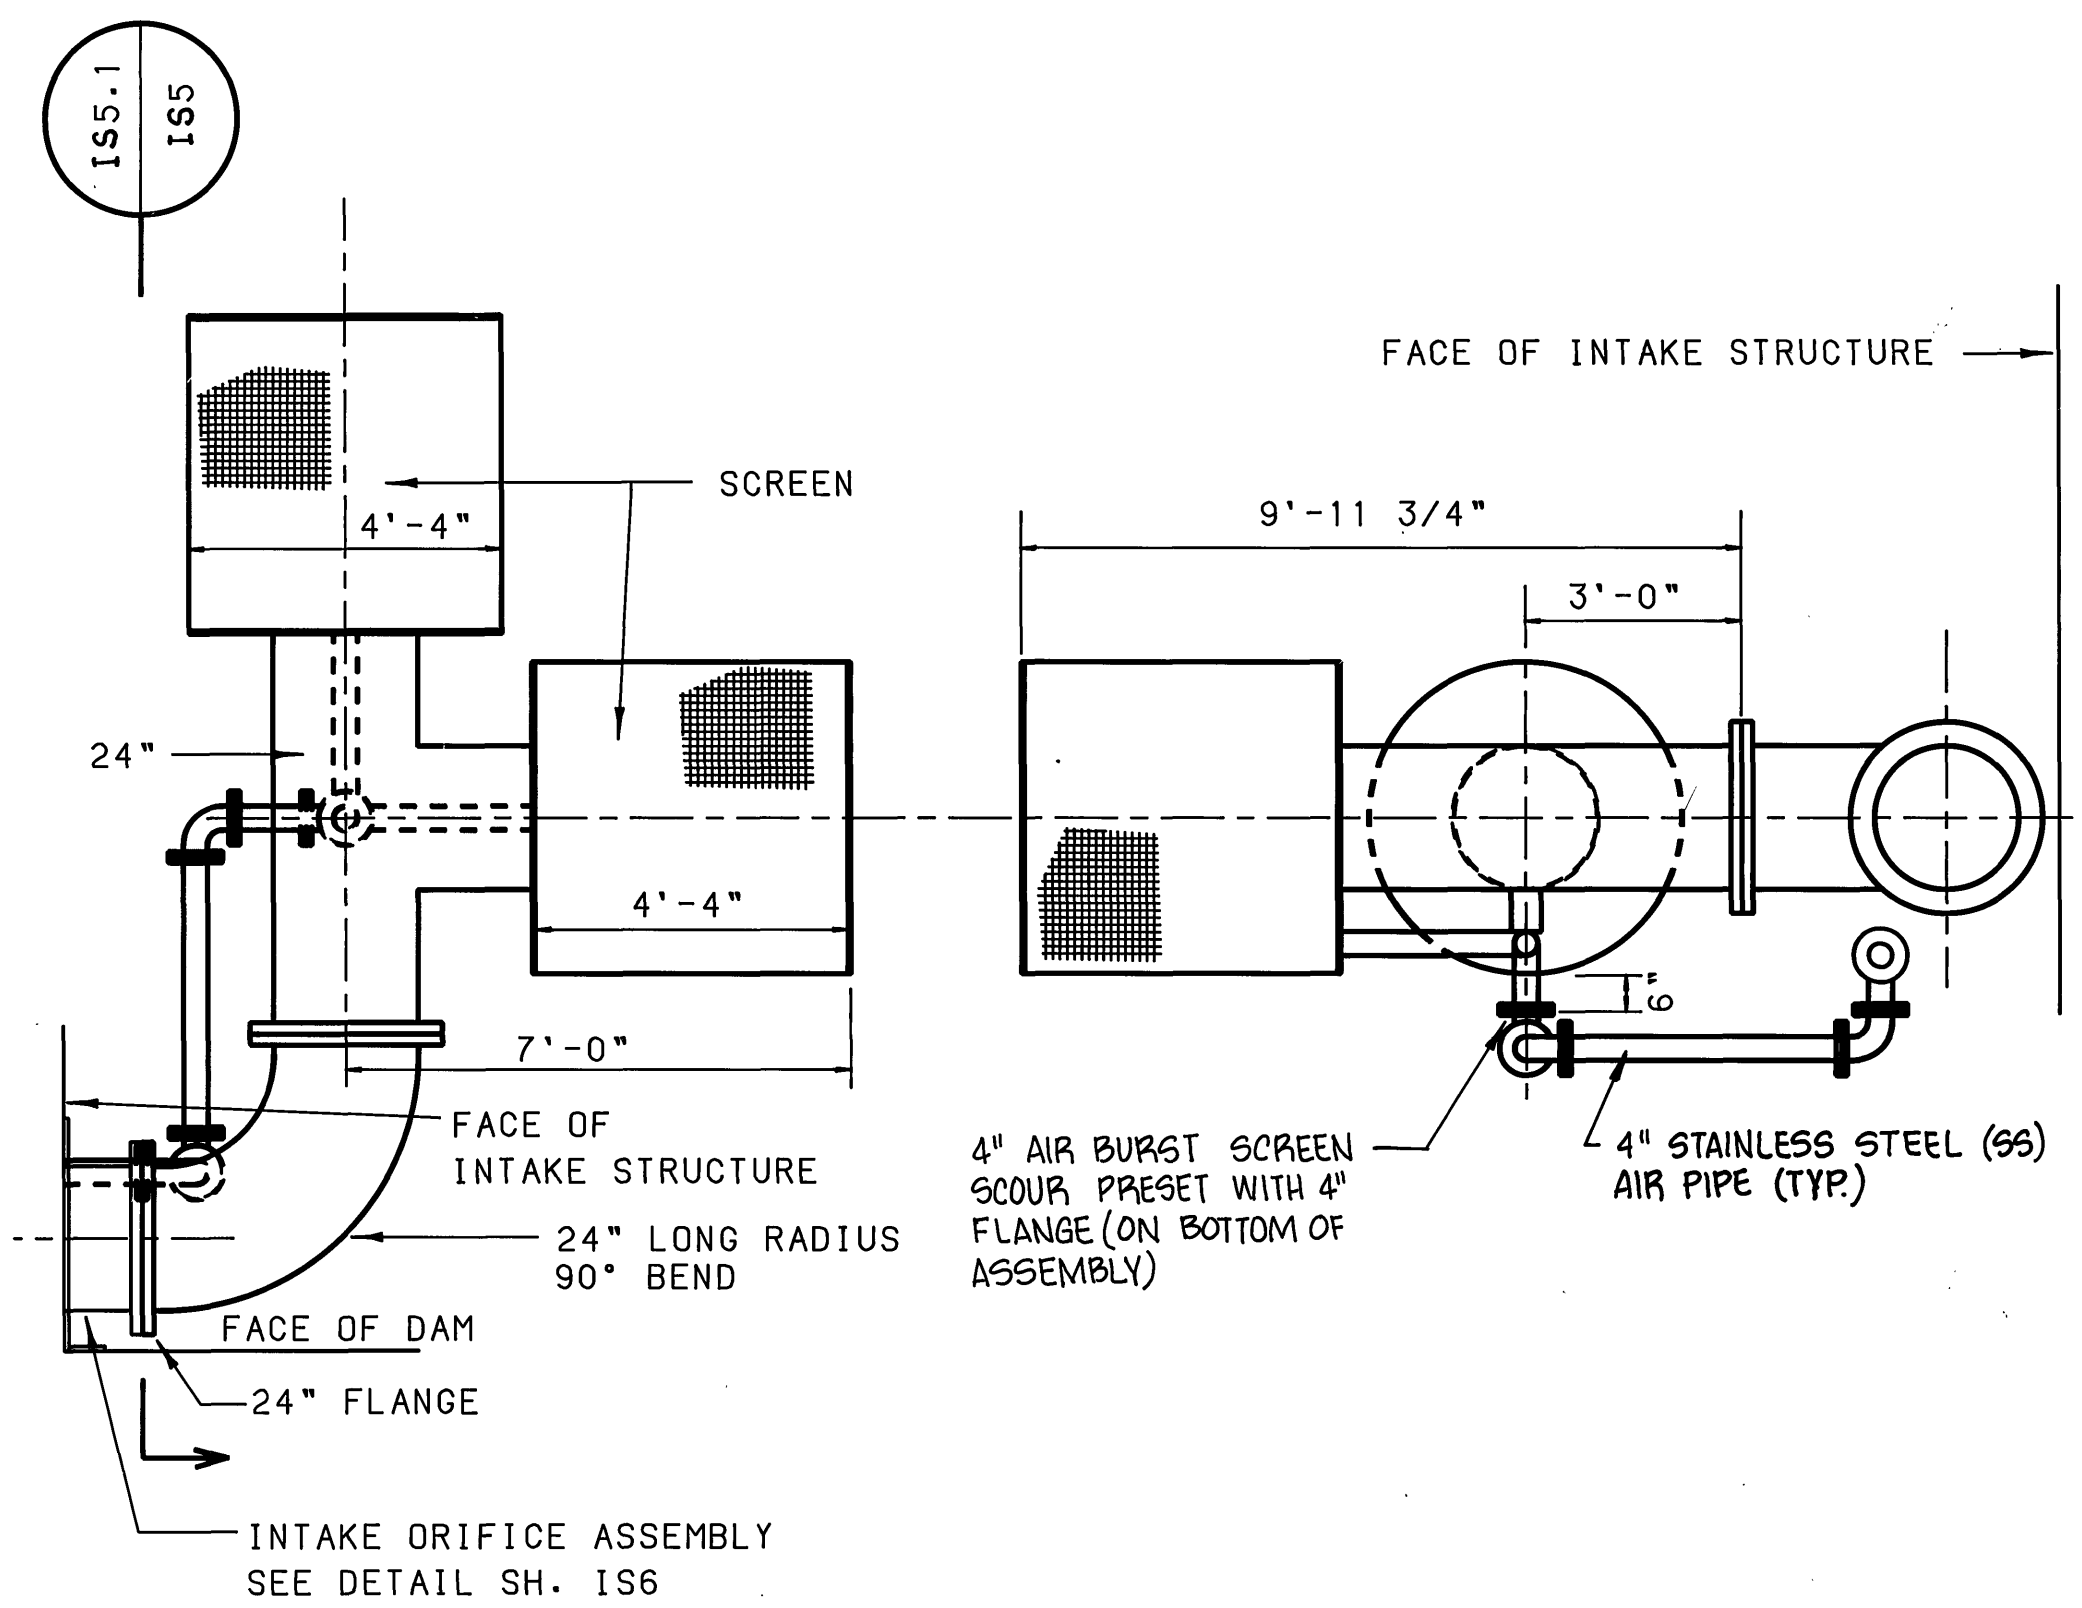


PLAN-ELEV 1160 SCREEN DETAIL
SCALE: 3/8"=1'-0"

SECTION
SCALE: 3/8"=1'-0"

IS5.1
IS5

LOCATED IN CHAMBER #1

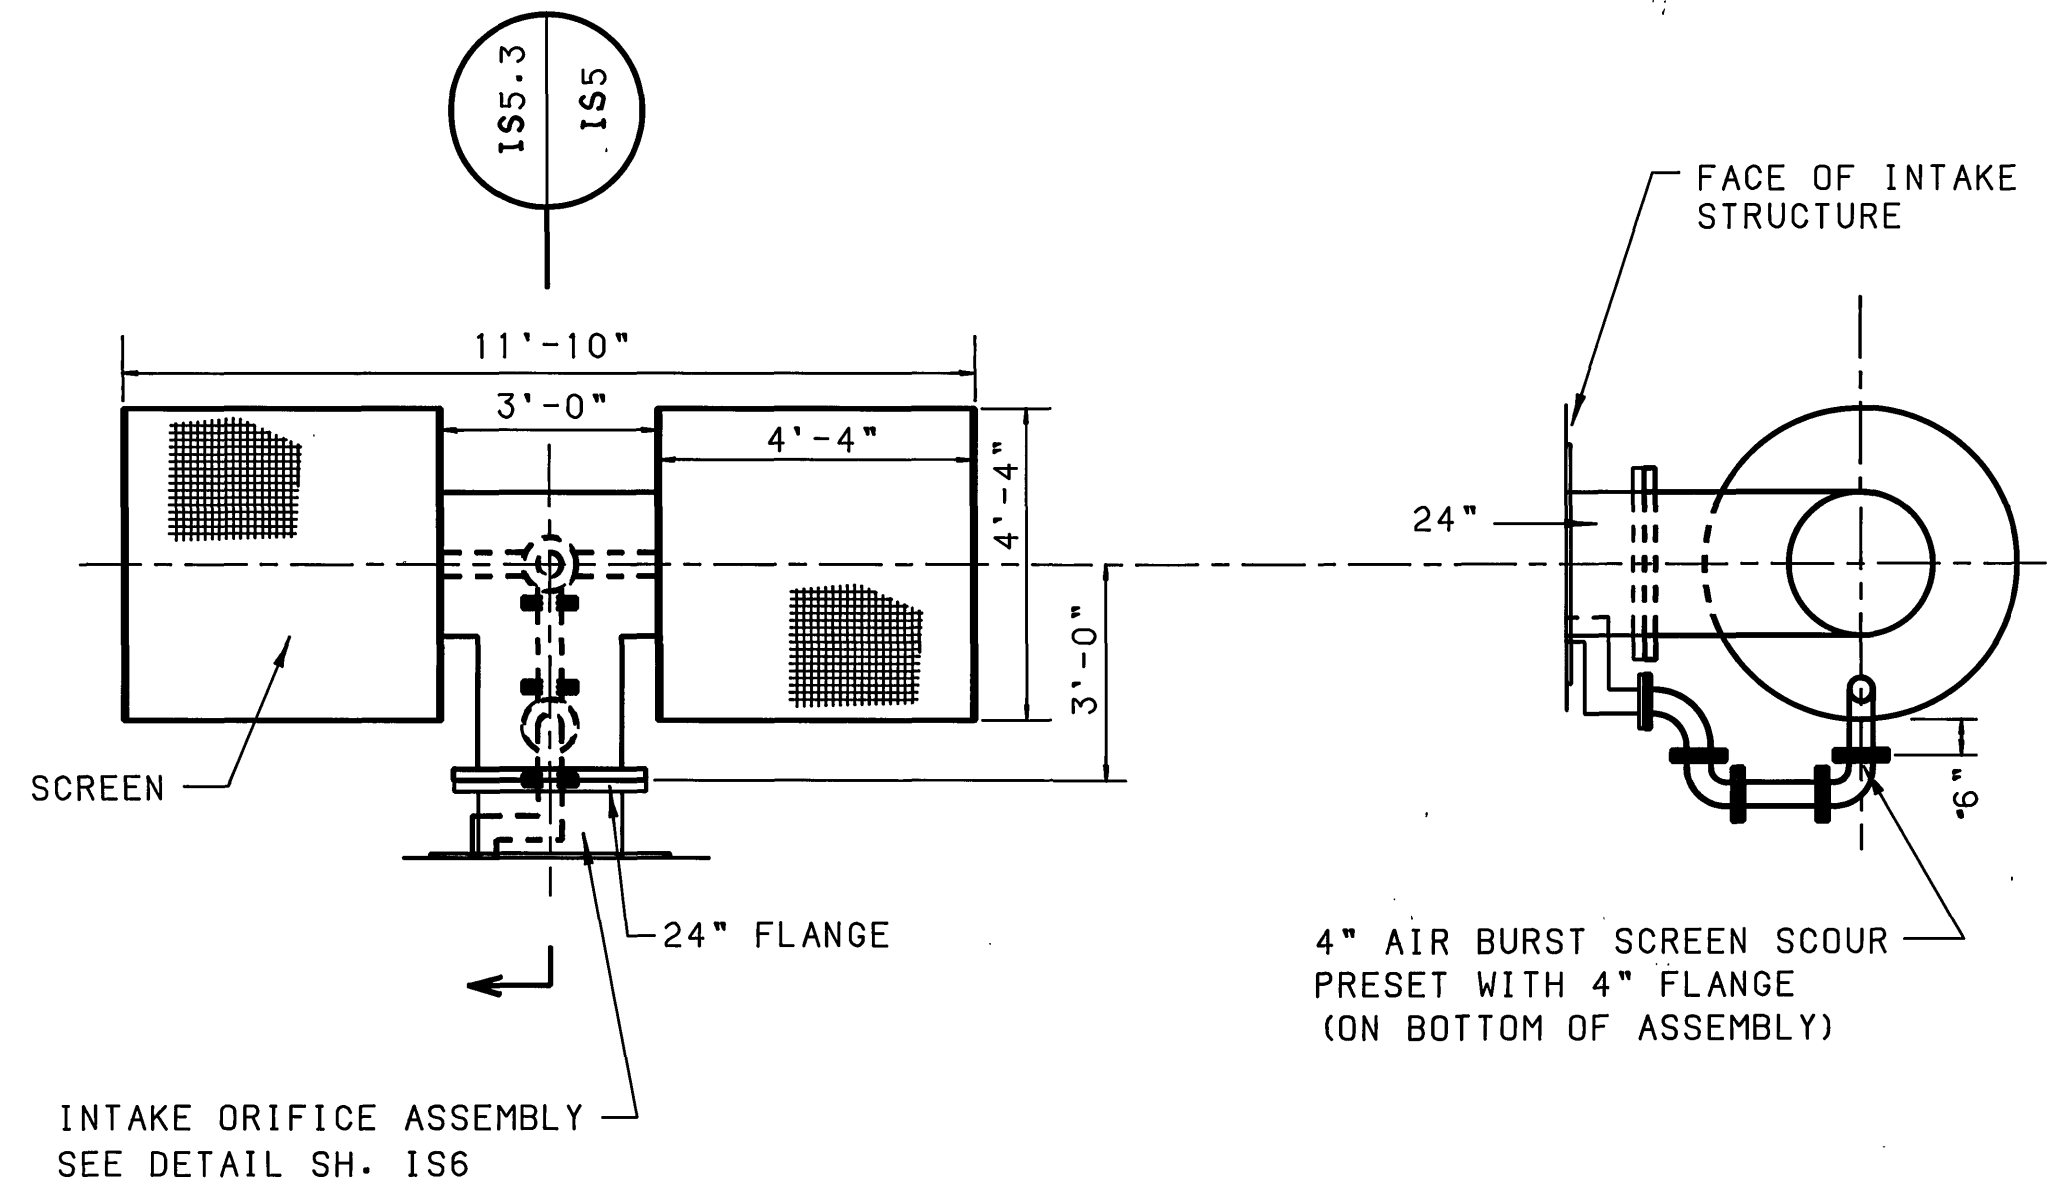


PLAN-ELEV 1140 SCREEN DETAIL
SCALE: 3/8"=1'-0"

SECTION
SCALE: 3/8"=1'-0"

IS5.3
IS5

LOCATED IN CHAMBER #1

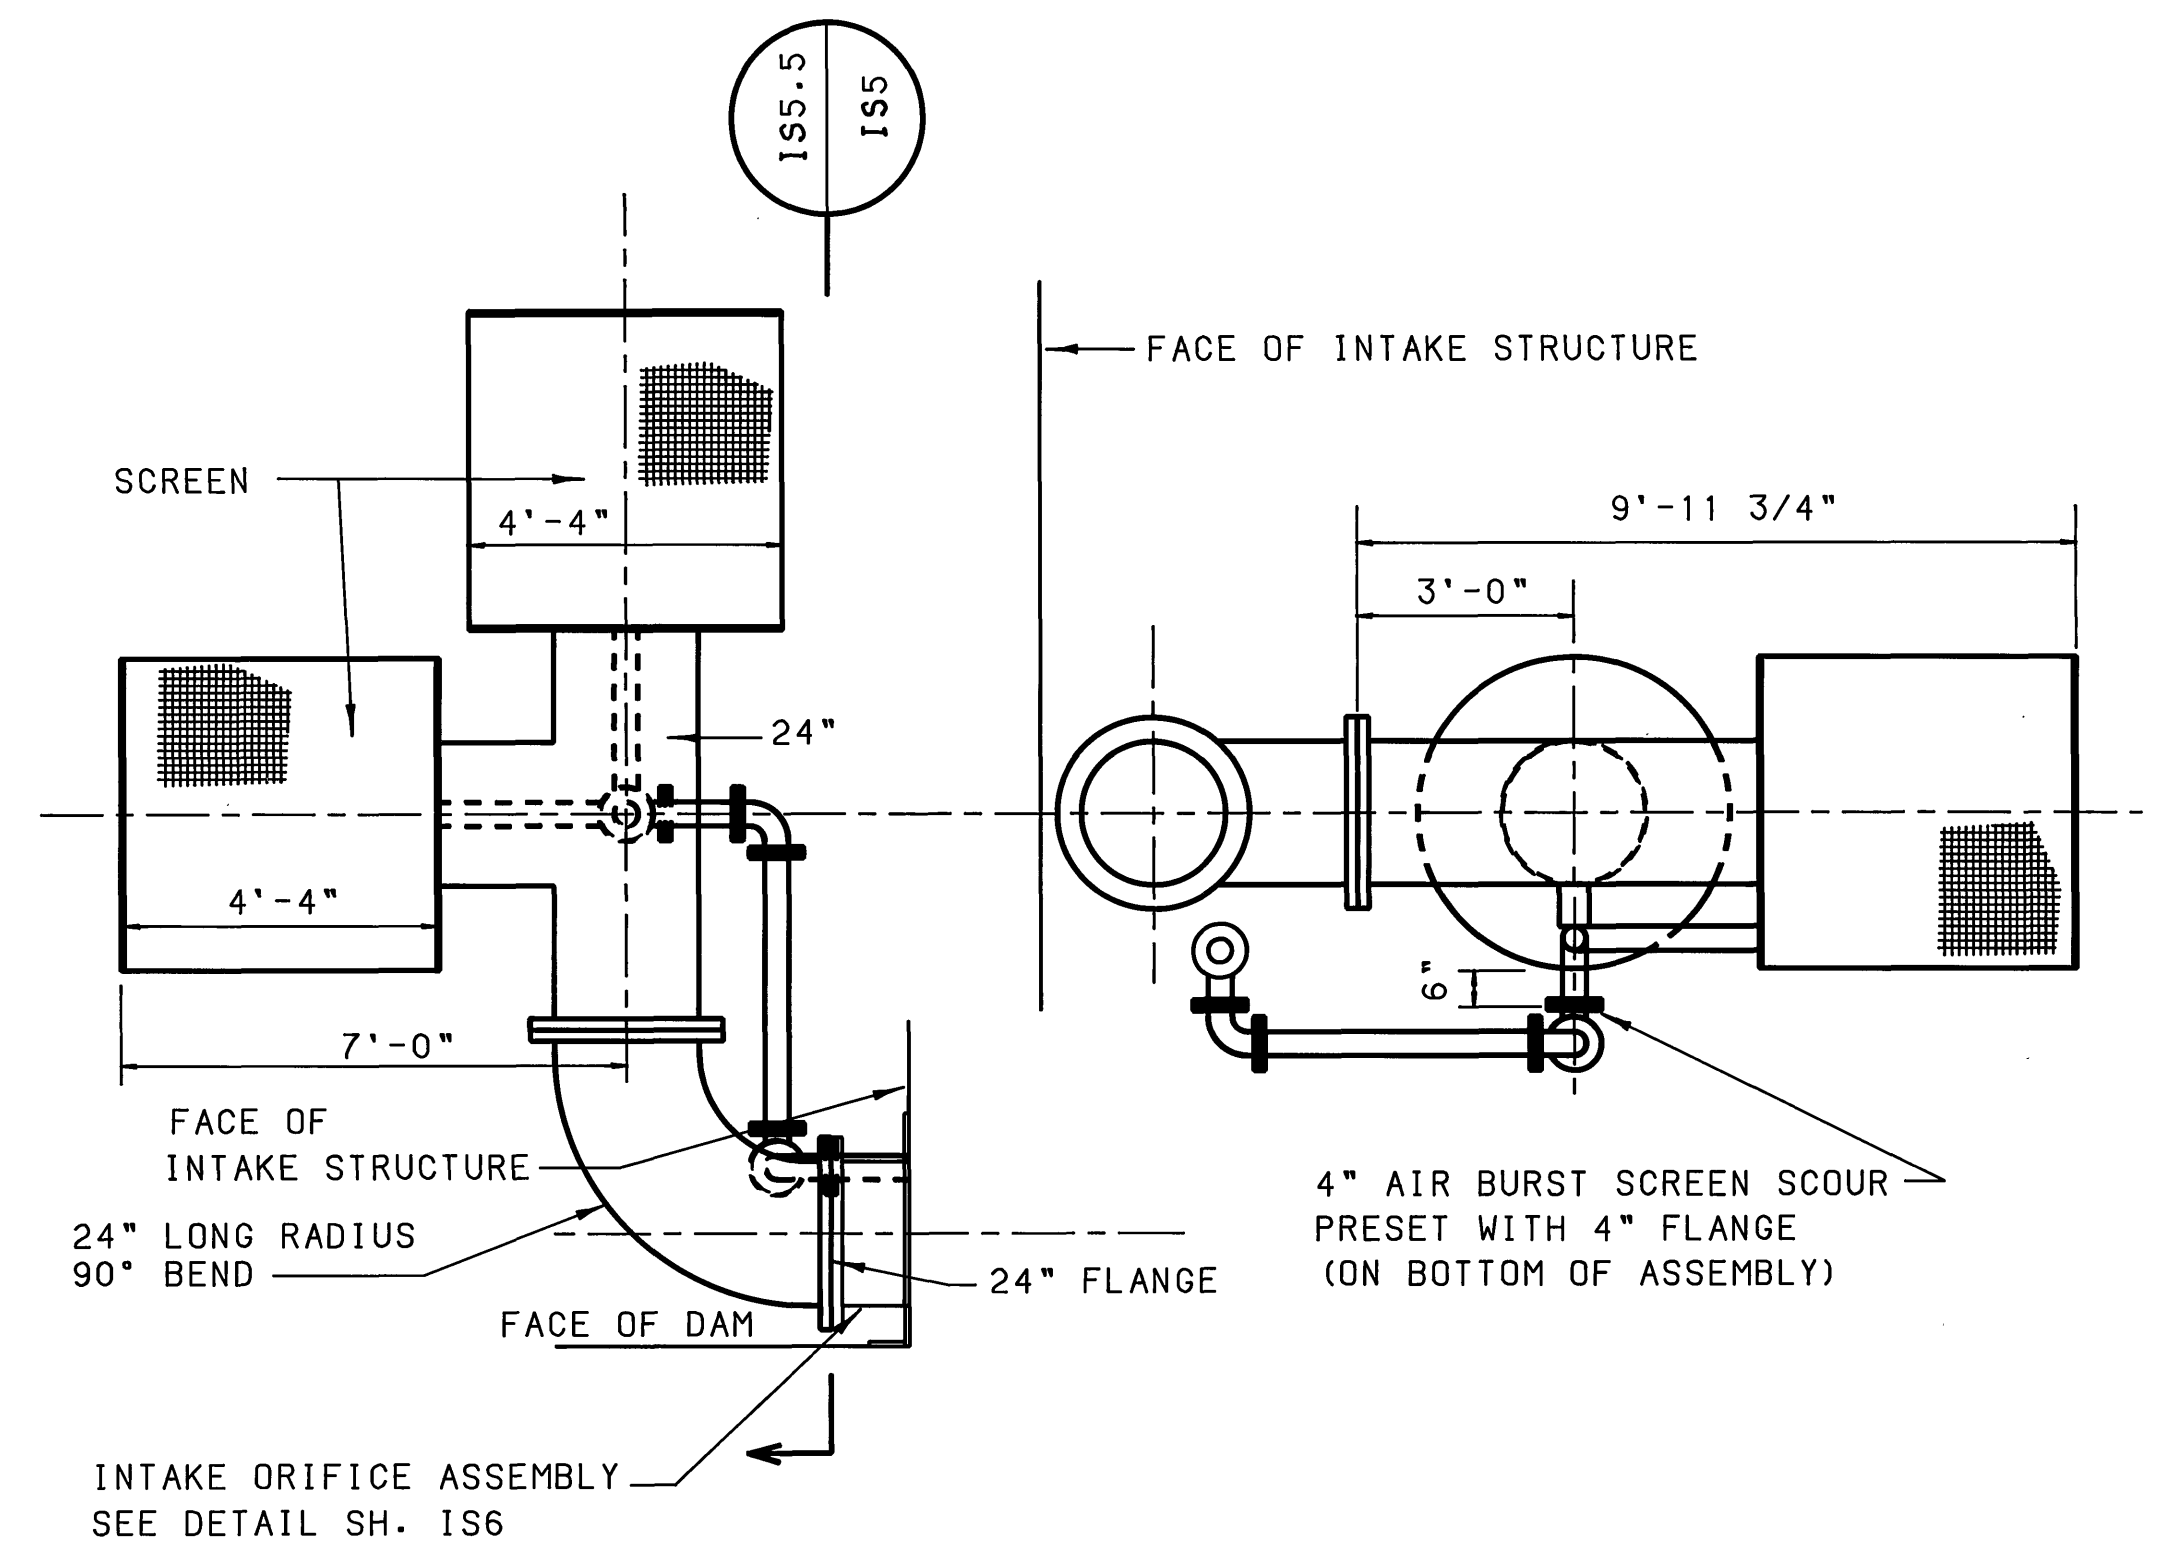


PLAN-ELEV 1130 SCREEN DETAIL
SCALE: 3/8"=1'-0"

SECTION
SCALE: 3/8"=1'-0"

IS5.5
IS5

LOCATED IN CHAMBER #2

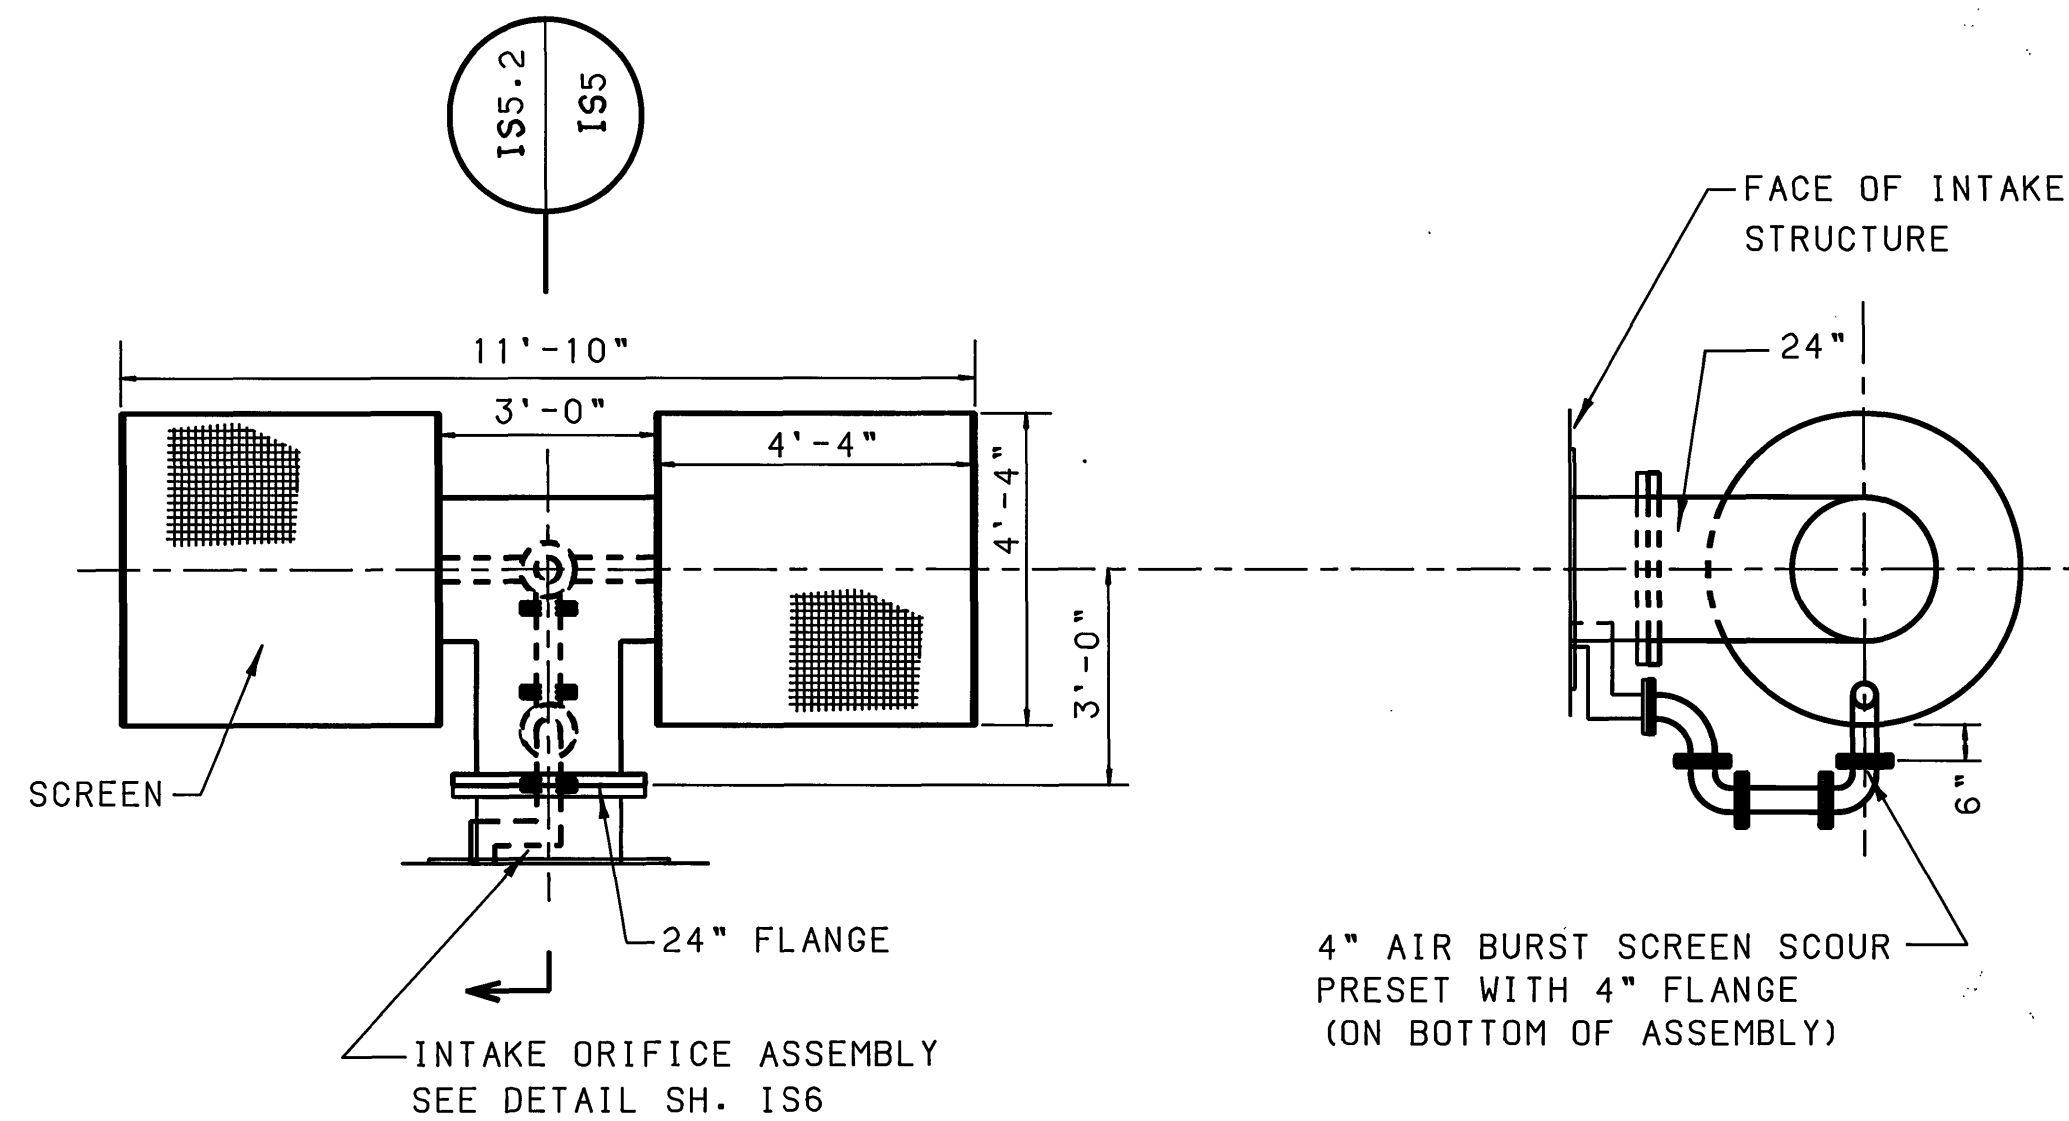


PLAN-ELEV 1150 SCREEN DETAIL
SCALE: 3/8"=1'-0"

SECTION
SCALE: 3/8"=1'-0"

IS5.2
IS5

LOCATED IN CHAMBER #1

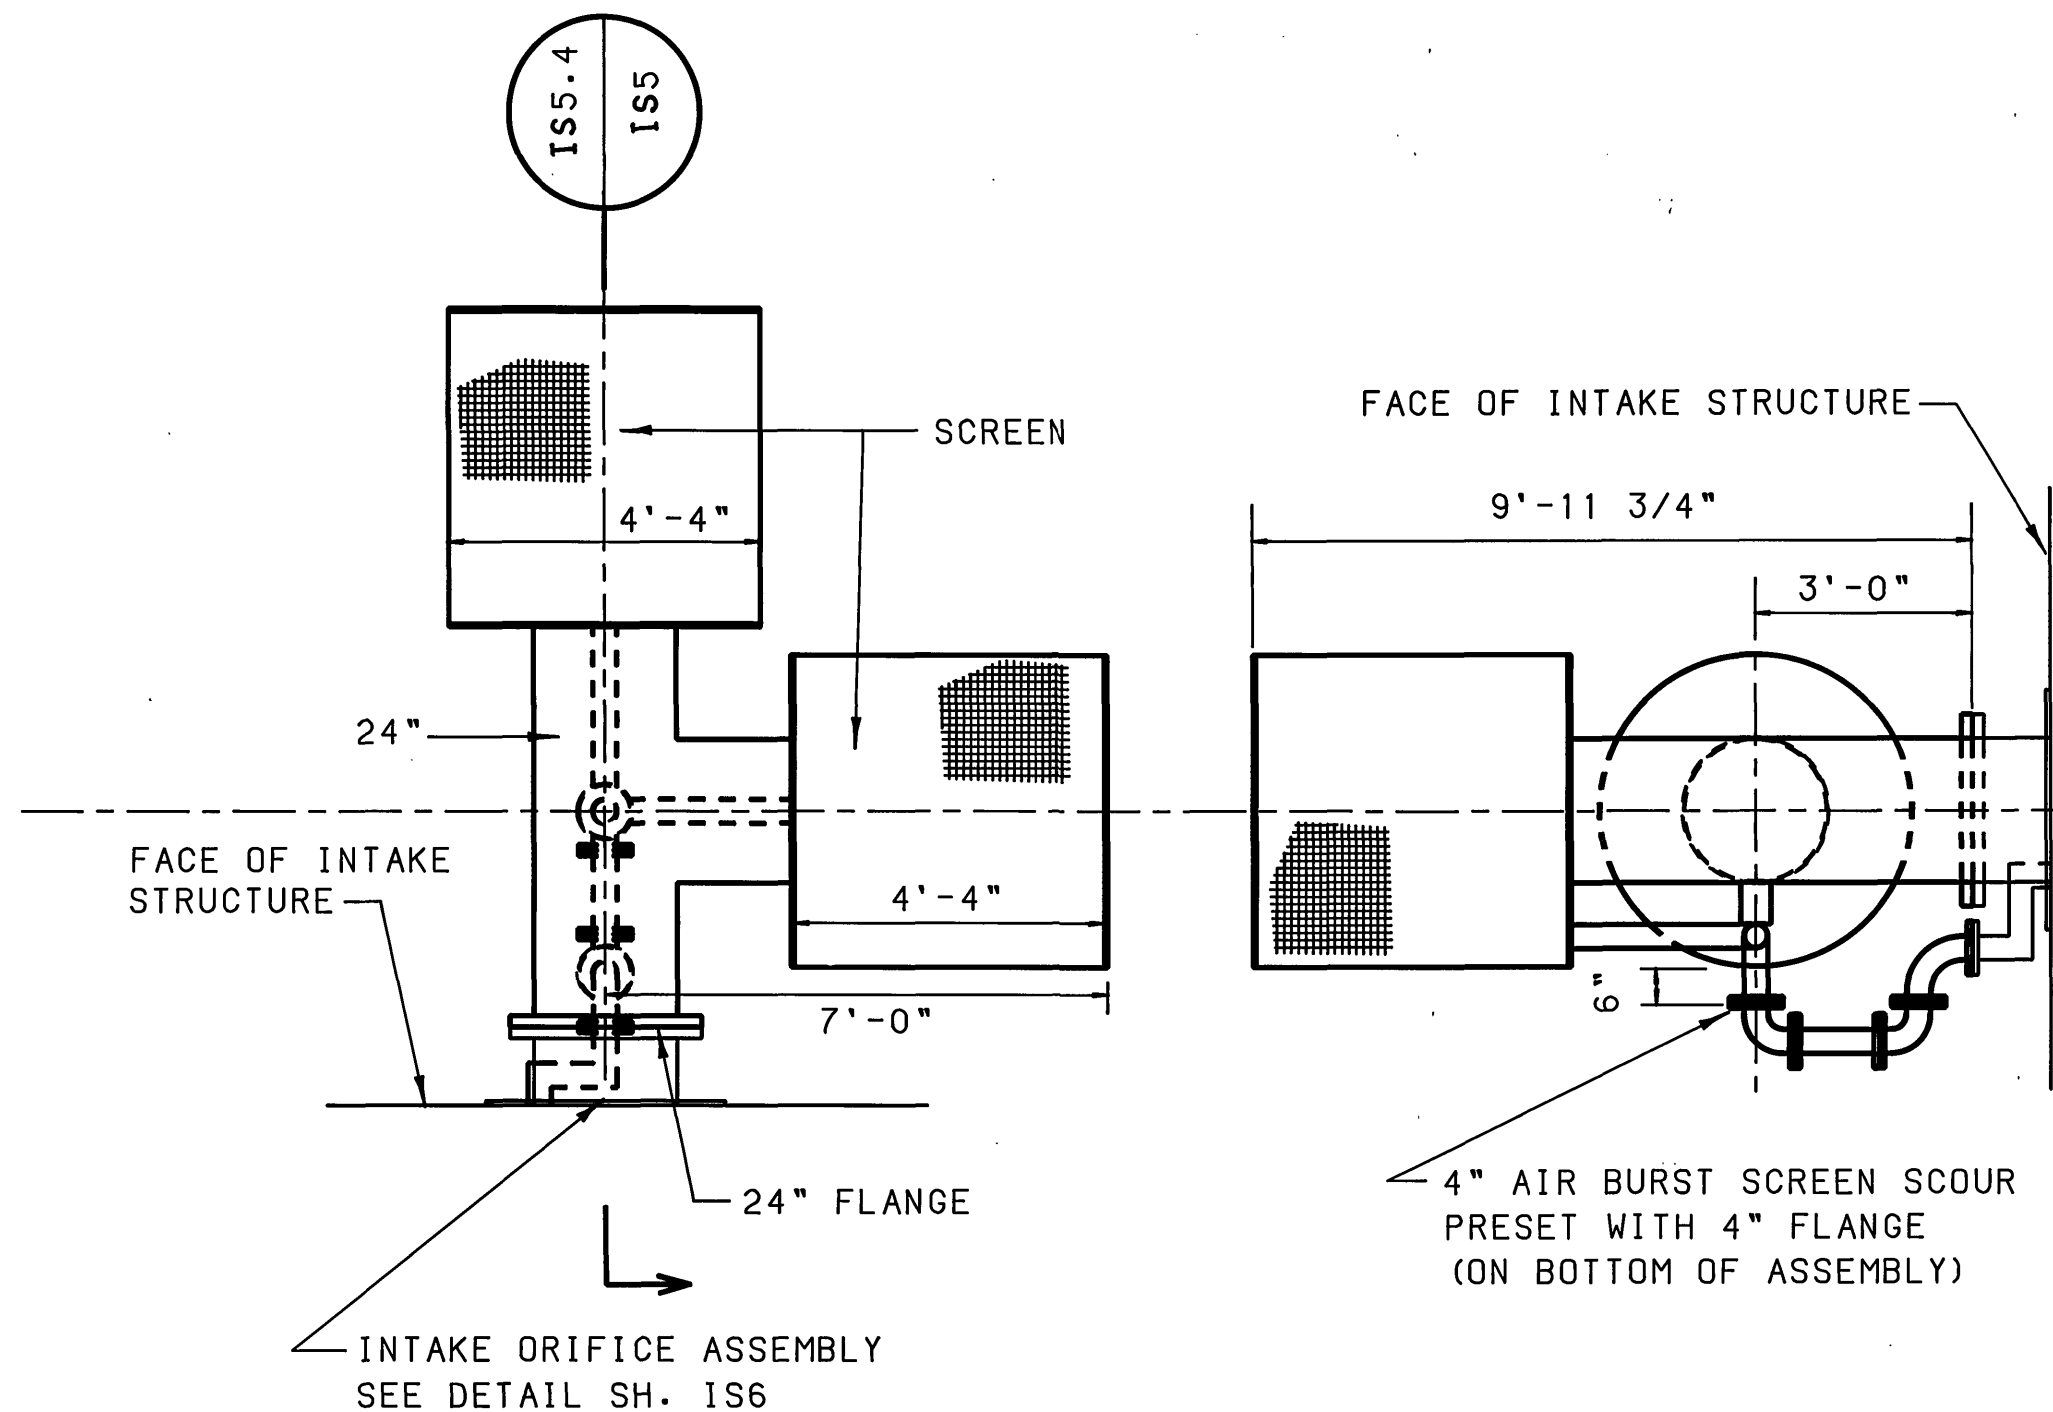


PLAN-ELEV 1117 SCREEN DETAIL
SCALE: 3/8"=1'-0"

SECTION
SCALE: 3/8"=1'-0"

IS5.4
IS5

LOCATED IN CHAMBER #1

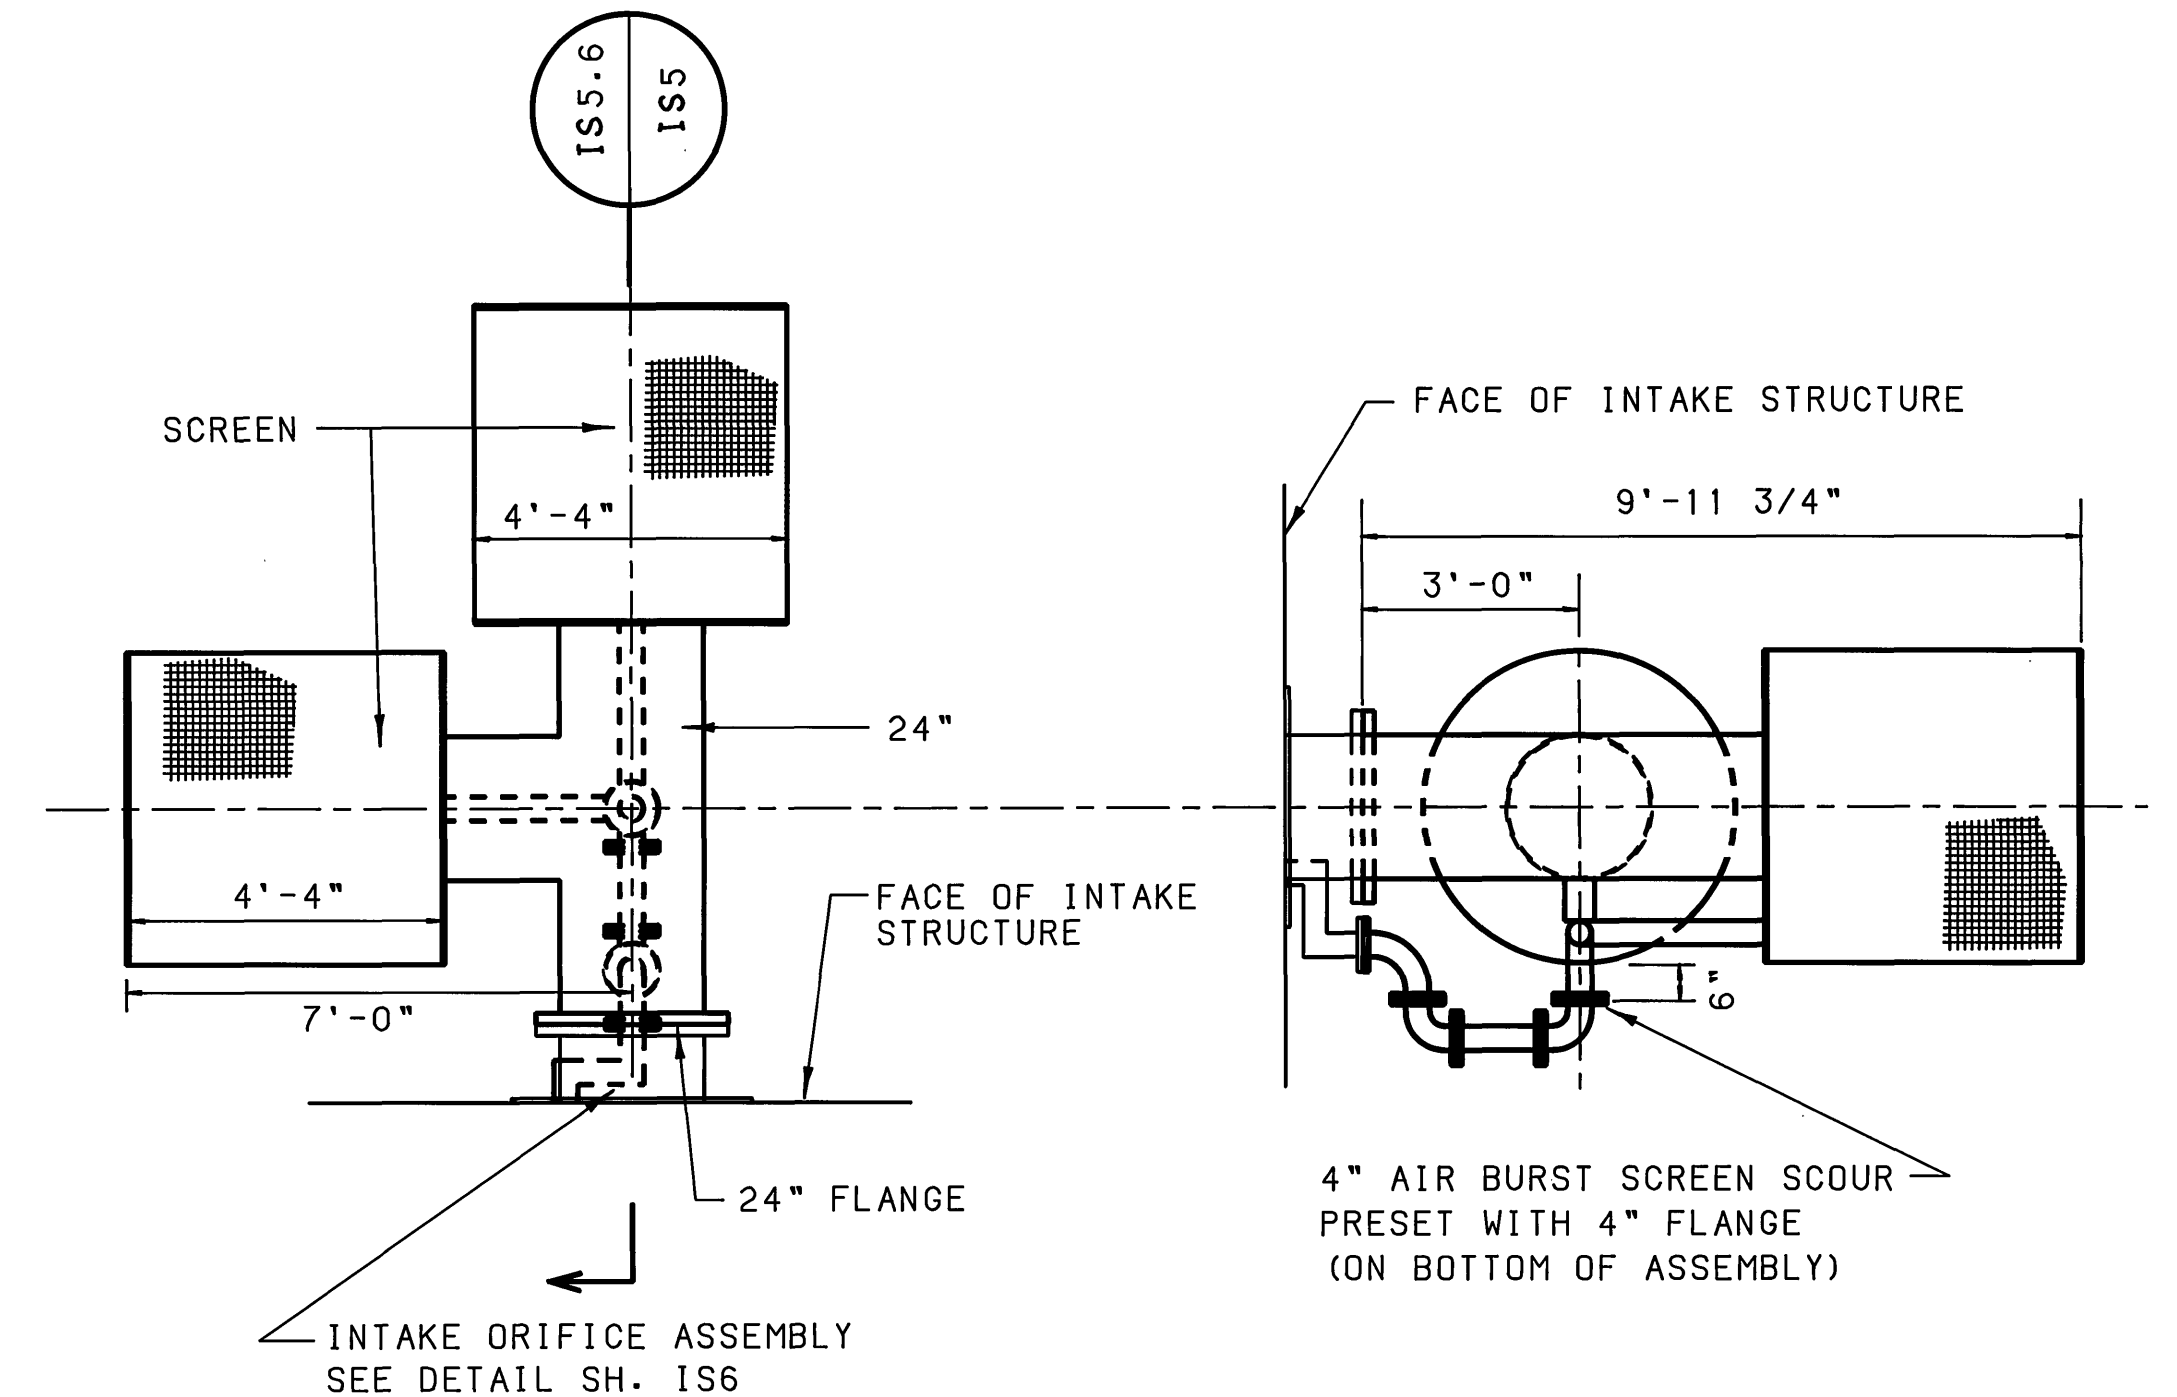

PLAN-ELEV 1120 SCREEN DETAIL
SCALE: 3/8"=1'-0"

SECTION
SCALE: 3/8"=1'-0"

IS5.6
IS5

LOCATED IN CHAMBER #2

RECORD DRAWING

MATTERN & CRAIG
CONSULTING ENGINEERS • SURVEYORS
ROANOKE VIRGINIA

ALVORD, BURDICK & HOWSON
ENGINEERS CHICAGO

DESIGNED: RWB
DRAWN: DSG
CHECKED: SWH

COMMONWEALTH OF VIRGINIA
STEWART W. HUBBELL
NO. 07420
PROFESSIONAL ENGINEER
2/3/92

REV	DATE	DESCRIPTION	BY	APP.
1	8/92	MISC.	TAM	RWB

CARVINS COVE FILTER PLANT IMPROVEMENTS - PHASE I
ROANOKE, VIRGINIA

INTAKE STRUCTURE
SCREEN DETAILS

DATE
MARCH 1992
COMM. NO.
1138
SHEET
IS5