
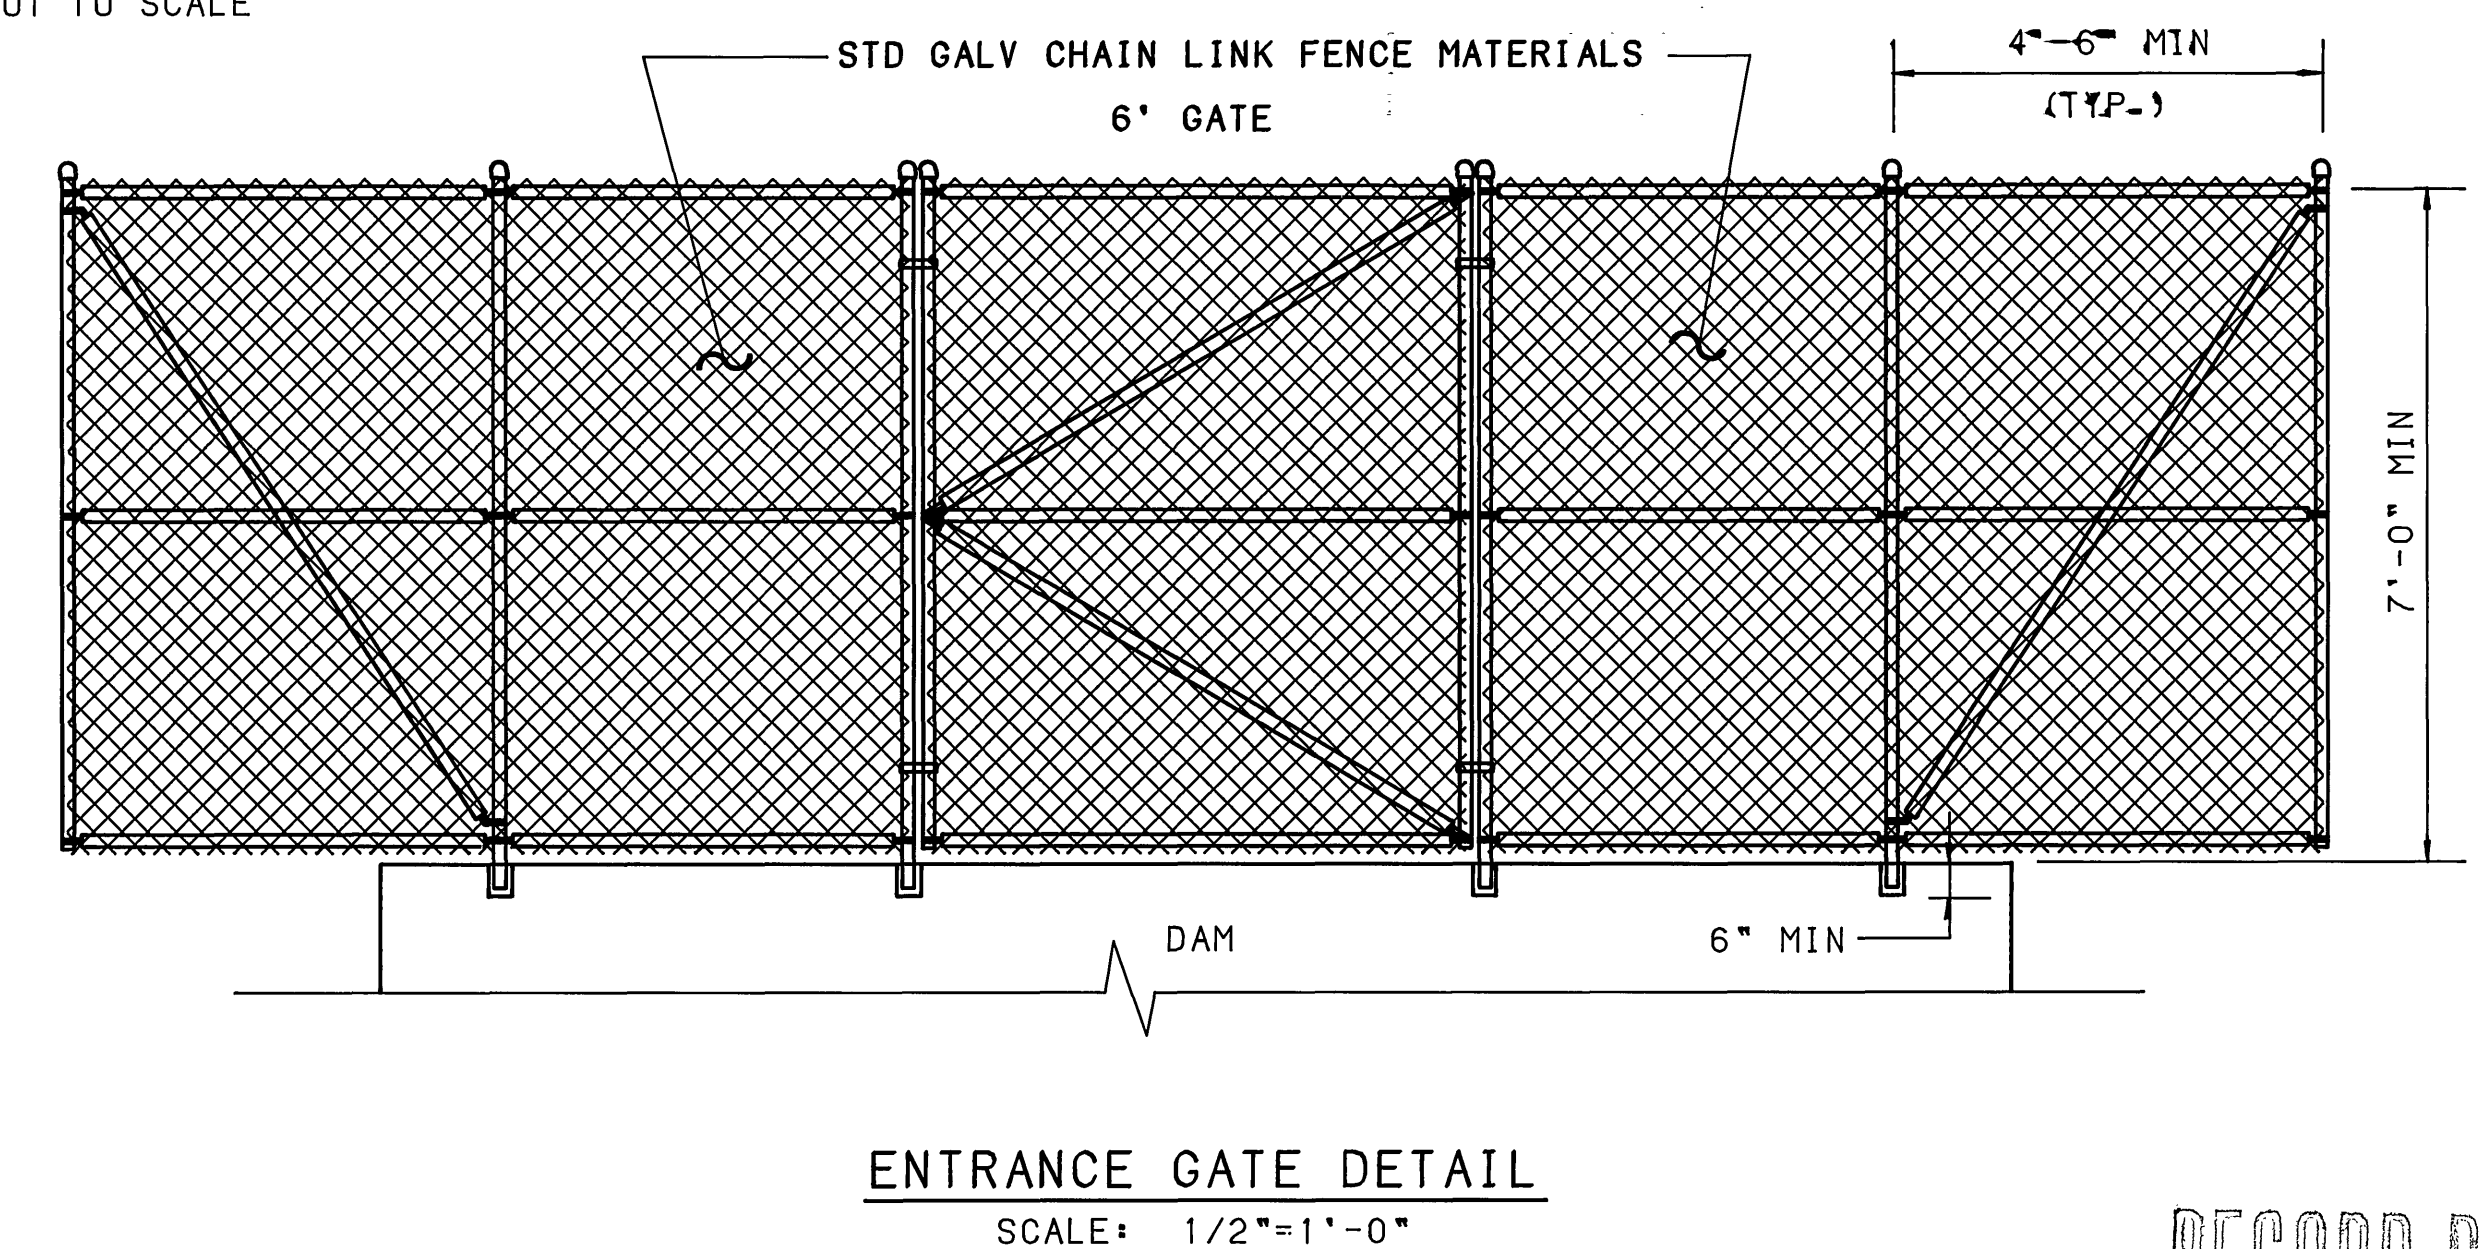
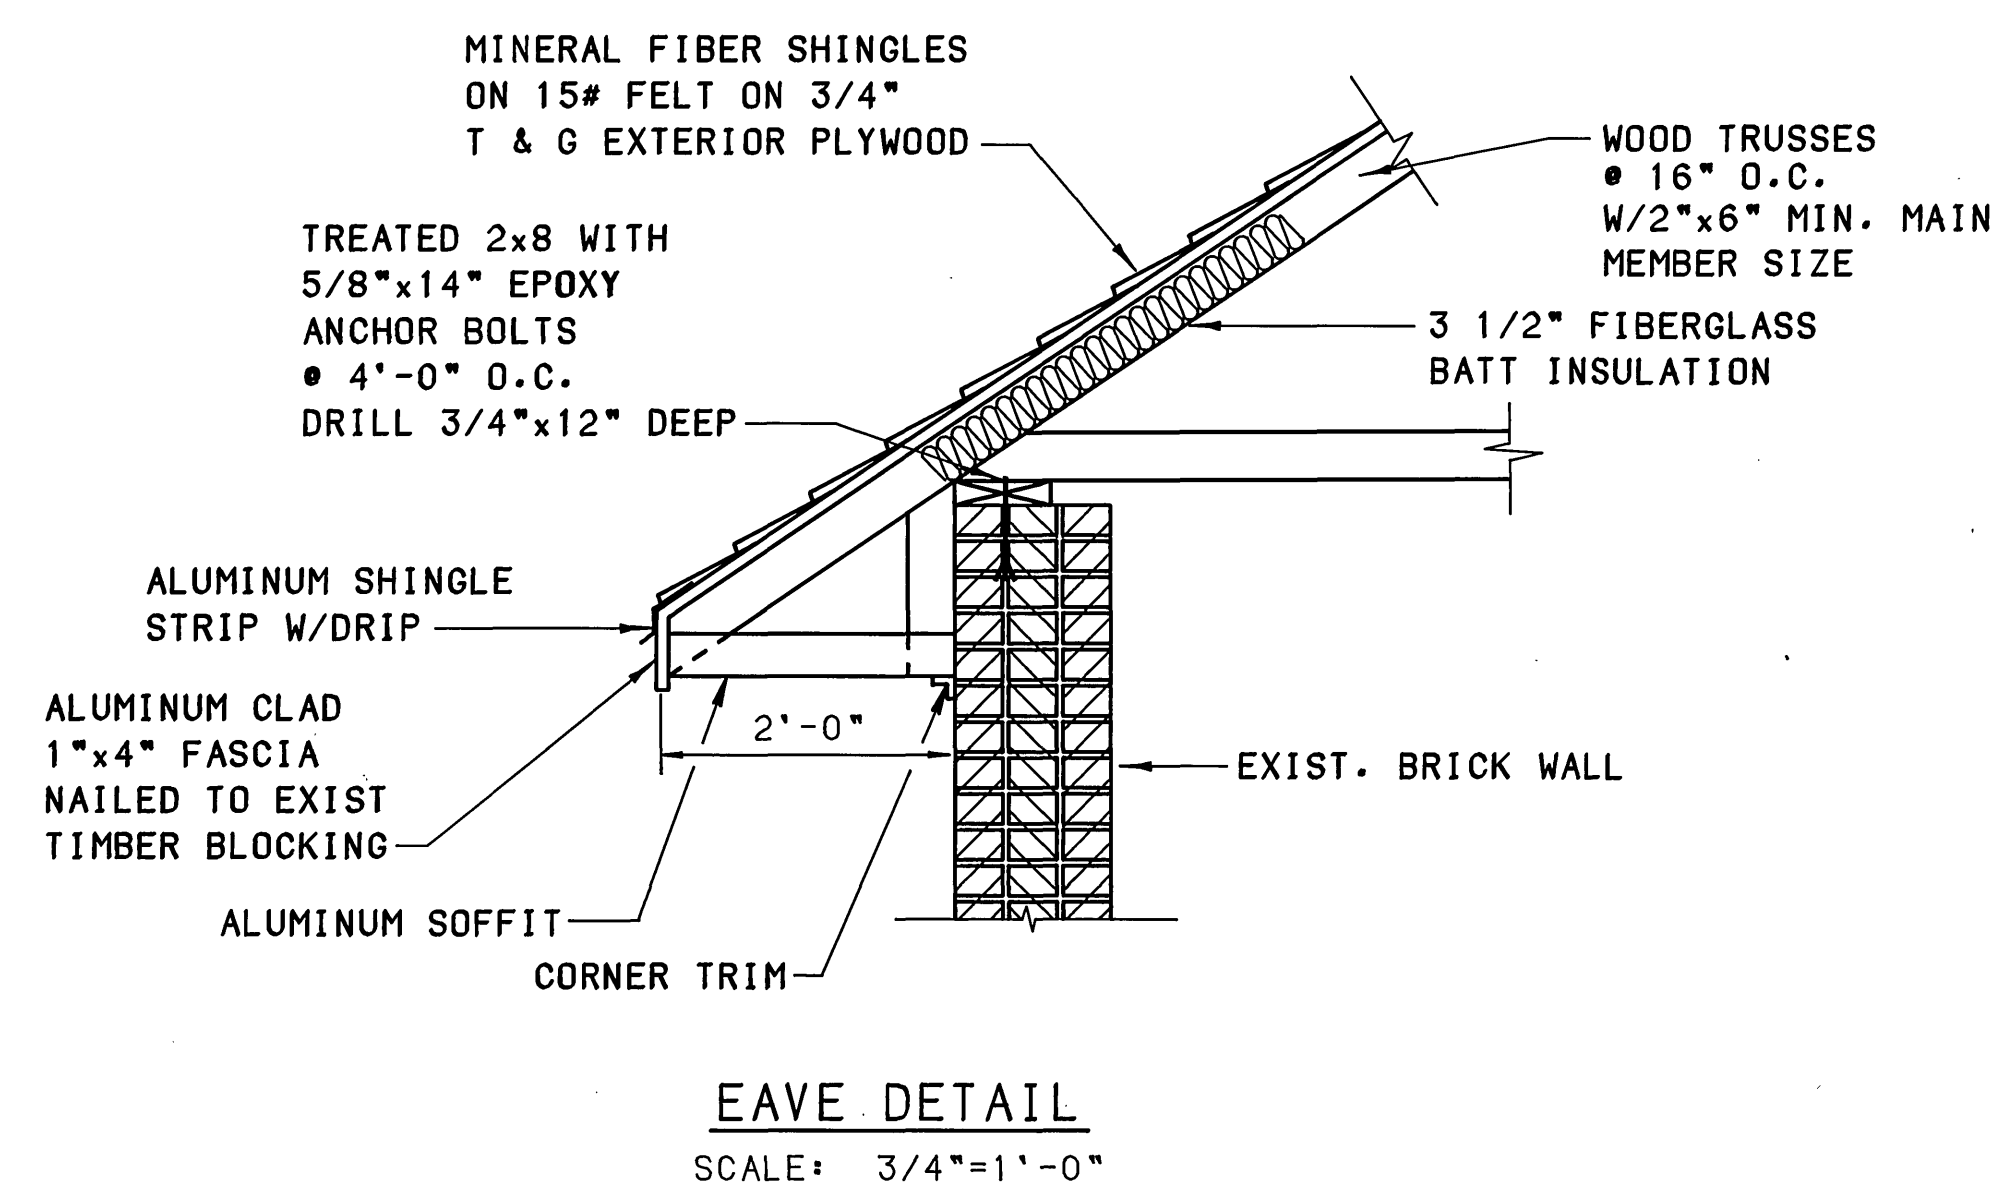
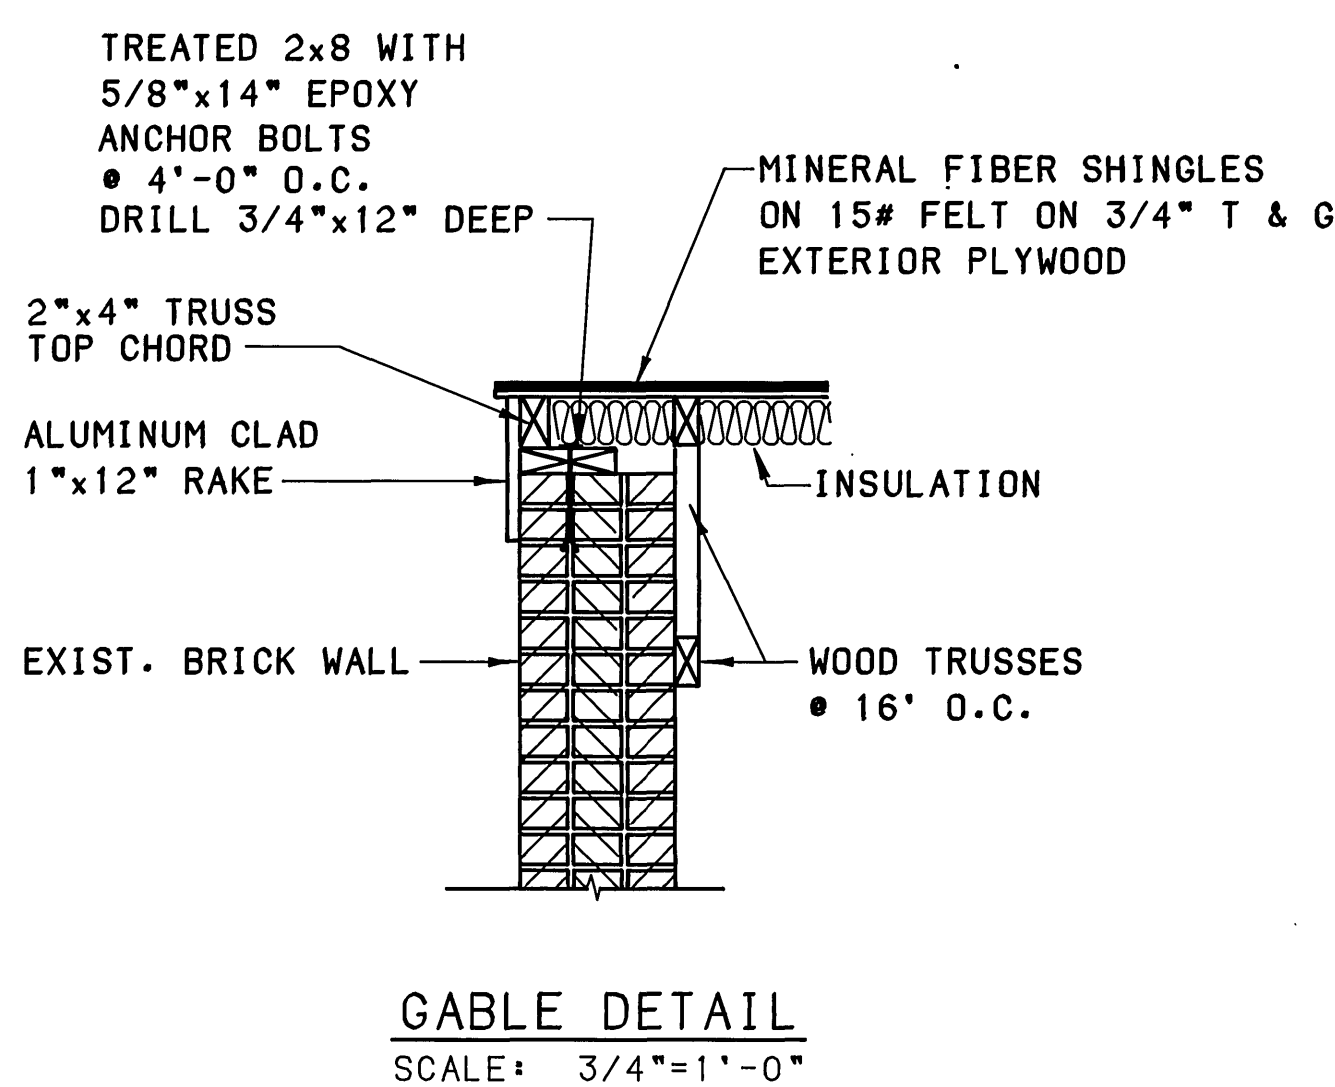
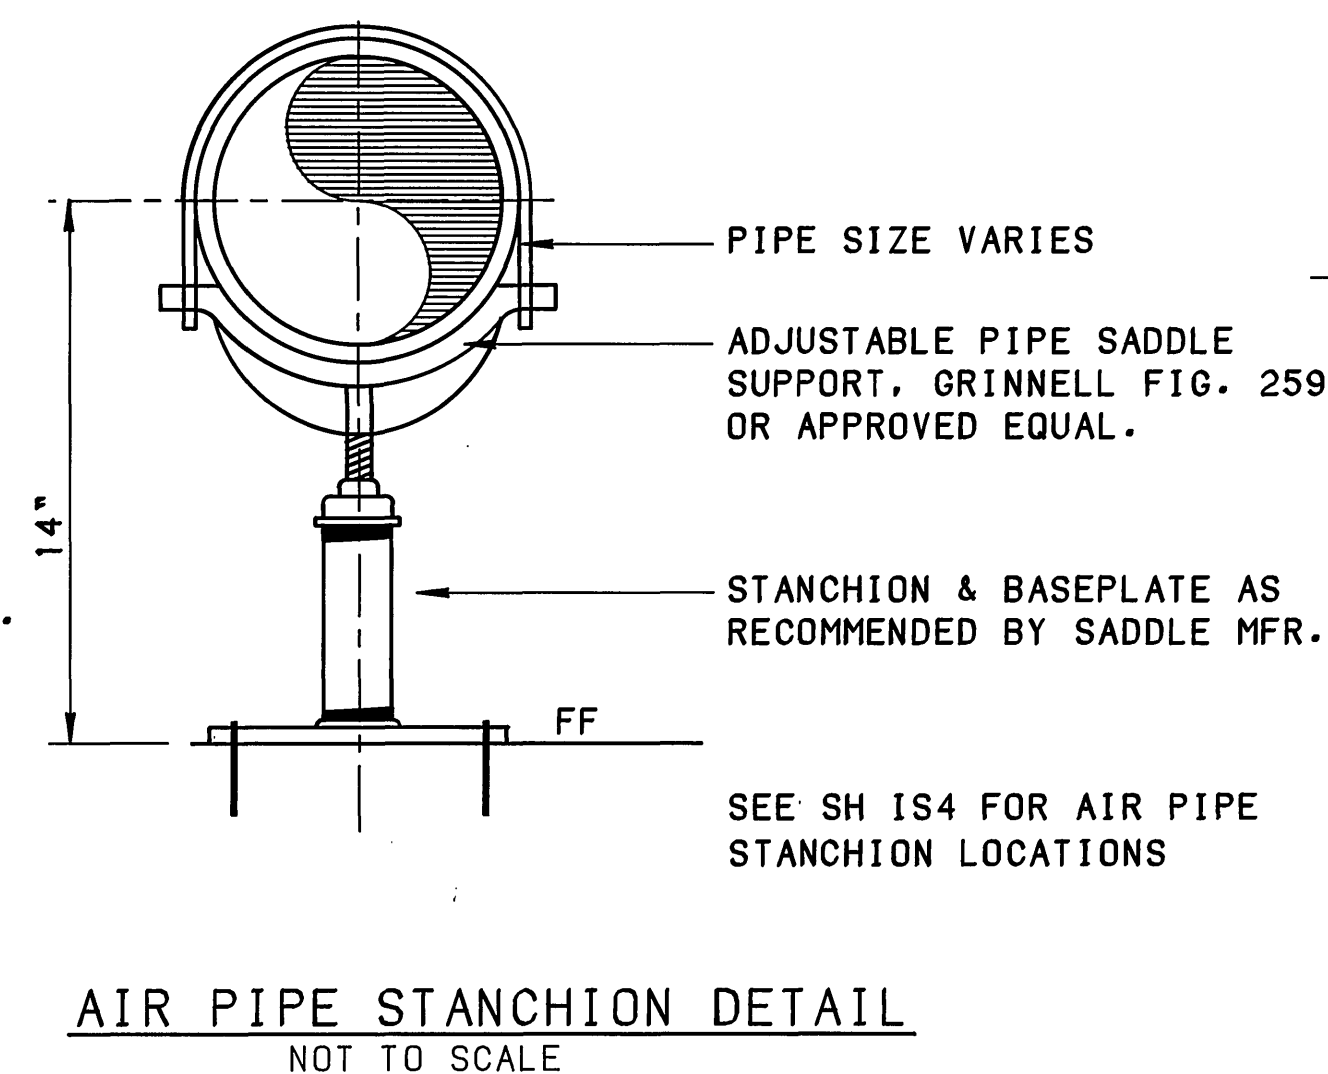
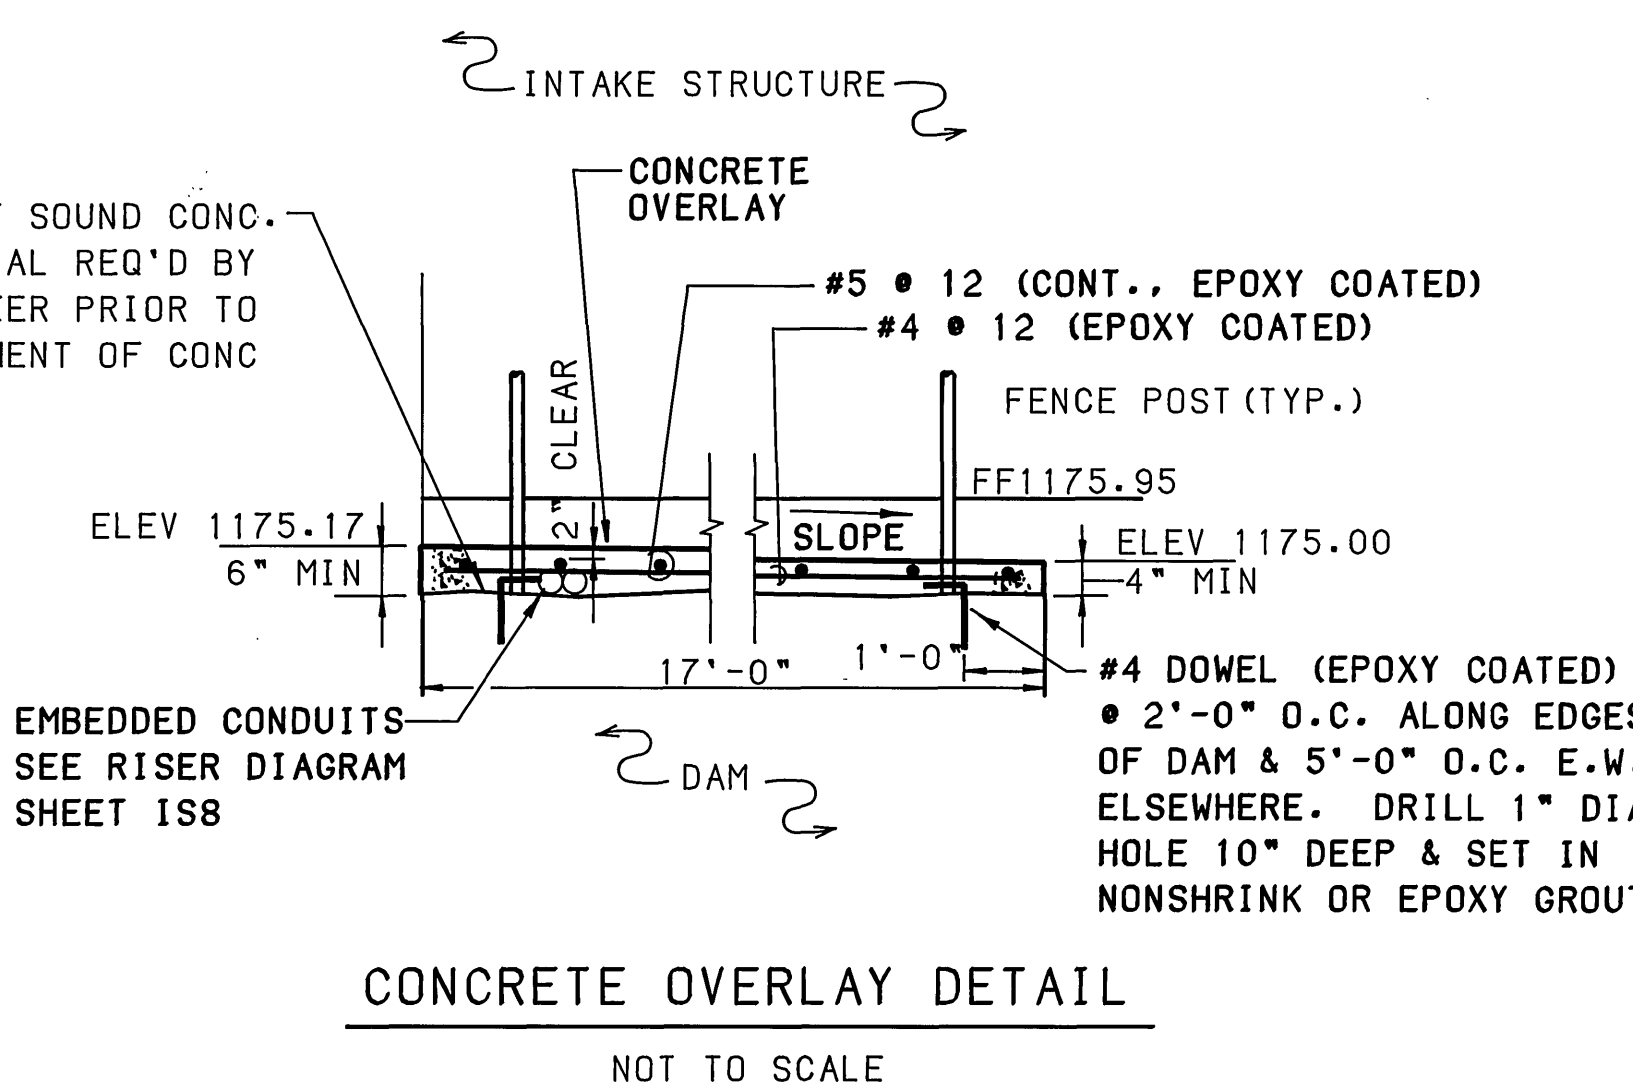
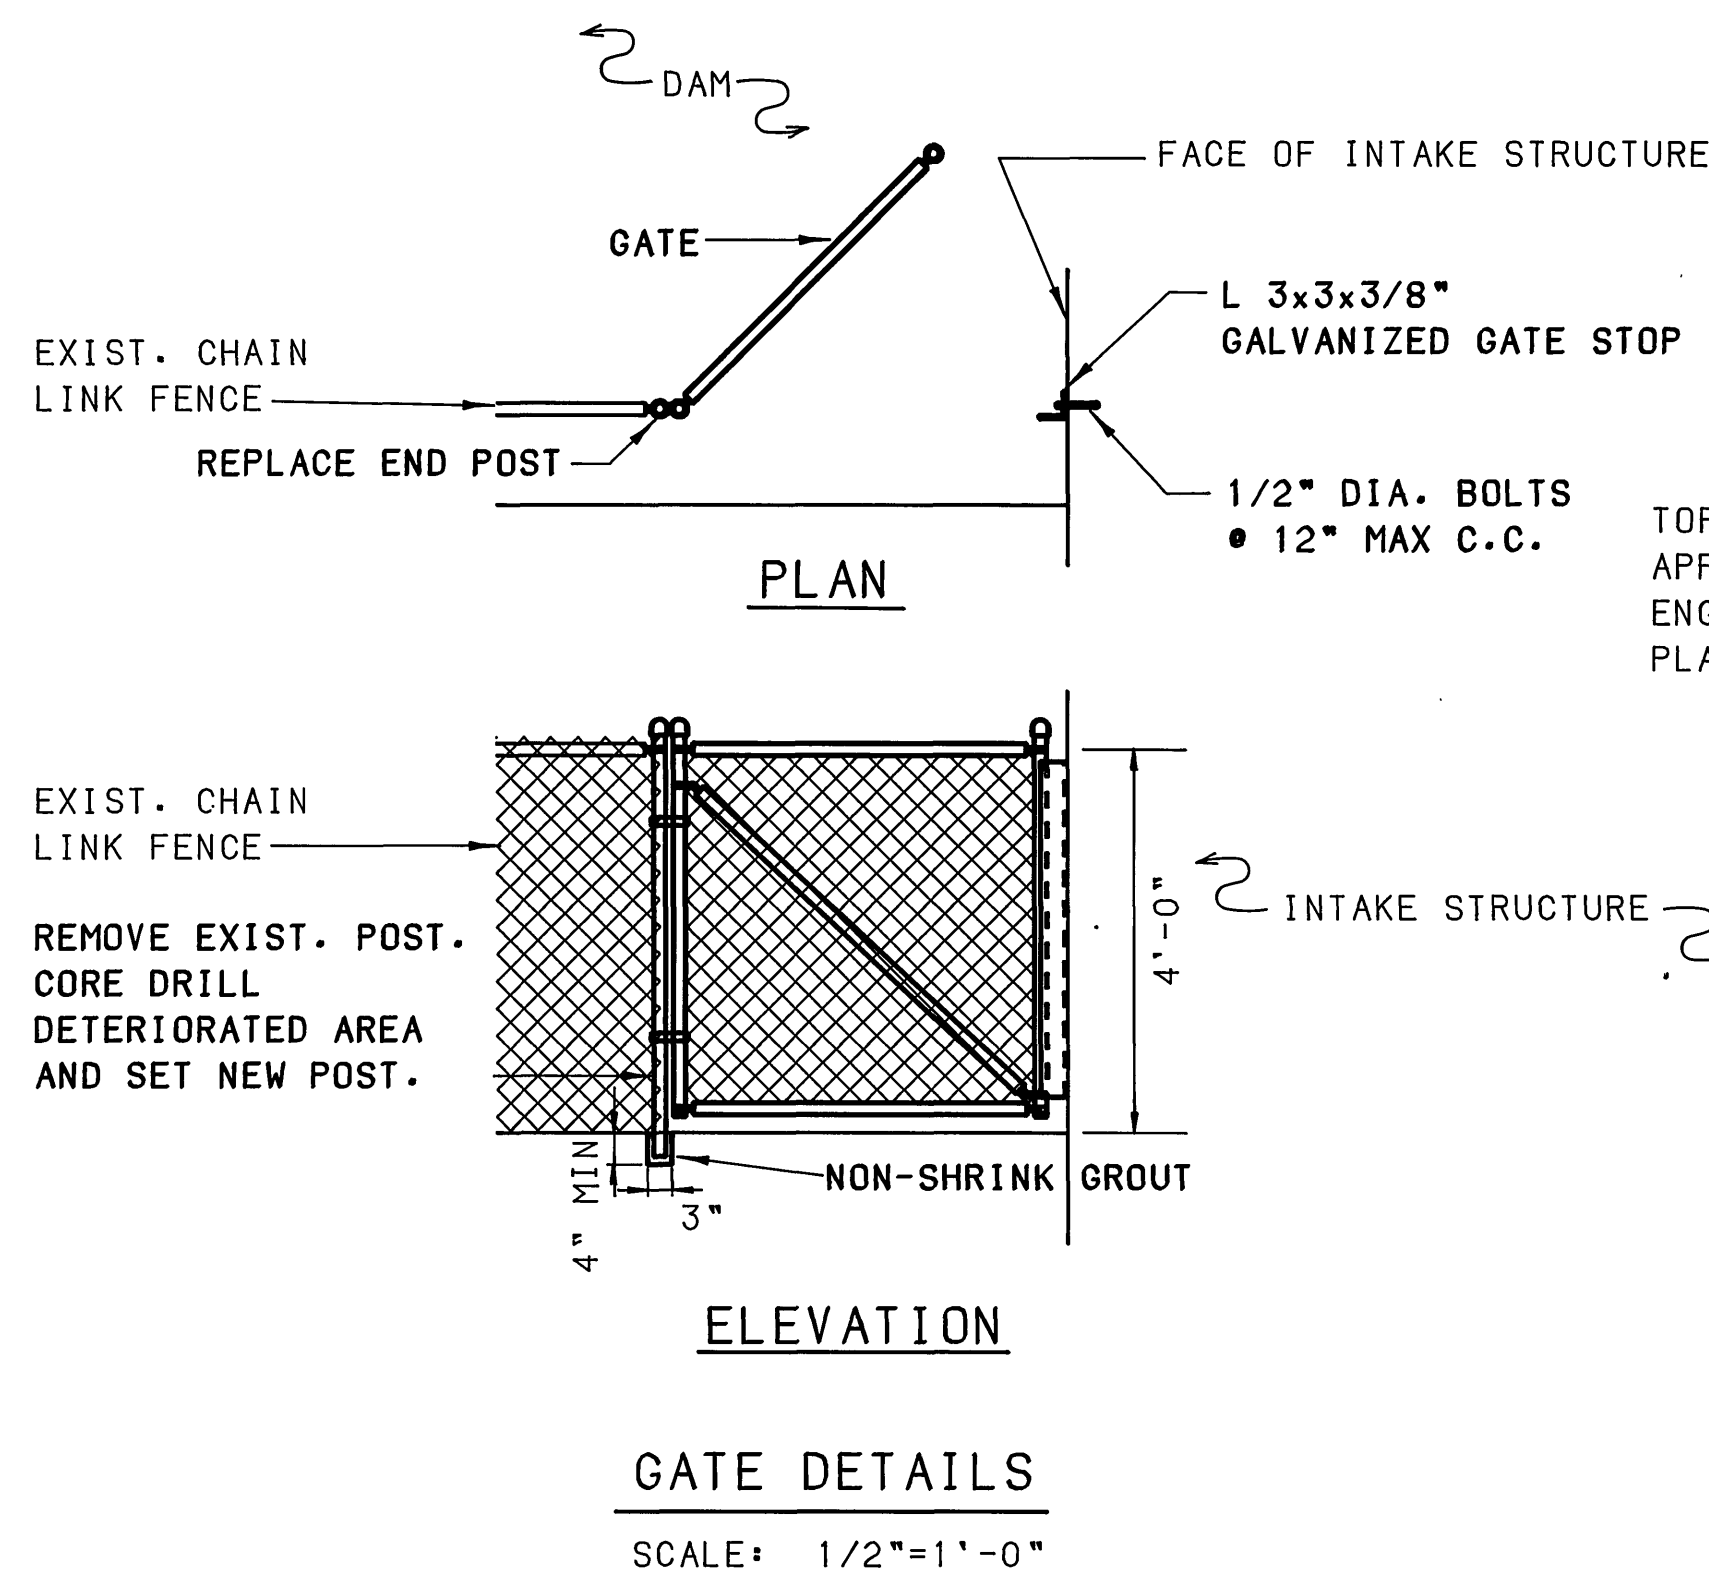
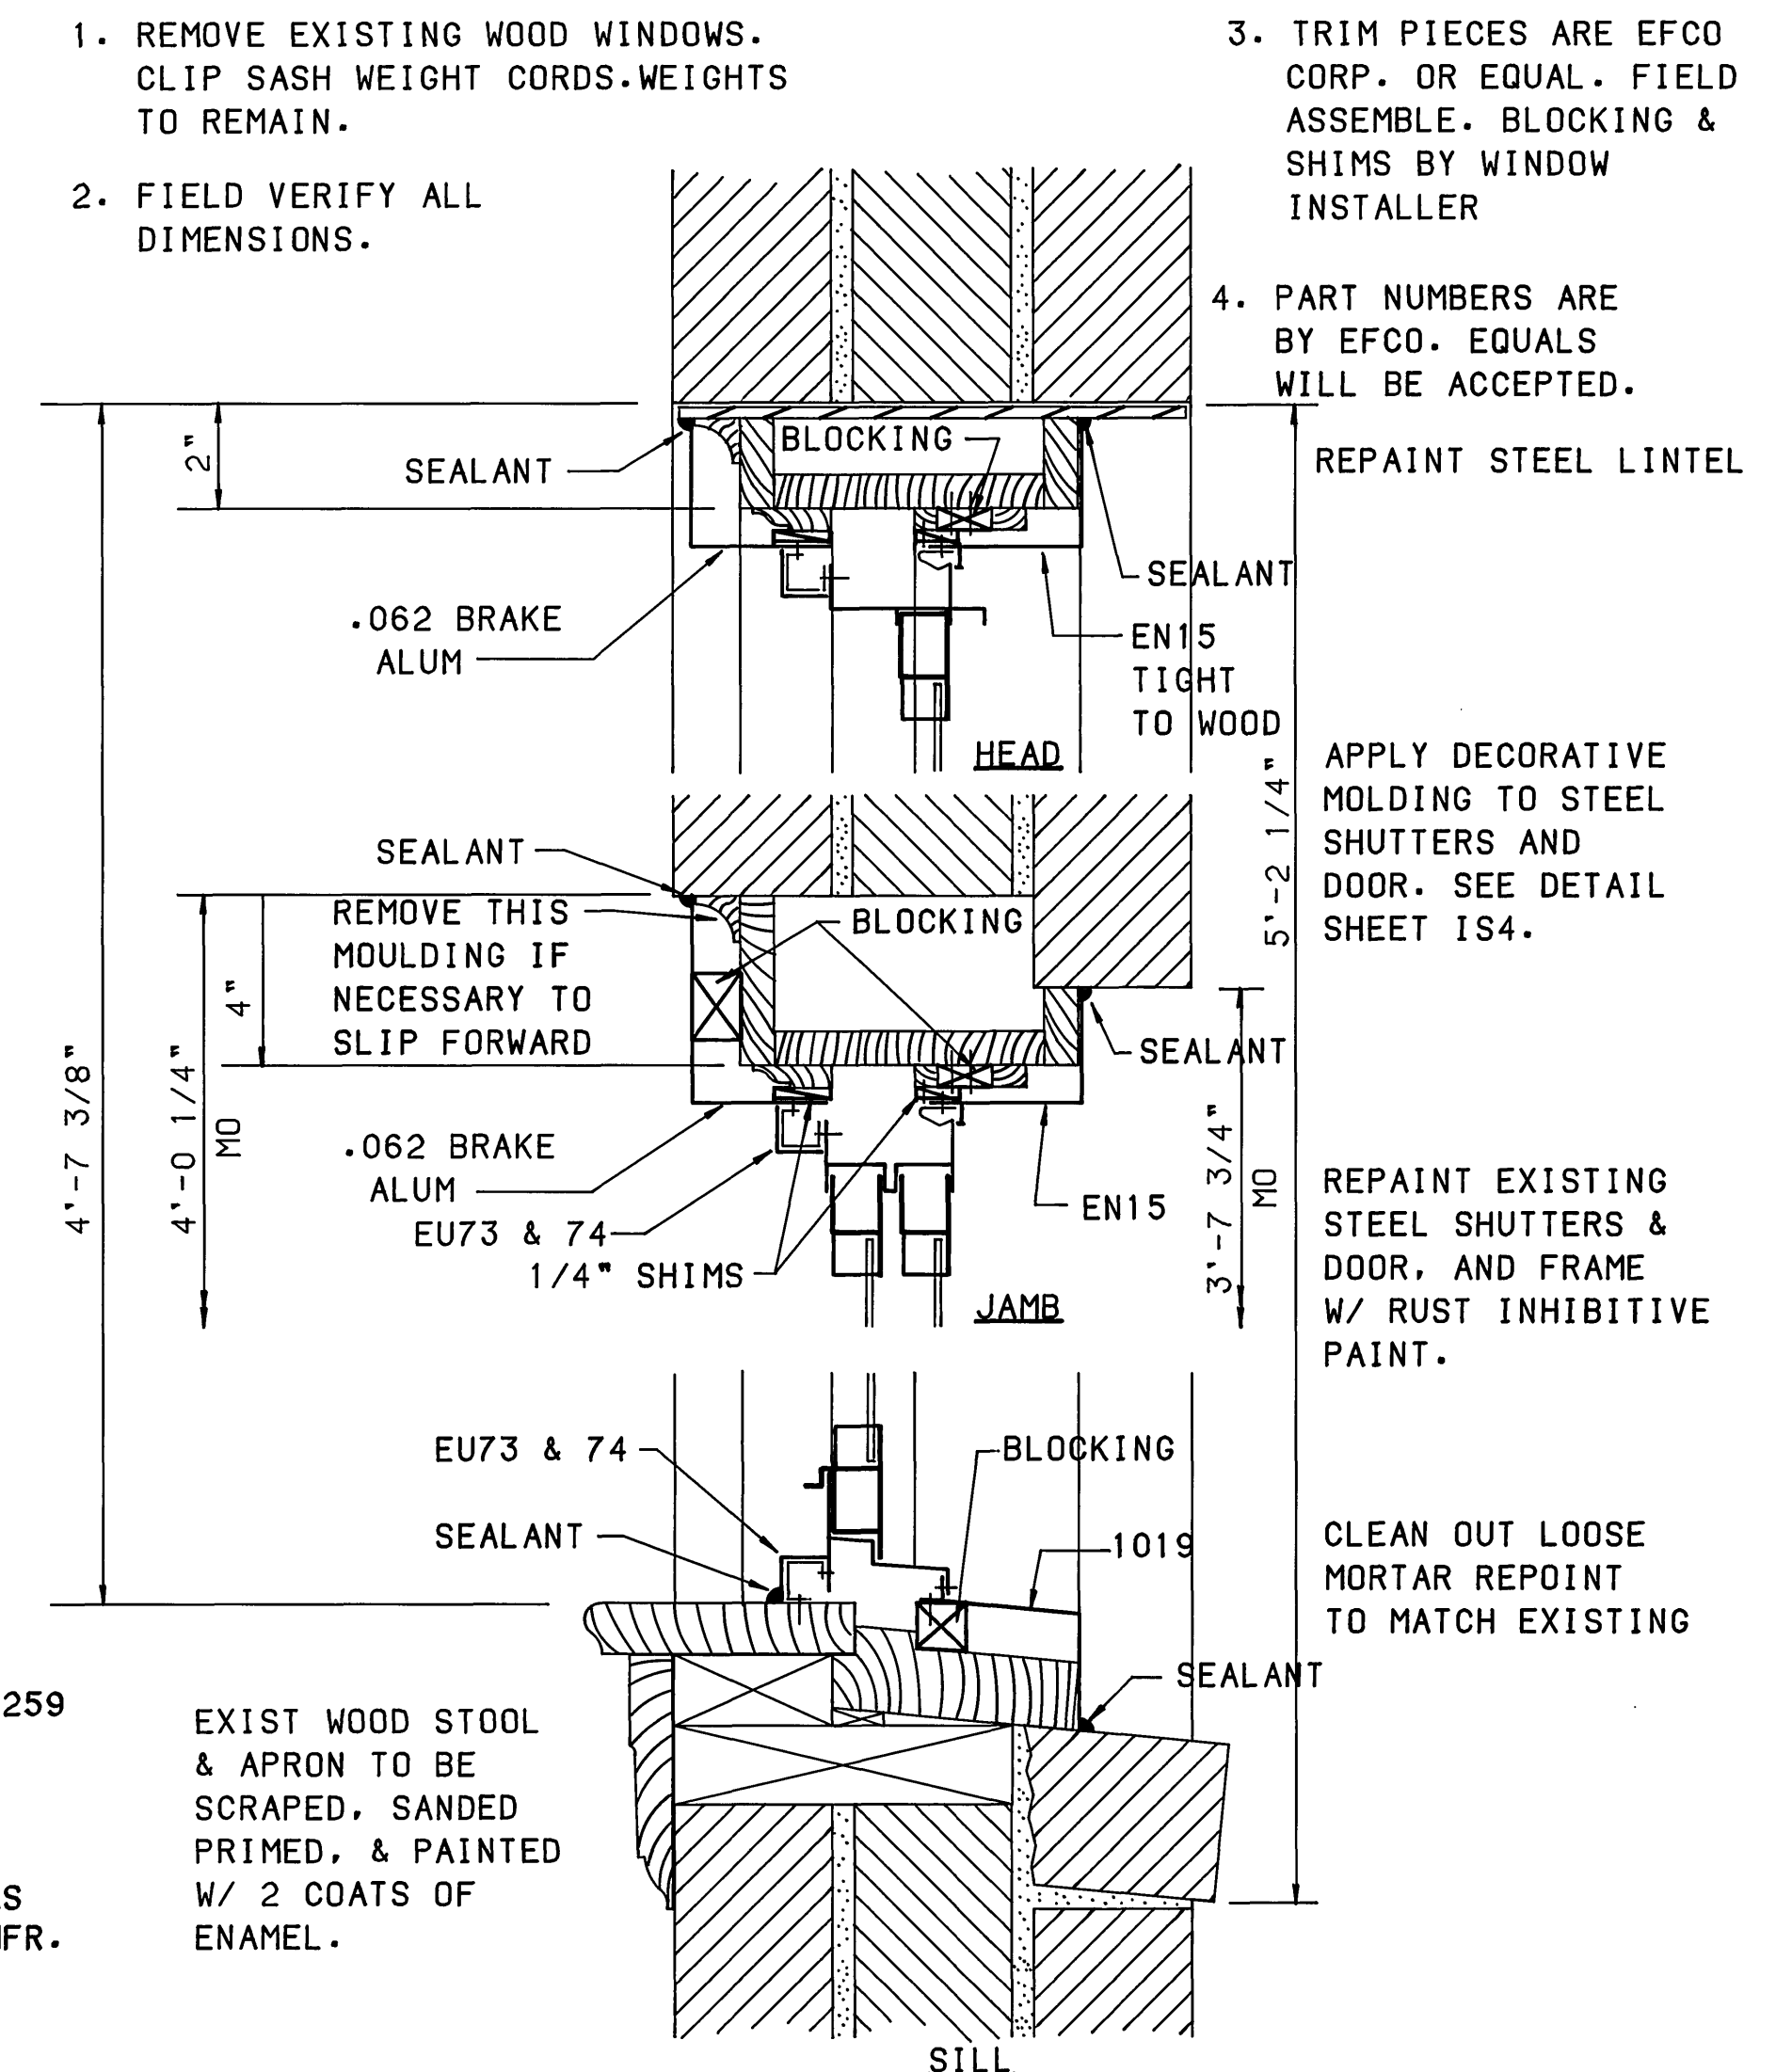
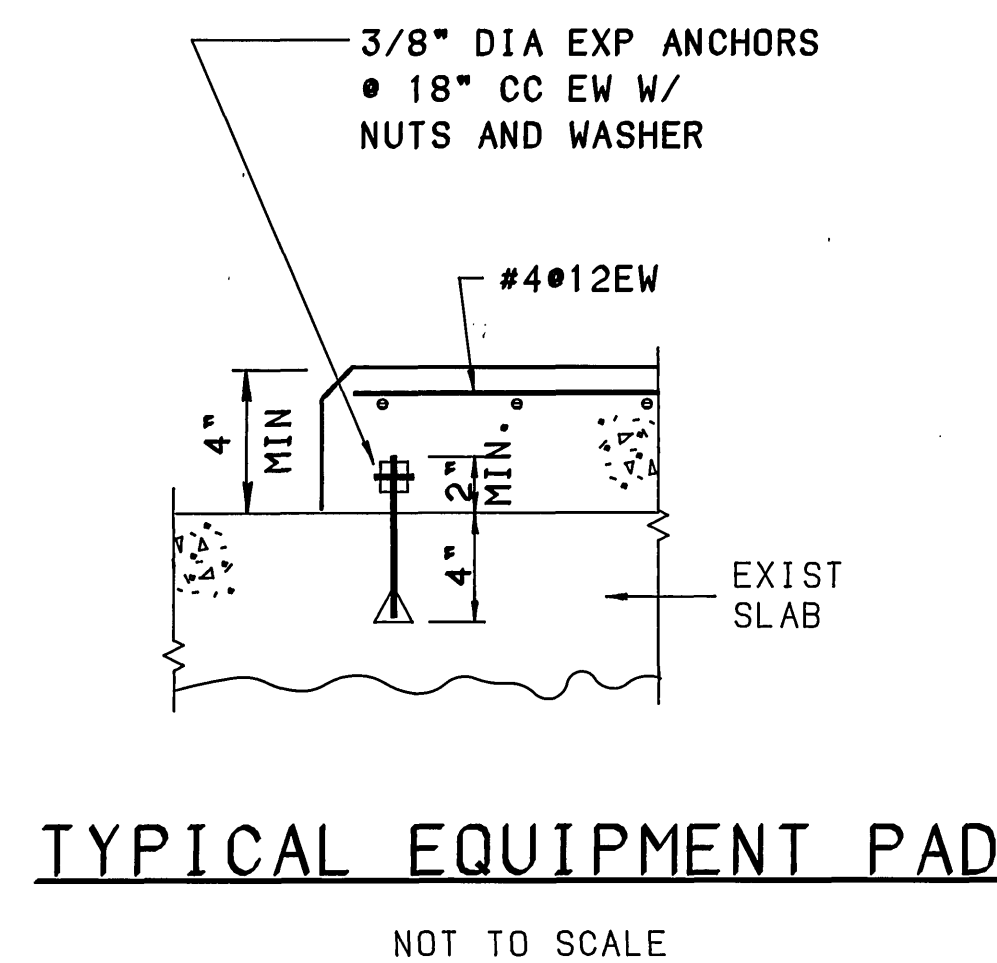
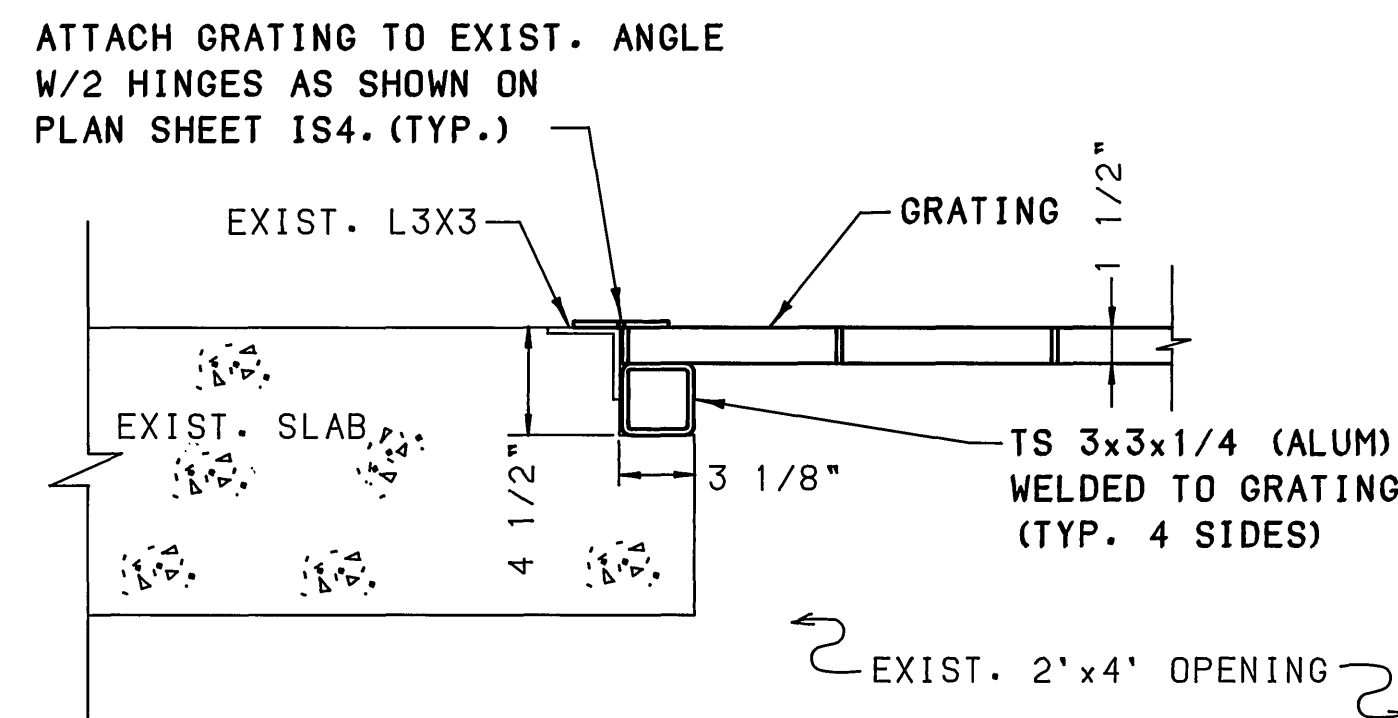


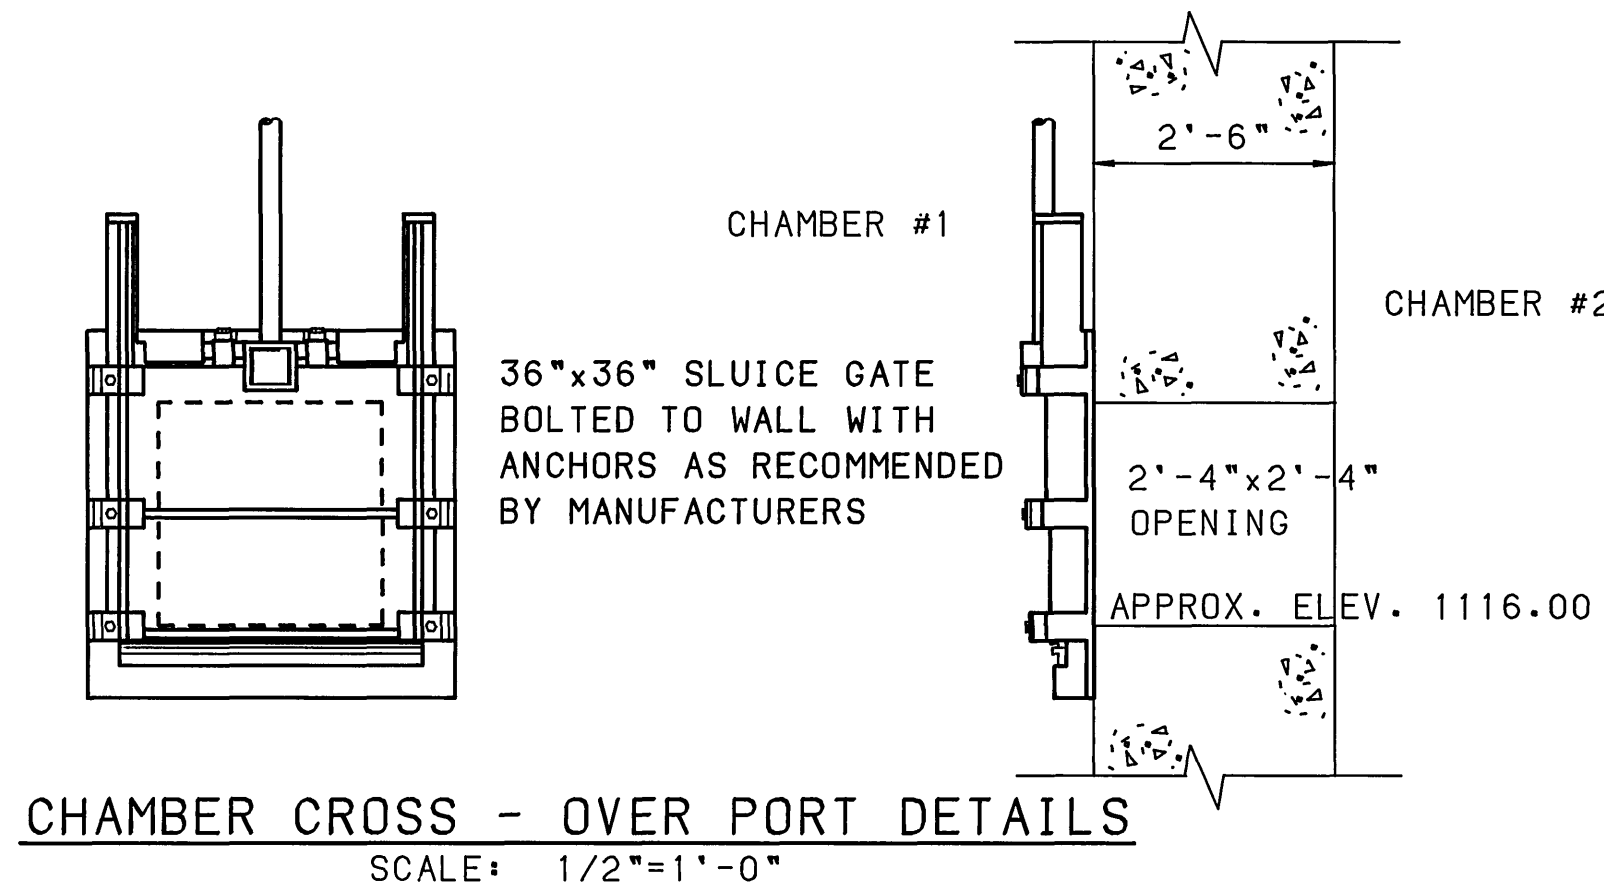

RECORD DRAWING

MATTERN & CRAIG
CONSULTING ENGINEERS • SURVEYORS
ROANOKE VIRGINIA

ALVORD, BURDICK & HOWSON
ENGINEERS CHICAGO

DESIGNED: RWB

DRAWN: TLM/DSG

CHECKED: SWH

STEWART W. HUBBELL
PROFESSIONAL ENGINEER
NO. 07420
2/19/92

REV	DATE	DESCRIPTION	BY	APP.
1	8/92	MISCELLANEOUS	DSG	RWB

CARVINS COVE FILTER PLANT IMPROVEMENTS - PHASE I
ROANOKE, VIRGINIA

INTAKE STRUCTURE
MISCELLANEOUS DETAILS

DATE MARCH 1992
COMM. NO. 1138
SHEET IS7