
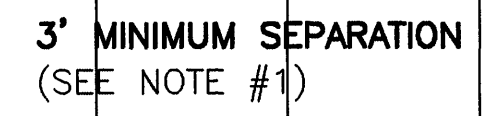
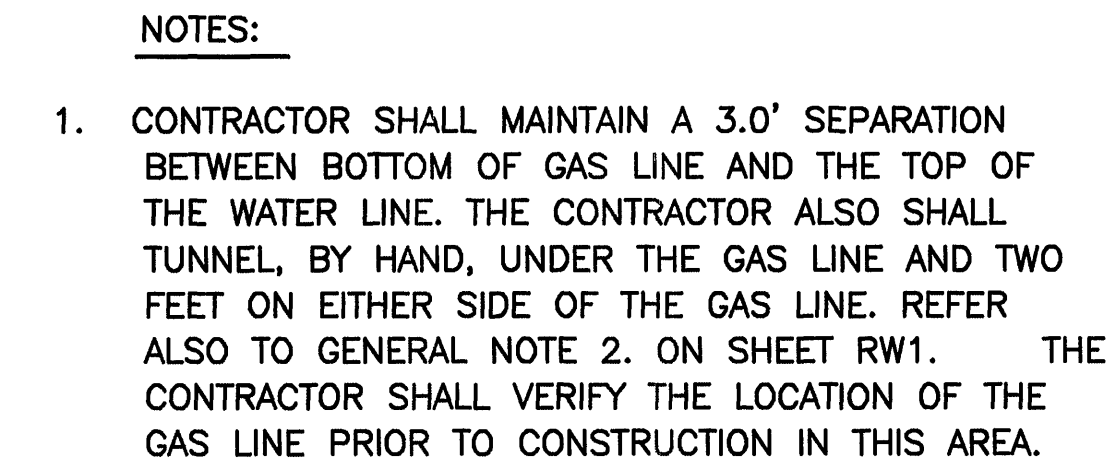


9-12-97

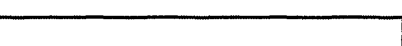

MATTERN & CRAIG CONSULTING ENGINEERS & SURVEYORS ROANOKE VIRGINIA	DESIGNED: RFP			REV	DATE	DESCRIPTION	BY	APP.	CARVINS COVE FILTER PLANT IMPROVEMENTS – PHASE I ROANOKE, VIRGINIA	DATE MARCH, 1992
	DRAWN: ASB			1	8/92	MISCELLANEOUS	DSG	RWB		COMM. NO. 1138
ALVORD, BURDICK & HOWSON ENGINEERS CHICAGO	CHECKED: JSL			2	5/93	C.O. #3	CLD	RWB	RAW WATER LINE PLAN & PROFILE	SHEET RW2A
		3	9/97	RECORD DRAWING	BCB	JWB				