



NOTES:

1. THE CONTRACTOR SHALL CONSTRUCT THE WATERLINE IN ACCORDANCE WITH STREAM CROSSING DETAIL (SEE SHEET RW5) WHEN CROSSING THE CREEK CHANNEL.


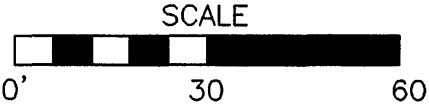


SCALE: HORIZONTAL: 1" = 30' VERTICAL: 1" = 10'

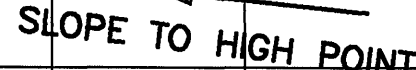

800' - 36" RAW WATER LINE & (3) 2" CHLORINE SOLUTION LINES

DESIGNED: _____ RFP
DRAWN: _____ DSG
CHECKED: _____ JSL

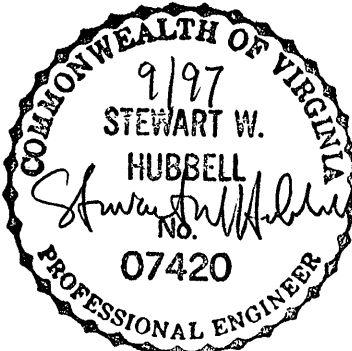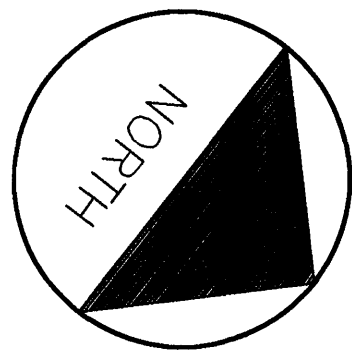CARVINS COVE FILTER PLANT IMPROVEMENTS – PHASE I

ROANOKE, VIRGINIA

RAW WATER LINE PLAN & PROFILE

DATE	MARCH 1992
COMM. NO.	1138
SHEET	RW3A