
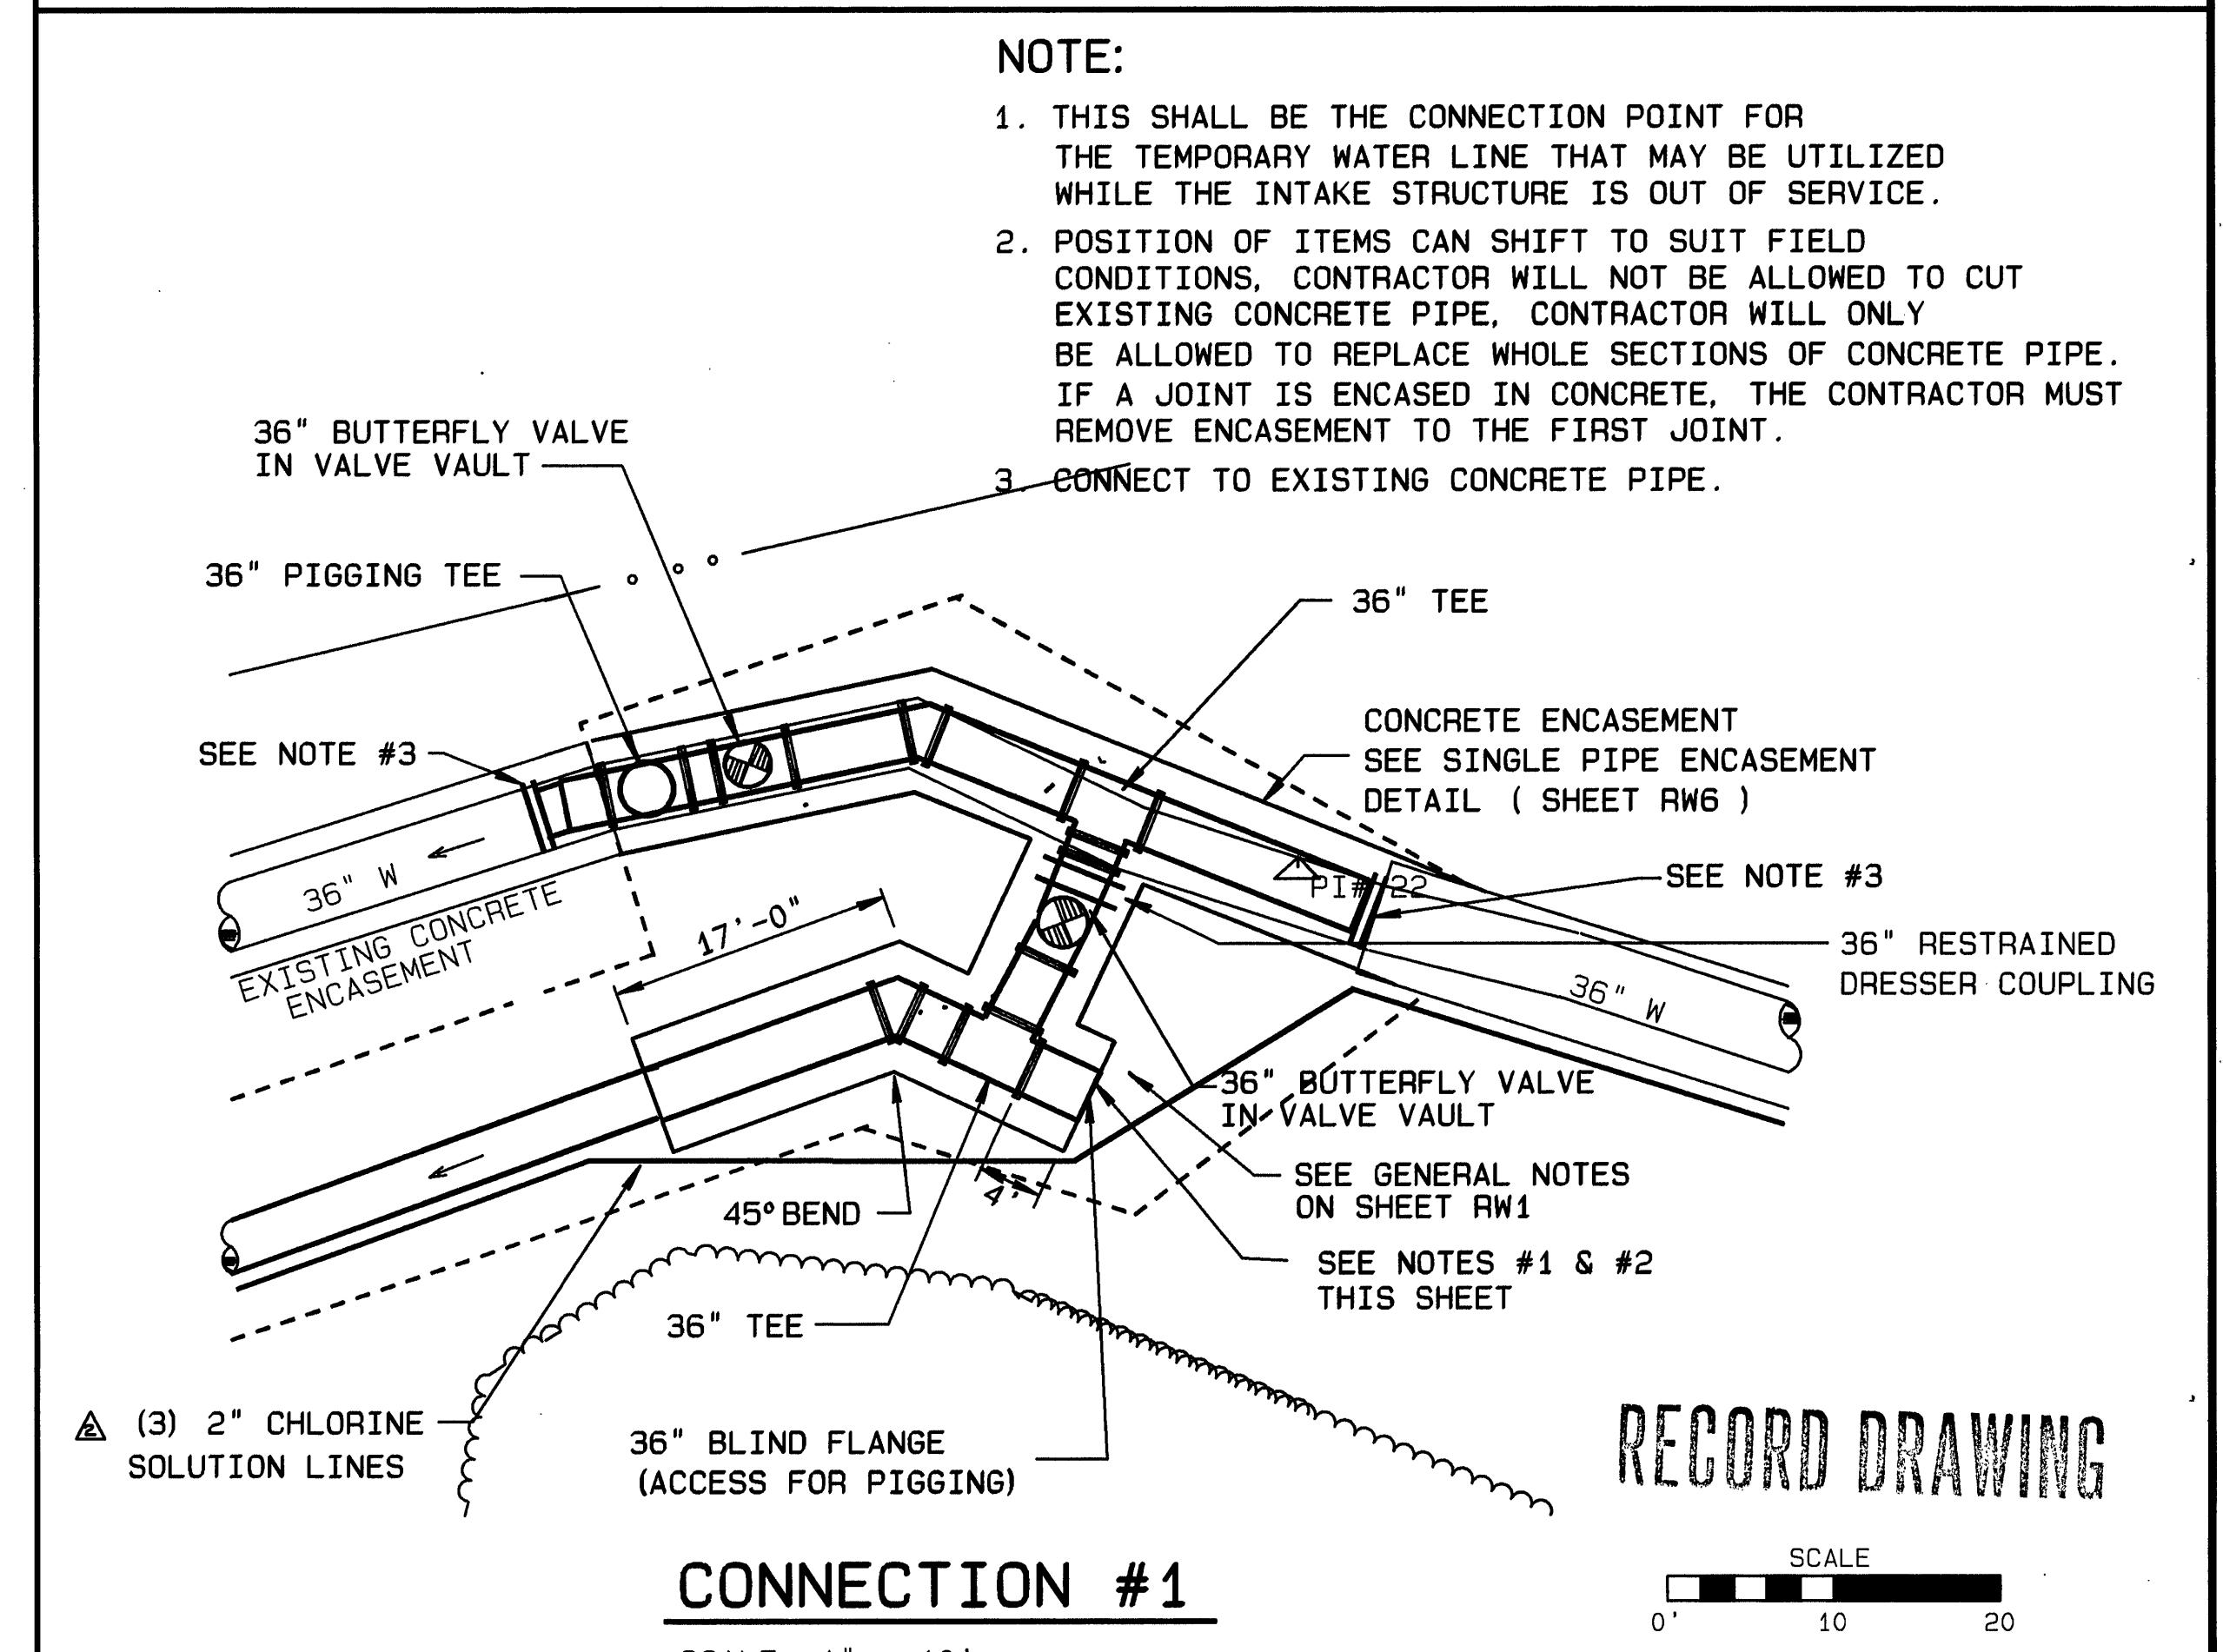
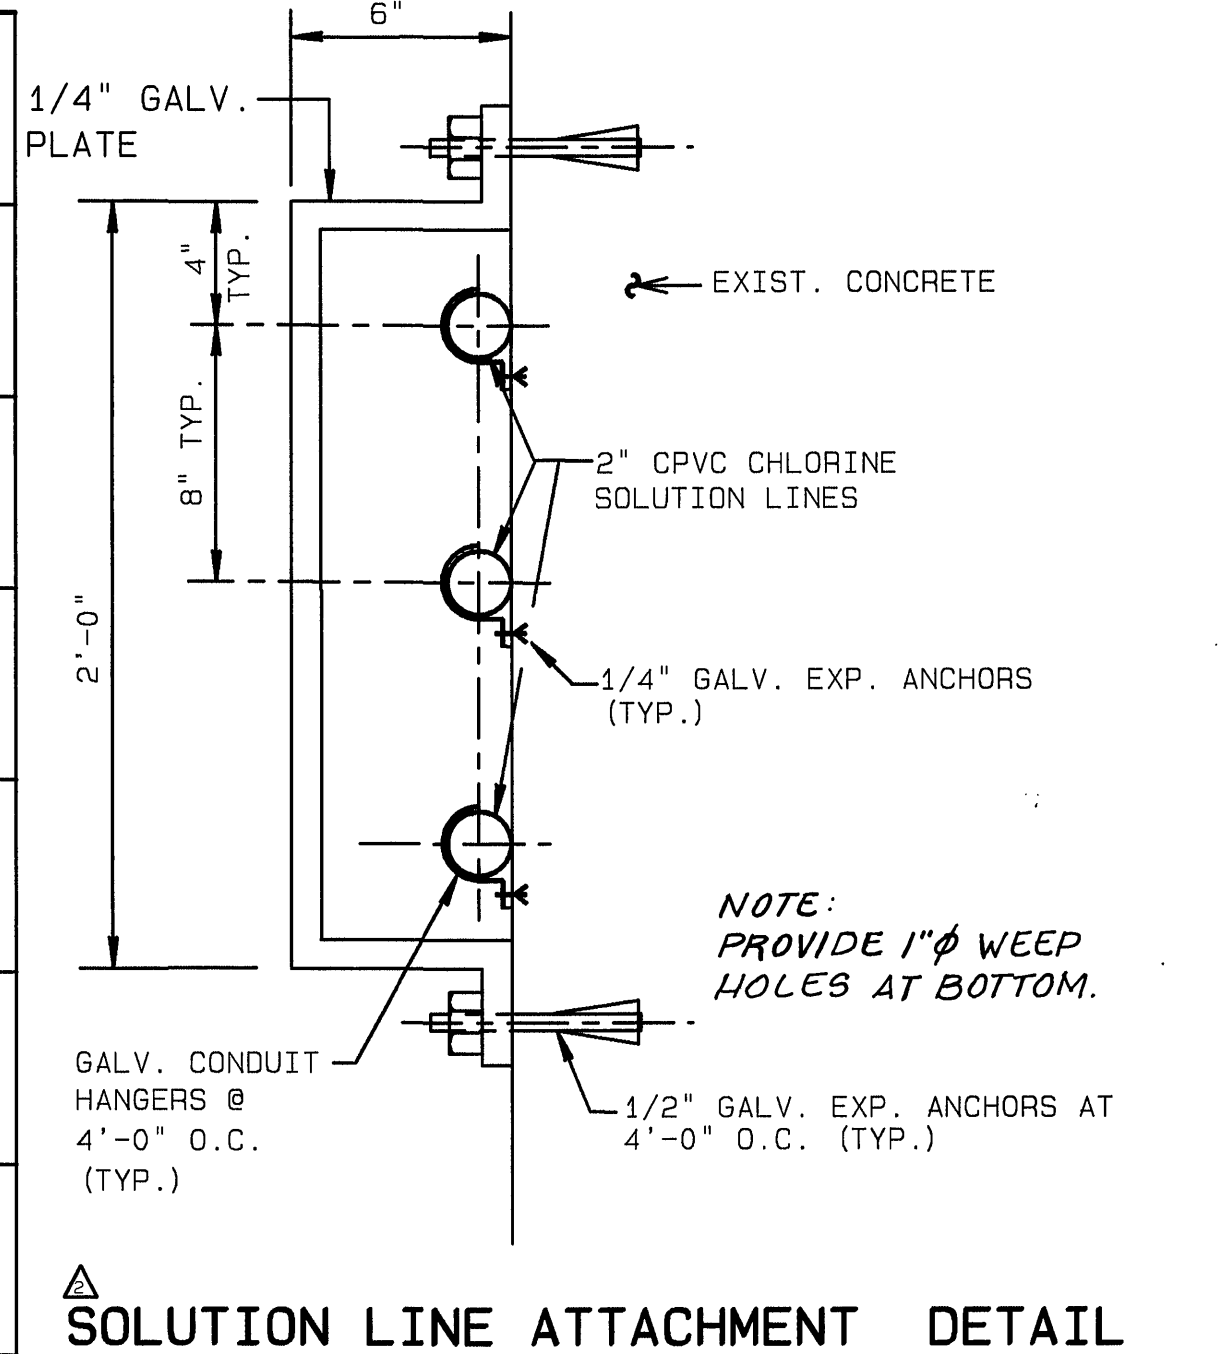
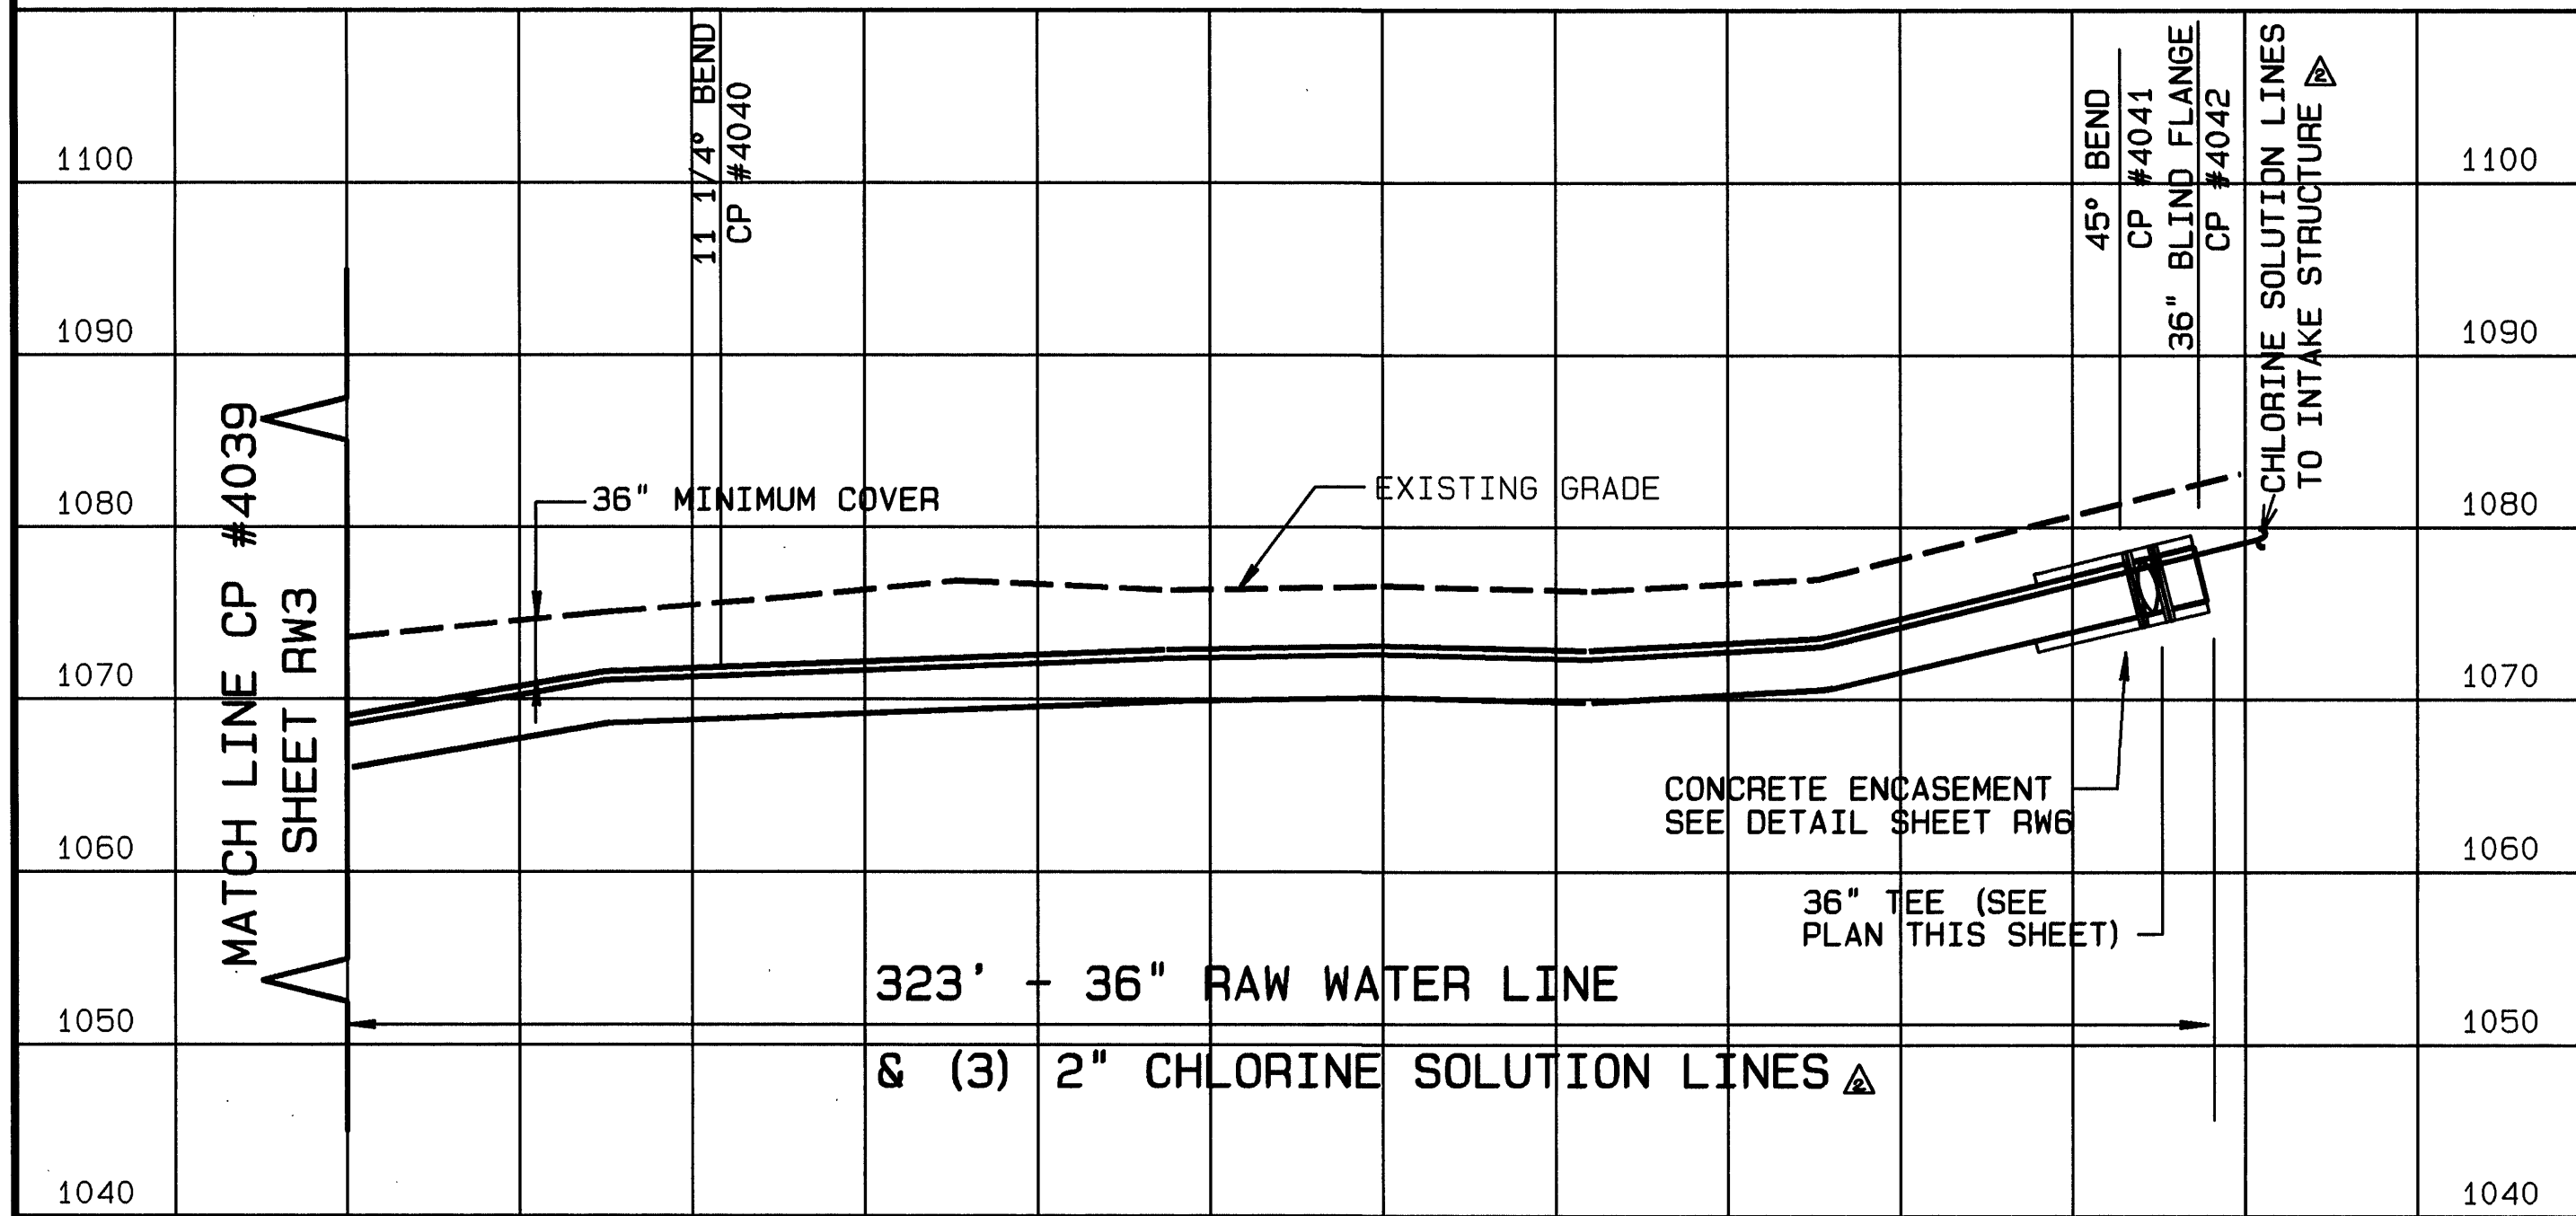
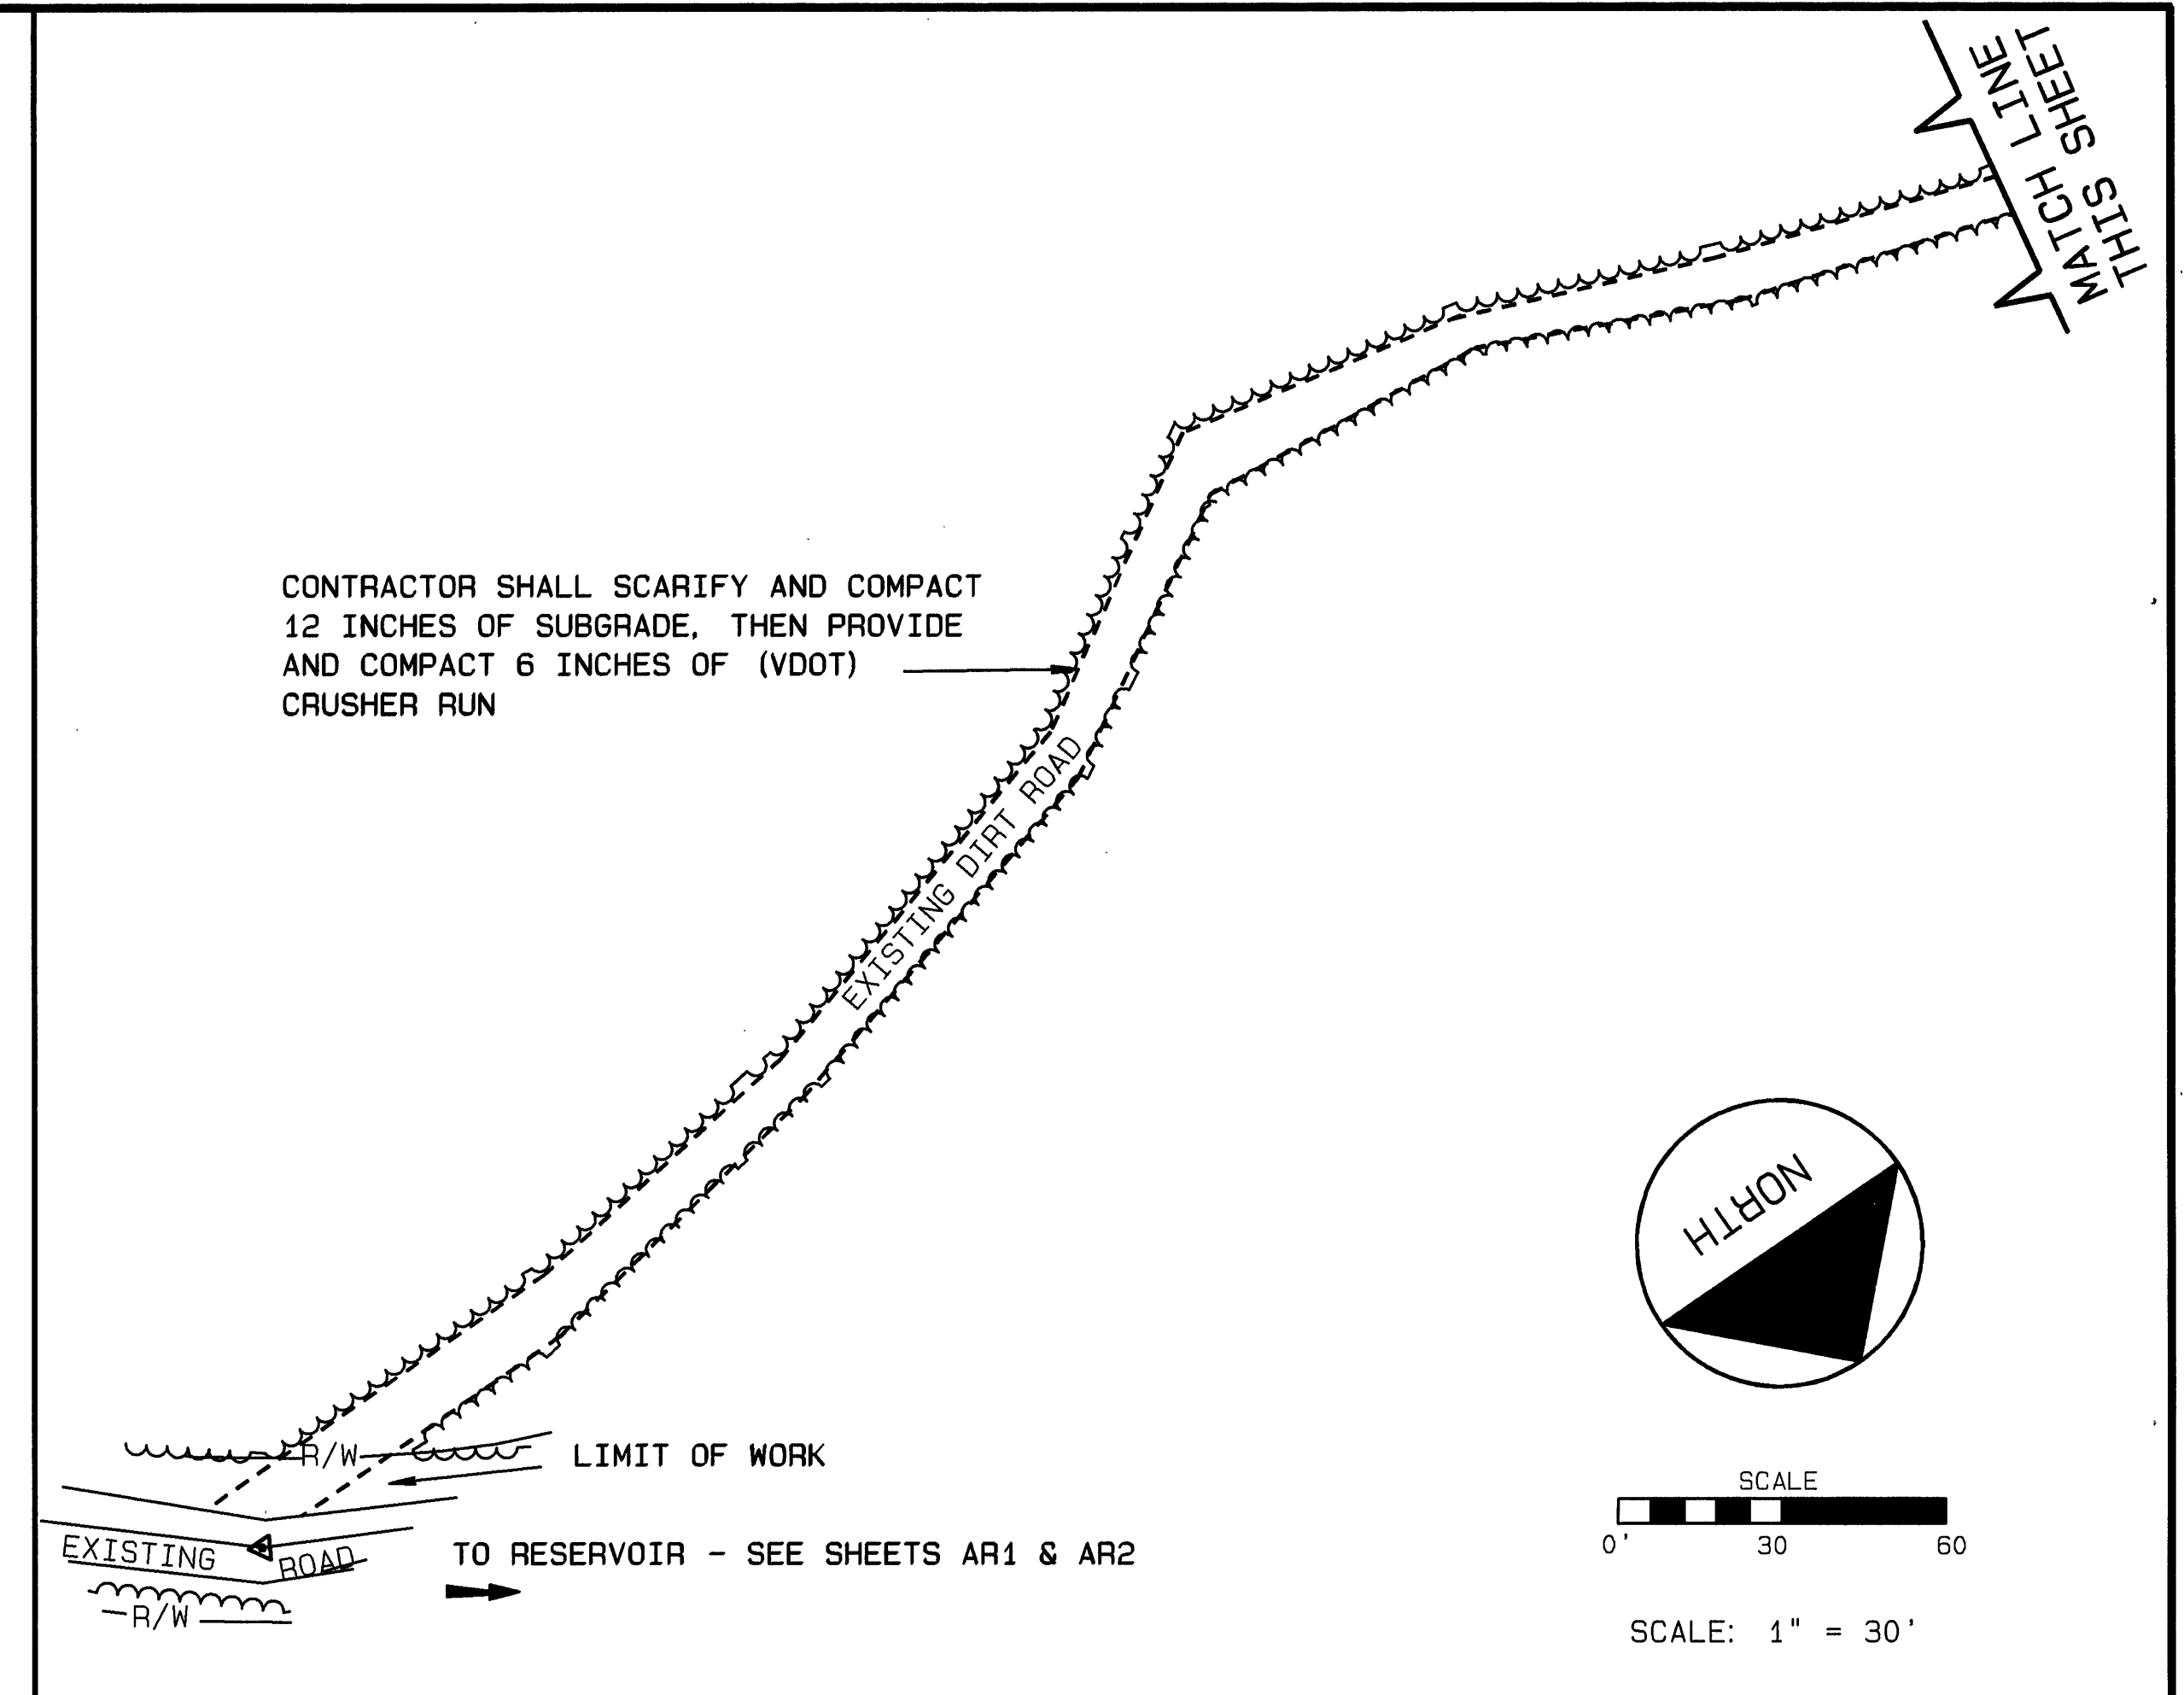


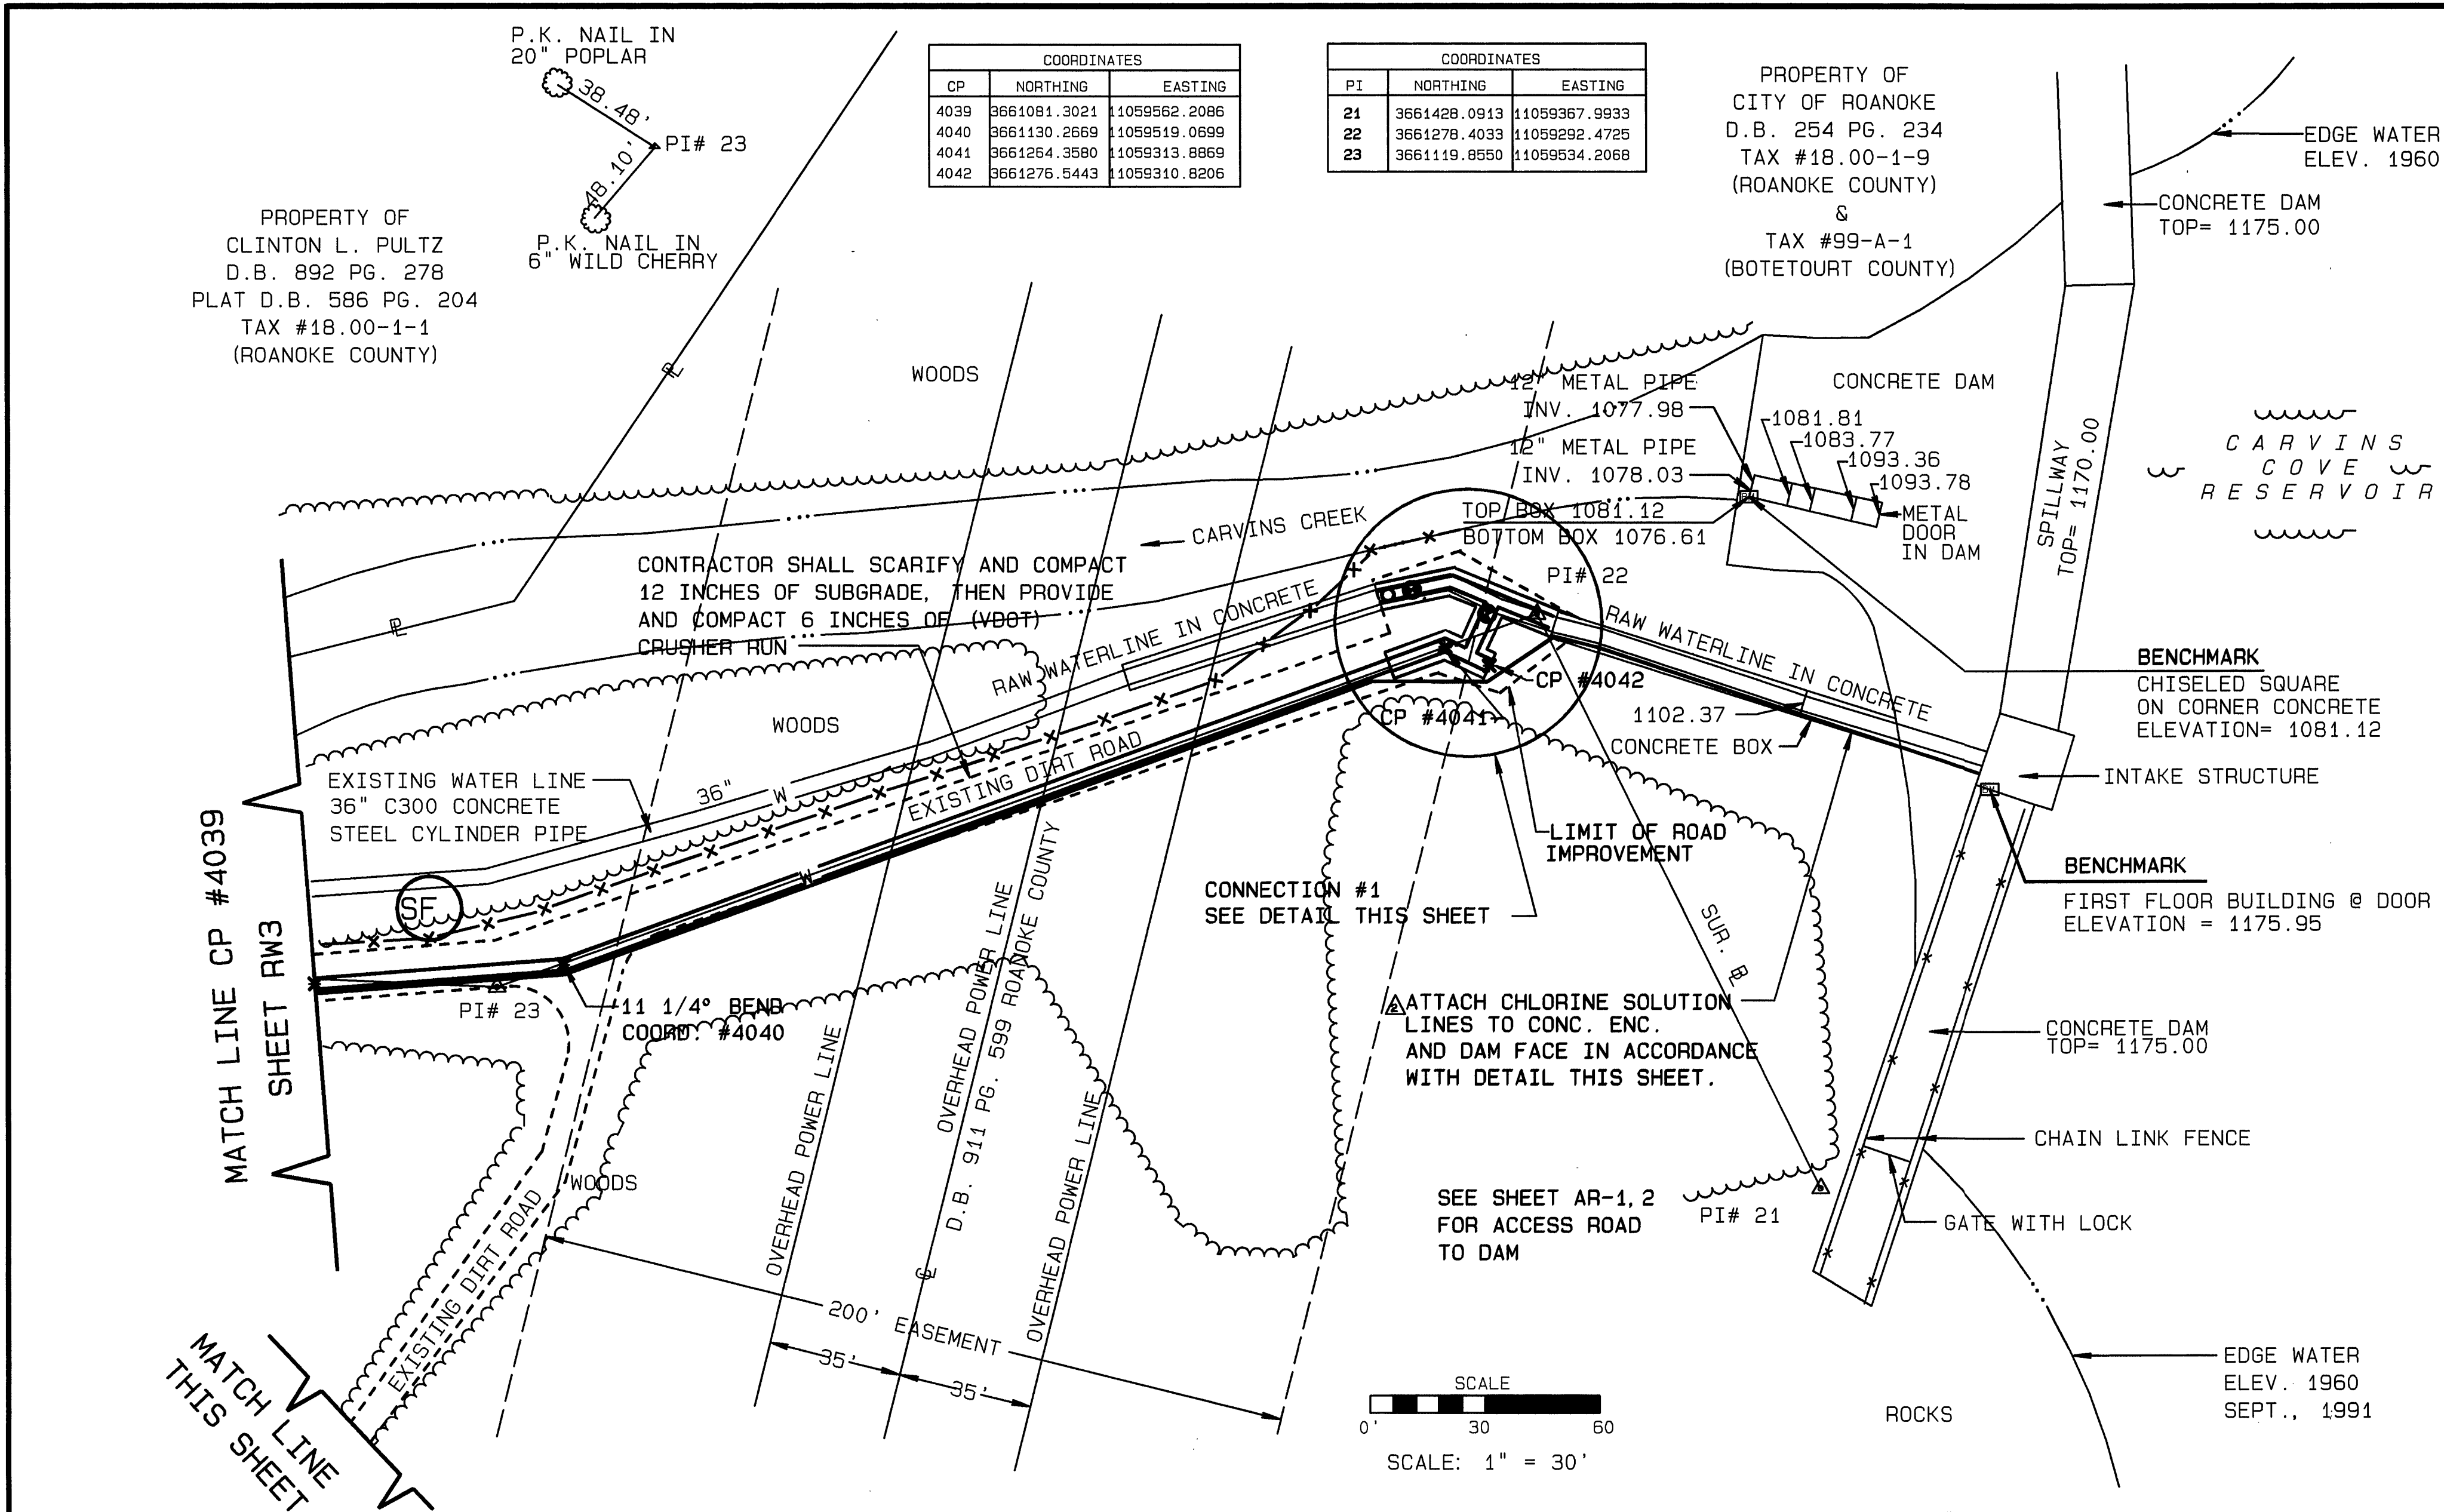

SCALE: HORIZONTAL: 1" = 30' VERTICAL: 1" = 10' NO SCALE										SCALE: 1" = 10'										
MATTERN & CRAIG CONSULTING ENGINEERS • SURVEYORS ROANOKE VIRGINIA					DESIGNED: RFP				REV	DATE	DESCRIPTION	BY	APP.	CARVINS COVE FILTER PLANT IMPROVEMENTS - PHASE I ROANOKE, VIRGINIA					DATE MARCH 1992	
					1	8/92			MISCELLANEOUS	DSG	RWB	COMM. NO. 1138								
ALVORD, BURDICK & HOWSON ENGINEERS CHICAGO					DRAWN: TLM											SHEET RW4A				
					CHECKED: JSL															