


LINTEL SCHEDULE	
L-1	W8 X 21 WITH 1/4" X 11" PLATE
L-2	W8 X 10 WITH 1/4" X 11" PLATE
L-3	W8 X 21 WITH 1/4" X 11" PLATE
L-4	8" C.M.U. LINTEL

NOTE: PROVIDE 8" MIN BEARING

FINISH NOTES:

- ALL CONCRETE FLOORS SHALL RECEIVE 2 COATS OF SEALER.
- ALL C.M.U. WALLS SHALL BE BLOCK SEALED AND PAINTED WITH TWO (2) COATS ENAMEL. COLOR TO BE SELECTED BY OWNER.
- ALL METAL DOORS AND FRAMES SHALL BE SHOP PRIMED AND FIELD COATED W/ TWO (2) COATS ENAMEL. THIS ALSO INCLUDES BOLLARDS, ANGLES, AND ALL OTHER FERROUS METALS.
- CONCRETE WALLS OF PUMP PITS AND PIPE GALLERY SHALL RECEIVE ONE COAT OF THEROSEAL.

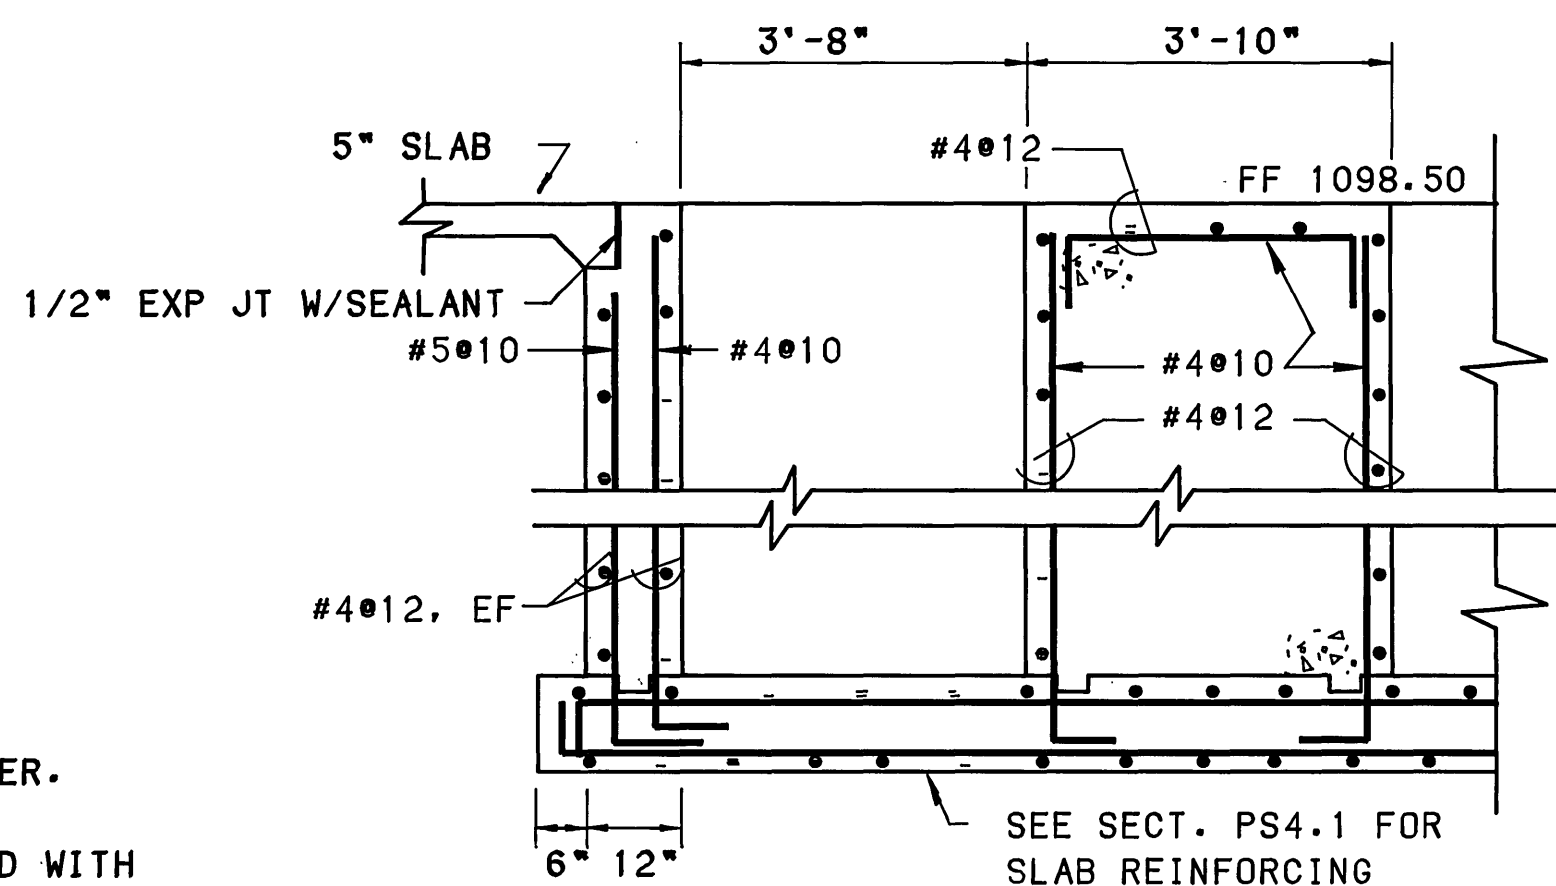


SECTION

SCALE: 1/2" = 1'-0"

PS3.1

PS3

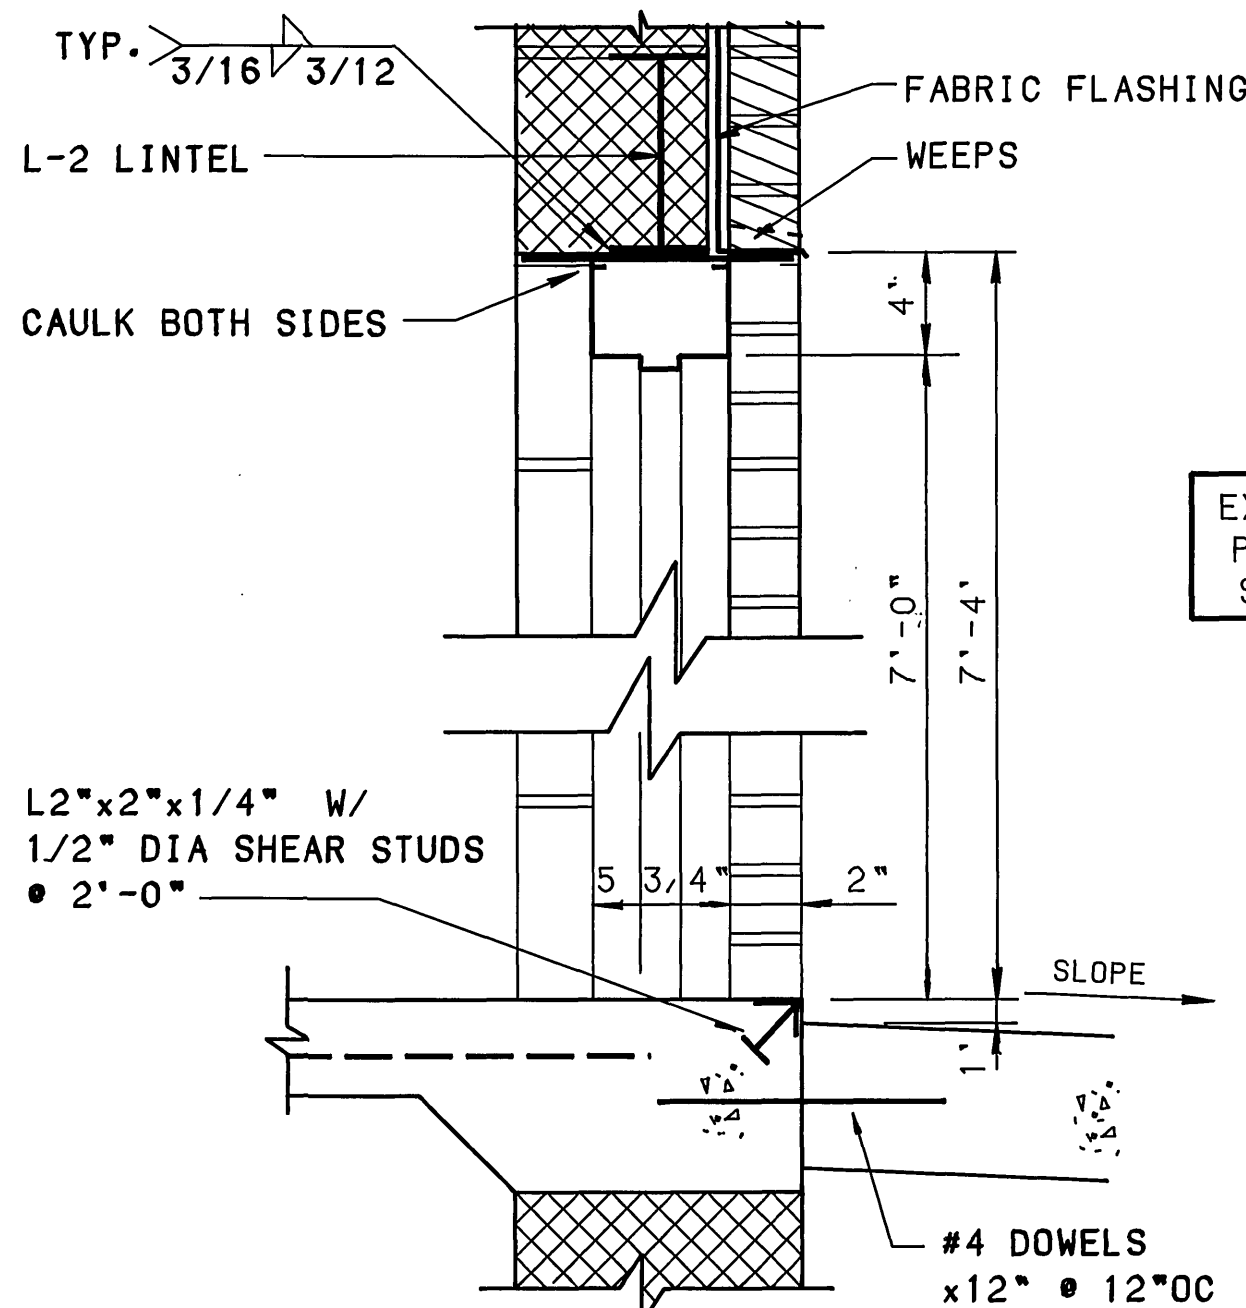


TYPICAL EXTERIOR DOOR DETAIL

SCALE: 1 1/2" = 1'-0"


DOOR SCHEDULES								
NO	SIZE	MATERIAL	TYPE	GLASS	LOUVER	FRAME	THRESHOLD	REMARKS
1	3070 X 1 3/4	METAL	A	—	—	1	—	4" HEAD, CLOSER, LOCKSET
2	3070 X 1 3/4	METAL	A	—	—	1	—	4" HEAD, CLOSER, LOCKSET
3	3070 X 1 3/4	METAL	A	—	—	2	—	4" HEAD, PASSAGE SET
4	1010 X 1 3/4	METAL	B	—	—	3	—	CHAIN OPERATED
5	4270 X 1 3/4	METAL	A	—	—	2	—	4" HEAD, CLOSER, LOCKSET
6	6090 X 1 3/4	METAL	C	—	—	4	—	4" HEAD, LOCKSET

EXI T
PUMP
STA.

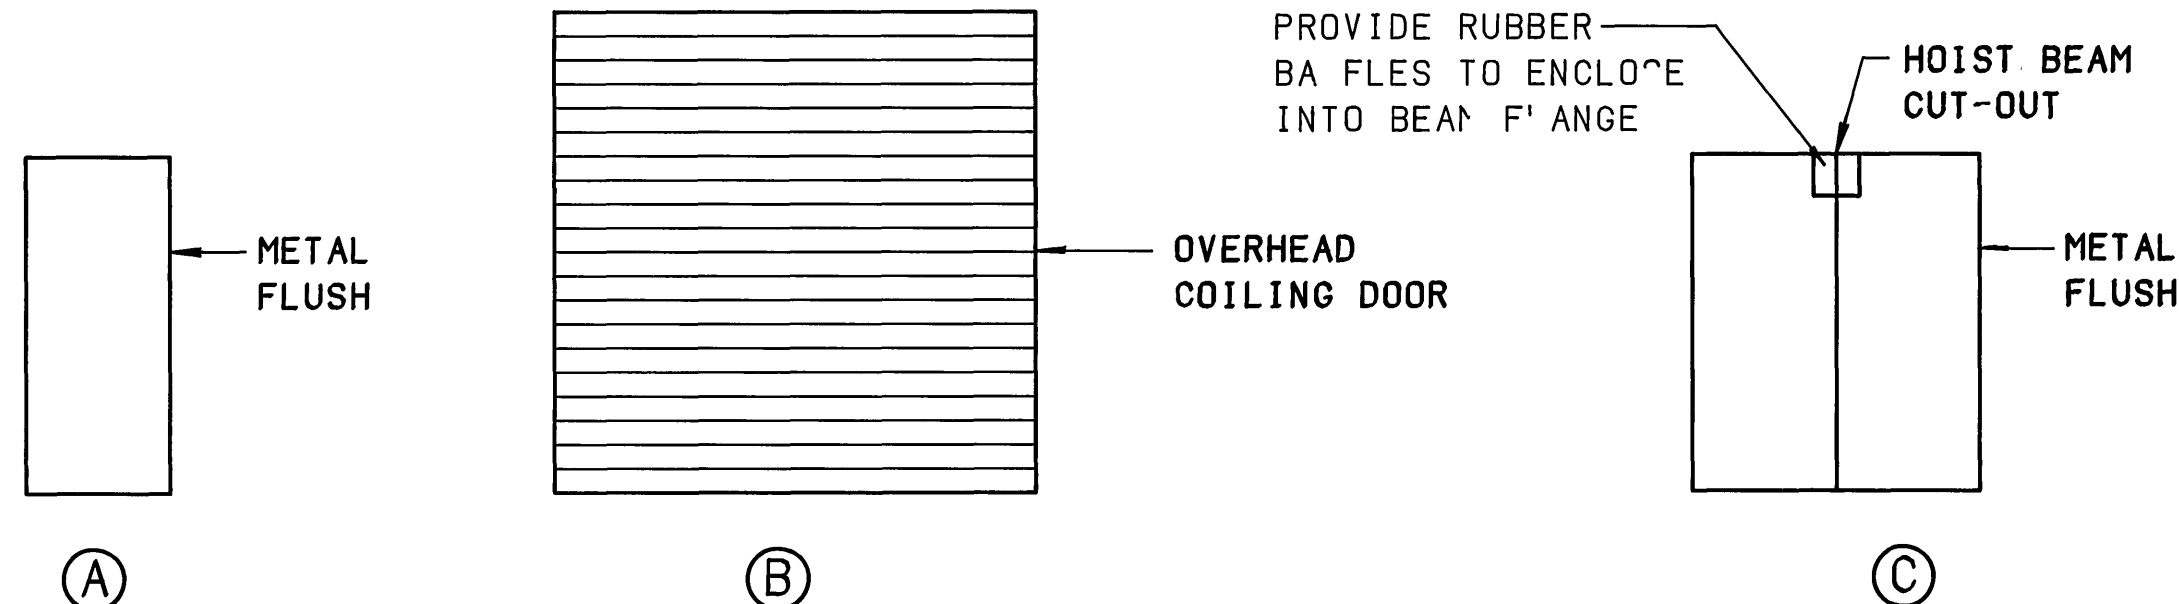

DOOR TYPE ELEVATIONS

SCALE: 1/4" = 1'-0"

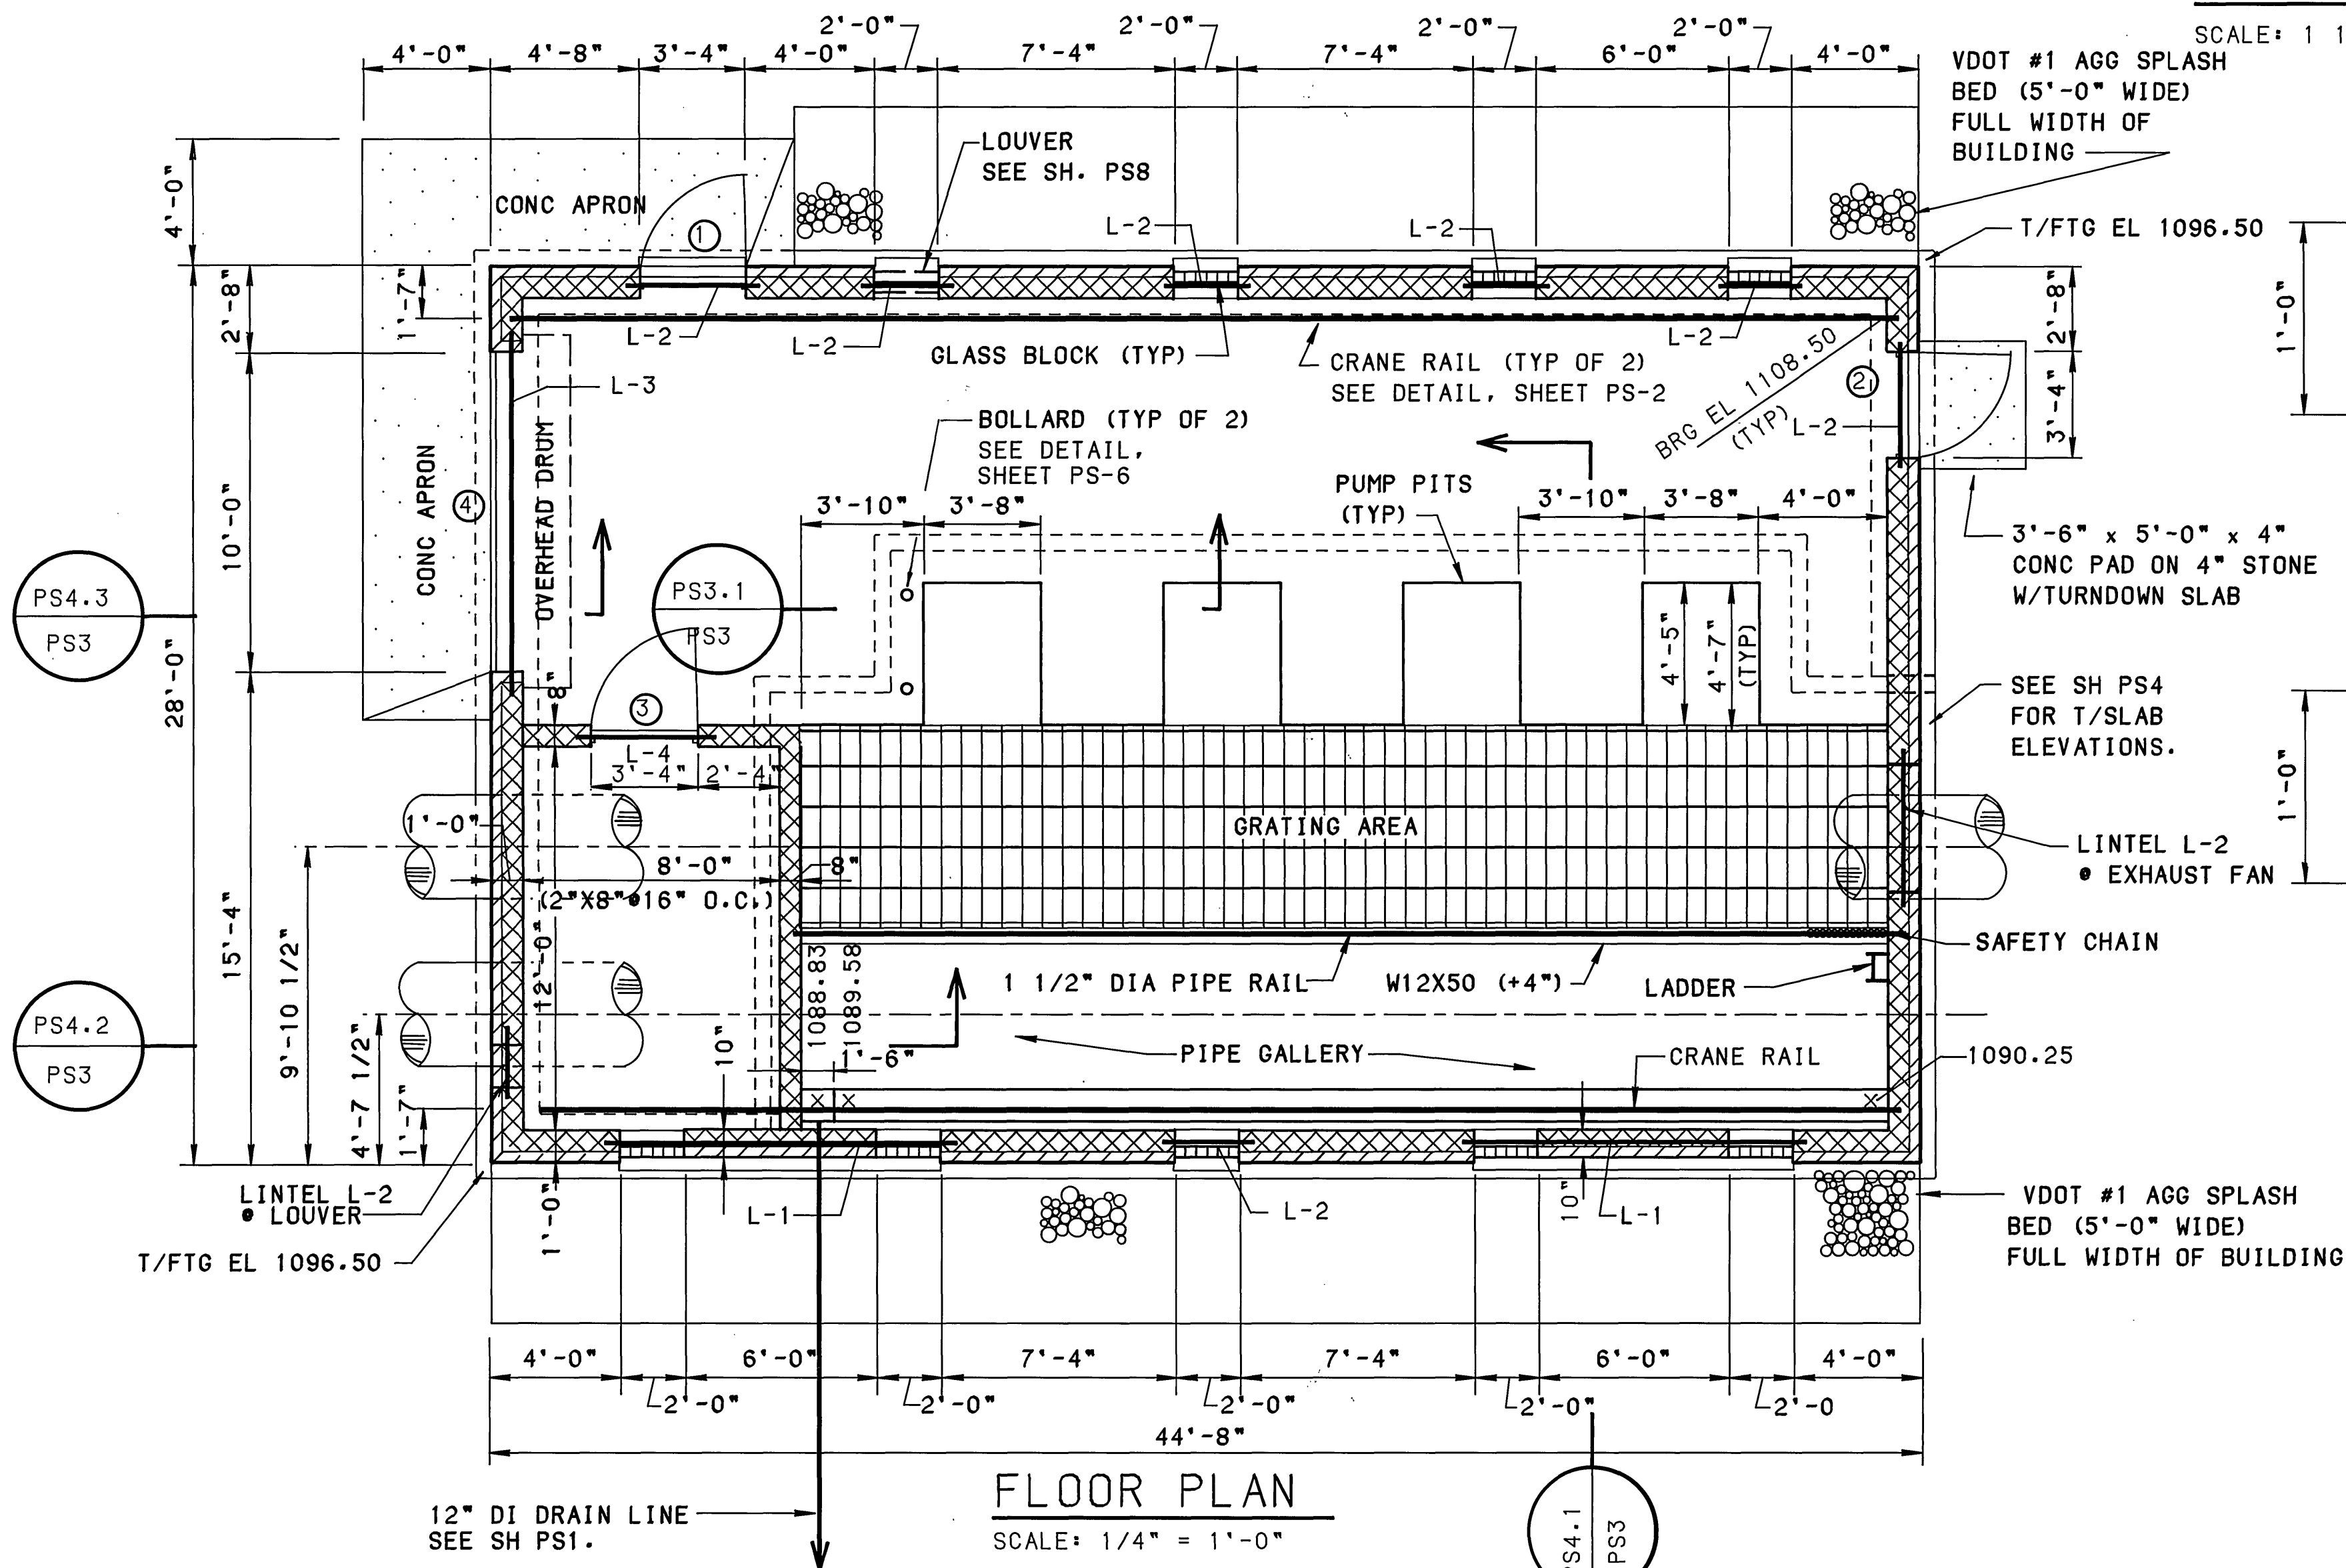


FLOOR PLAN

SCALE: 1/4" = 1'-0"


PS4.1

PS3

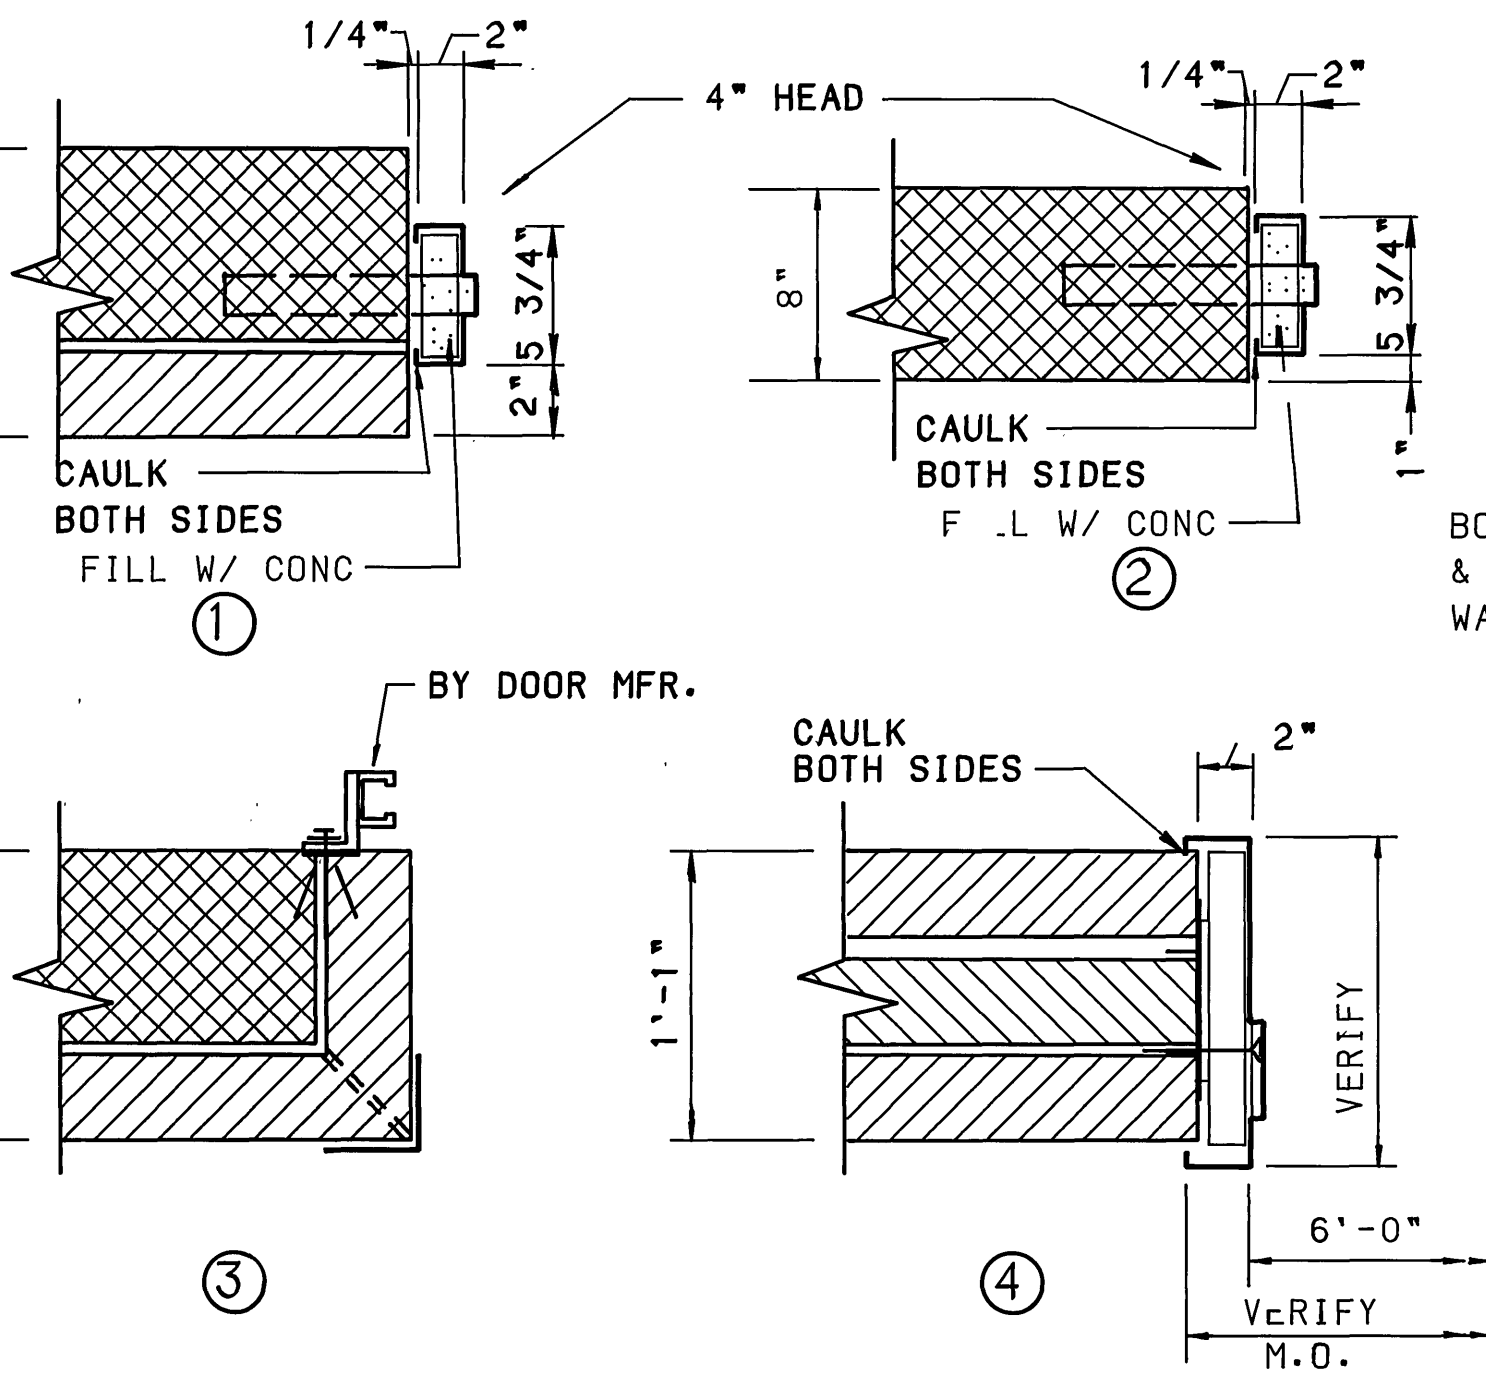

FRAME TYPES

SCALE: 1 1/2" = 1'-0"

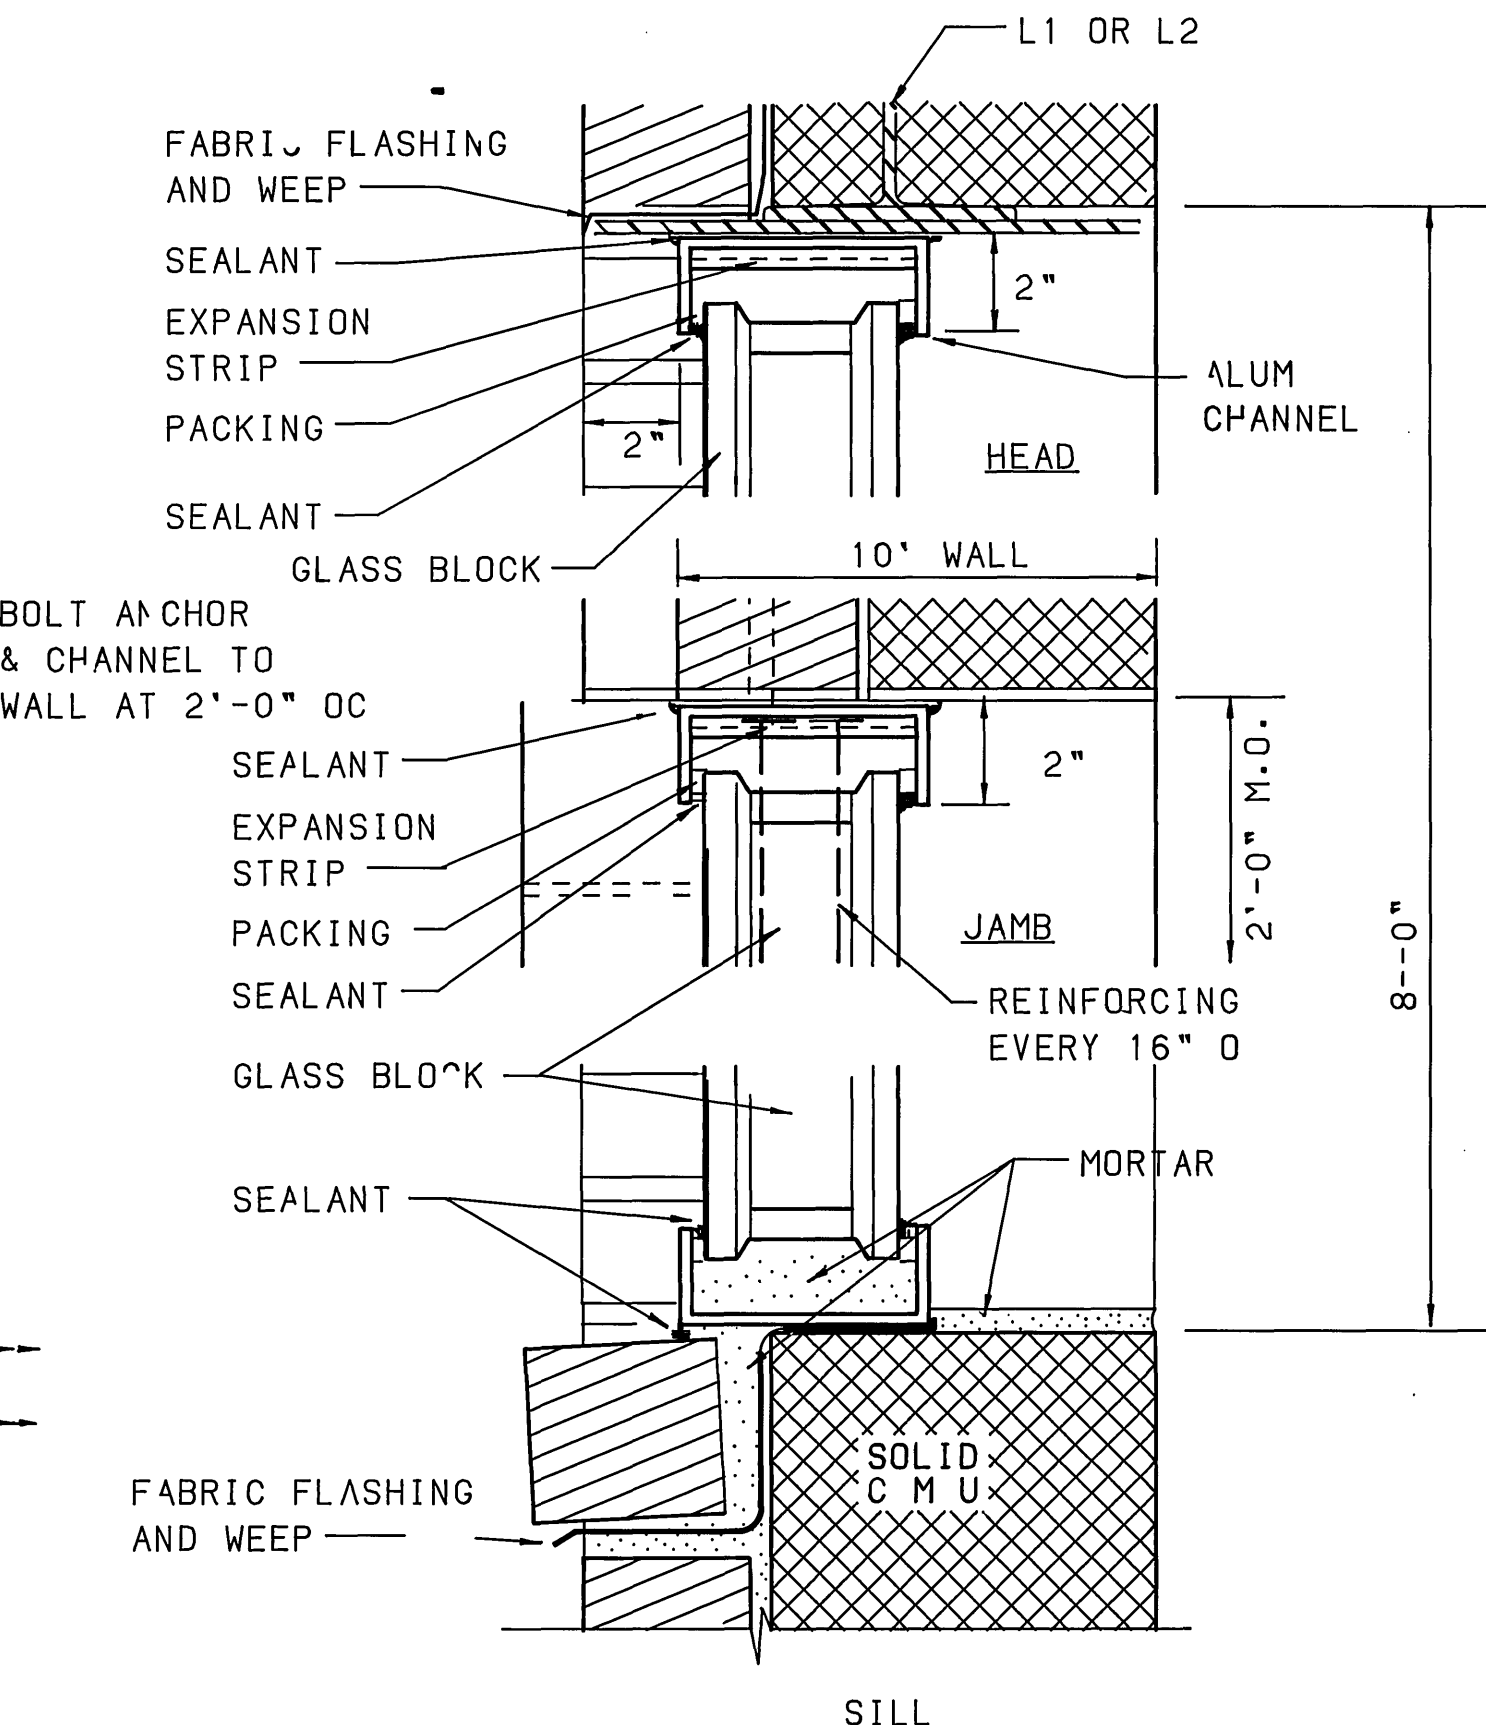

GLASS BLOCK DETAIL



SCALE: 3/8" = 1'-0"

RECORD DRAWING

MATTERN & CRAIG
CONSULTING ENGINEERS • SURVEYORS
ROANOKE VIRGINIA

ALVORD, BURDICK & HOWSON
ENGINEERS CHICAGO

DESIGNED:
RWB
DRAWN:
TLM/FMP
CHECKED:
SWH

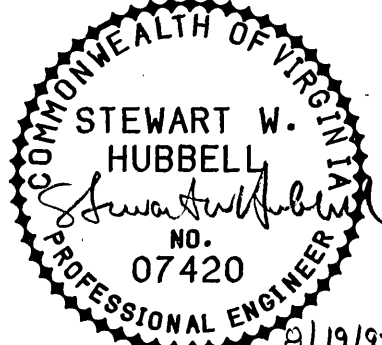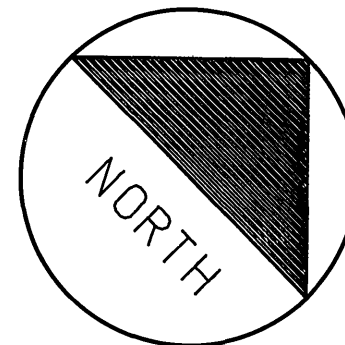

REV	DATE	DESCRIPTION	BY	APP.
1	8/92	MISCELLANEOUS	DSG	RWB

CARVINS COVE FILTER PLANT IMPROVEMENTS - PHASE I

ROANOKE, VIRGINIA

LOW LIFT PUMP STATION
ARCHITECTURAL PLAN AND SECTIONS

DATE
MARCH 1992
COMM. NO.
1138
SHEET
PS3