
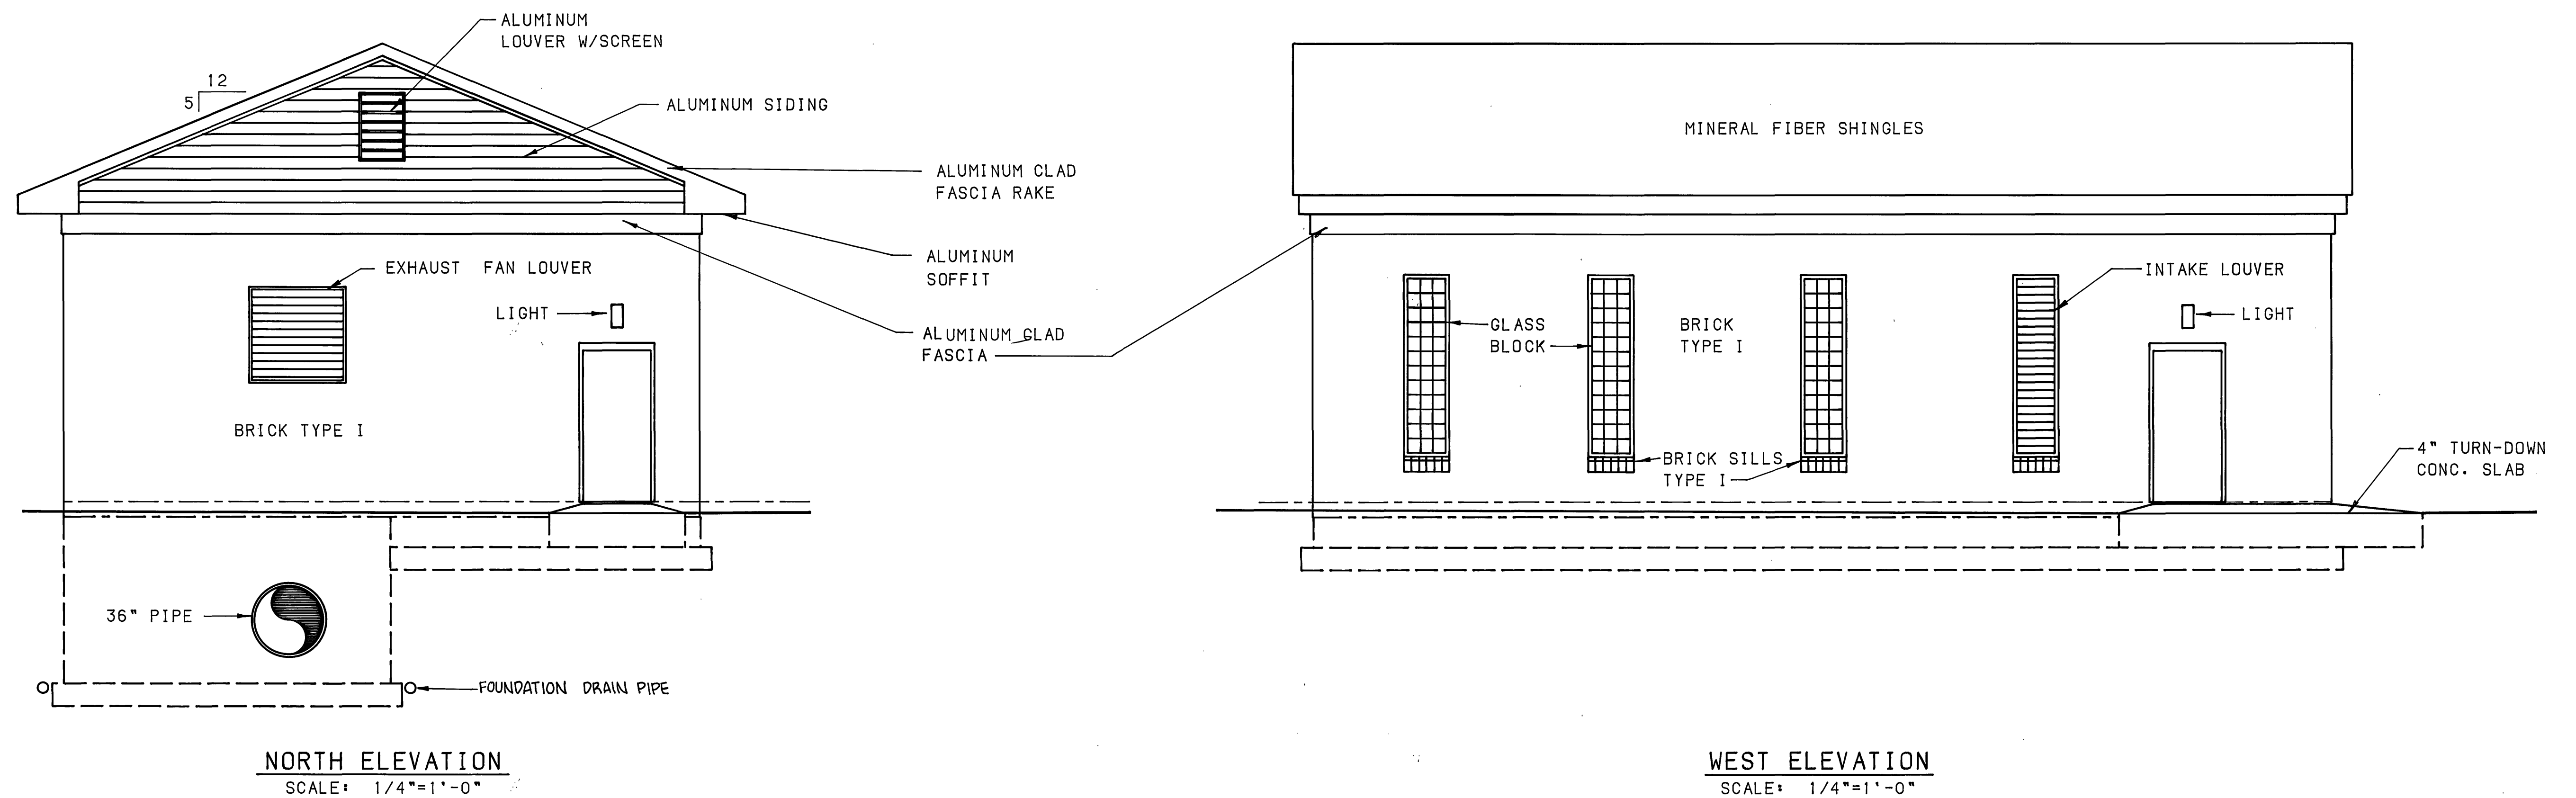
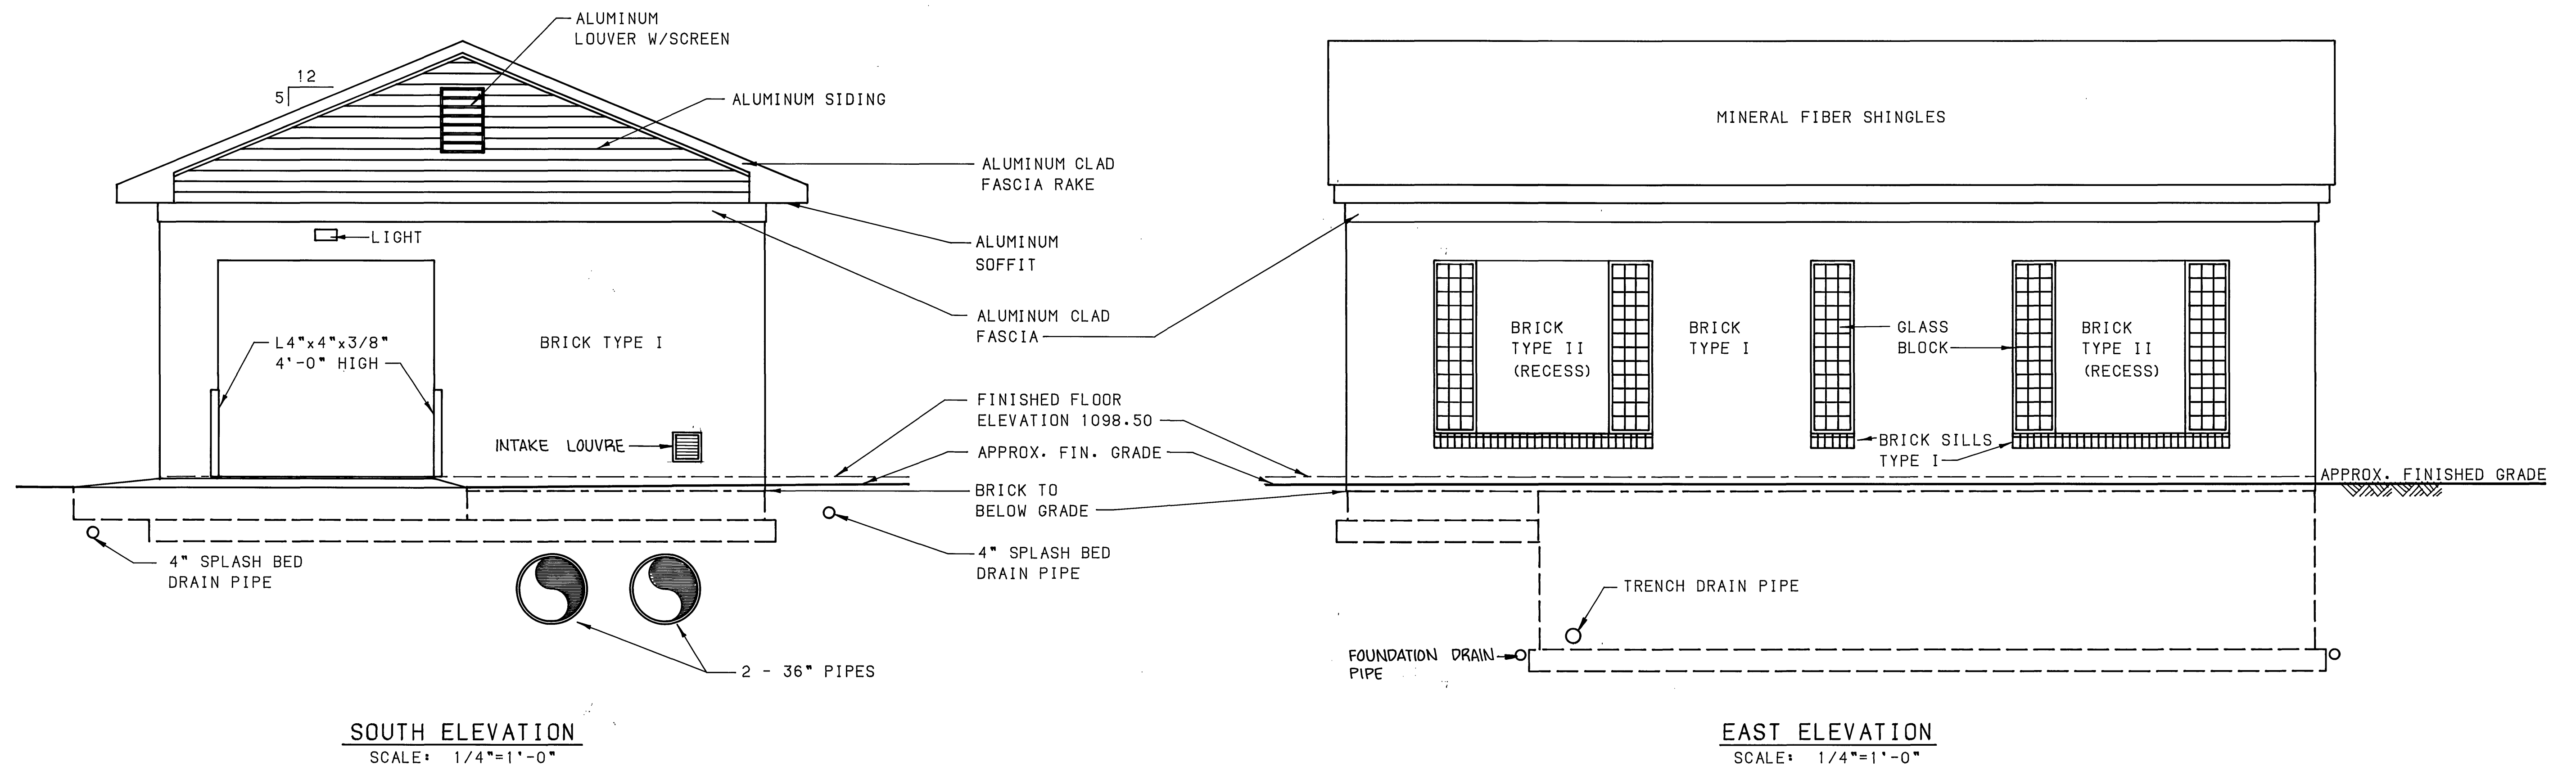


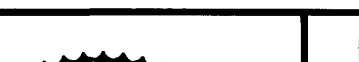

RECORD DRAWING

MATTERN & CRAIG CONSULTING ENGINEERS • SURVEYORS ROANOKE VIRGINIA	DESIGNED:		REV	DATE	DESCRIPTION	BY	APP.	CARVINS COVE FILTER PLANT IMPROVEMENTS - PHASE I ROANOKE, VIRGINIA	DATE MARCH 1992	
	RWB		1	8/92	MISC.	TAM	RWB		COMM. NO. 1138	
ALVORD, BURDICK & HOWSON ENGINEERS CHICAGO	DRAWN:		DSG						LOW LIFT PUMP STATION ELEVATIONS	SHEET
	CHECKED:		SWH							PS5