


NOTE: BARS INDICATED ARE NOT REQ'D @ OPENINGS OF 7" OR LESS

BARS. MIN 1-#5 EA SIDE, EA


FACE, TYP EA DIRECTION

TYPICAL SLAB OPENING DETAIL

NOT TO SCALE

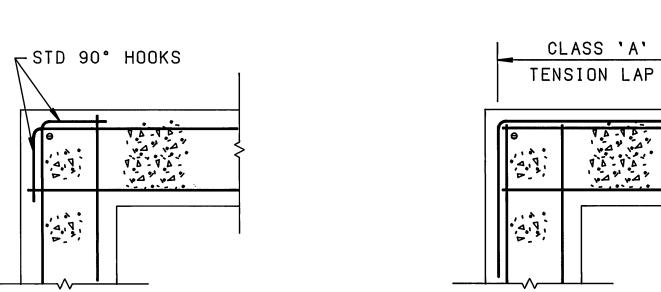


DOUBLE CURTAIN CORNER DETAIL NOT TO SCALE

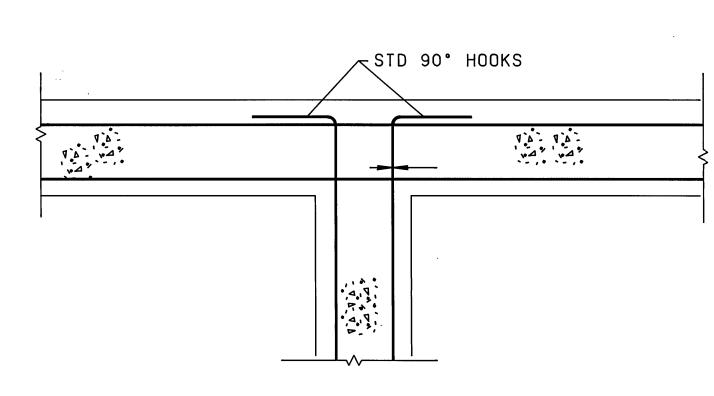

CLASS 'A'


INTERSECTION DETAIL

NOT TO SCALE

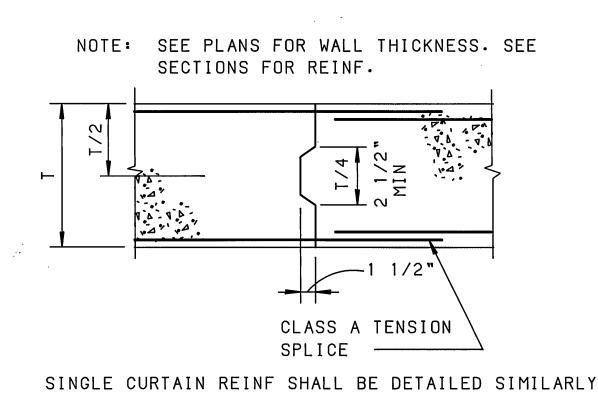


TYPICAL WALL CONSTRUCTION JOINT

NOT TO SCALE

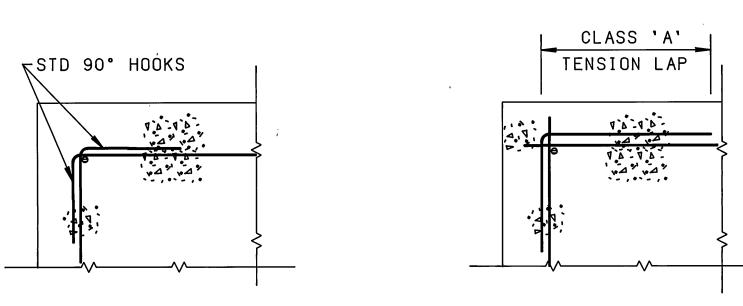


## CURTAIN CORNER DETAIL NOT TO SCALE

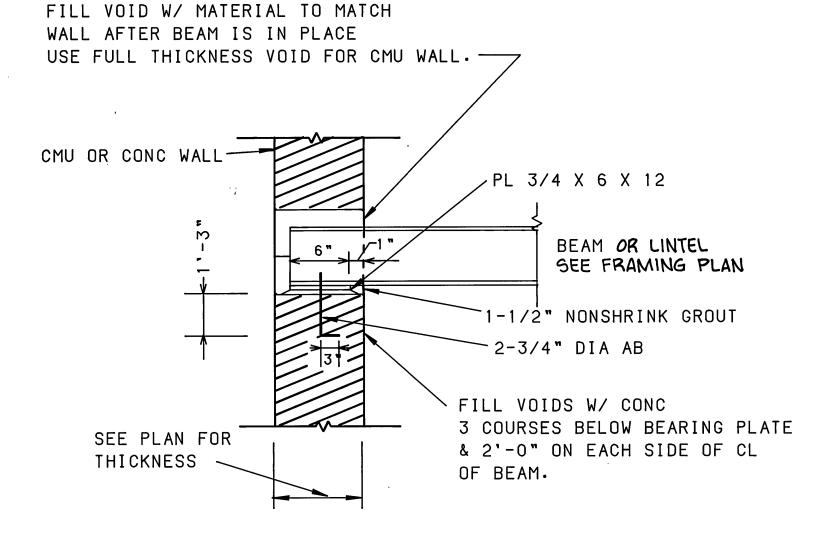


## TYPICAL BEARING PLATE DETAIL

NOT TO SCALE

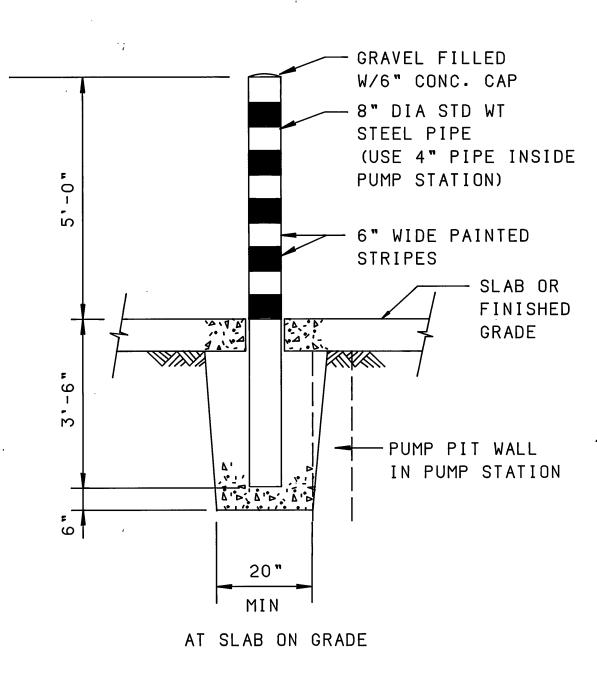


BOLLARD DETAIL

NOT TO SCALE

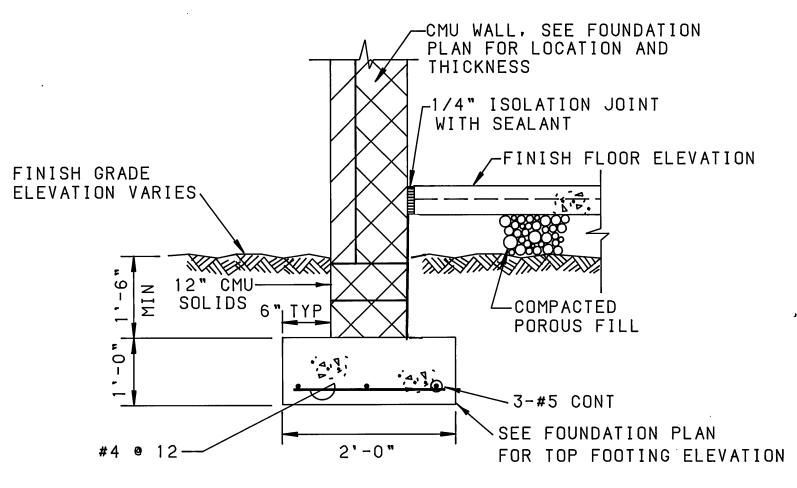


## TYPICAL EXTERIOR WALL FOOTING

NOT TO SCALE

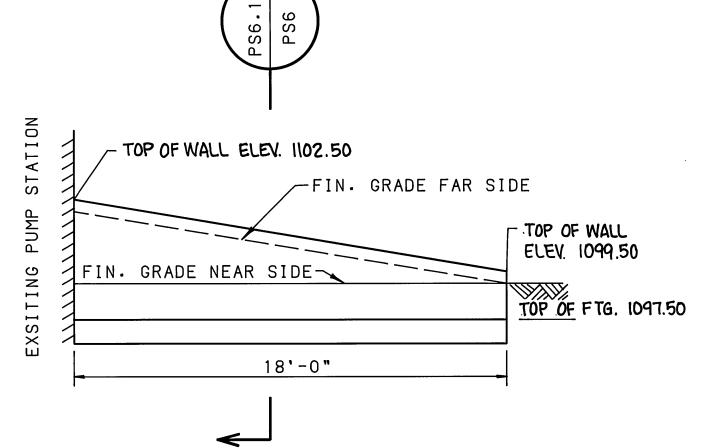

## RETAINING WALL - ELEVATION

NOT TO SCALE

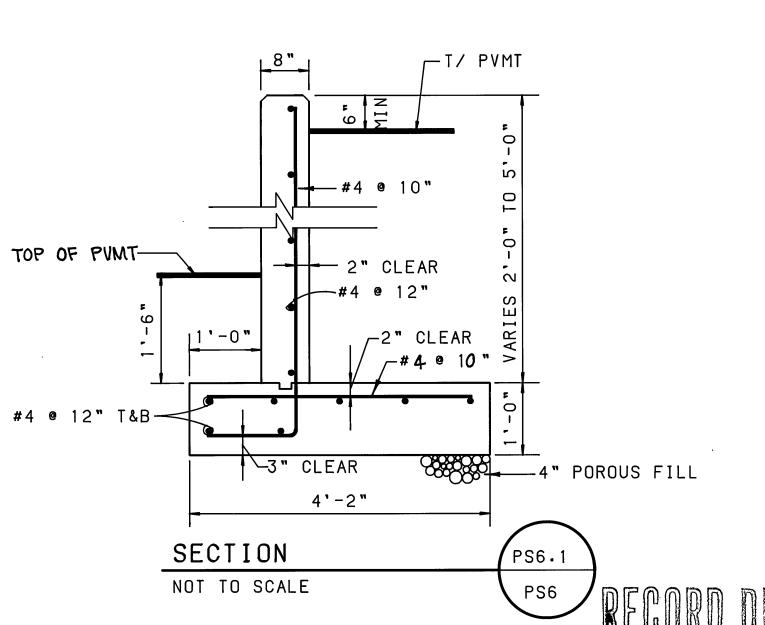

MATTERN & CRAIG	DESIGNED:
CONSULTING ENGINEERS • SURVEYORS	RWB
ROANOKE VIRGINIA	DRAWN:
ALVORD, BURDICK & HOWSON	DSG
ALVOID, DONDION & HOWSON	CHECKED:
ENGINEERS CHICAGO	SWH

****	REV	DATE	DESCRIPTION	BY	APP.	ے ا
LALTH OF A	1	8/92	MISC.	TAM	RWB	١٢
STEWART W			•			
9 HUBBELL						<u> </u>
No. 07420						
SSIONAL ENGLIPS 4/3/92	•					
*********						

DATE CARVINS COVE FILTER PLANT IMPROVEMENTS - PHASE ] MARCH 1992 COMM. NO. ROANOKE, VIRGINIA 1138 SHEET LOW LIFT PUMP STATION

TYPICAL DETAILS

PS6