



UNIT HEATERS

<u>MARK</u>	<u>KW</u>	<u>VOLTAGE</u>	<u>MODEL</u>
EUH-20	10.0	208	MUH-10-8
EUH-21	10.0	480	MUH-10-4

FANS

MARK	CFM	SP	HP	MANUFACTURER	MODEL	NOTE
EF-29	1720	0.03	1/5	FASCO	RV16	
EF-30	8200	0.25	3/4	GREENHECK	SPF36	1
EF-31	332	0.25	1/25	GREENHECK	SDE-10-32-D	2
EF-32	2920	0.25	1/4	GREENHECK	SDE-20-24-B	3

1. PROVIDE WITH MOTORIZED DAMPER, WALL MOUNT COLLAR, OSHA MOTOR SIDE GUARD, 2 SPEED MOTOR, TRANSFORMER & 2 STAGE WALL MOUNTED THERMOSTAT (120 V).
2. PROVIDE WITH WALL MOUNT COLLAR, OSHA MOTOR SIDE GUARD, OSHA OPPOSITE MOTOR SIDE GUARD, WALL MOUNTED THERMOSTAT.
3. PROVIDE WITH MOTORIZED DAMPER, WALL MOUNT COLLAR, OSHA MOTOR SIDE GUARD, 2 SPEED MOTOR & 2 STAGE WALL MOUNTED THERMOSTAT (120 V).

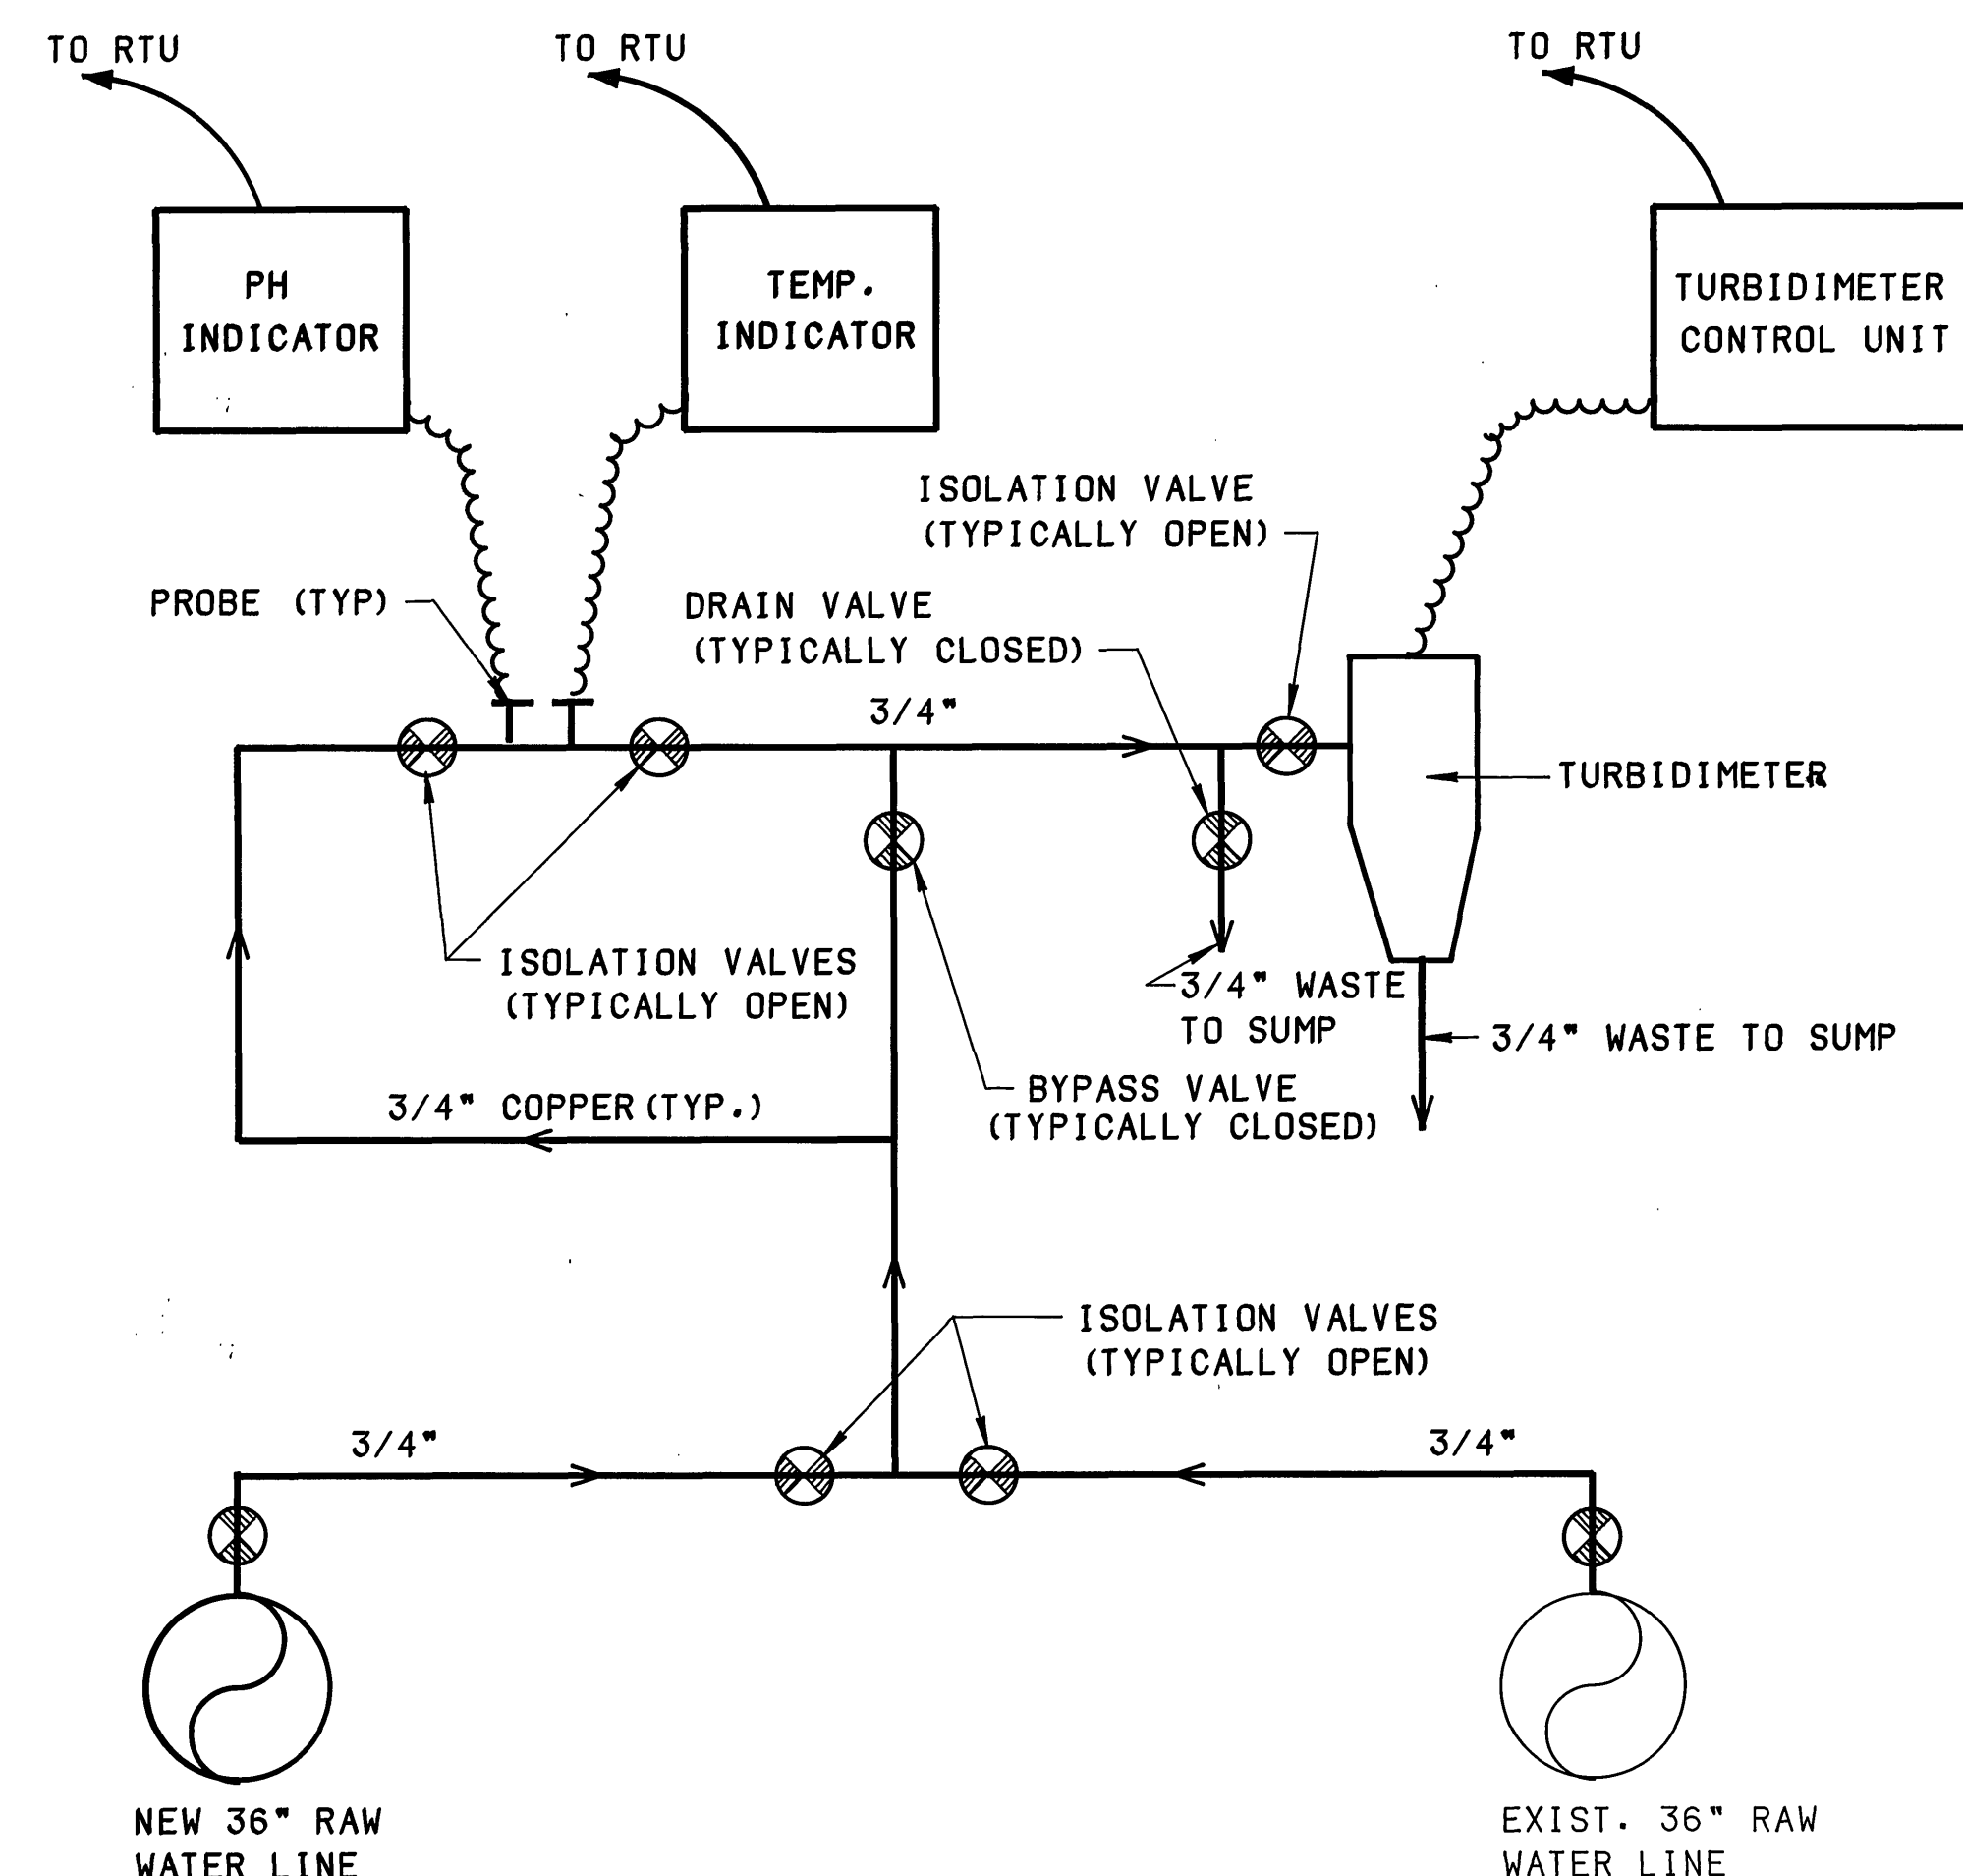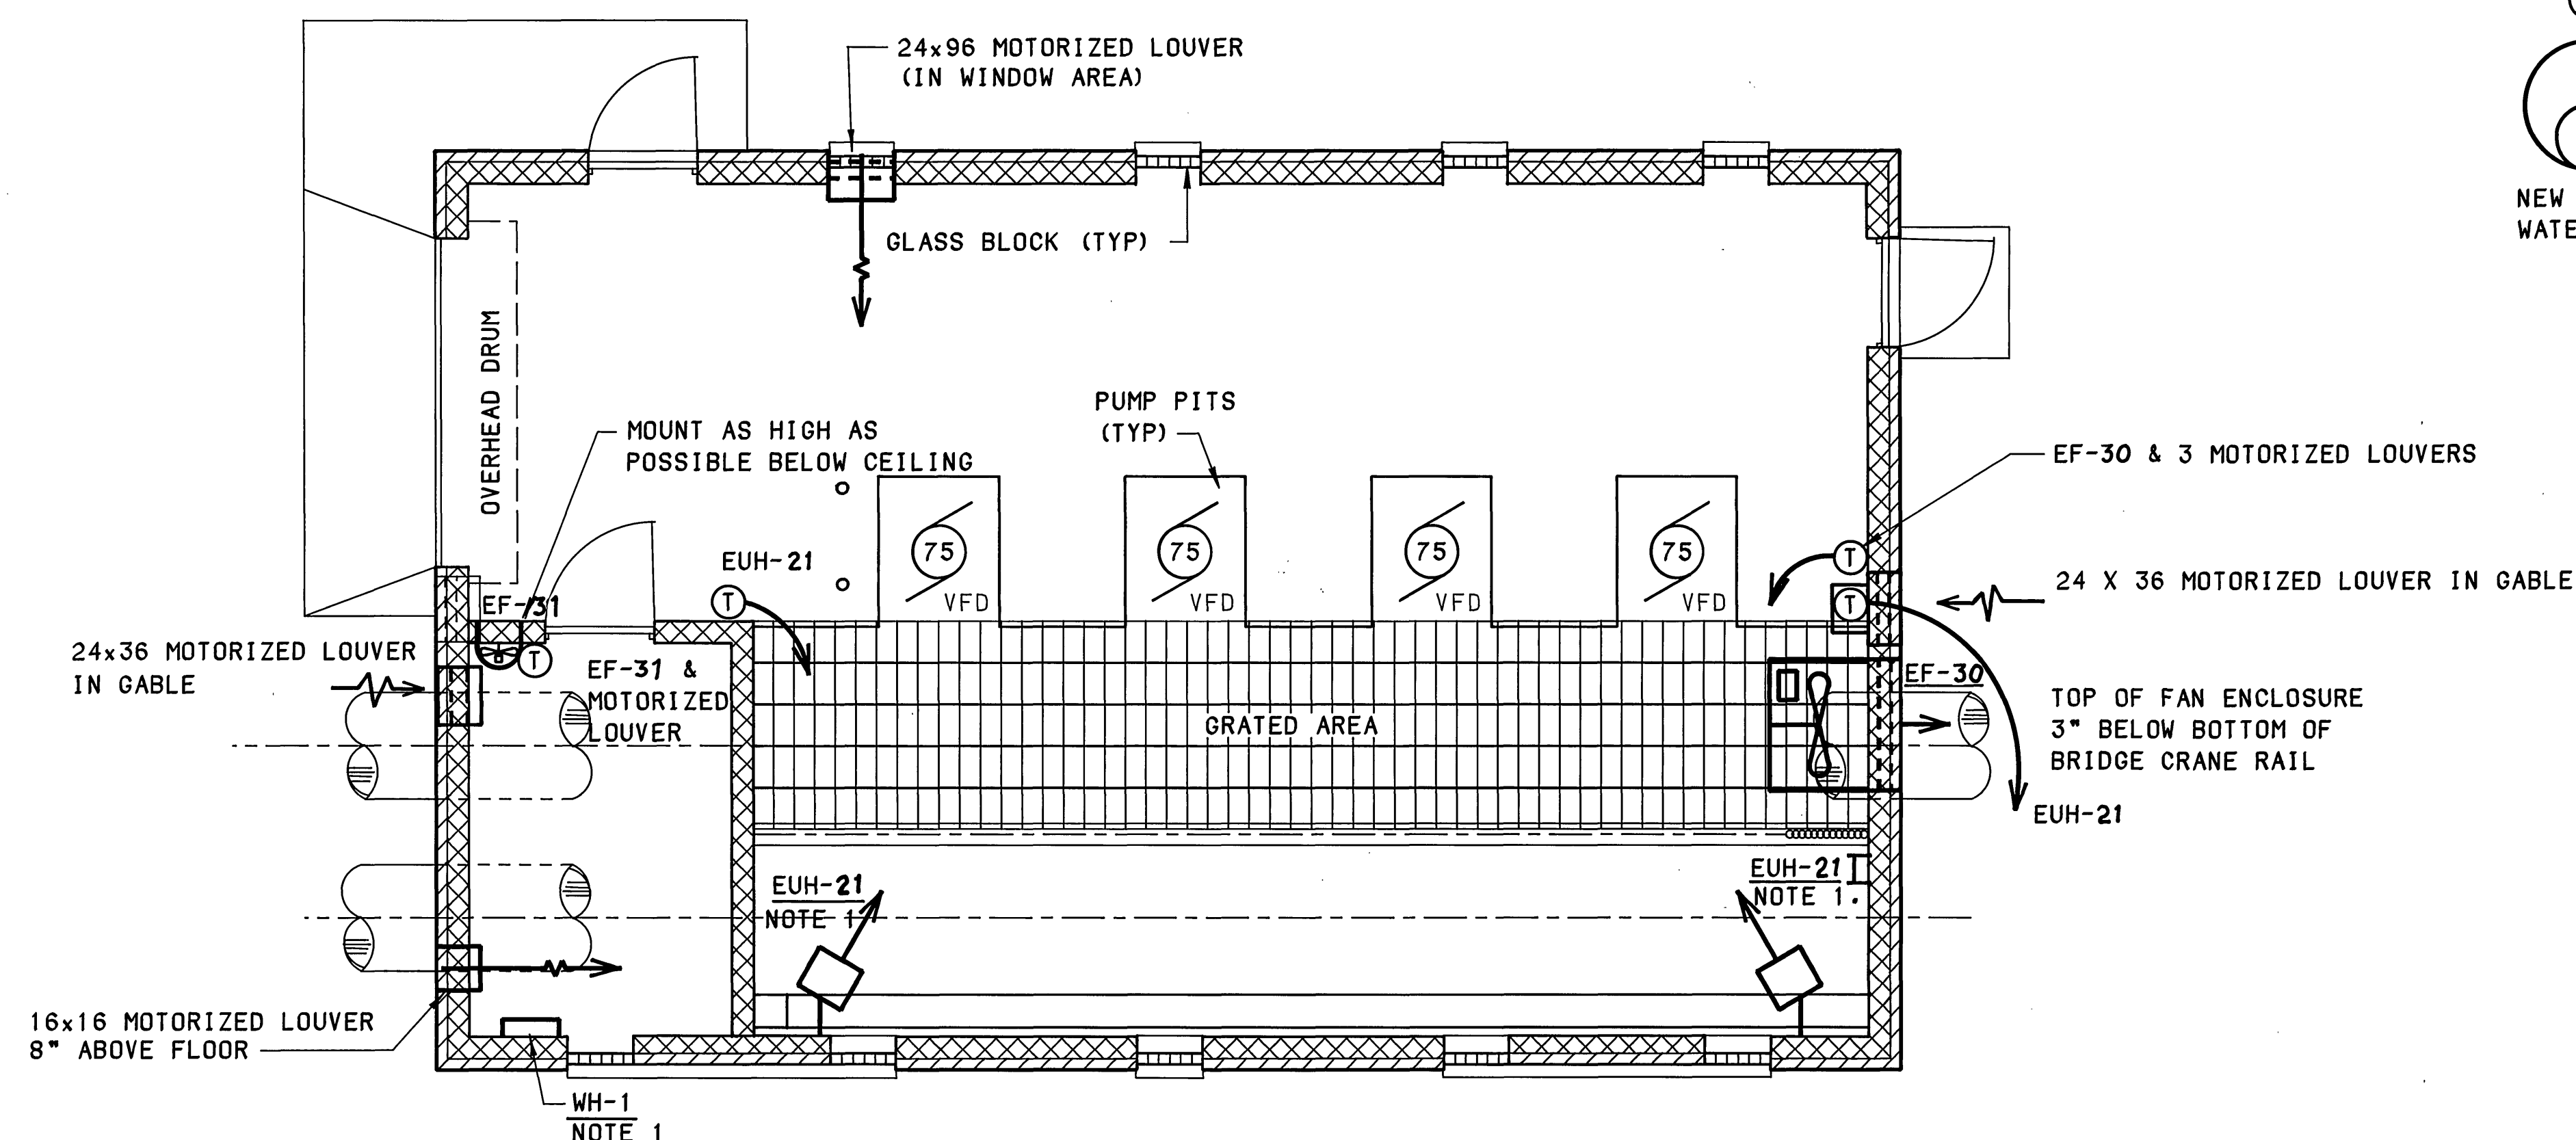

RAW WATER MONITORING SCHEMATIC

NOT TO SCALE



1. PROVIDED UNDER DIVISION 16.

(SEE SHEET M12)

MATTERN & CRAIG
CONSULTING ENGINEERS • SURVEYORS
ROANOKE VIRGINIA

ALVORD, BURDICK & HOWSON
ENGINEERS CHICAGO

SWH

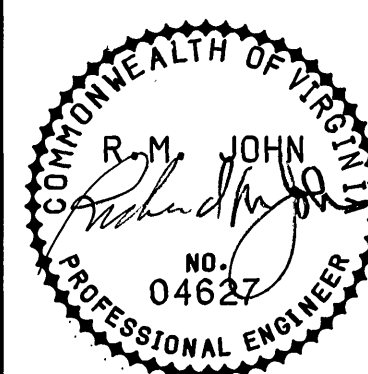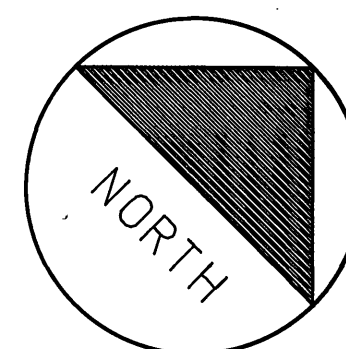

REV	DATE	DESCRIPTION	BY	AP
1	8/92	MISCELLANEOUS	DSG	RW

LOW LIFT PUMP STATION MECHANICAL

DATE	MARCH 1992
COMM. NO.	1138
SHEET	PS8