


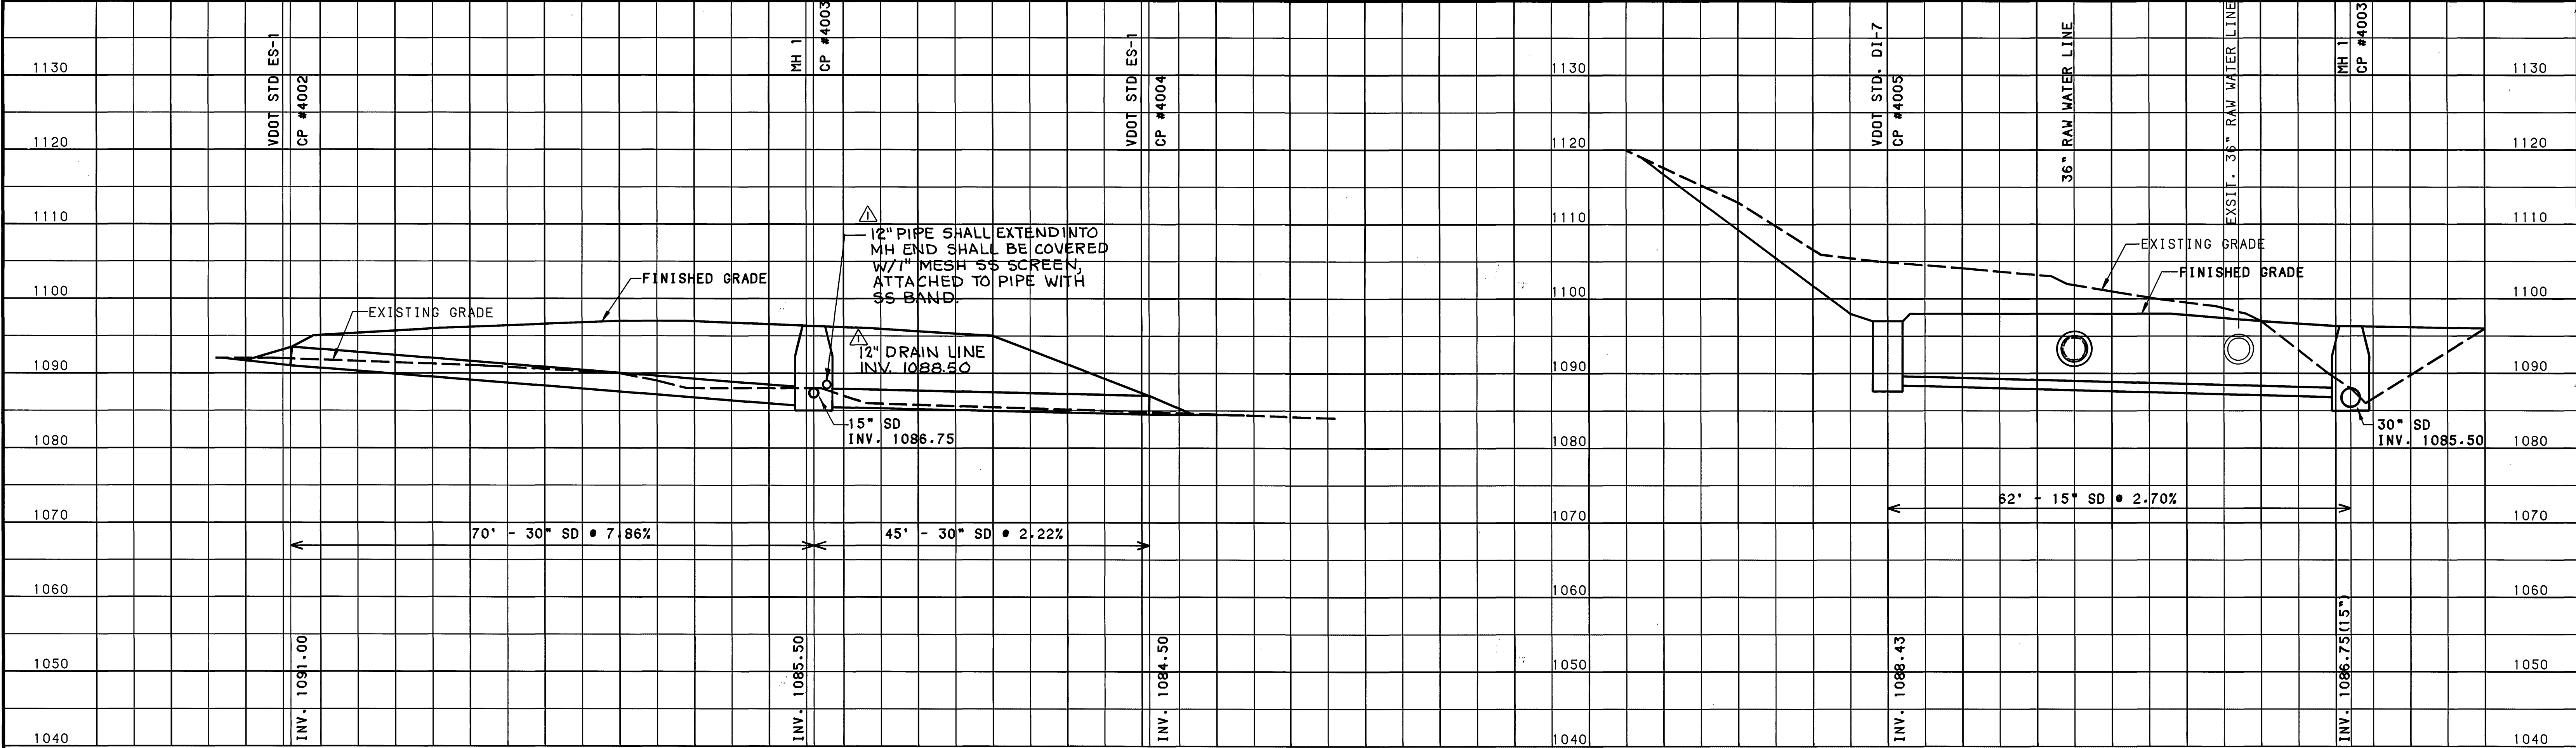

SCALE: 1"=10' VERT.
1"=10' HORZ.

RECORD DRAWING

MATTERN & CRAIG CONSULTING ENGINEERS • SURVEYORS ROANOKE VIRGINIA	DESIGNED:		REV	DATE	DESCRIPTION	BY	APP.	CARVINS COVE FILTER PLANT IMPROVEMENTS - PHASE I ROANOKE, VIRGINIA	DATE MARCH 1992
	DRAWN:		△	8/92	MISC.	JLJ	RWB		COMM. NO. 1138
ALVORD, BURDICK & HOWSON ENGINEERS CHICAGO	CHECKED:							LOW LIFT PUMP STATION STORM DRAIN PROFILES	SHEET PS10