

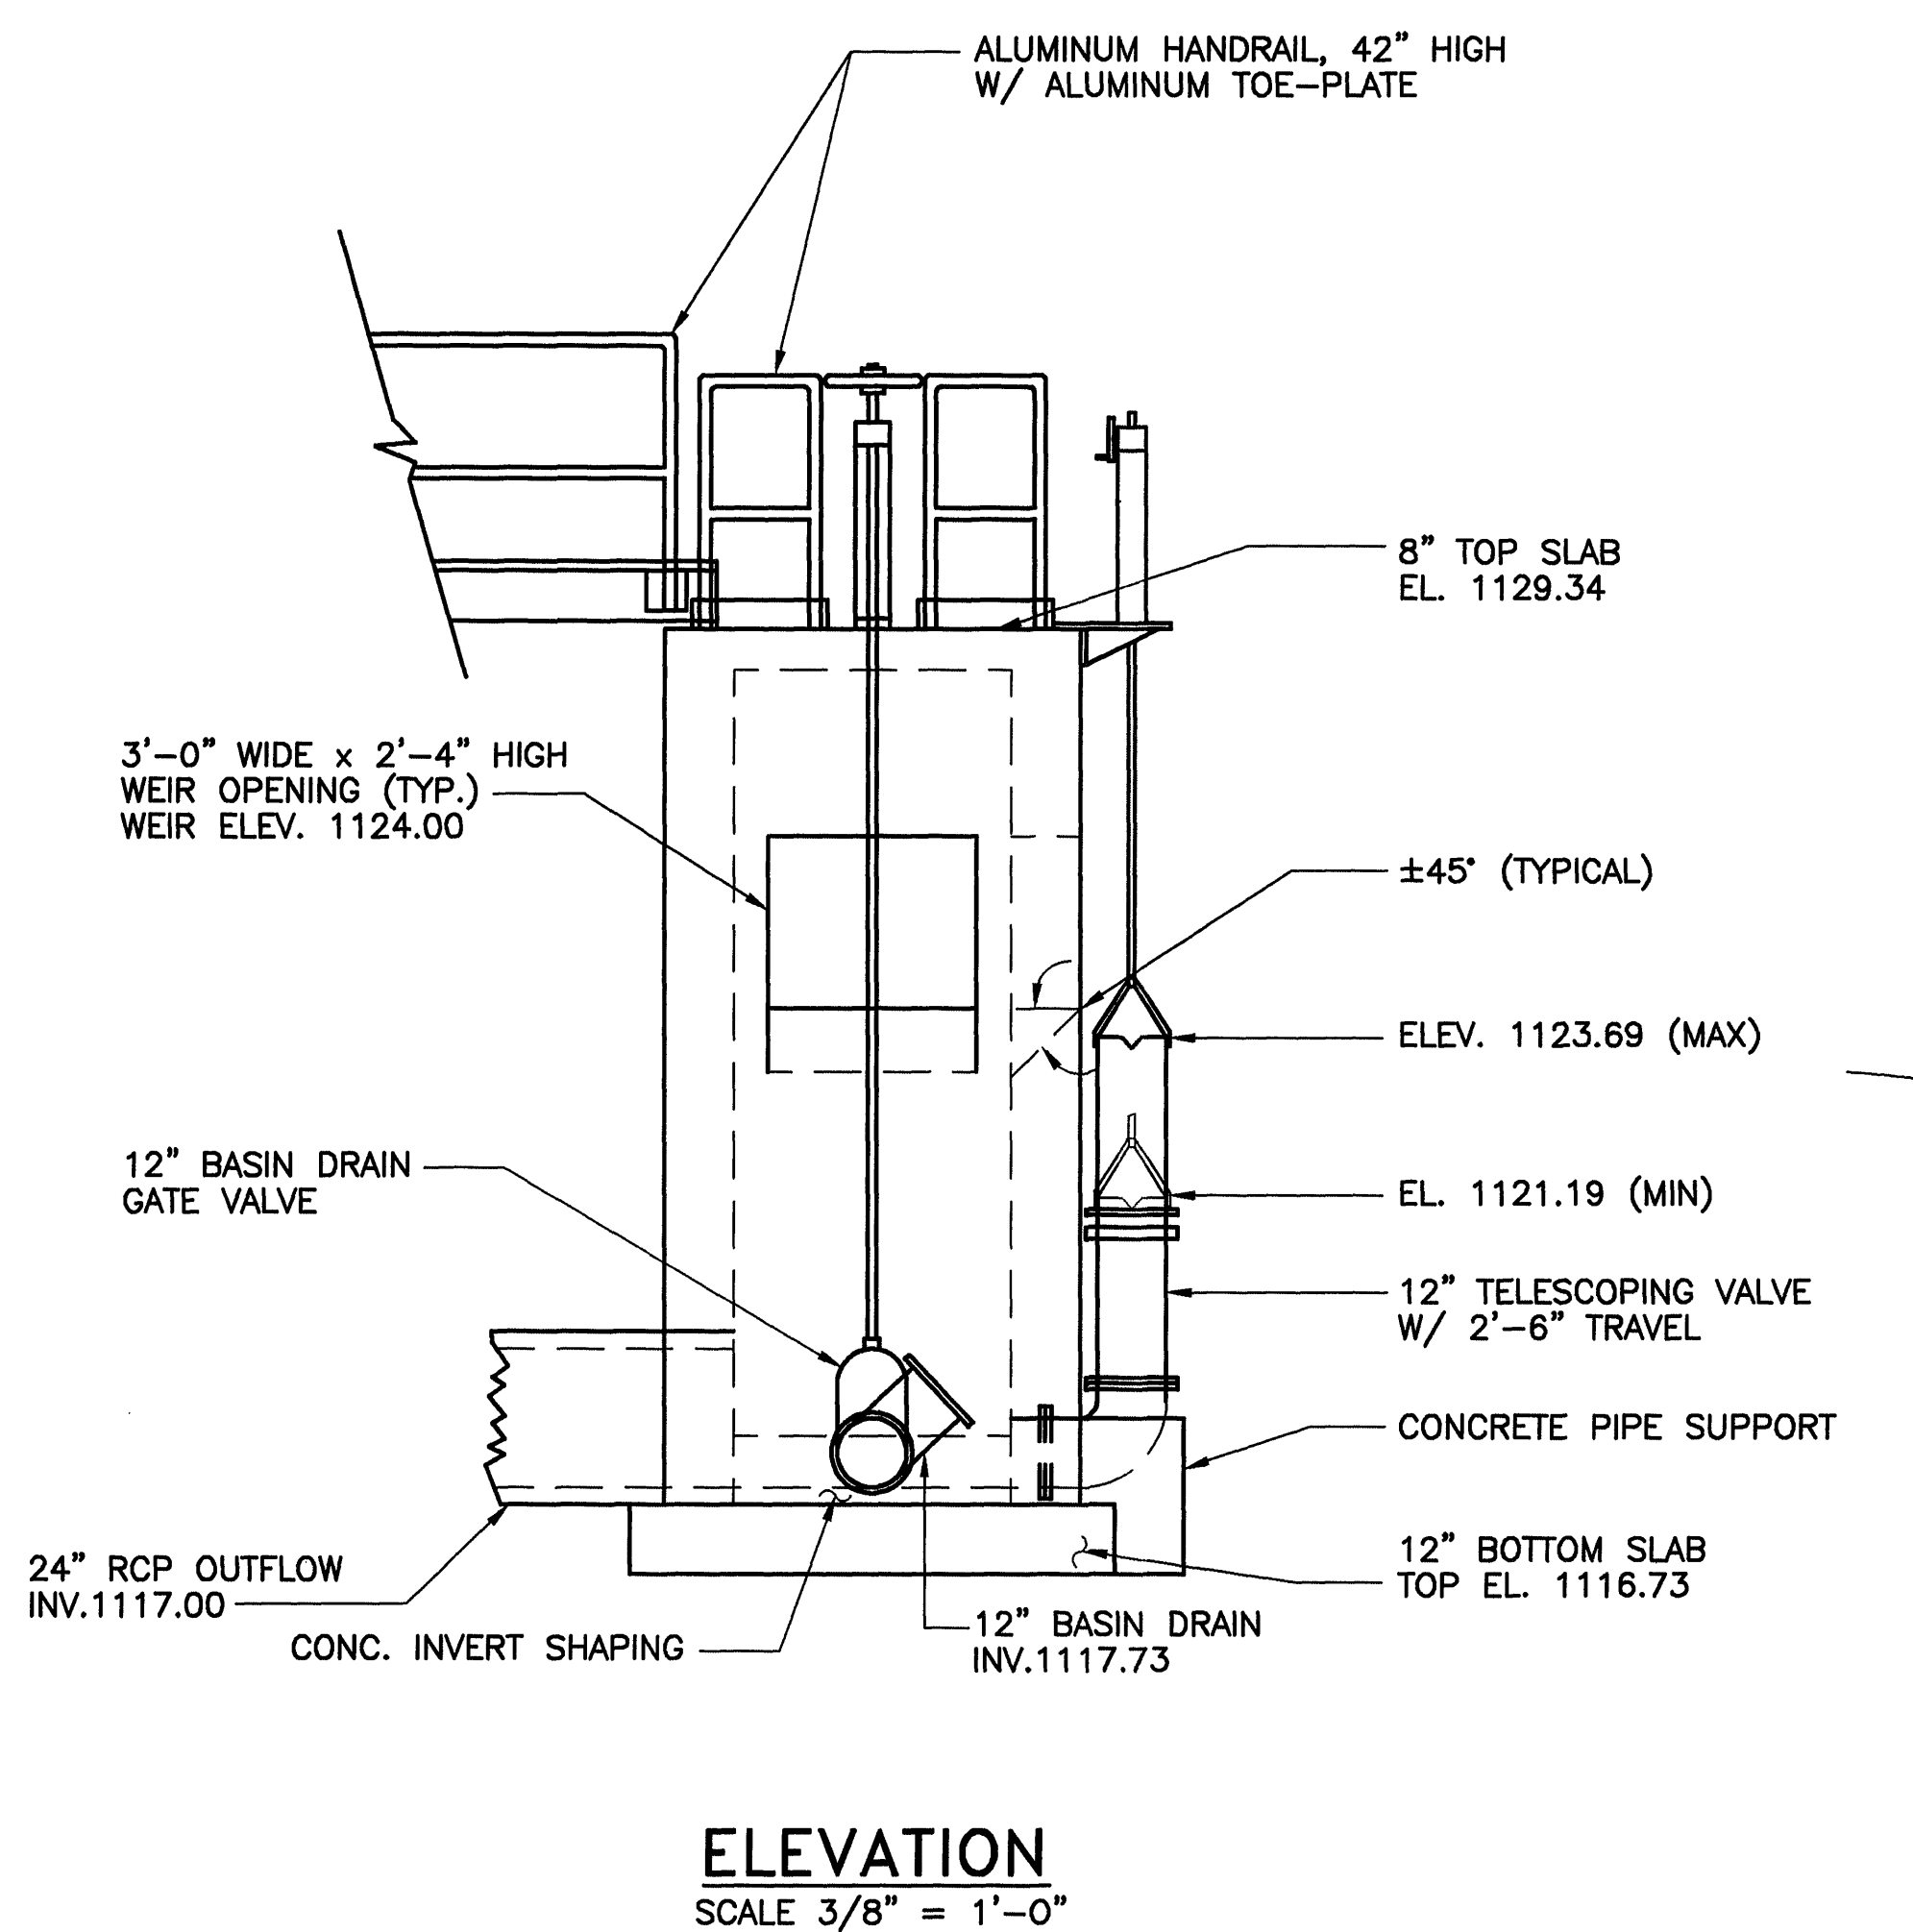


RECORD DRAWINGS
9-12-97

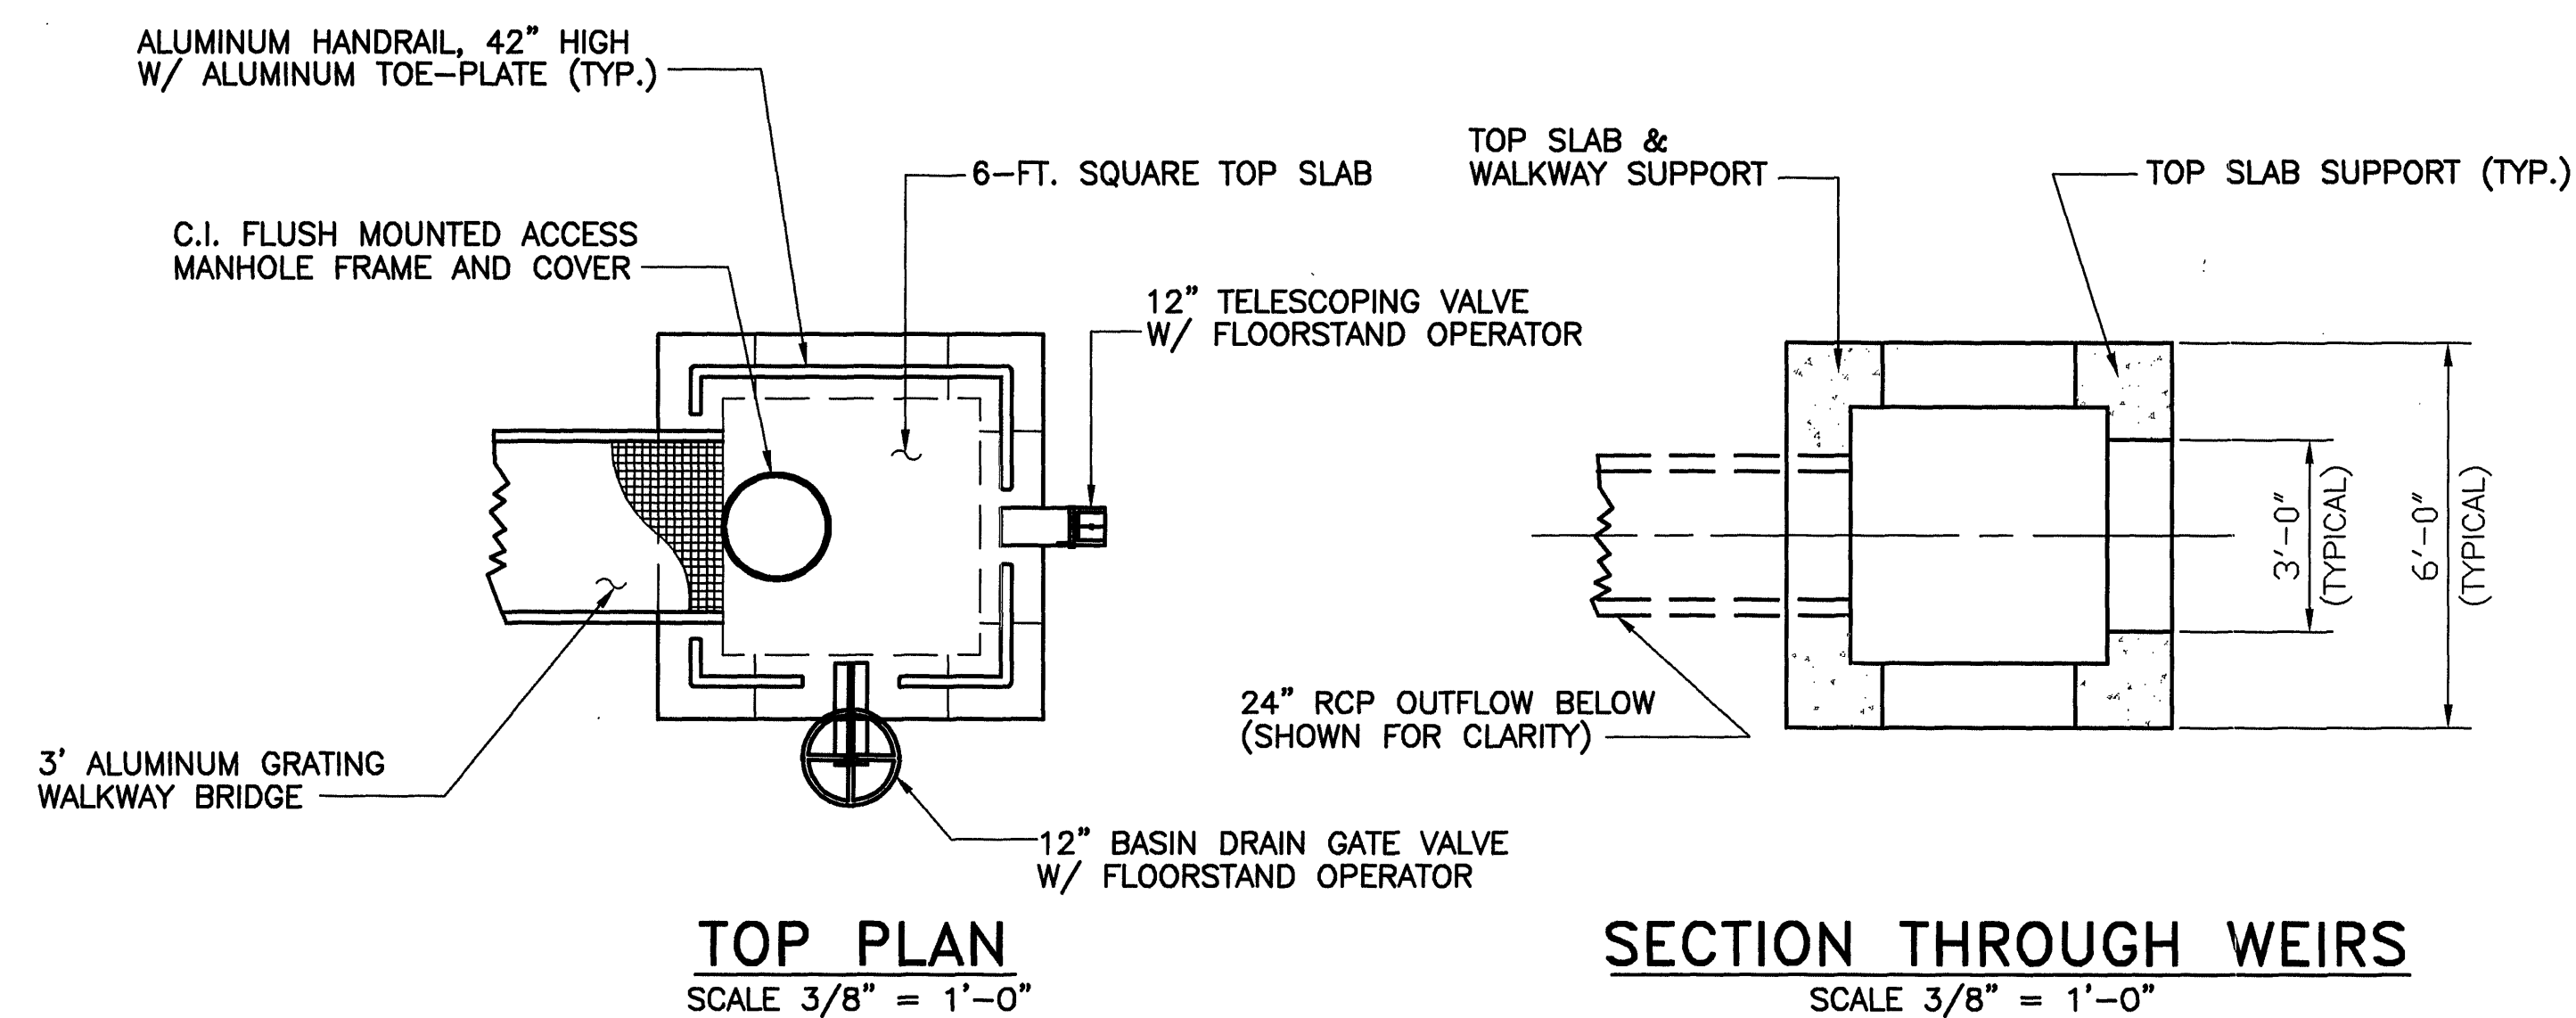

OUTLET STRUCTURE DETAILS

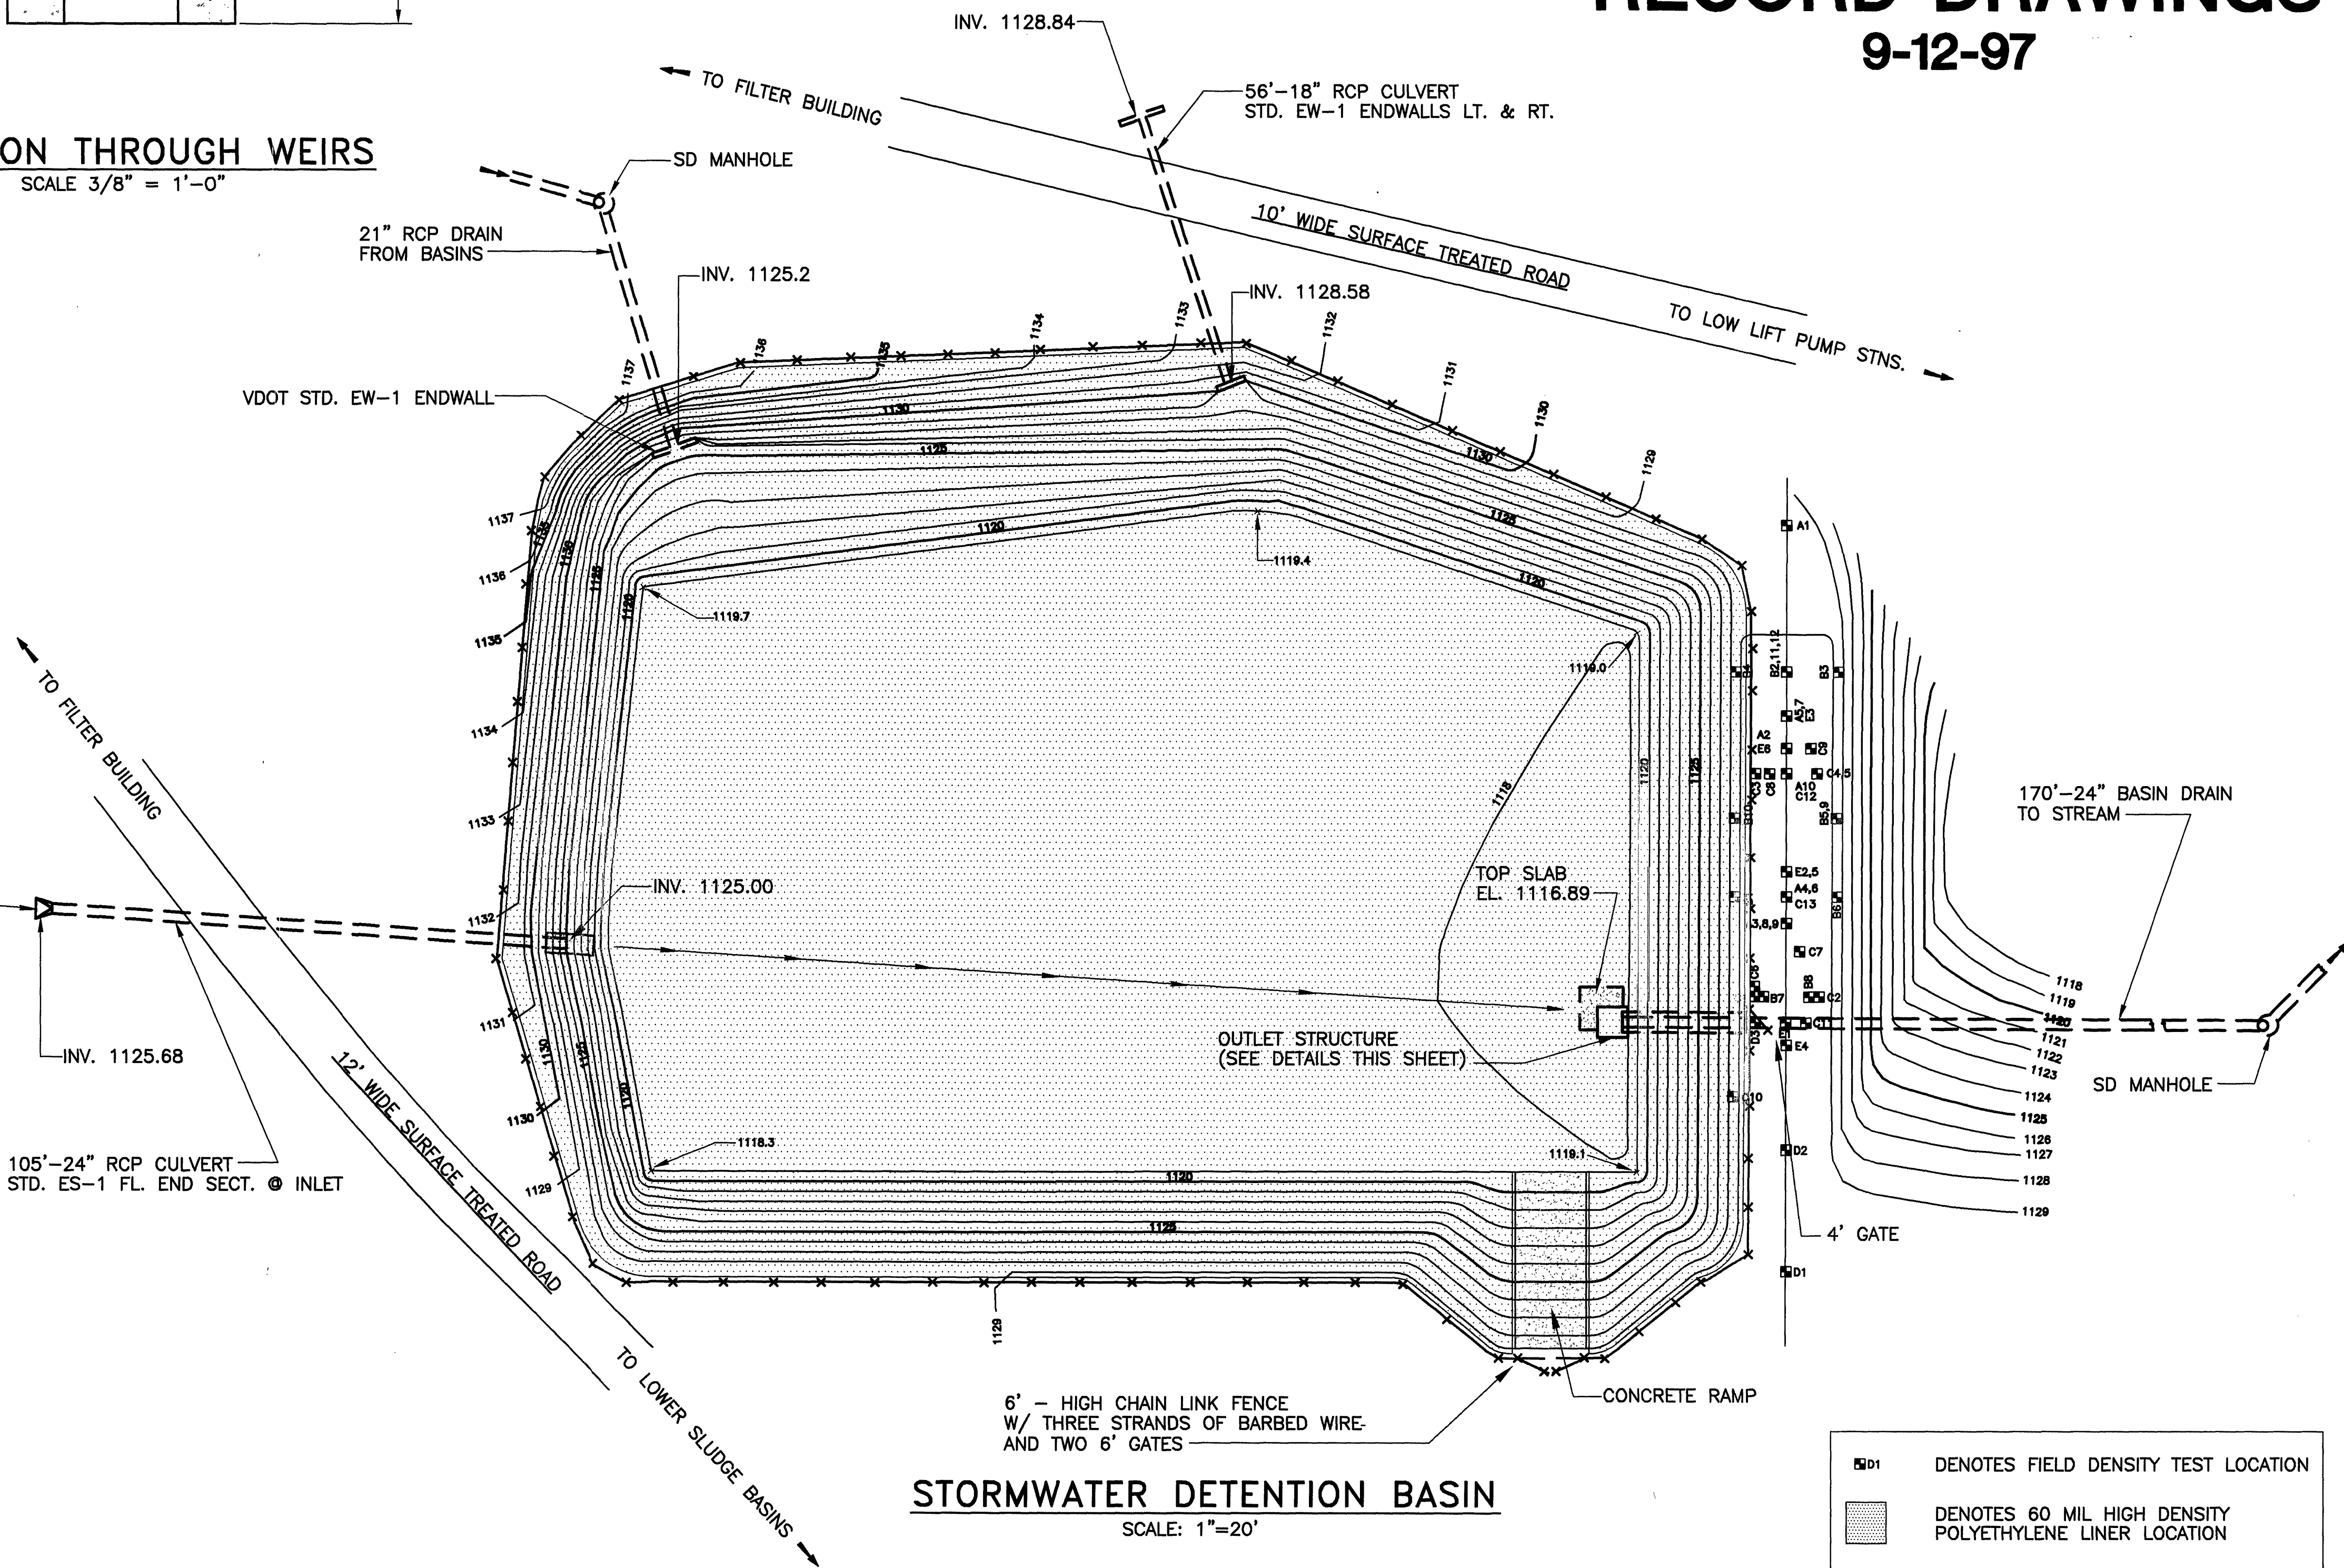

Mattern & Craig, Inc.
CONSULTING ENGINEERS • SURVEYORS
701 FIRST STREET, S.W.
ROANOKE, VIRGINIA 24016
(540) 345-9342
(540) 345-7691 FAX

DSGN	REV	DATE	DESCRIPTION	BY	APP
JMB					
BCB					
JMB					

CARVINS COVE FILTER PLANT IMPROVEMENTS, PHASE I

STORMWATER DETENTION BASIN

CITY OF ROANOKE, VIRGINIA

SCALE: AS SHOWN
COMM. NO. 1138
DATE: SEPT. 1997
SHEET 1 OF 1

S:\dms\1128k\bas\in\ab Wed Oct 15 14:36:03 1997