



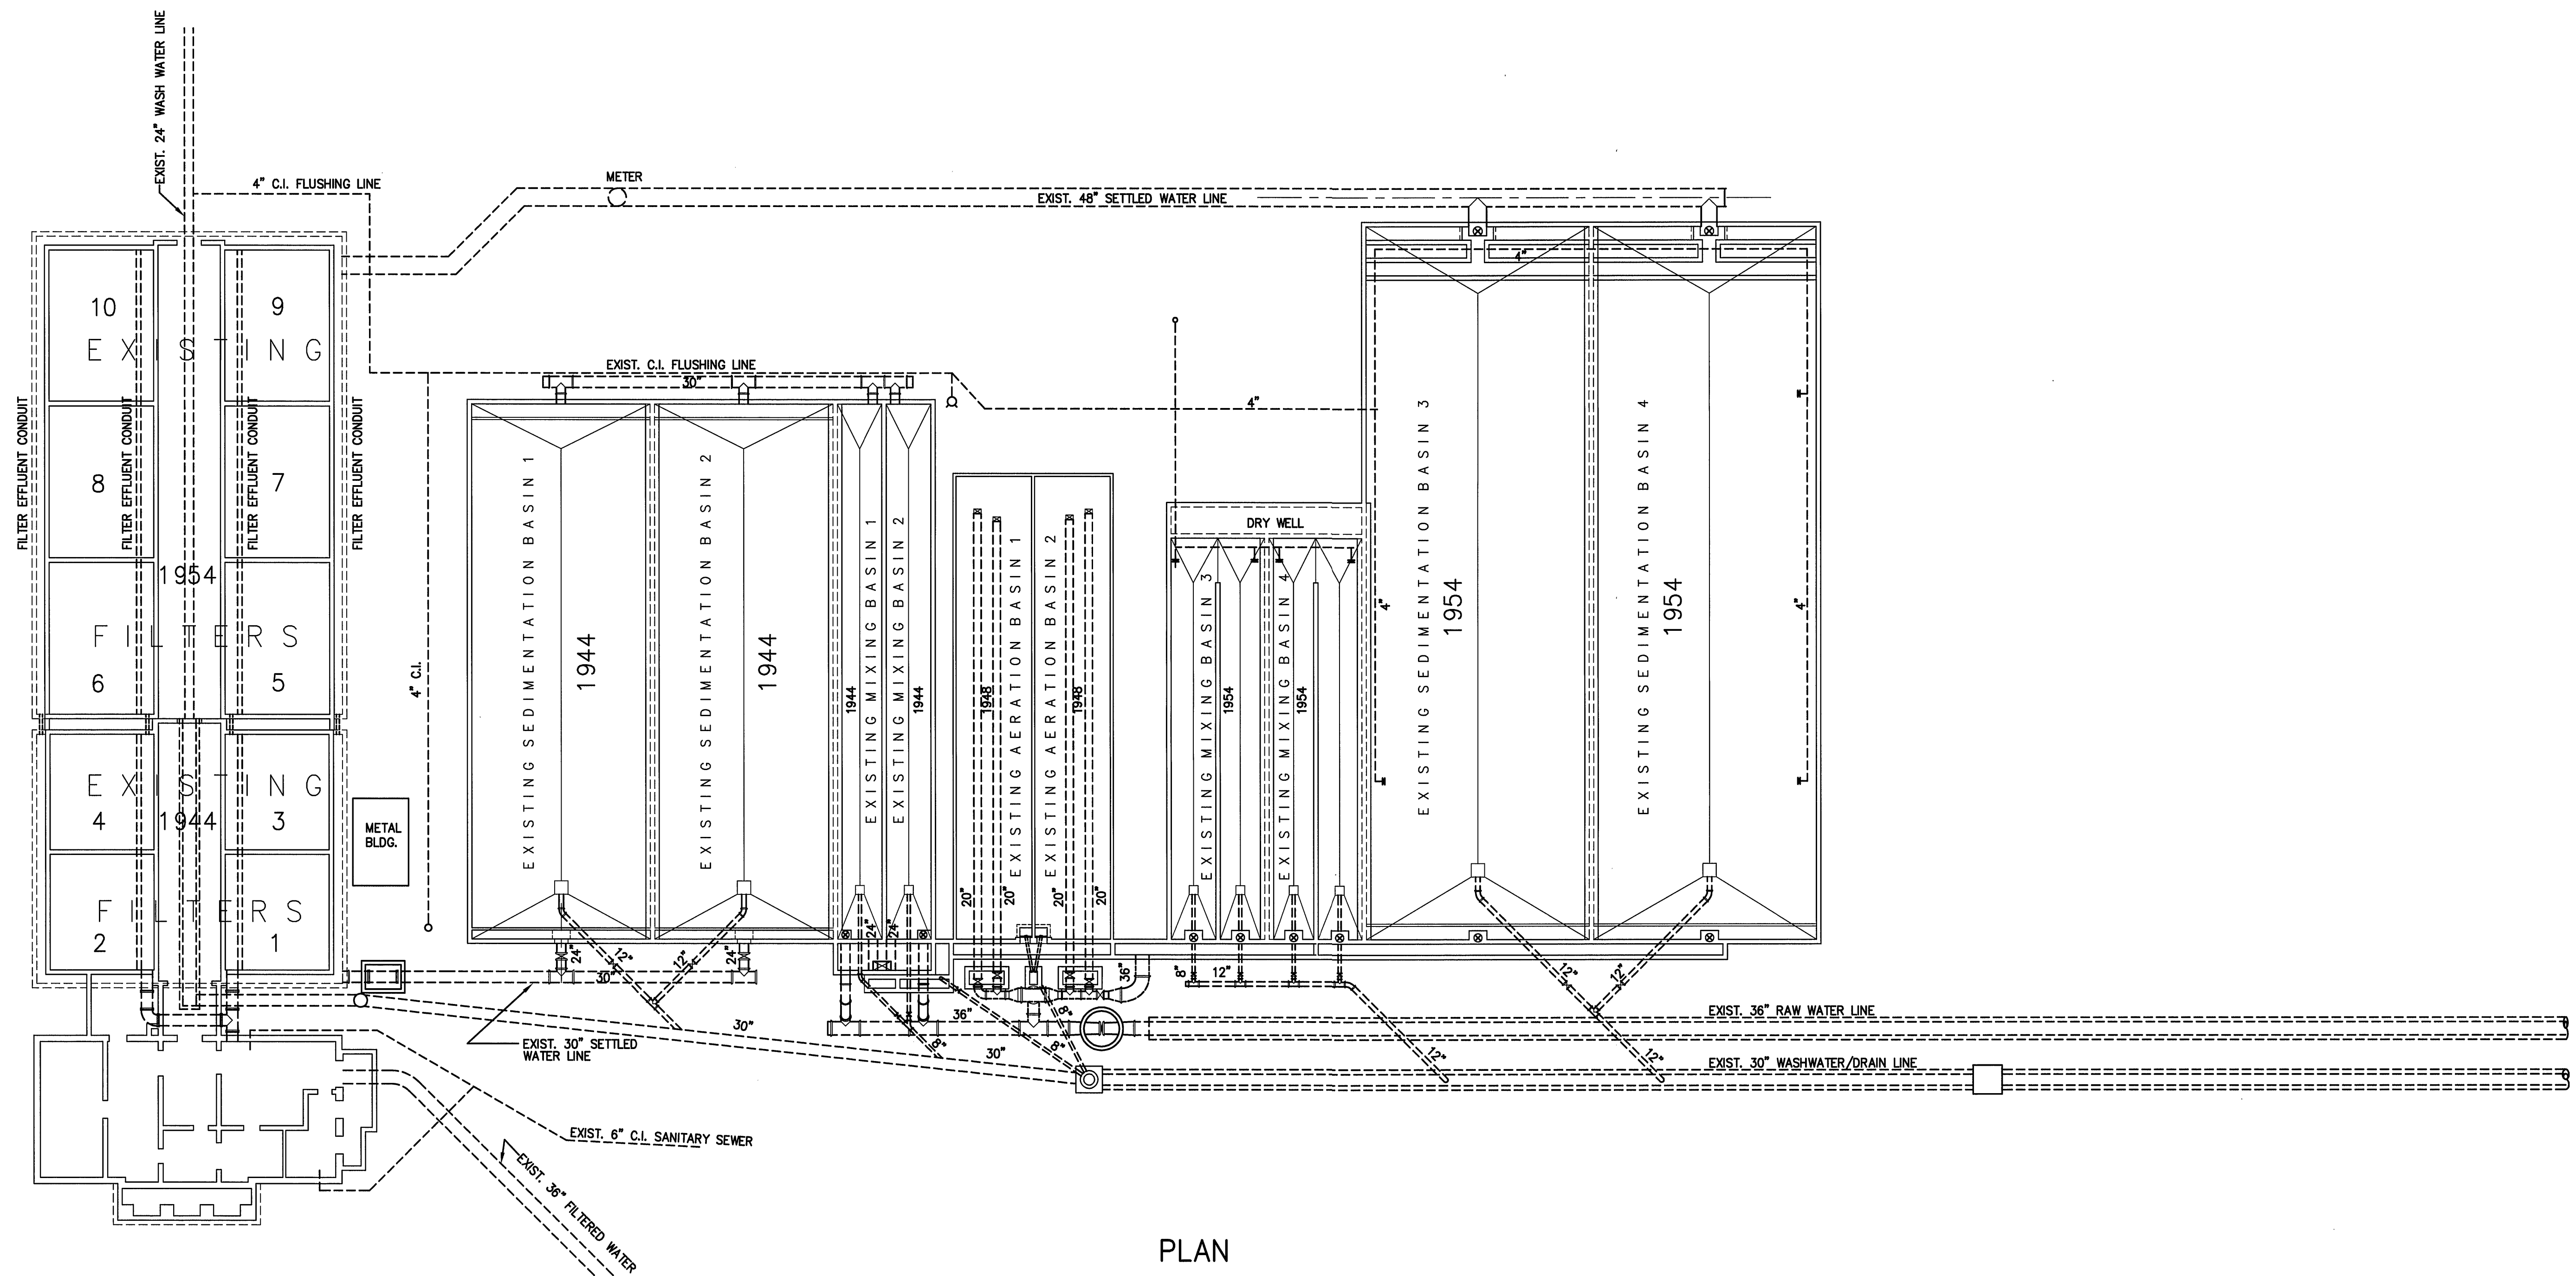


PLAN

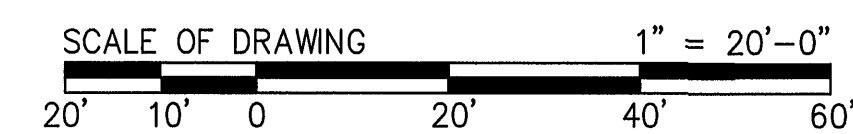

DRAWING OF RECORD

DATE: **SEP 30 1997**

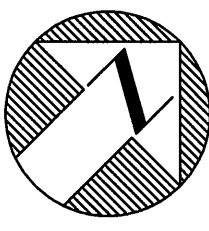MATTERN & CRAIG CONSULTING ENGINEERS • SURVEYORS ROANOKE VIRGINIA	DESIGNED:			REV.	DATE	DESCRIPTION	BY	APP.	CARVINS COVE FILTER PLANT IMPROVEMENTS – PHASE I ROANOKE, VIRGINIA	DATE APRIL 1992
	DRAWN: H.F. R.T.									
ALVORD, BURDICK & HOWSON ENGINEERS CHICAGO	CHECKED: Y.T.L.								EXISTING PLANT LAYOUT	SHEET EP2