


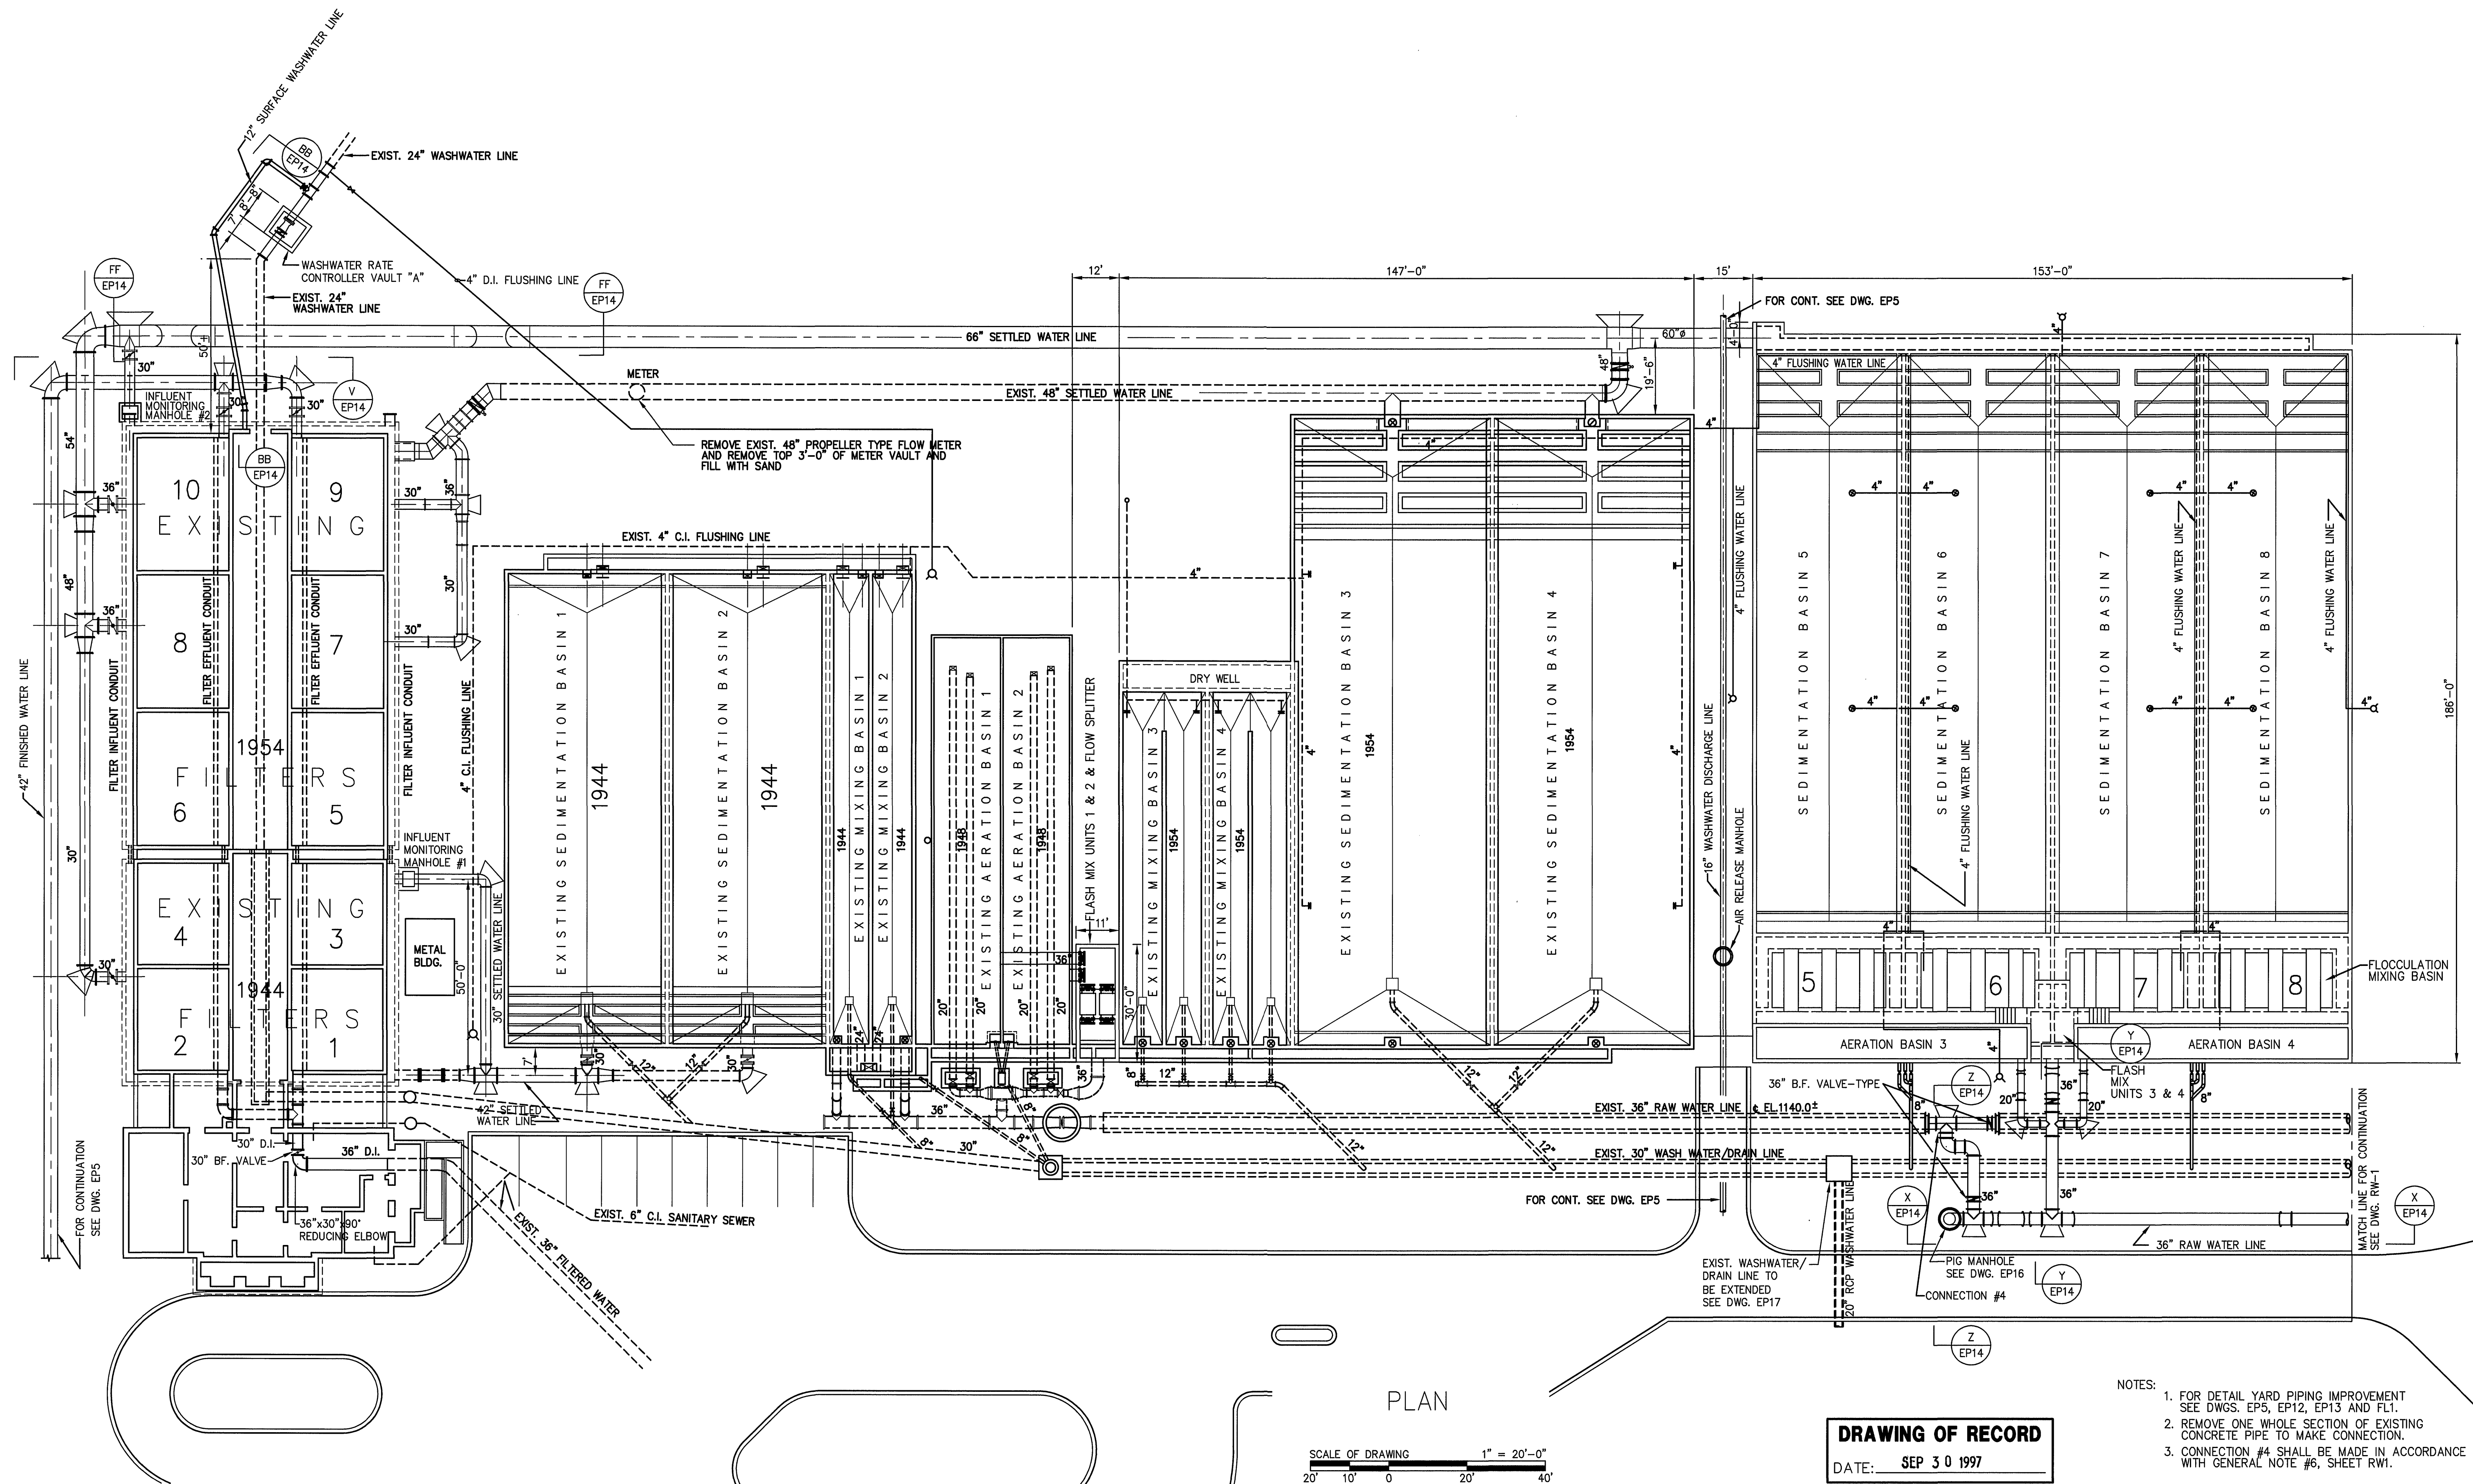


MATTERN & CRAIG
CONSULTING ENGINEERS • SURVEYORS
ROANOKE VIRGINIA

ALVORD, BURDICK & HOWSON
ENGINEERS CHICAGO

DESIGNED:

DRAWN: H.F.
R.T.

CHECKED: Y.T.L.

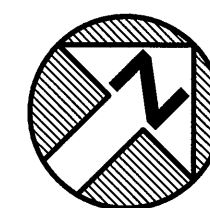

REV.	DATE	DESCRIPTION	BY	APP.

CARVINS COVE FILTER PLANT IMPROVEMENTS – PHASE I
ROANOKE, VIRGINIA

NEW PLANT LAYOUT

DATE
APRIL 1992

COMM. NO.
9130

SHEET
EP3