
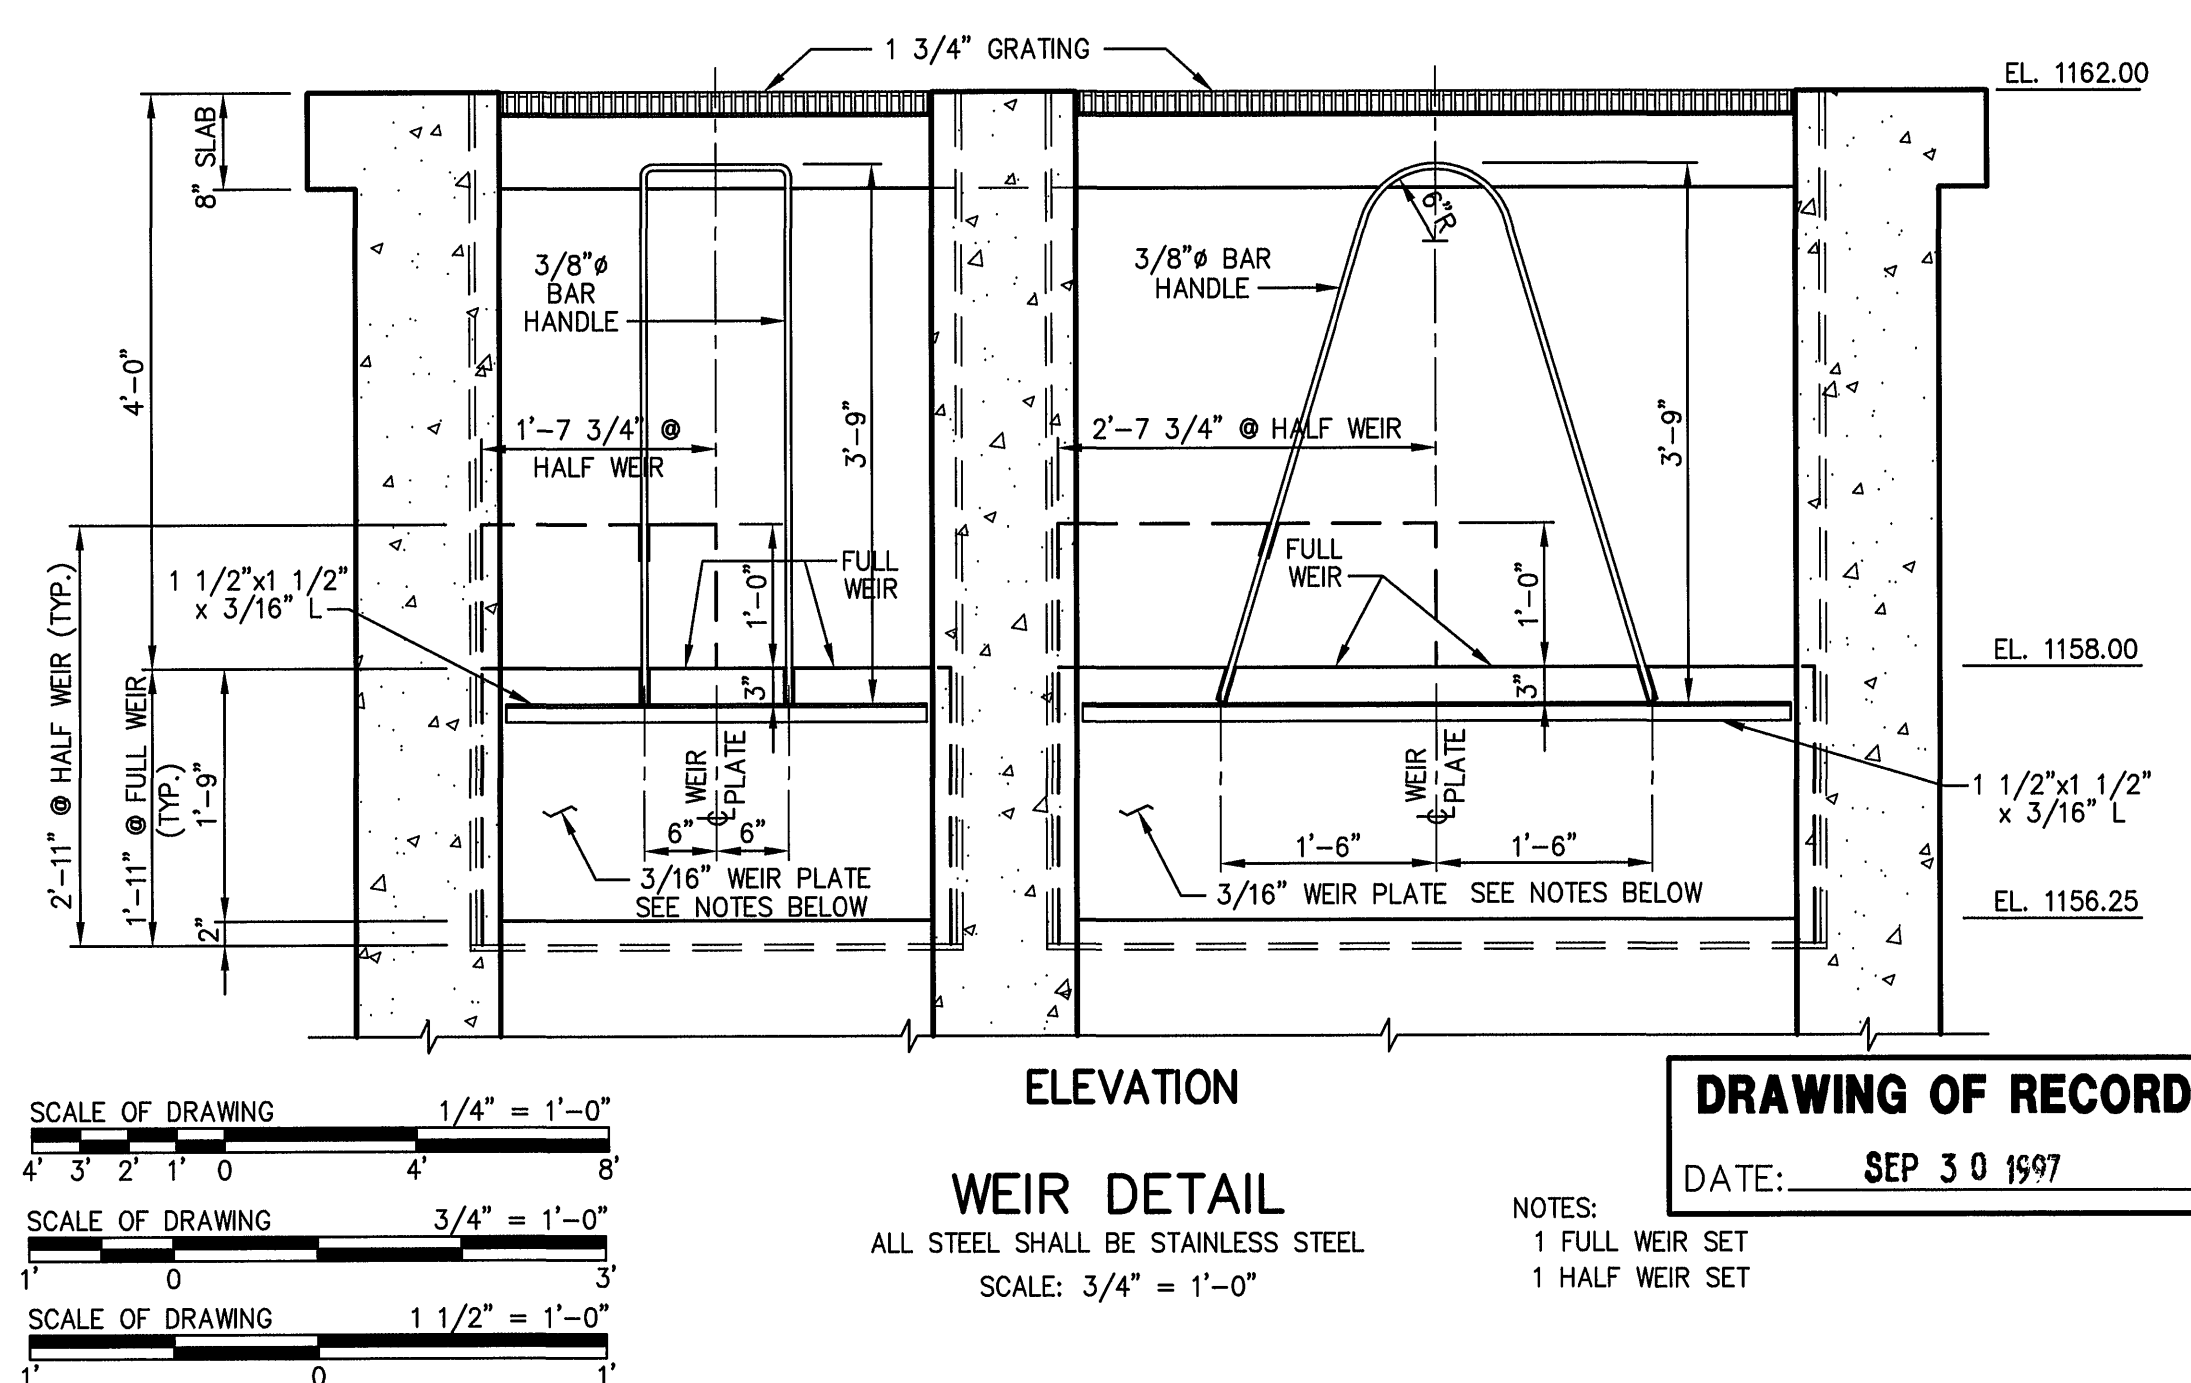
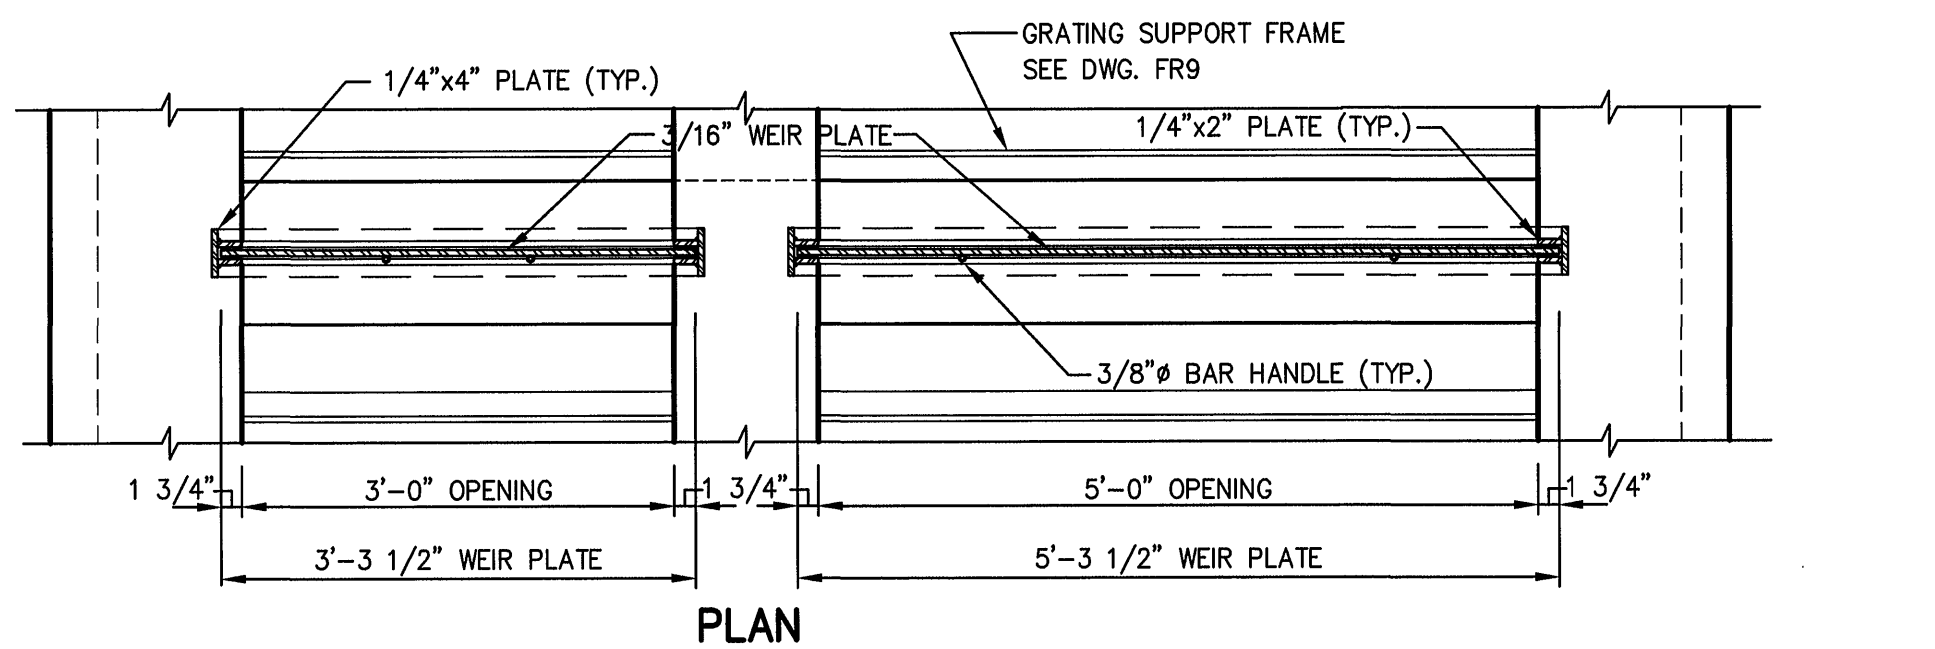
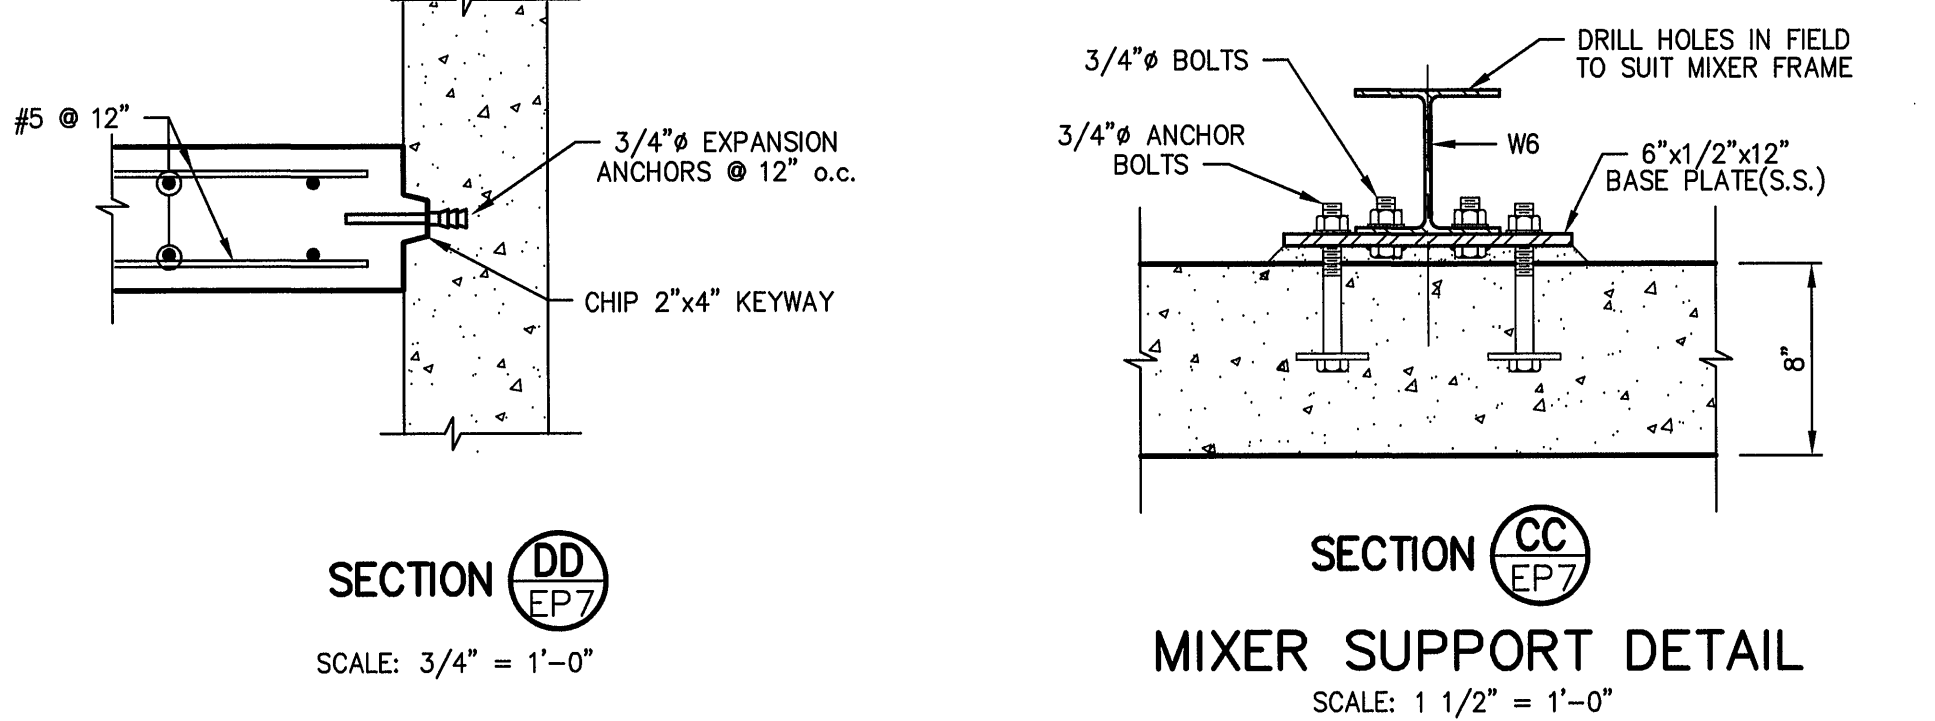
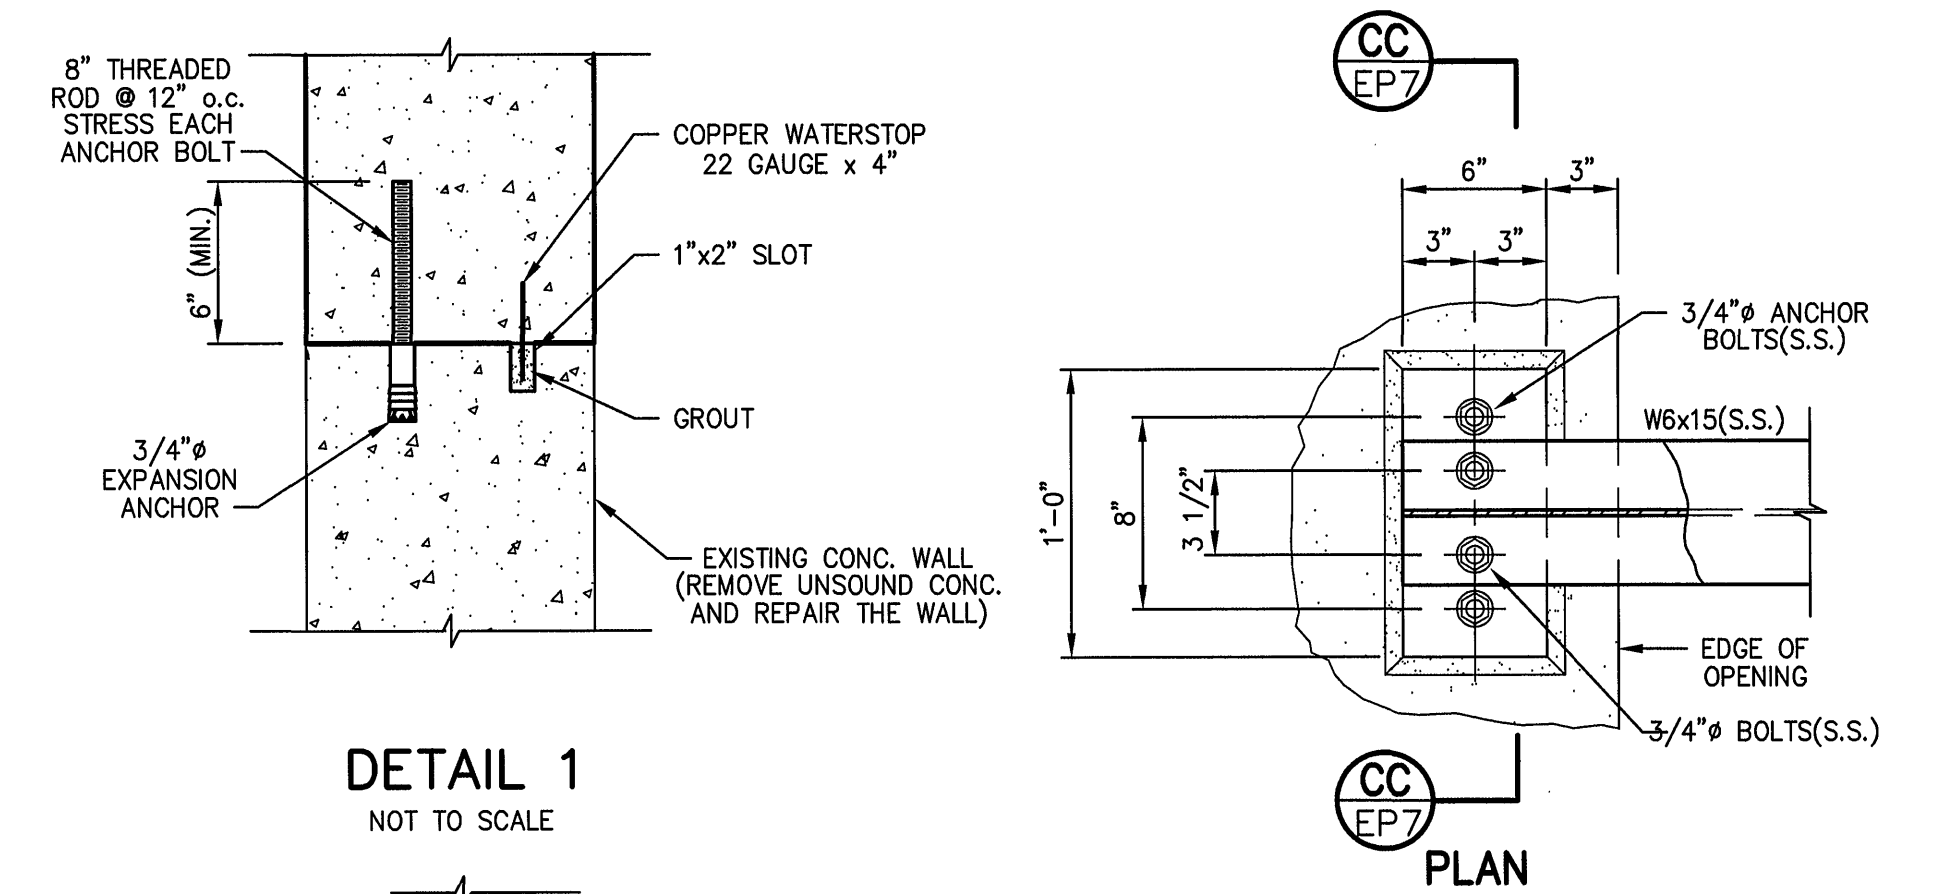
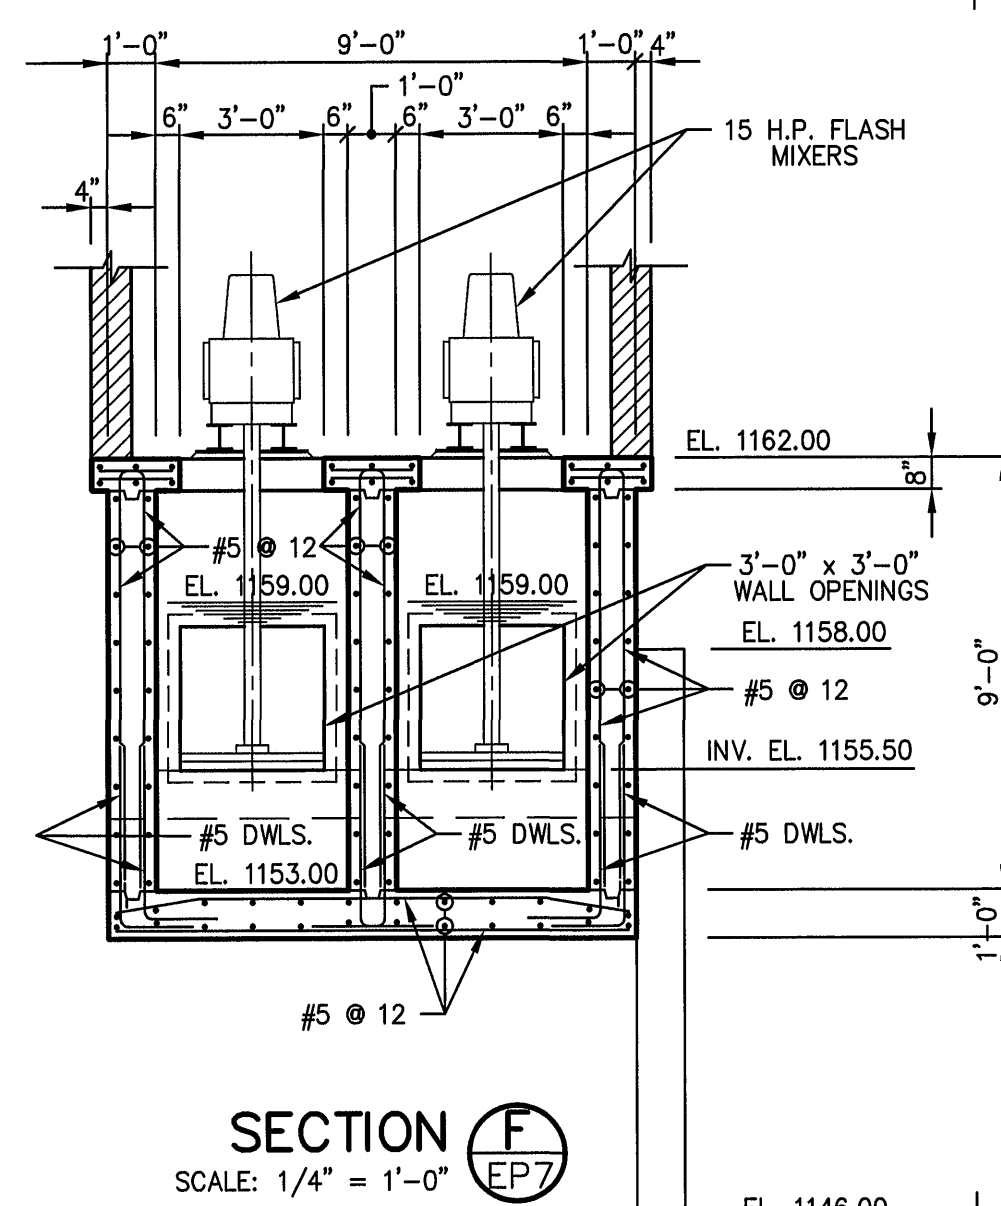
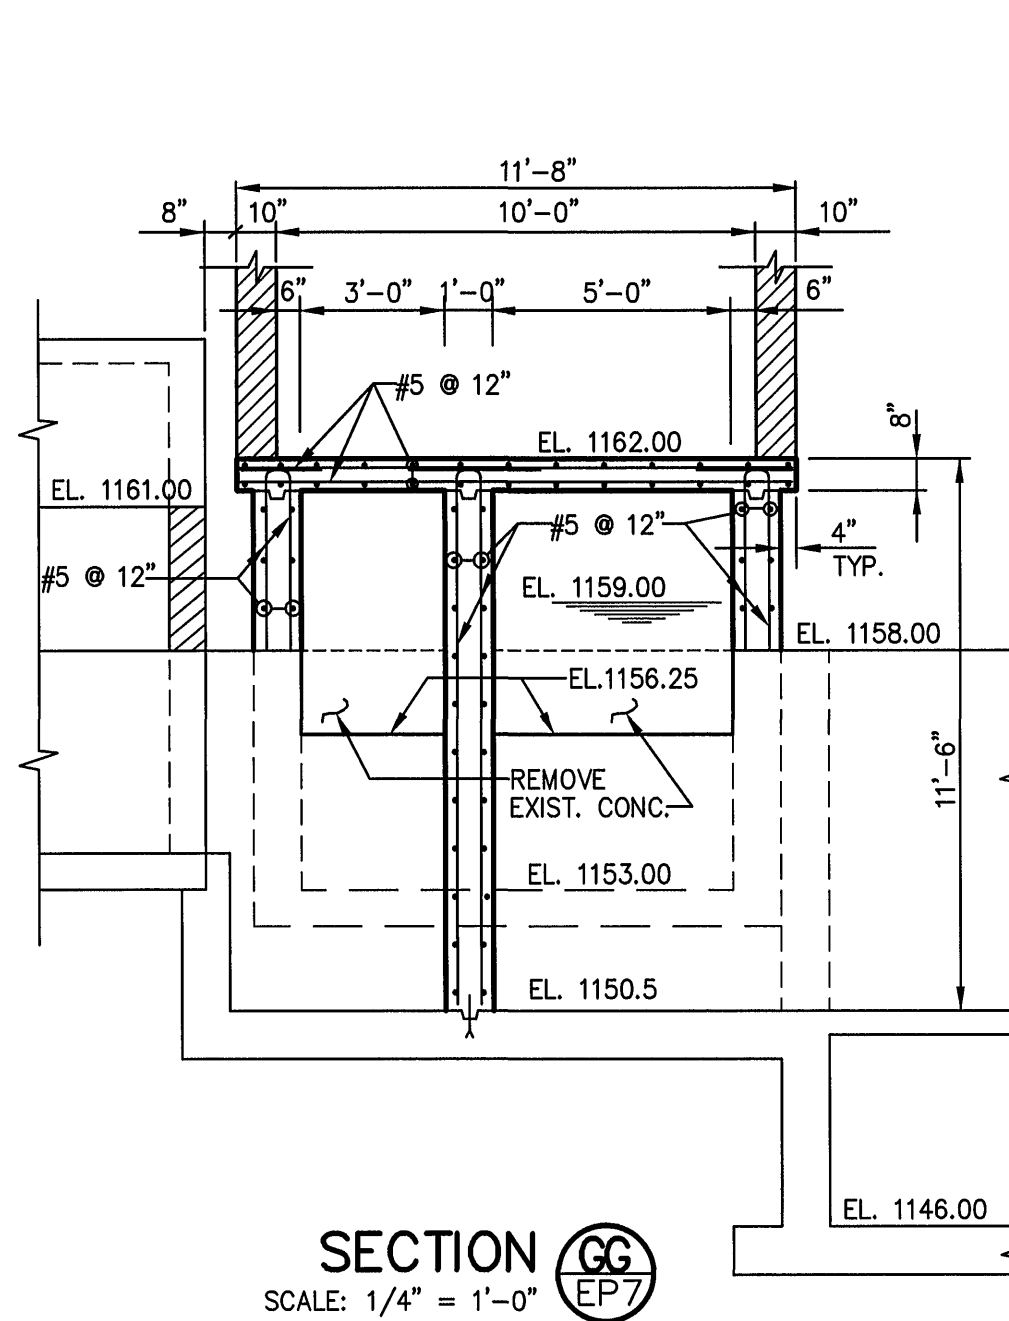
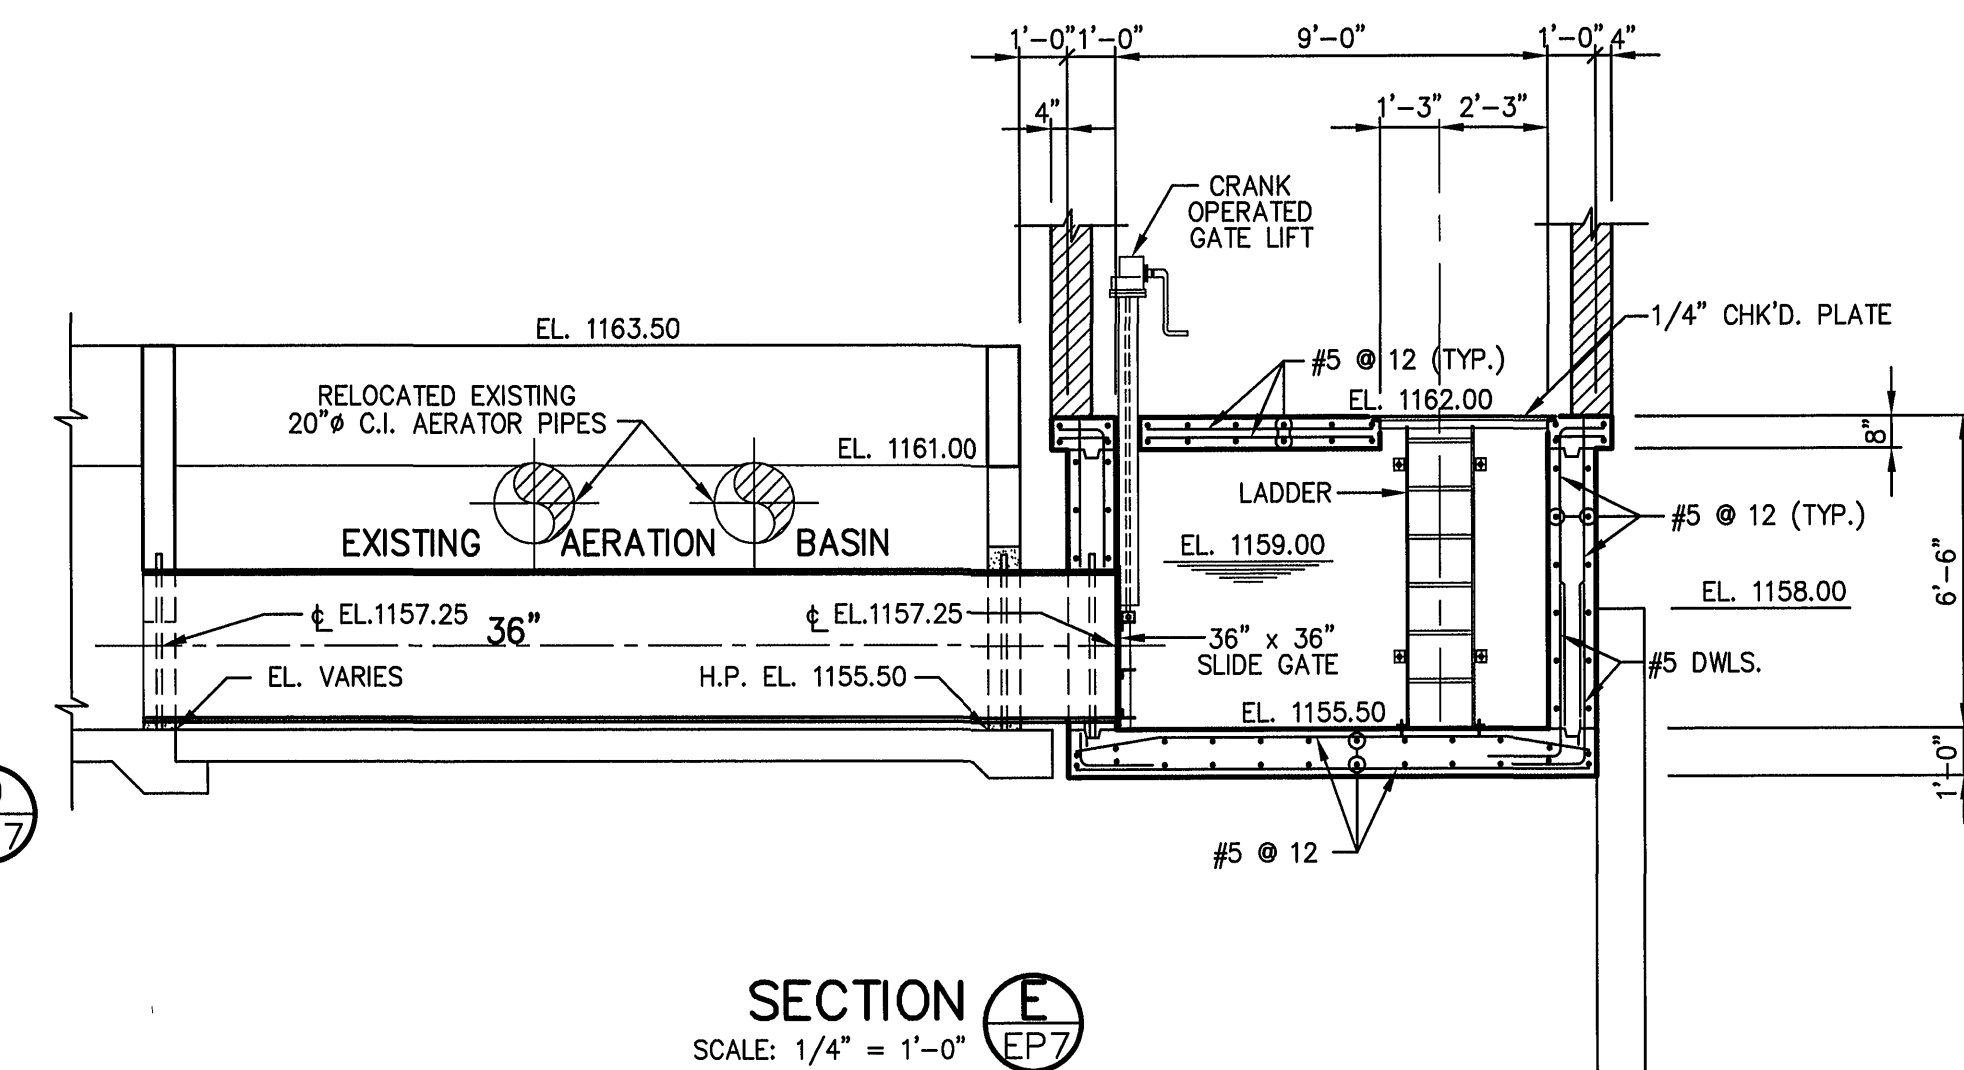
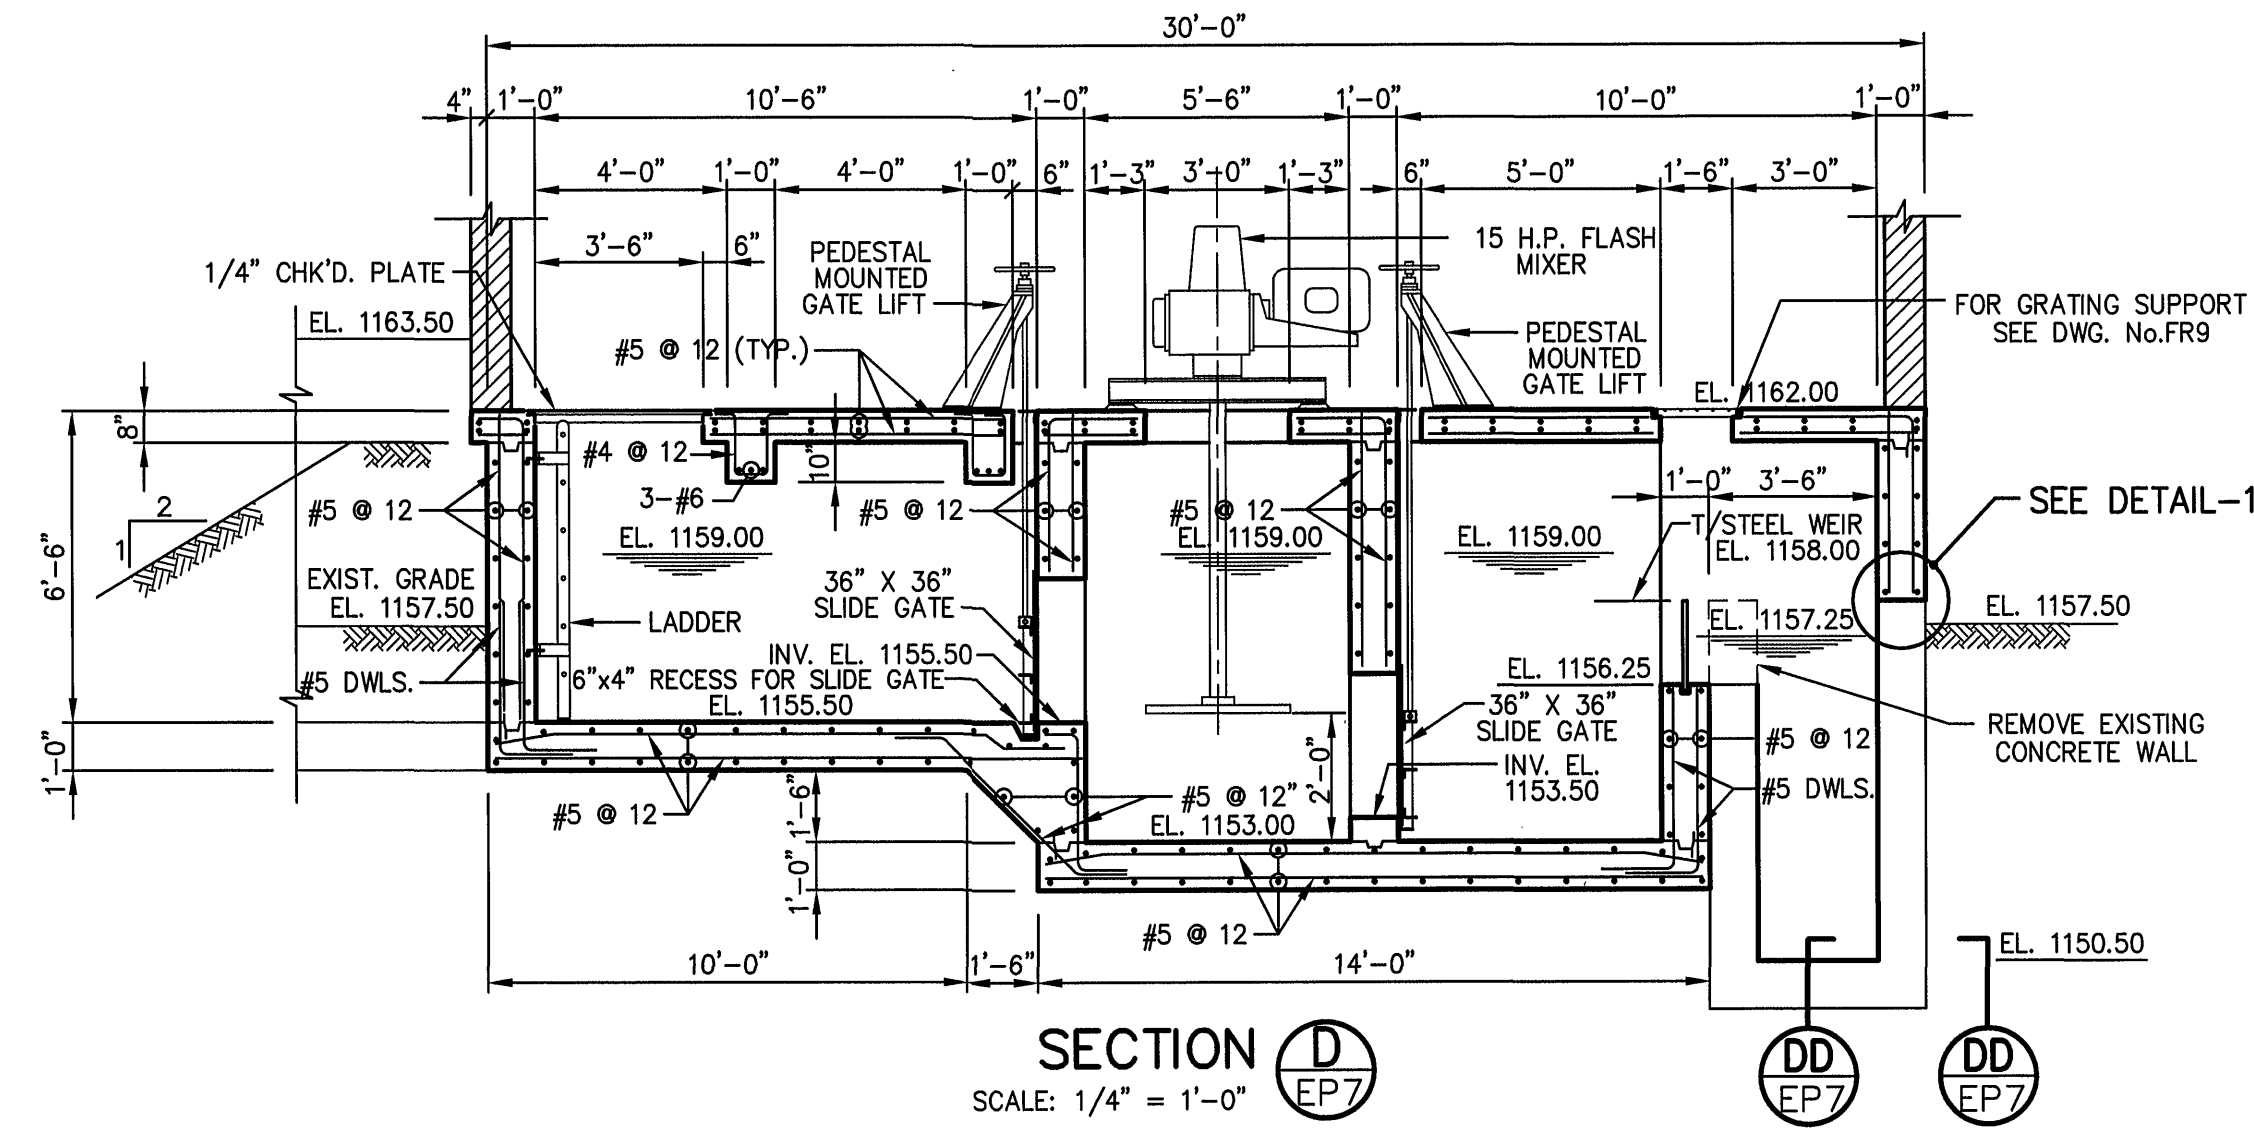
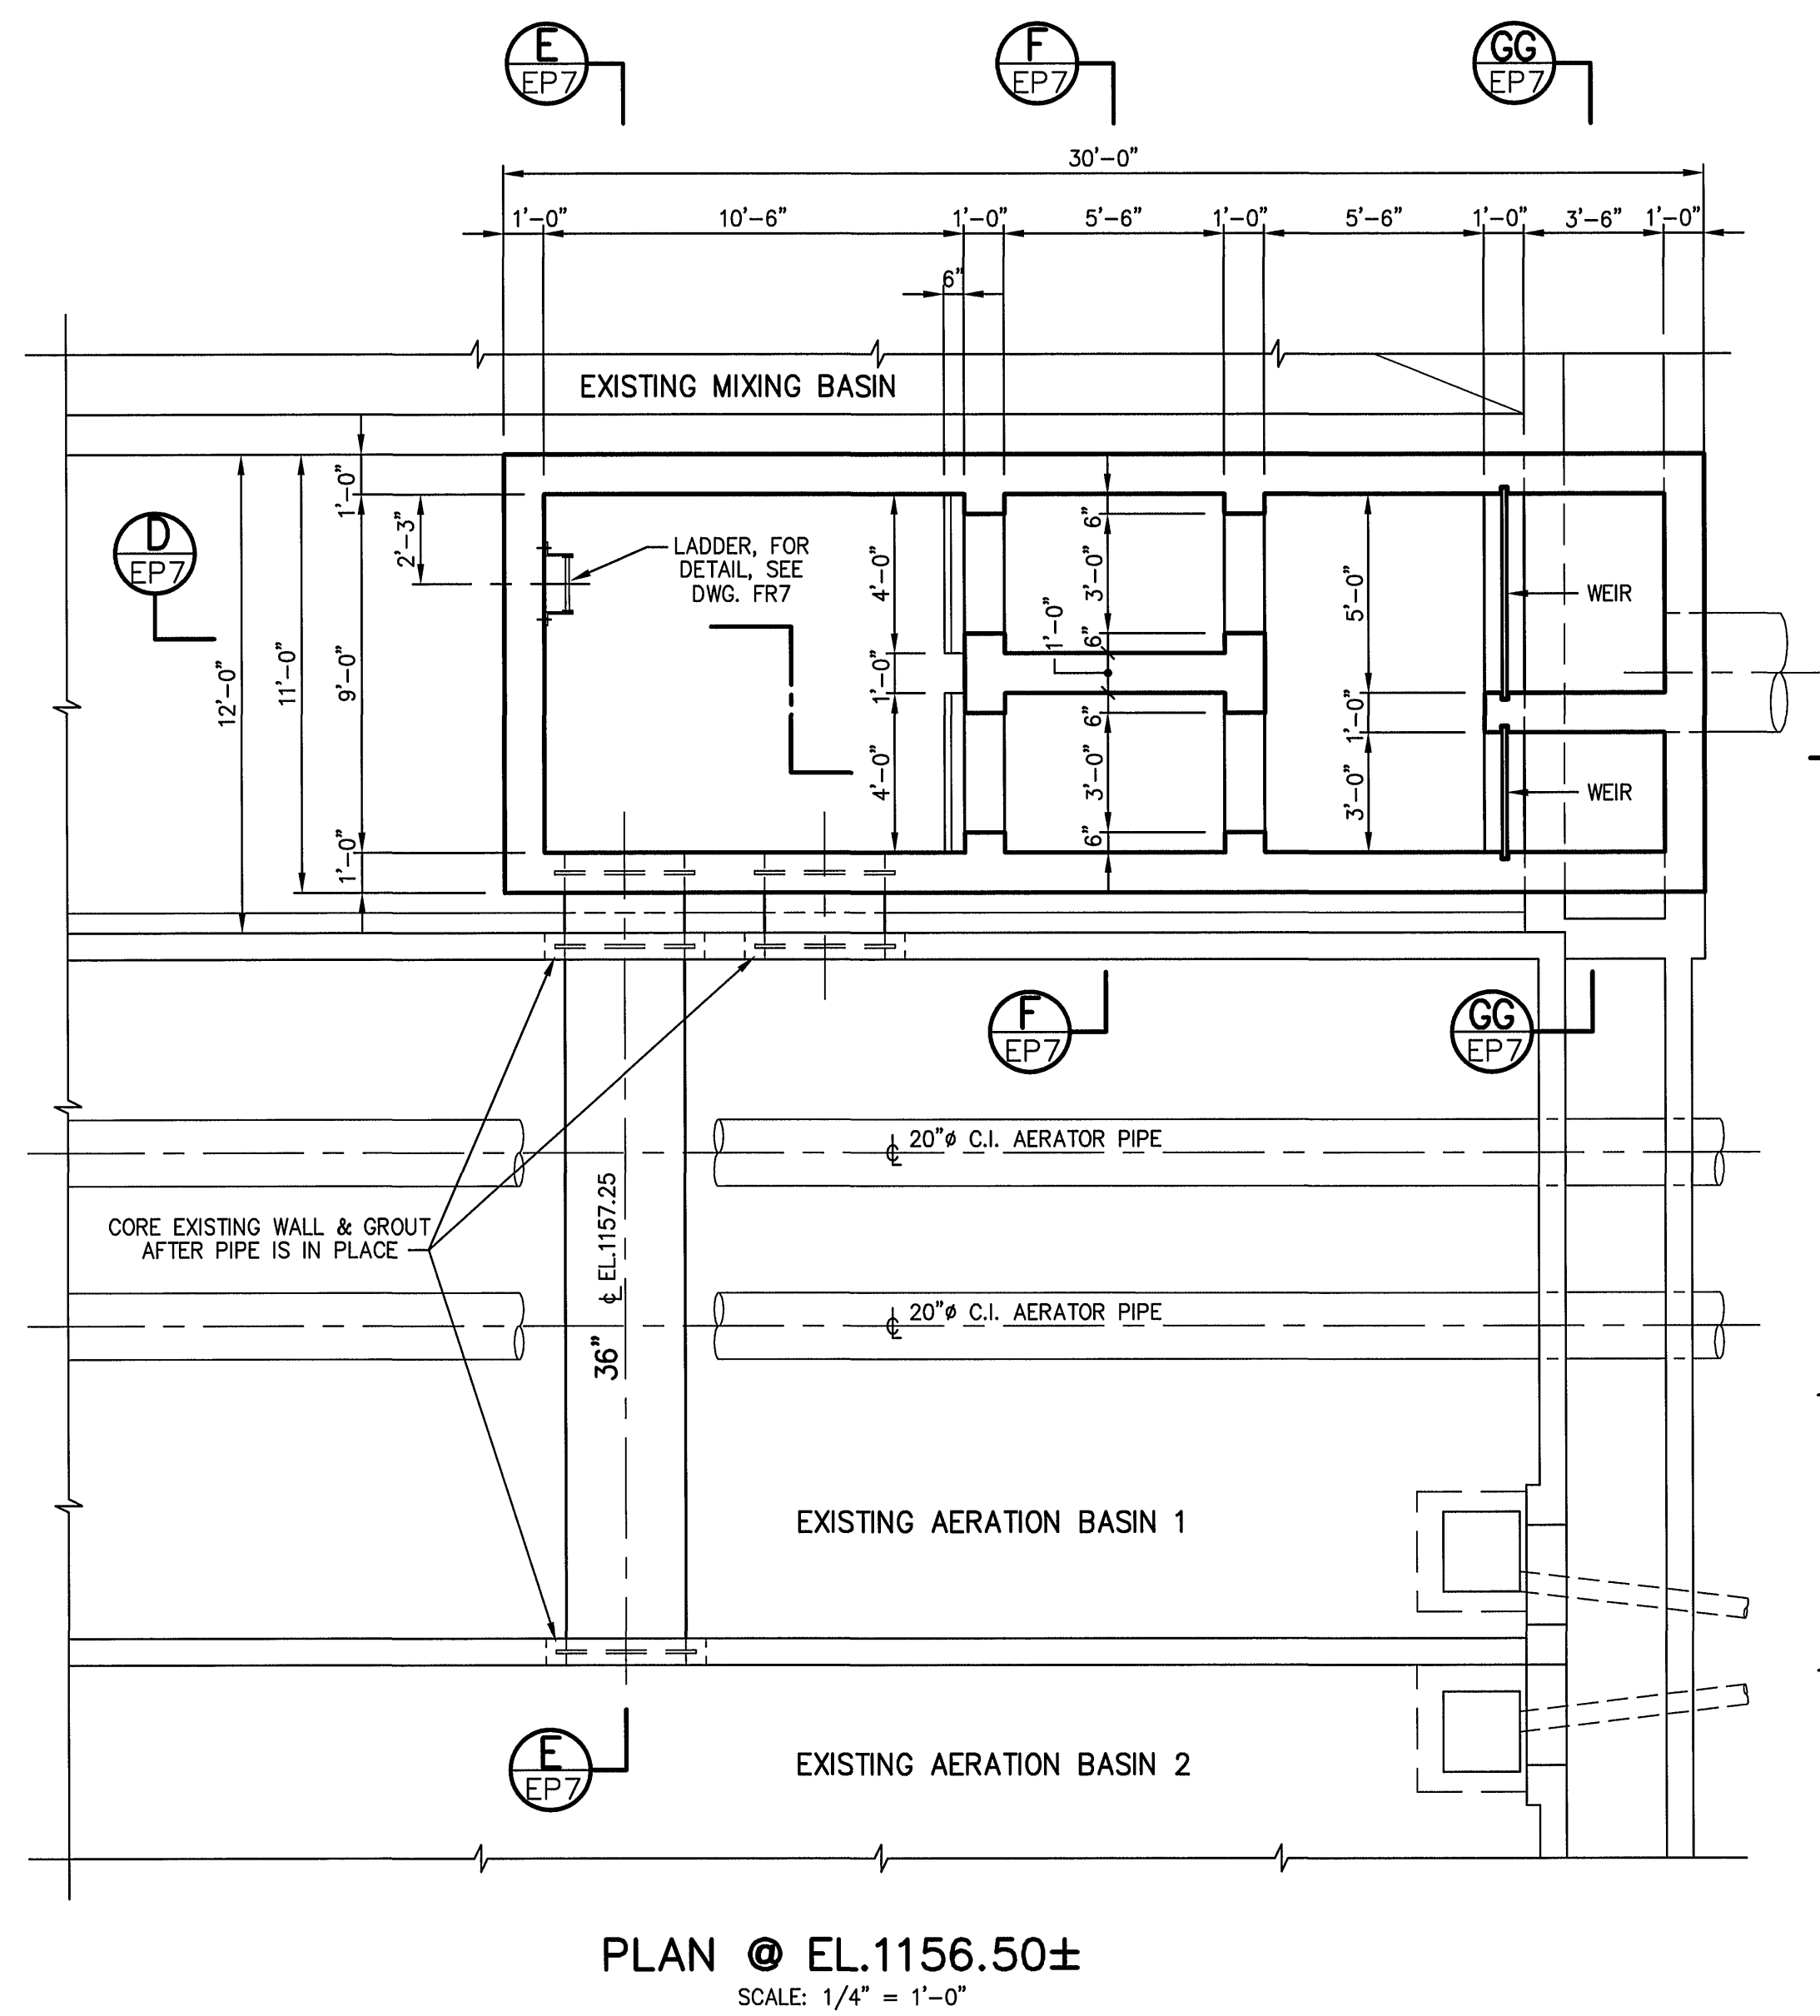


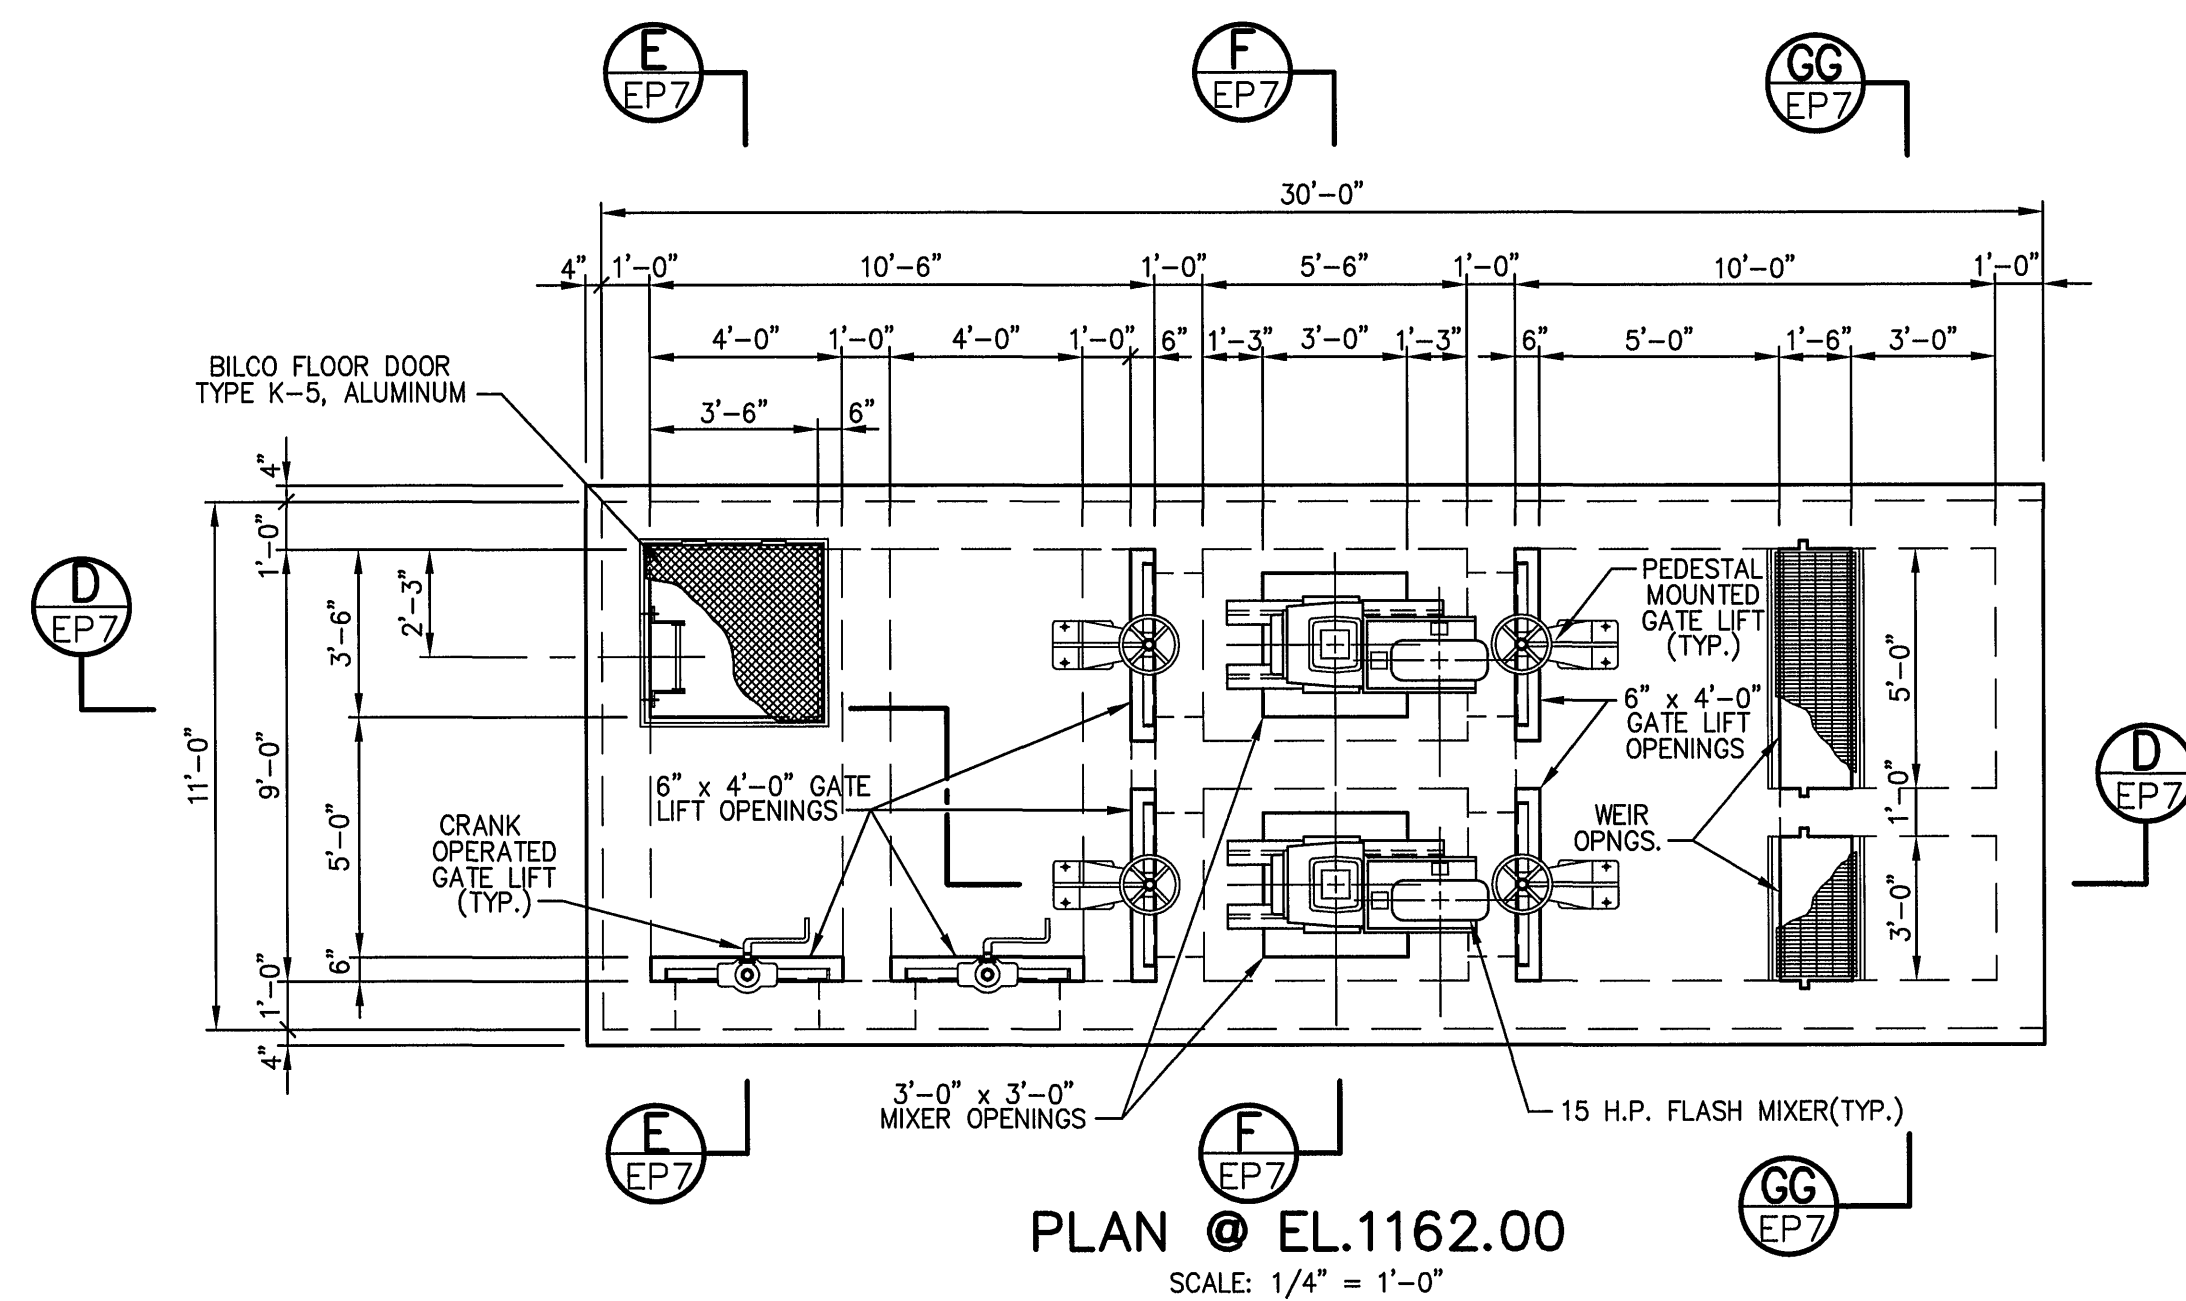

DRAWING OF RECORD
DATE: SEP 30 1997

NOTES:
1 FULL WEIR SET
1 HALF WEIR SET

SCALE OF DRAWING 1/4" = 1'-0"
SCALE OF DRAWING 3/4" = 1'-0"
SCALE OF DRAWING 1 1/2" = 1'-0"

MATTERN & CRAIG CONSULTING ENGINEERS • SURVEYORS ROANOKE VIRGINIA ALVORD, BURDICK & HOWSON ENGINEERS CHICAGO	DESIGNED: K.C. F.L. DRAWN: H.F. R.T. CHECKED: Y.T.L.	COMMONWEALTH OF VIRGINIA YA-TAI LIN NO. 022786 PROFESSIONAL ENGINEER	<table> <tr> <th>REV.</th><th>DATE</th><th>DESCRIPTION</th><th>BY</th><th>APP.</th></tr> <tr><td> </td><td> </td><td> </td><td> </td><td> </td></tr> <tr><td> </td><td> </td><td> </td><td> </td><td> </td></tr> <tr><td> </td><td> </td><td> </td><td> </td><td> </td></tr> <tr><td> </td><td> </td><td> </td><td> </td><td> </td></tr> </table>	REV.	DATE	DESCRIPTION	BY	APP.																					CARVINS COVE FILTER PLANT IMPROVEMENTS – PHASE I ROANOKE, VIRGINIA FLASH MIXING & FLOW SPLITTER FOR EXISTING PLANT DATE: APRIL 1992 COMM. NO. 9130 SHEET EP7
REV.	DATE	DESCRIPTION	BY	APP.																									