

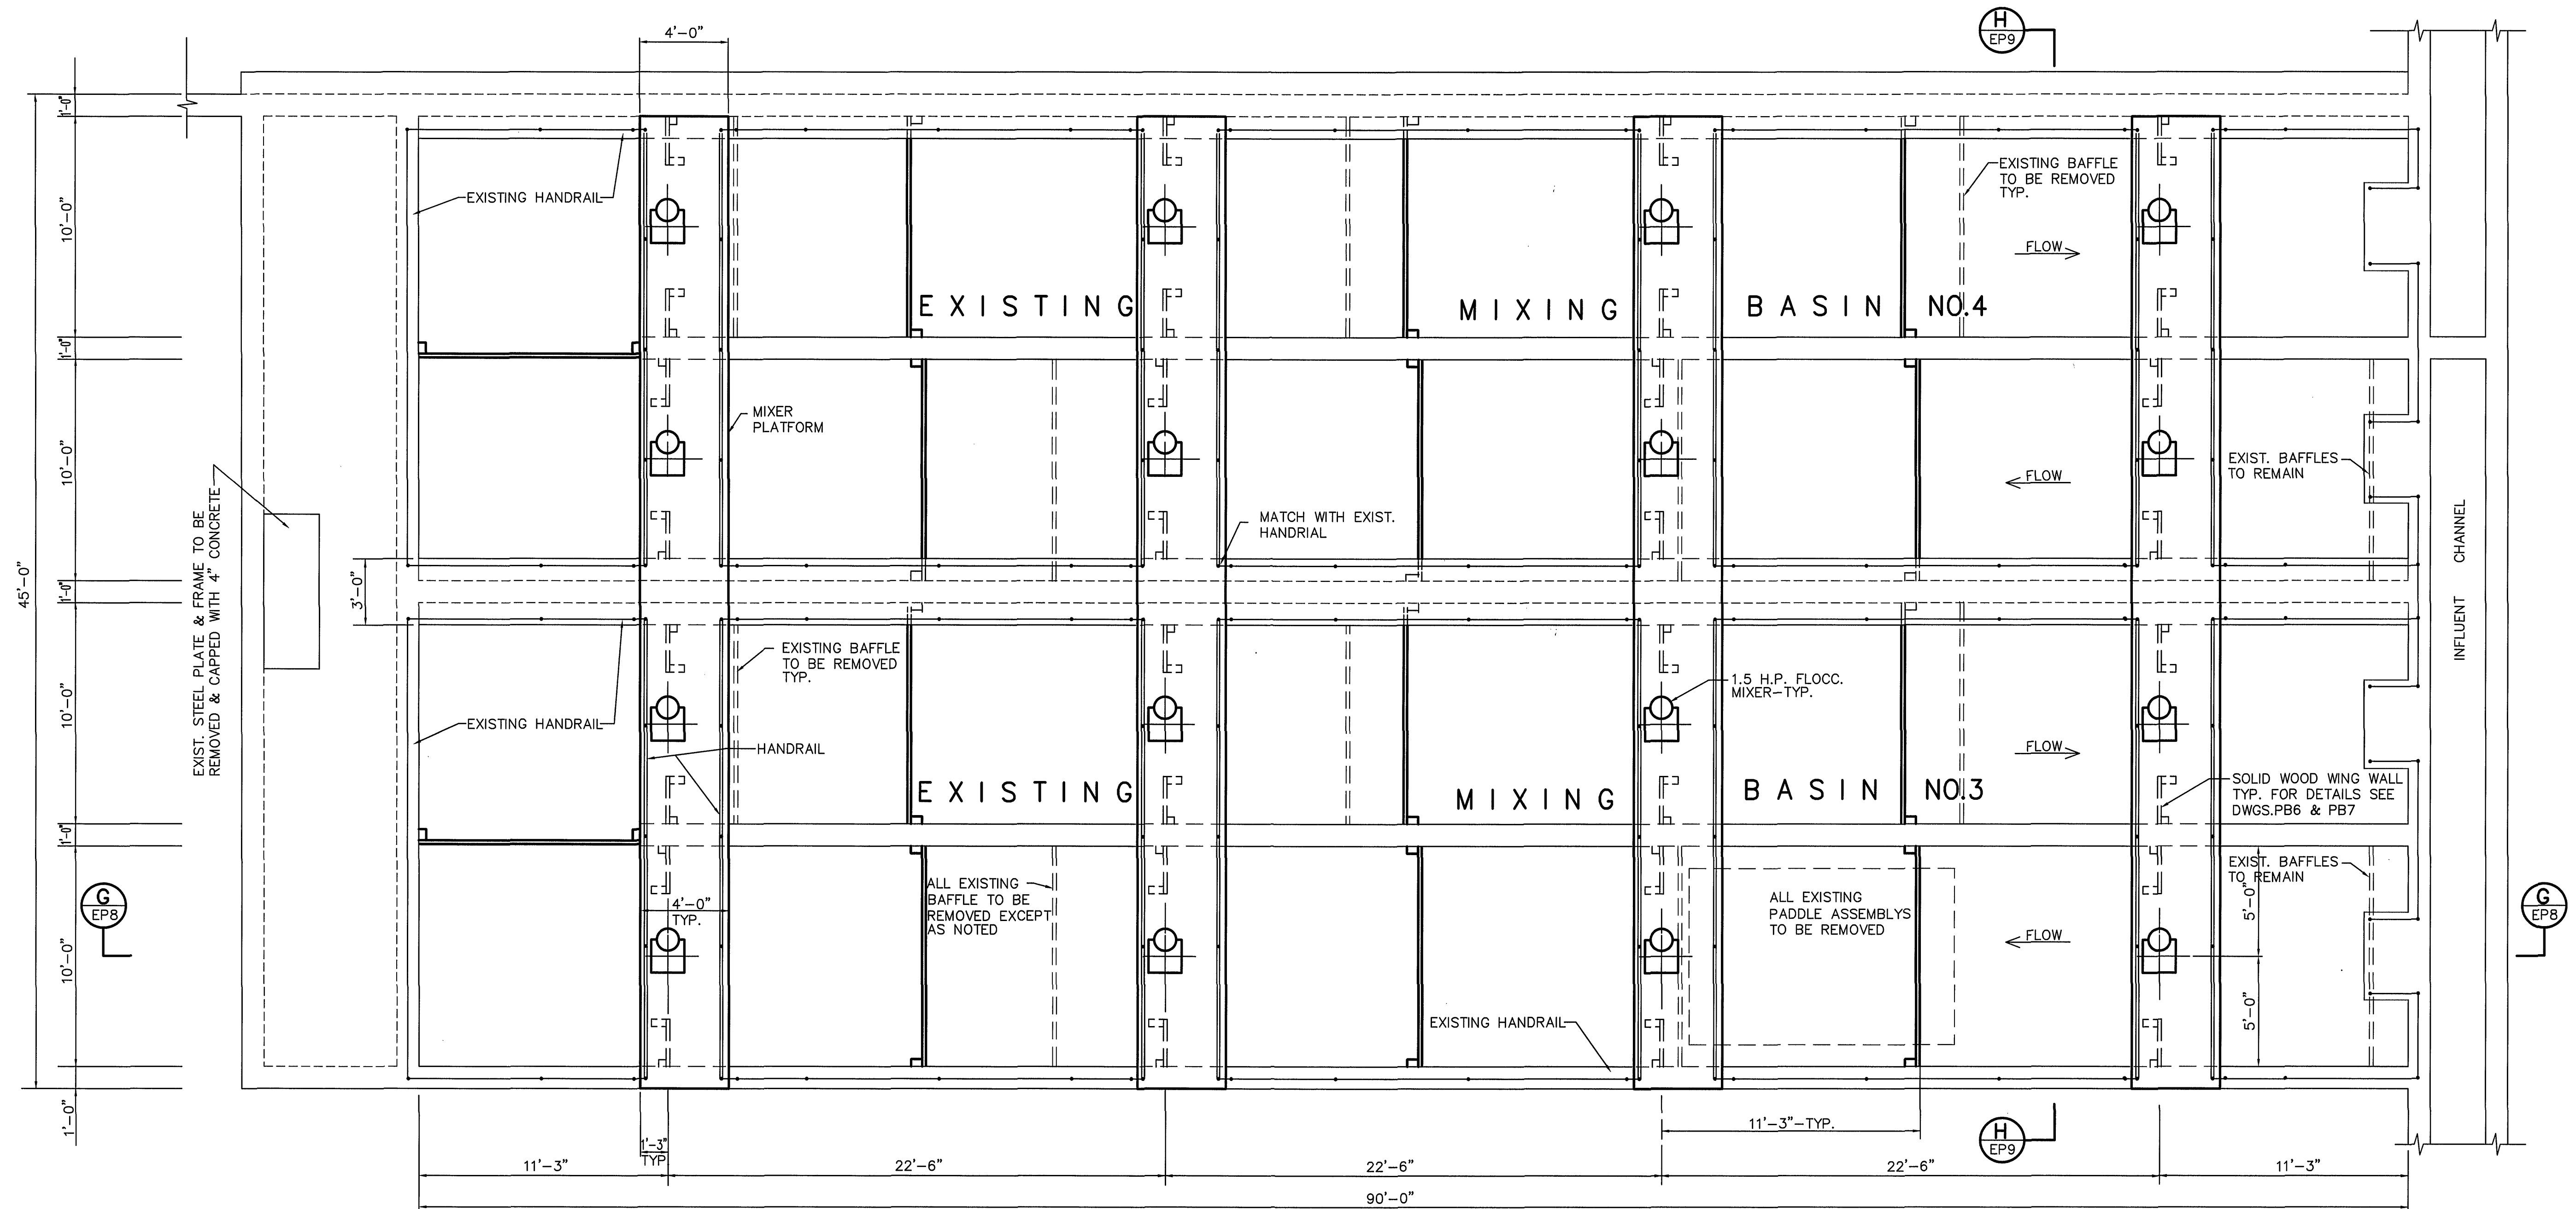


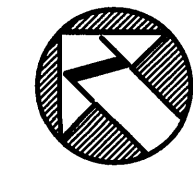

PLAN

SCALE: 1/4"=1'-0"

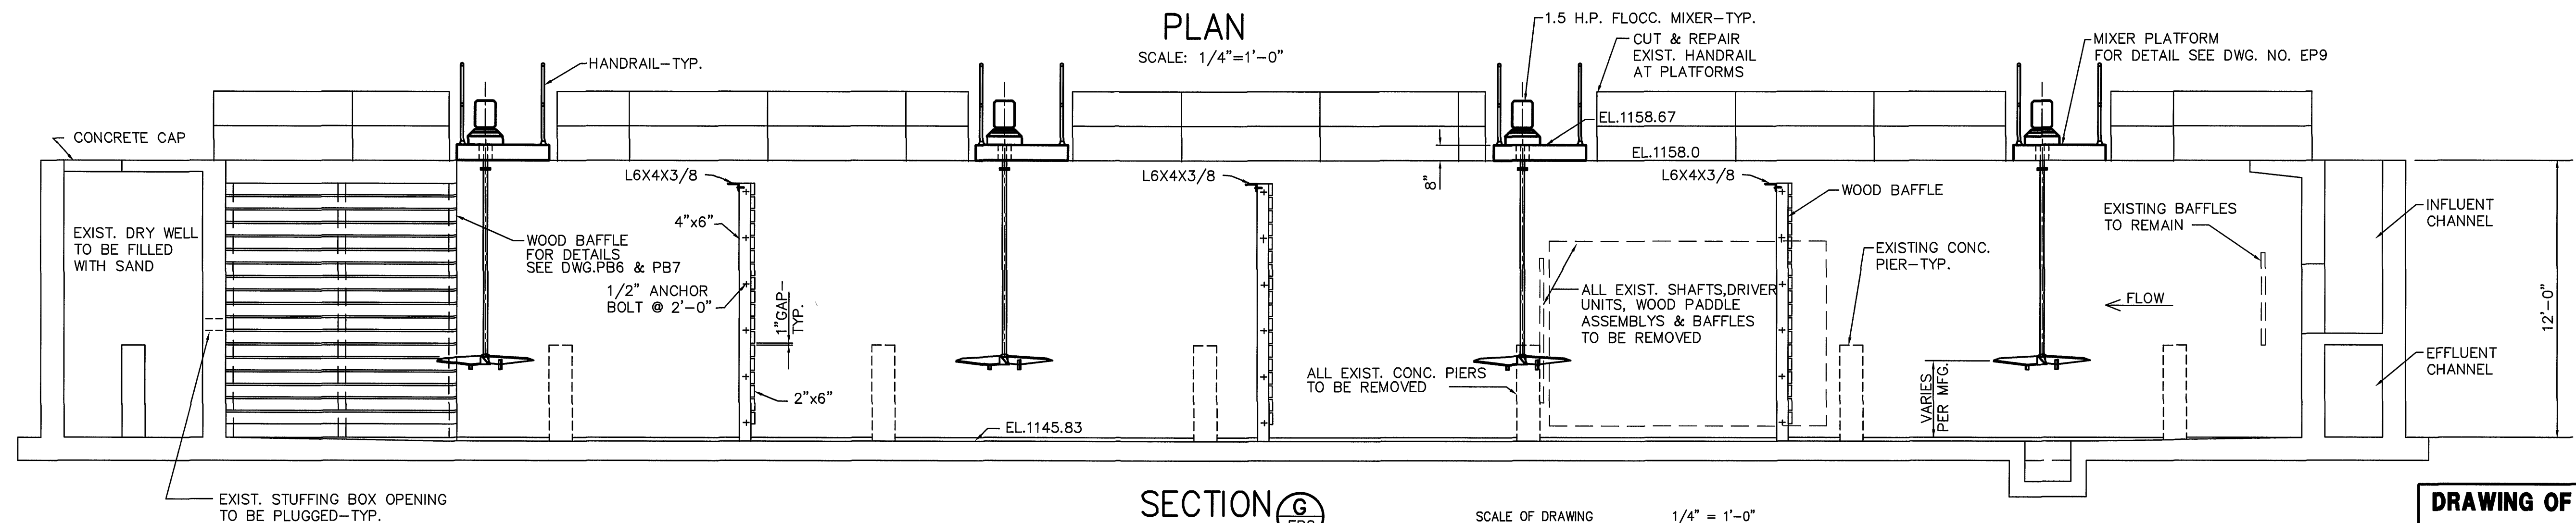

SECTION G

SCALE: 1/4"=1'-0"

DRAWING OF RECORD


DATE: SEP 30 1997

MATTERN & CRAIG
CONSULTING ENGINEERS • SURVEYORS
ROANOKE VIRGINIA

DESIGNED: K.C.
F.L.

DRAWN: H.F.
R.T.

CHECKED: Y.T.L.

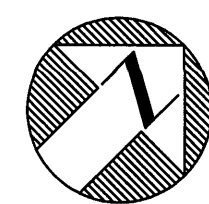

REV.	DATE	DESCRIPTION	BY	APP.

CARVINS COVE FILTER PLANT IMPROVEMENTS – PHASE I
ROANOKE, VIRGINIA

1954 FLOCC. MIXING BASIN IMPROVEMENT

DATE
APRIL 1992
COMM. NO.
9130
SHEET
EP8