
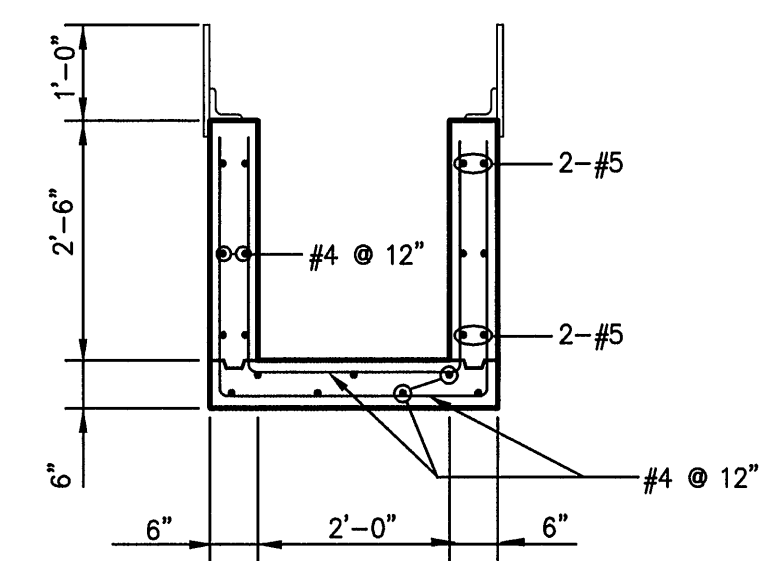
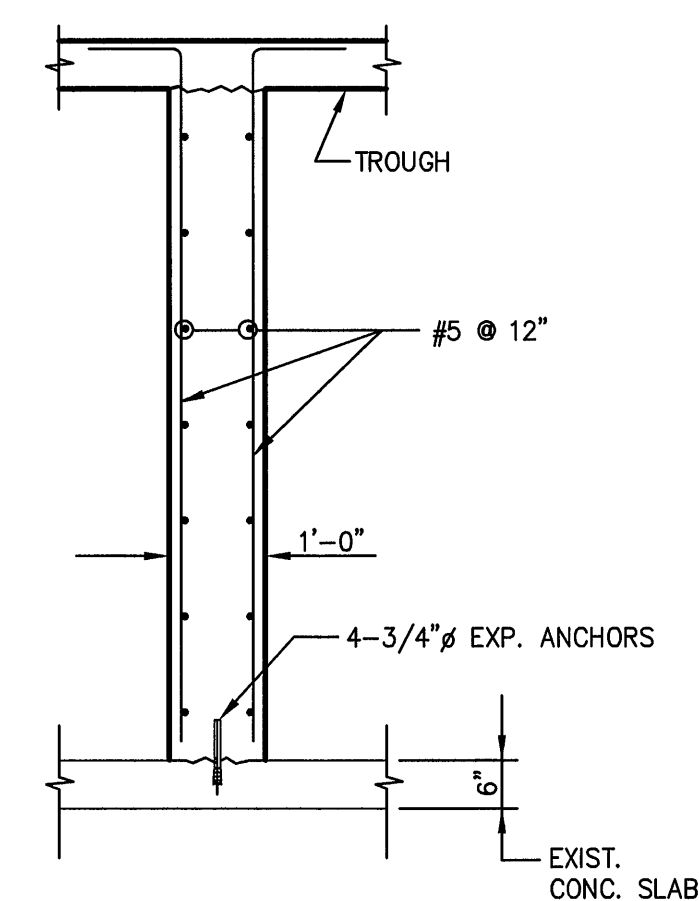
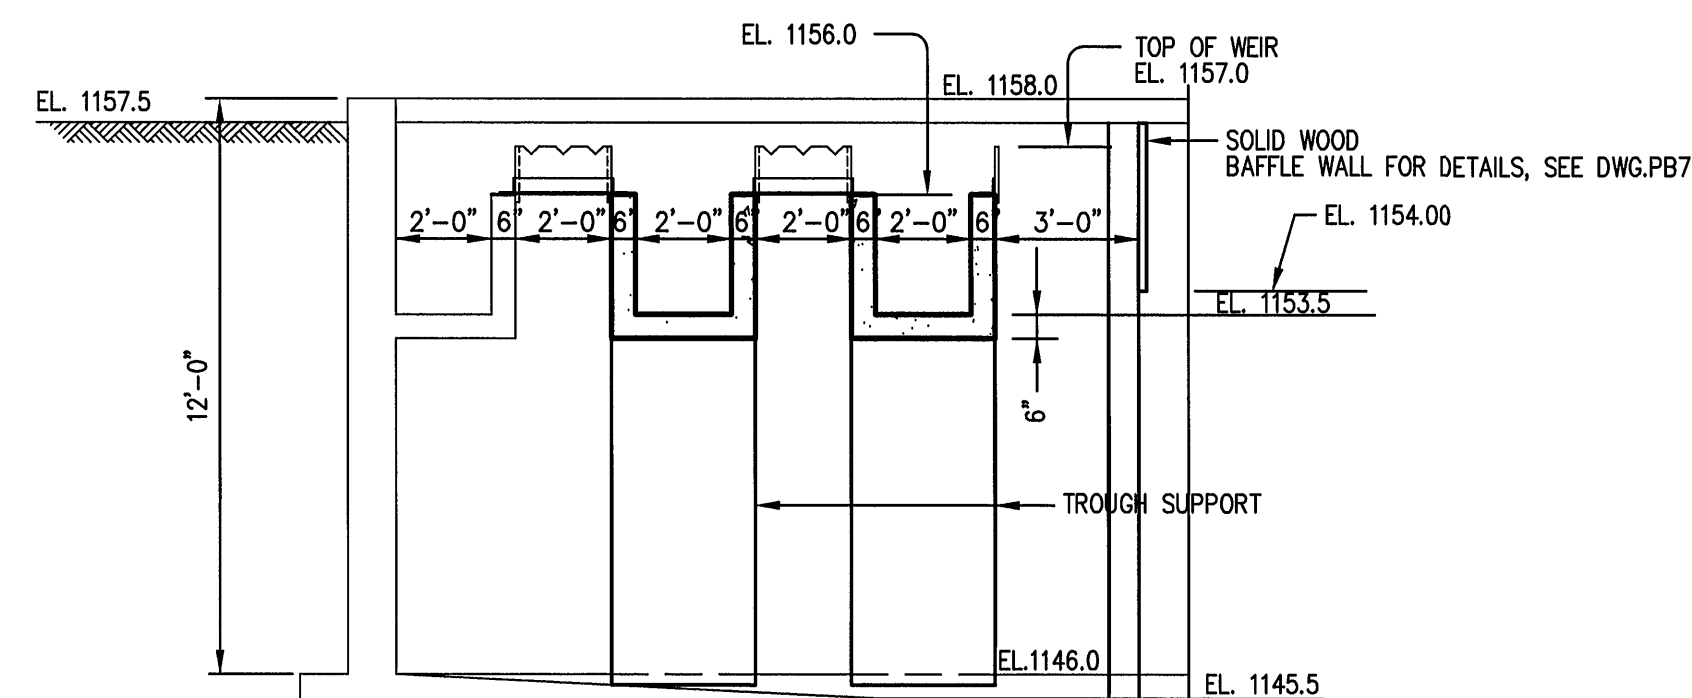
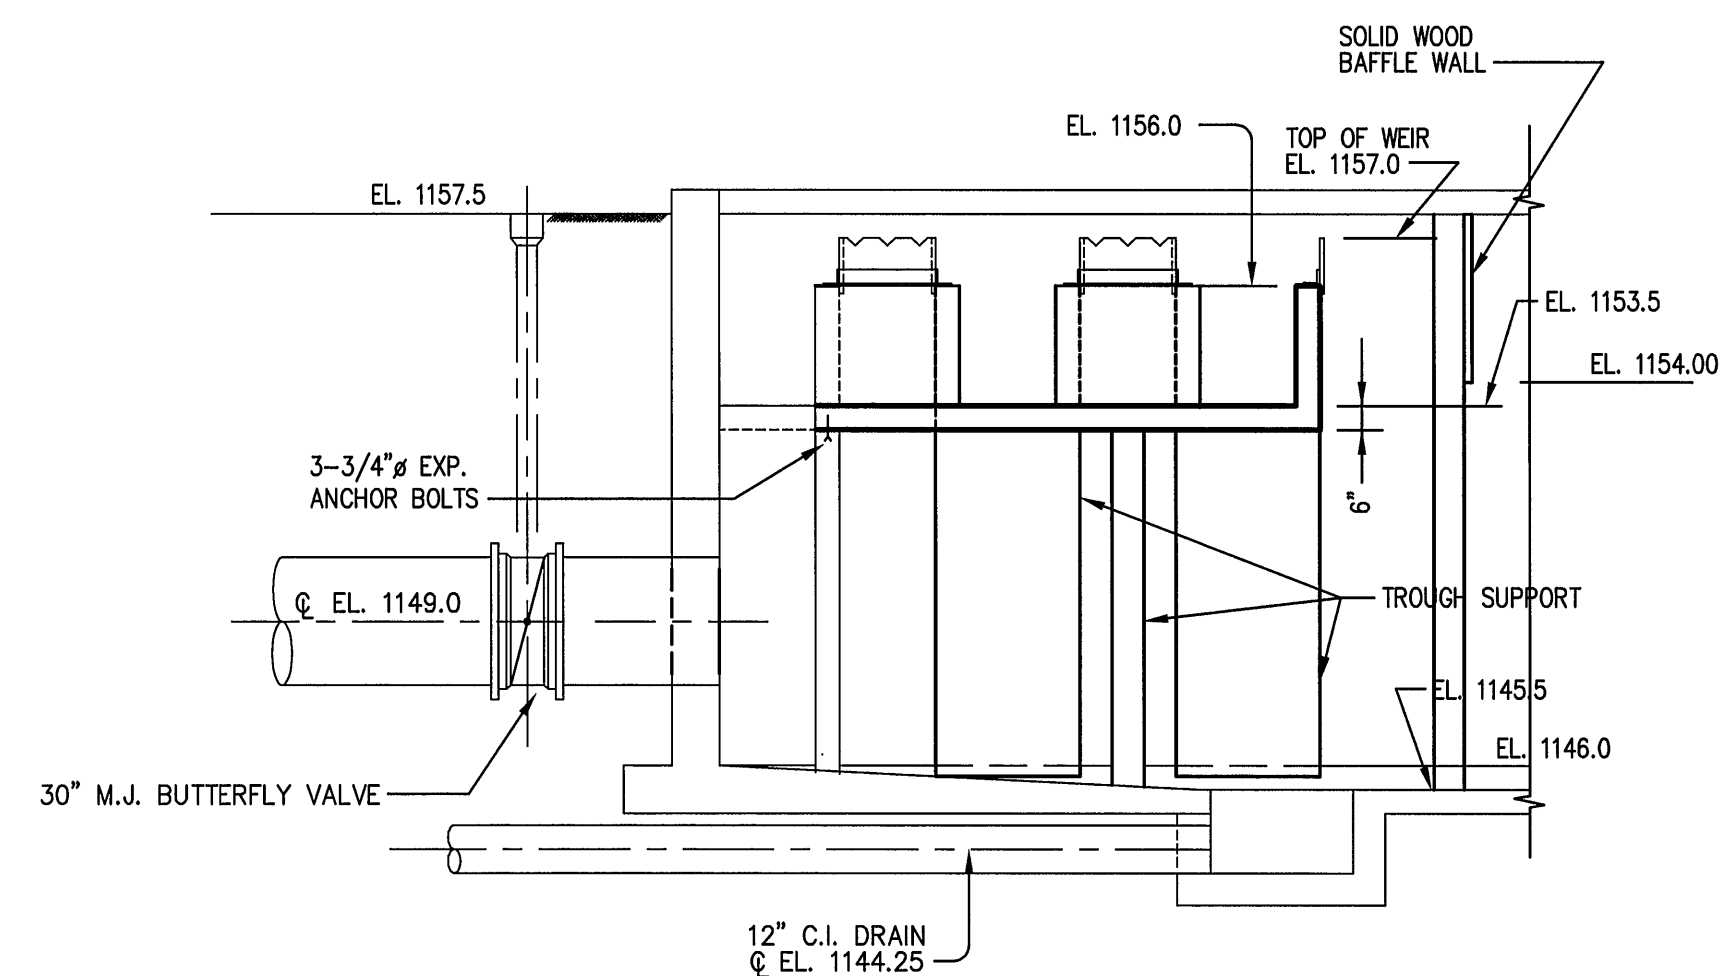
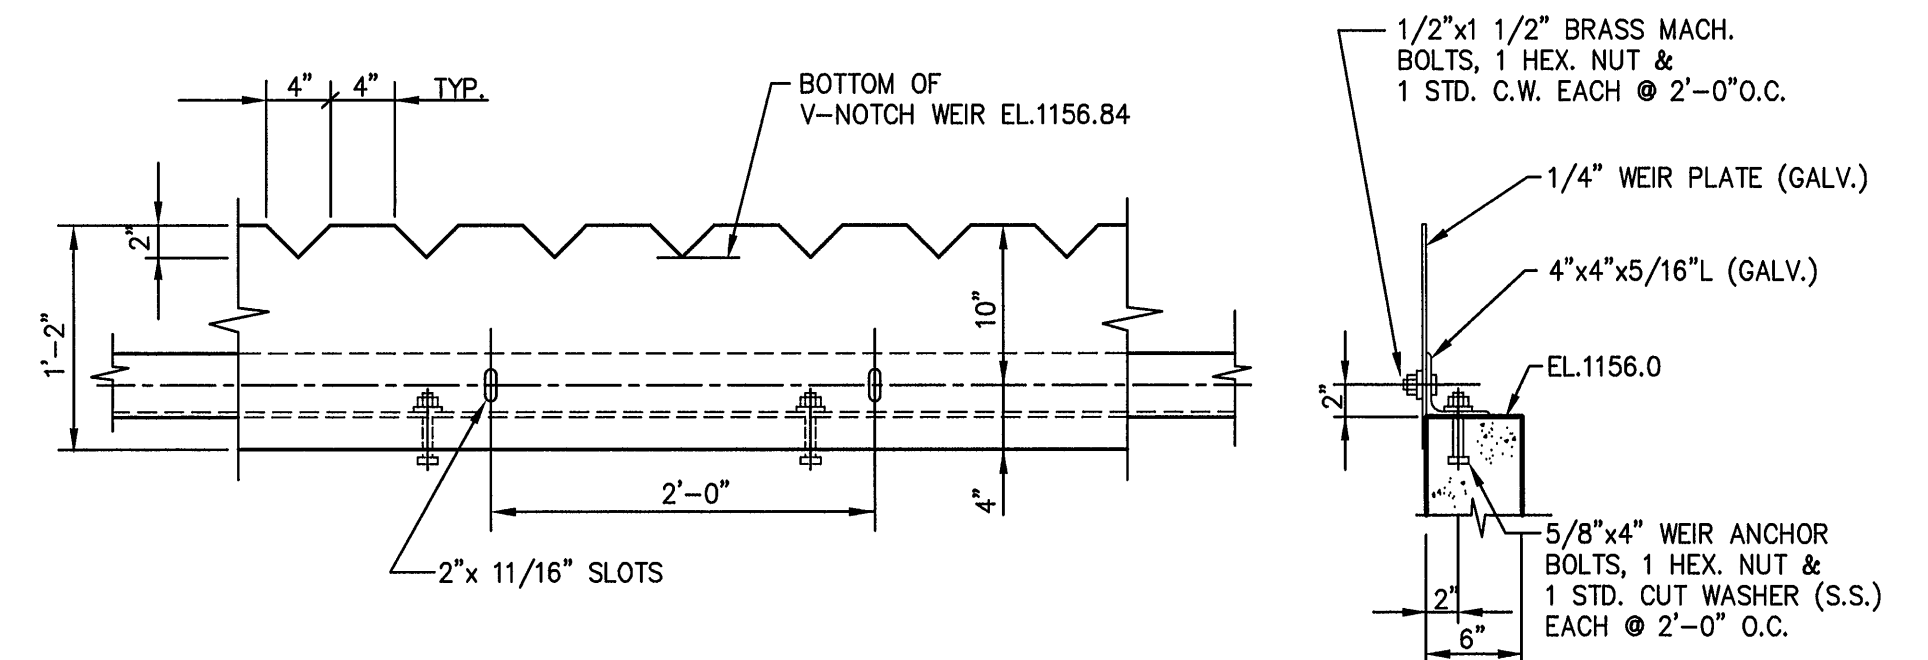


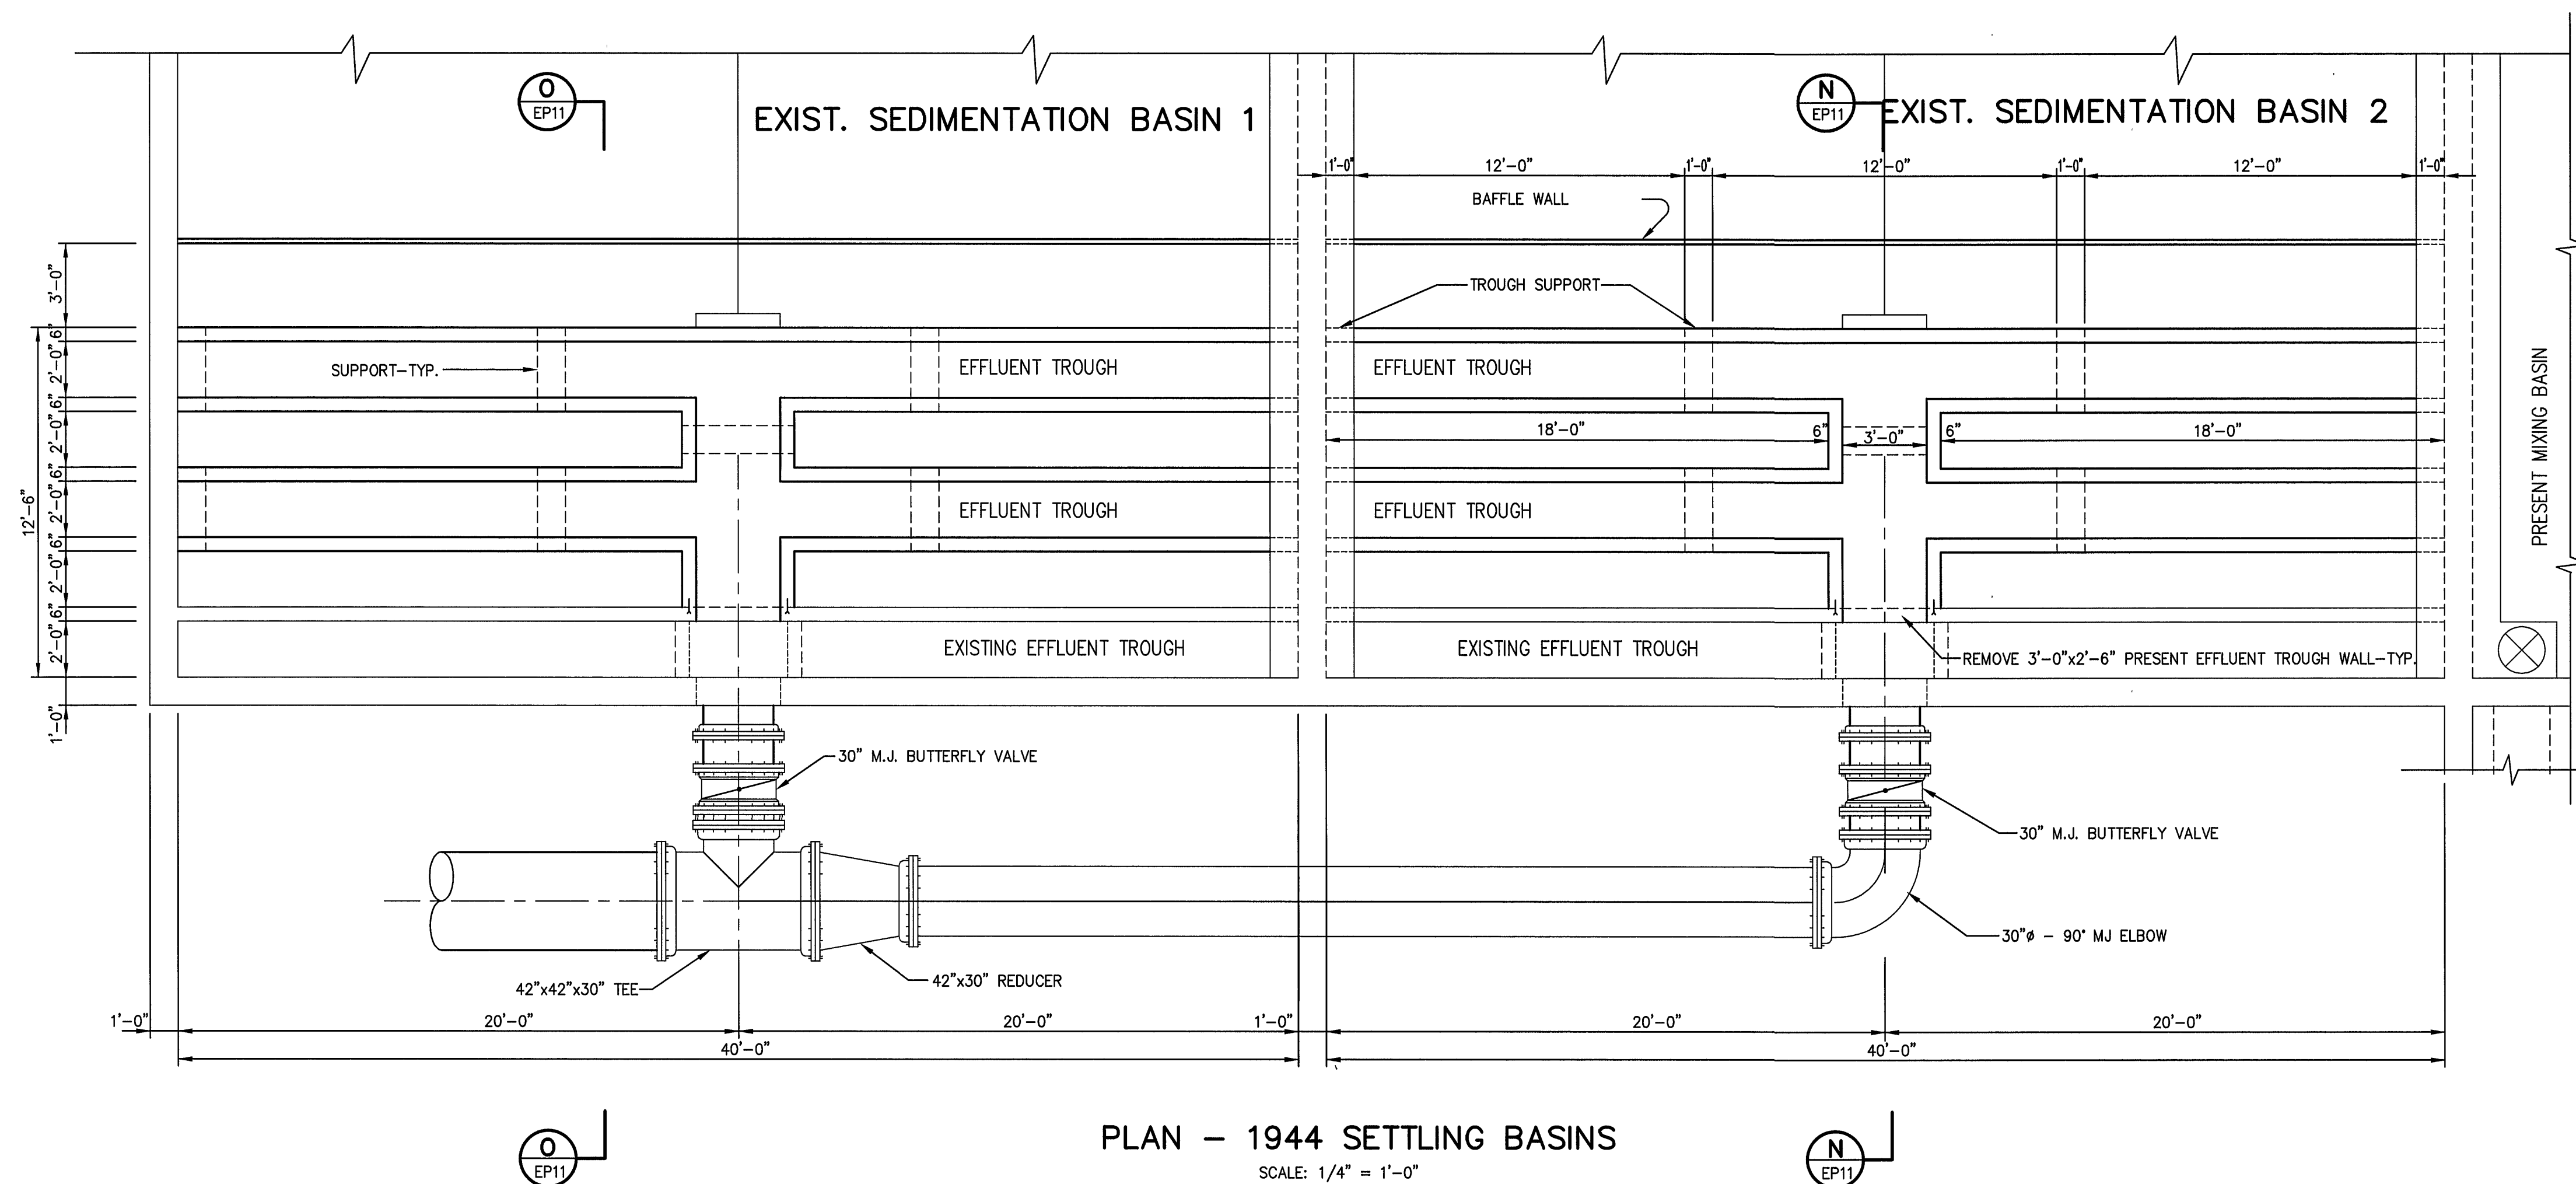

SCALE OF DRAWING $1/4" = 1'-0"$
 4' 3' 2' 1' 0 4' 8'

SCALE OF DRAWING $1/2" = 1'-0"$
 2' 1' 0 2' 4'

SCALE OF DRAWING $1" = 1'-0"$
 1' 0 2'

MATTERN & CRAIG CONSULTING ENGINEERS • SURVEYORS ROANOKE VIRGINIA	DESIGNED: K.C. F.L.			REV.	DATE	DESCRIPTION	BY	APP.	CARVINS COVE FILTER PLANT IMPROVEMENTS — PHASE I ROANOKE, VIRGINIA	DATE APRIL 1992	
	DRAWN: H.F. R.T.										COMM. NO. 9130
	CHECKED: Y.T.L.										SHEET EP11
ALVORD, BURDICK & HOWSON ENGINEERS CHICAGO									1944 SEDIMENTATION BASIN IMPROVEMENT		