


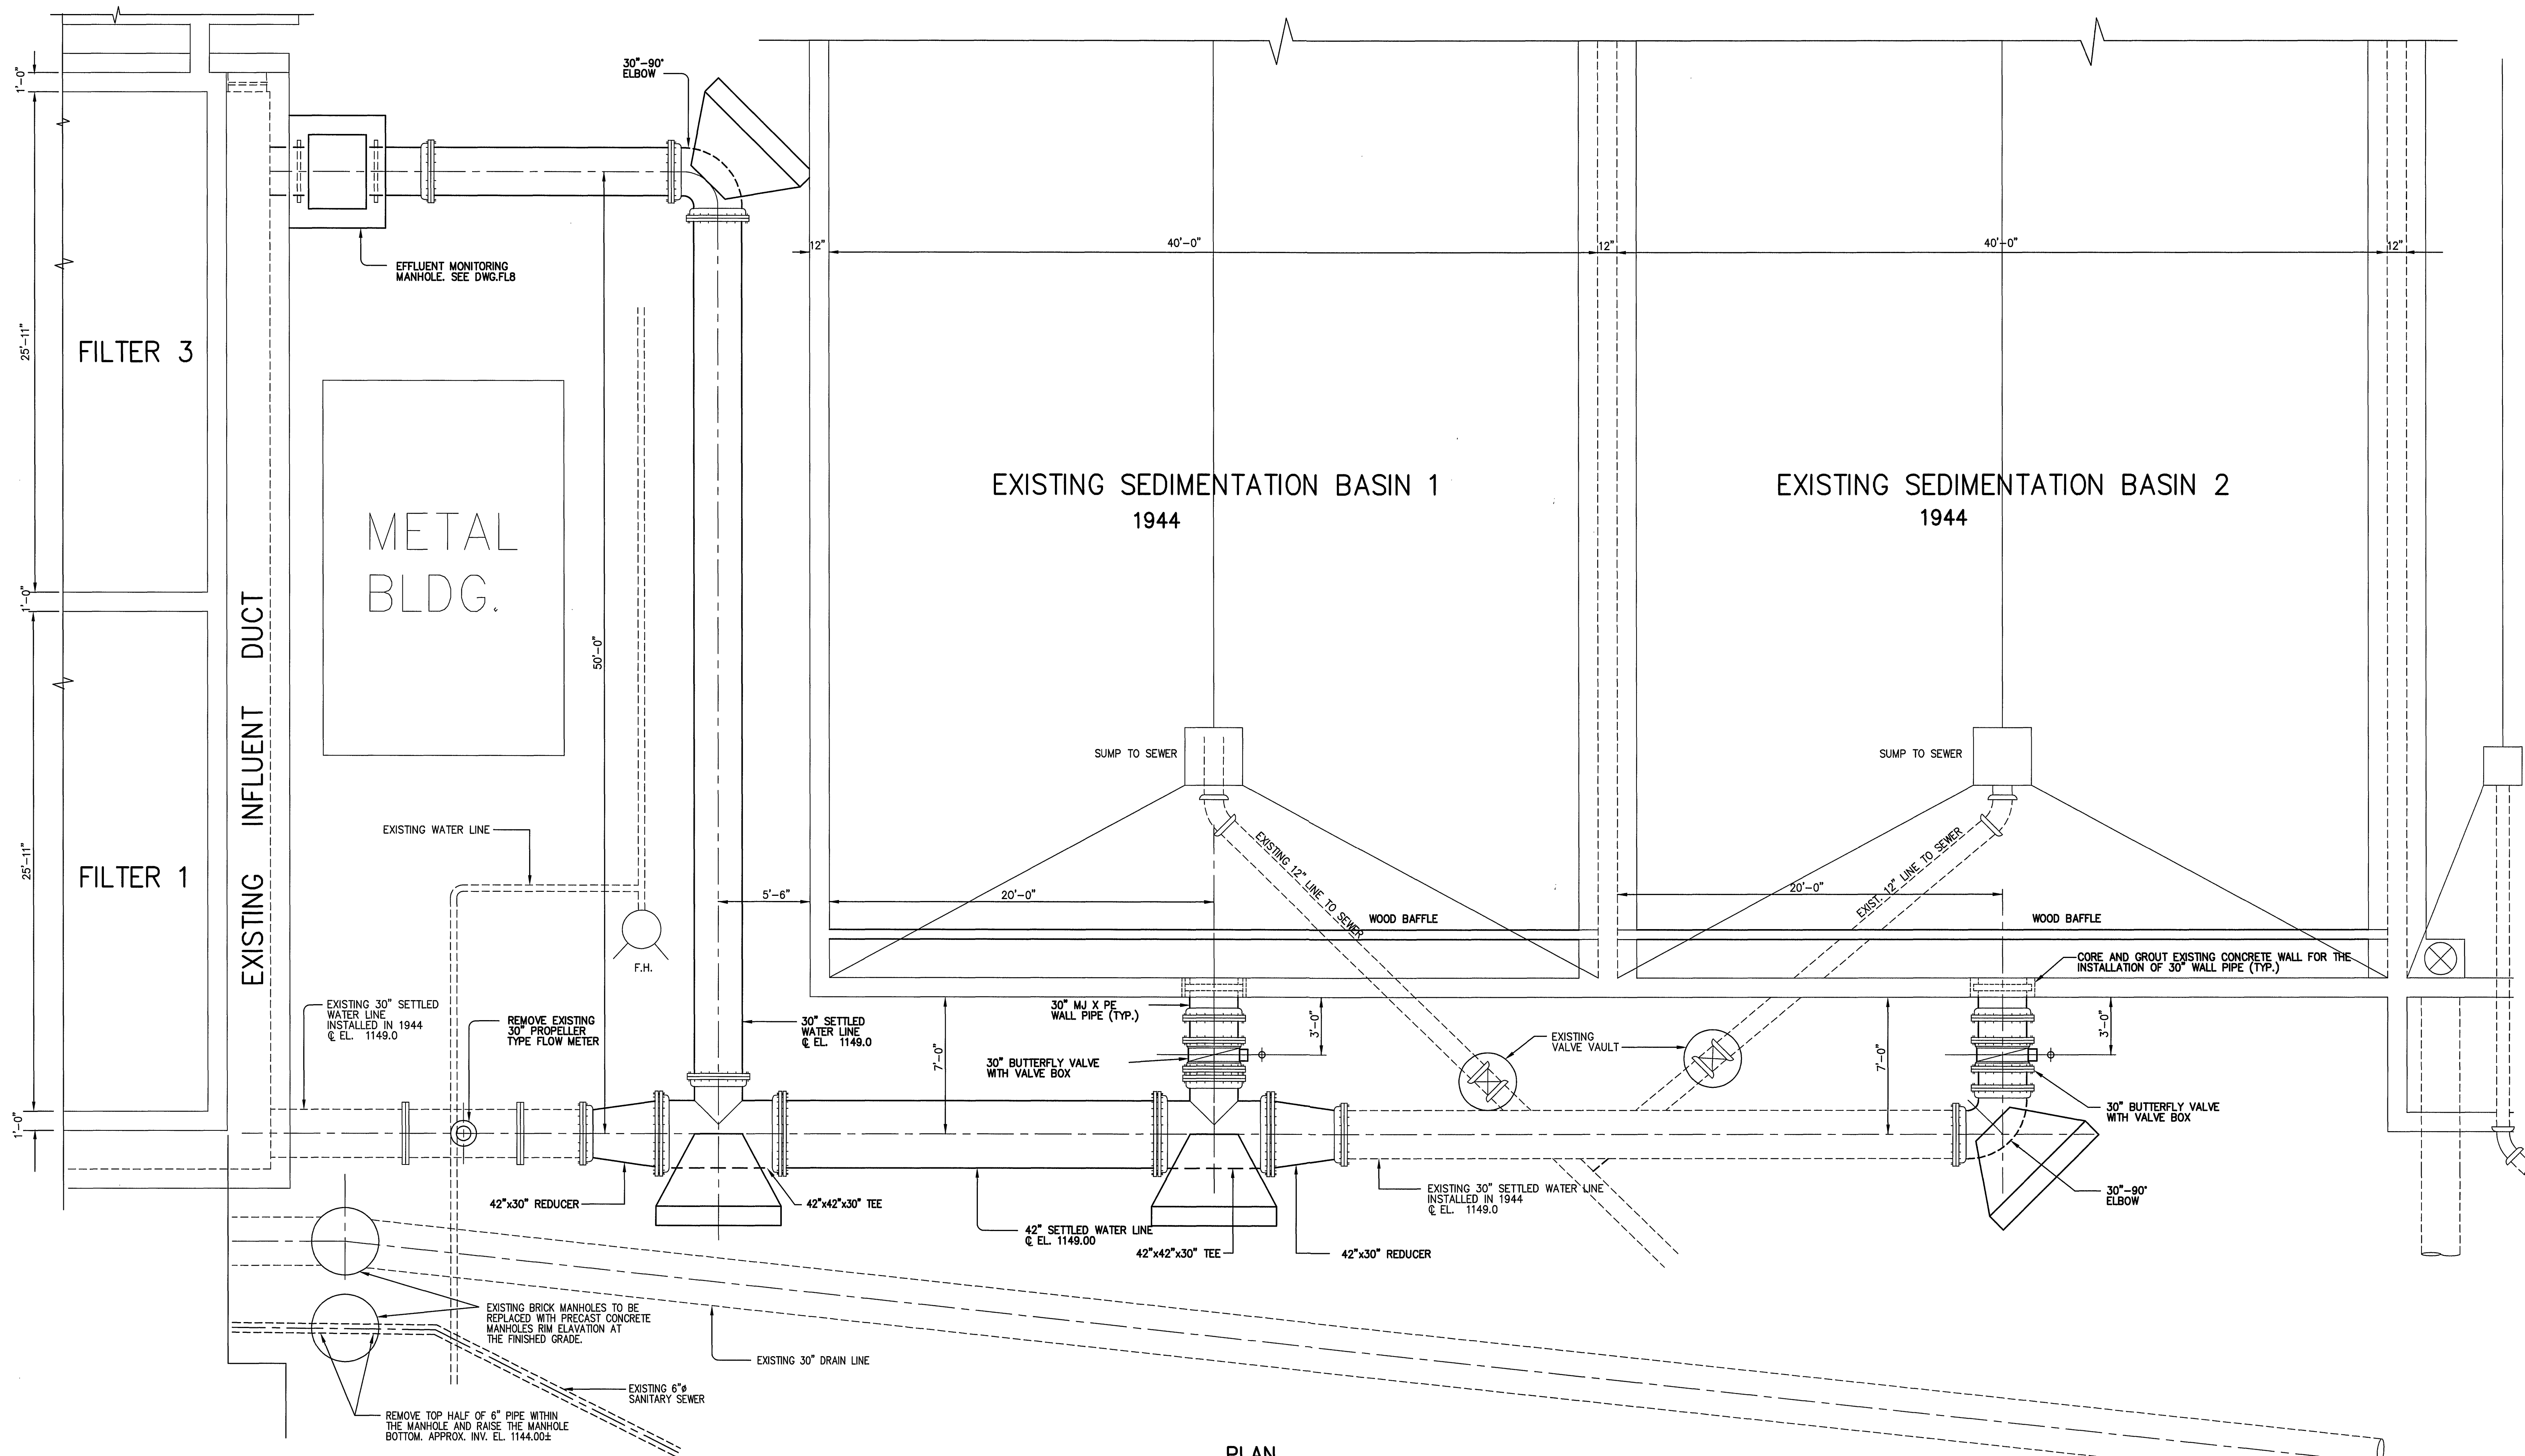

PLAN

SCALE OF DRAWING 1/4" = 1'-0"



DRAWING OF RECORD
DATE: SEP 30 1997

MATTERN & CRAIG
CONSULTING ENGINEERS • SURVEYORS
ROANOKE VIRGINIA

DESIGNED: KHC

DRAWN: HFF
RT

CHECKED: YTL

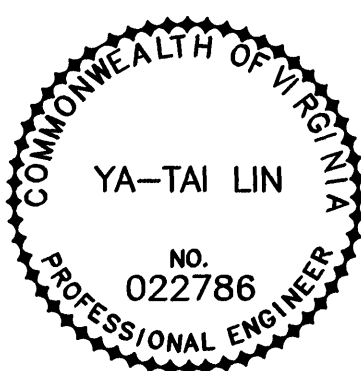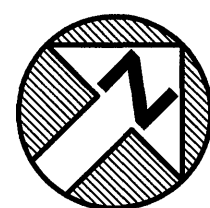

REV.	DATE	DESCRIPTION	BY	APP.

CARVINS COVE FILTER PLANT IMPROVEMENTS – PHASE I
ROANOKE, VIRGINIA

1944 SEDIMENTATION BASIN EFFLUENT IMPROVEMENT

DATE
APRIL 1992
COMM. NO.
9130
SHEET

EP13