
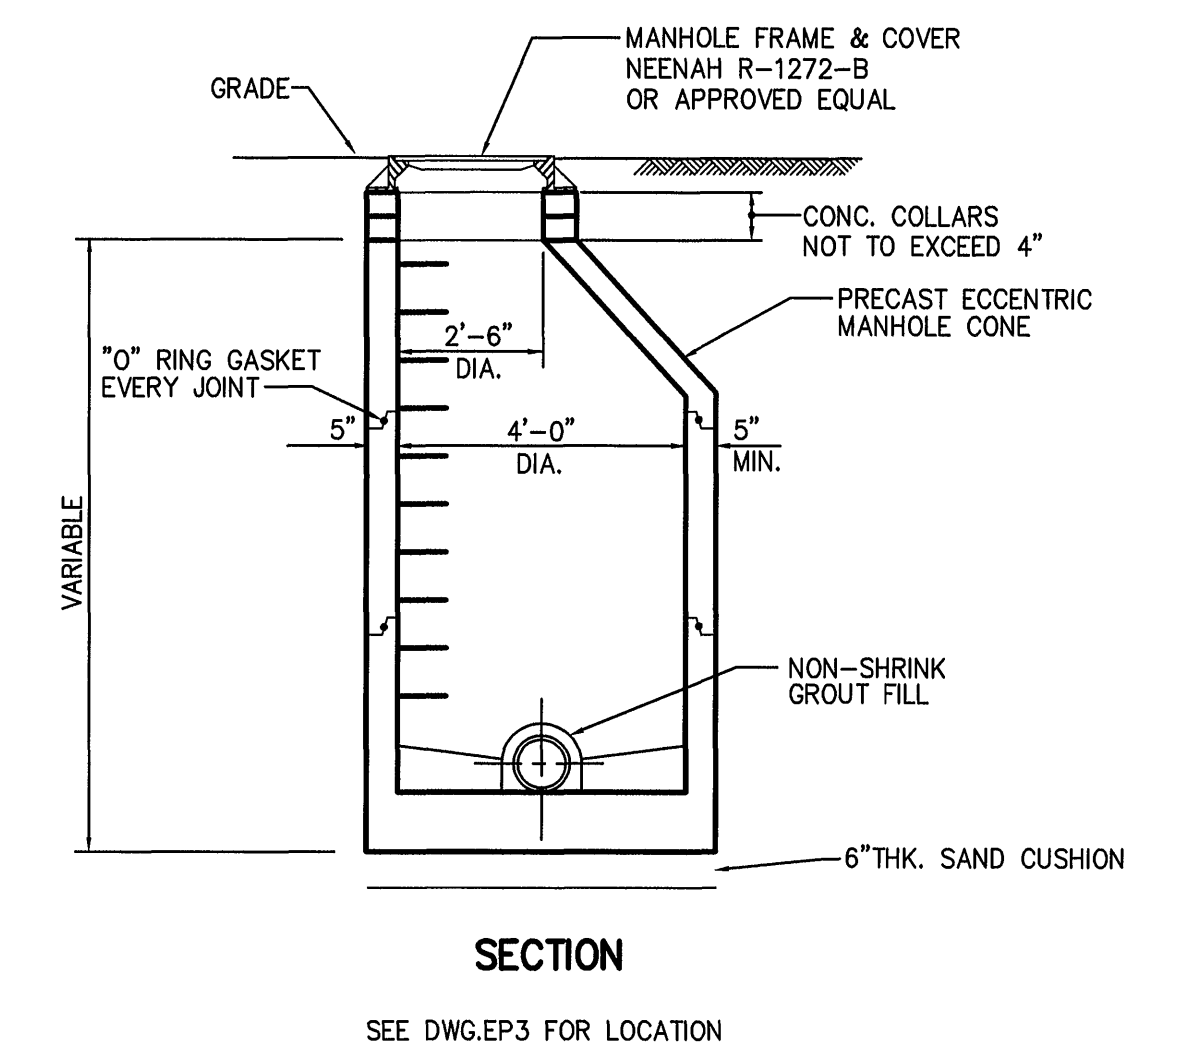
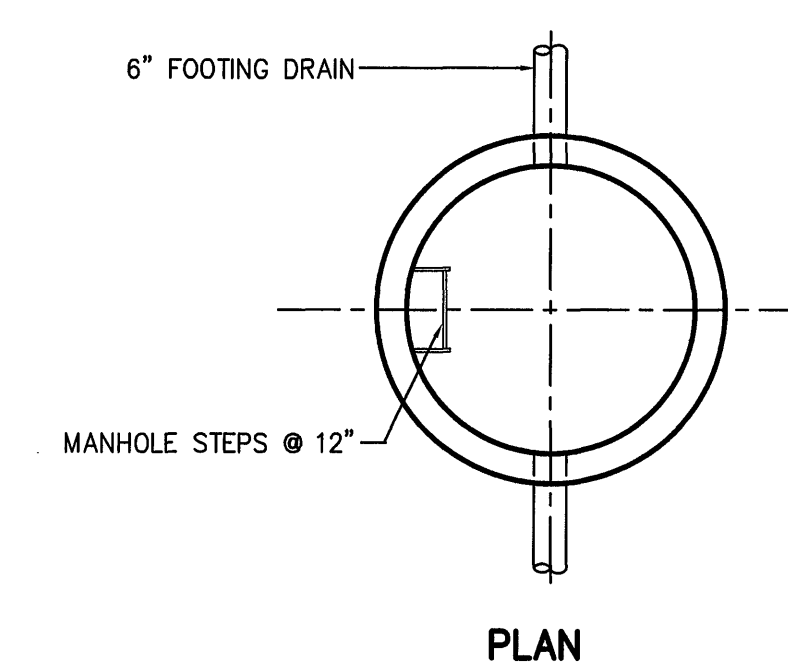
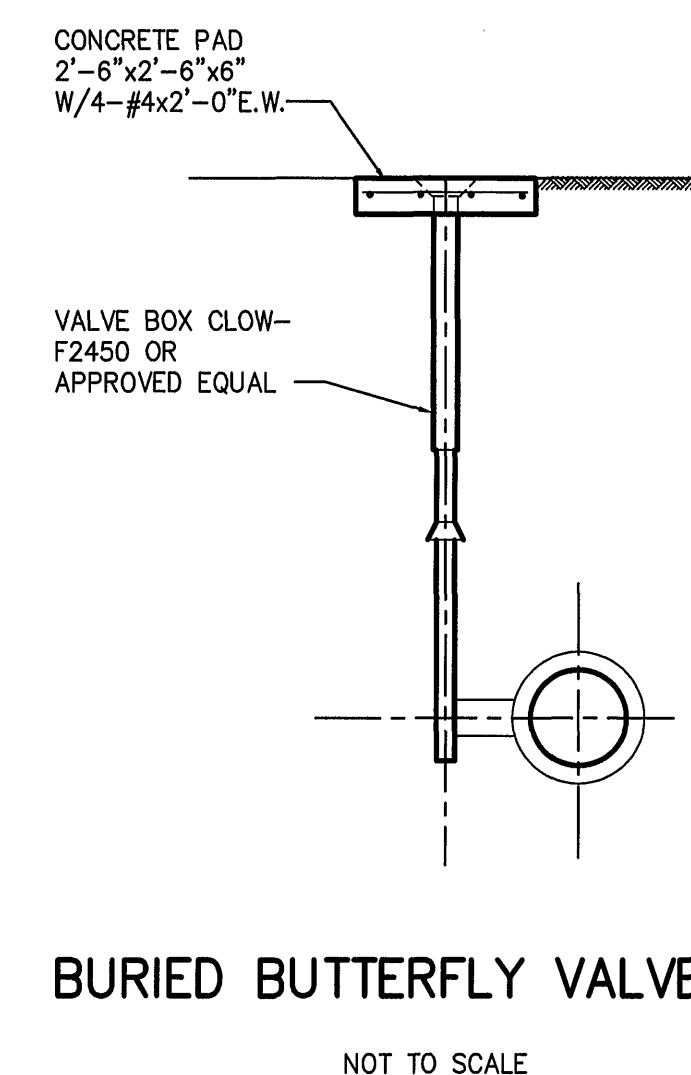
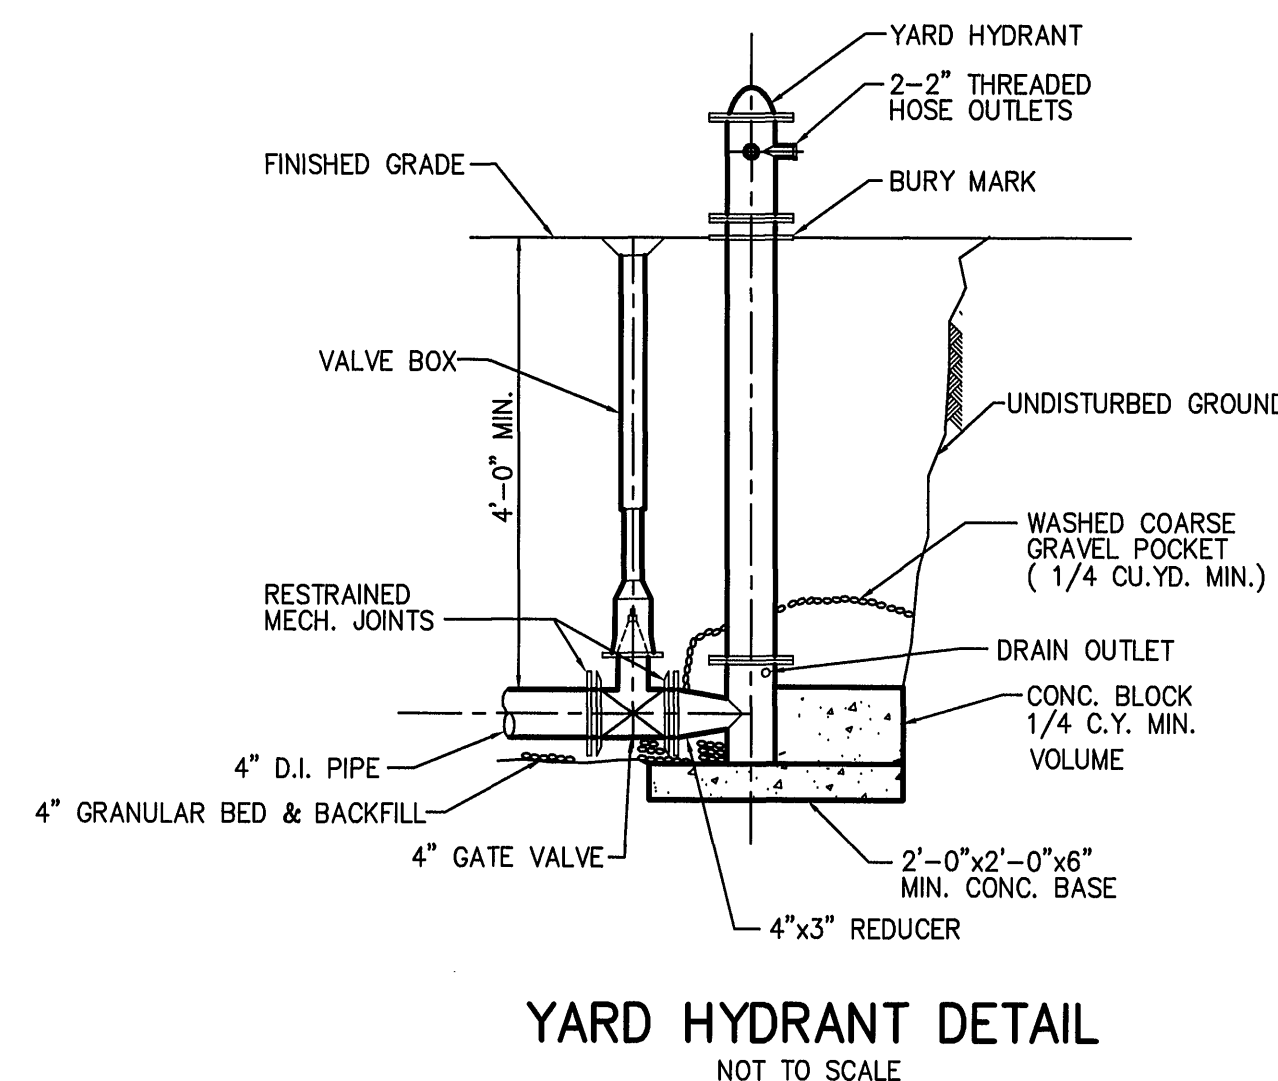
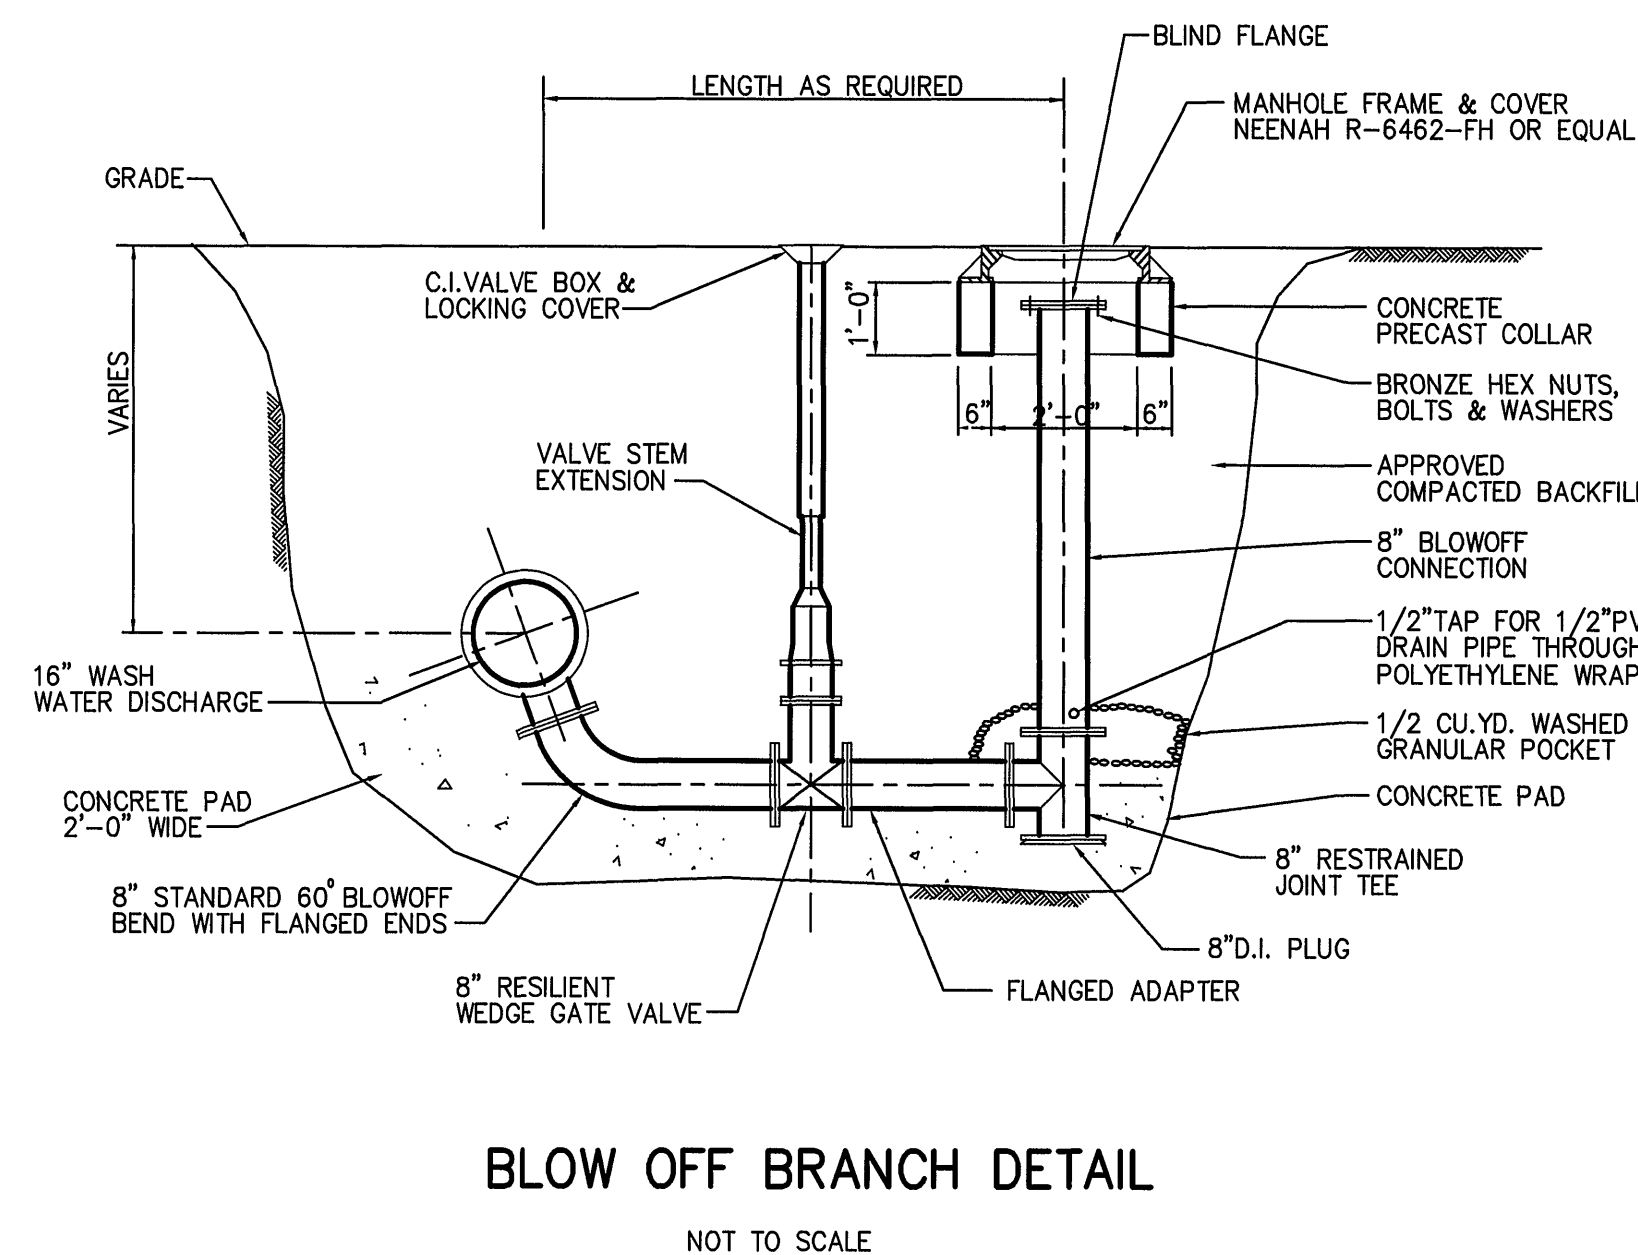
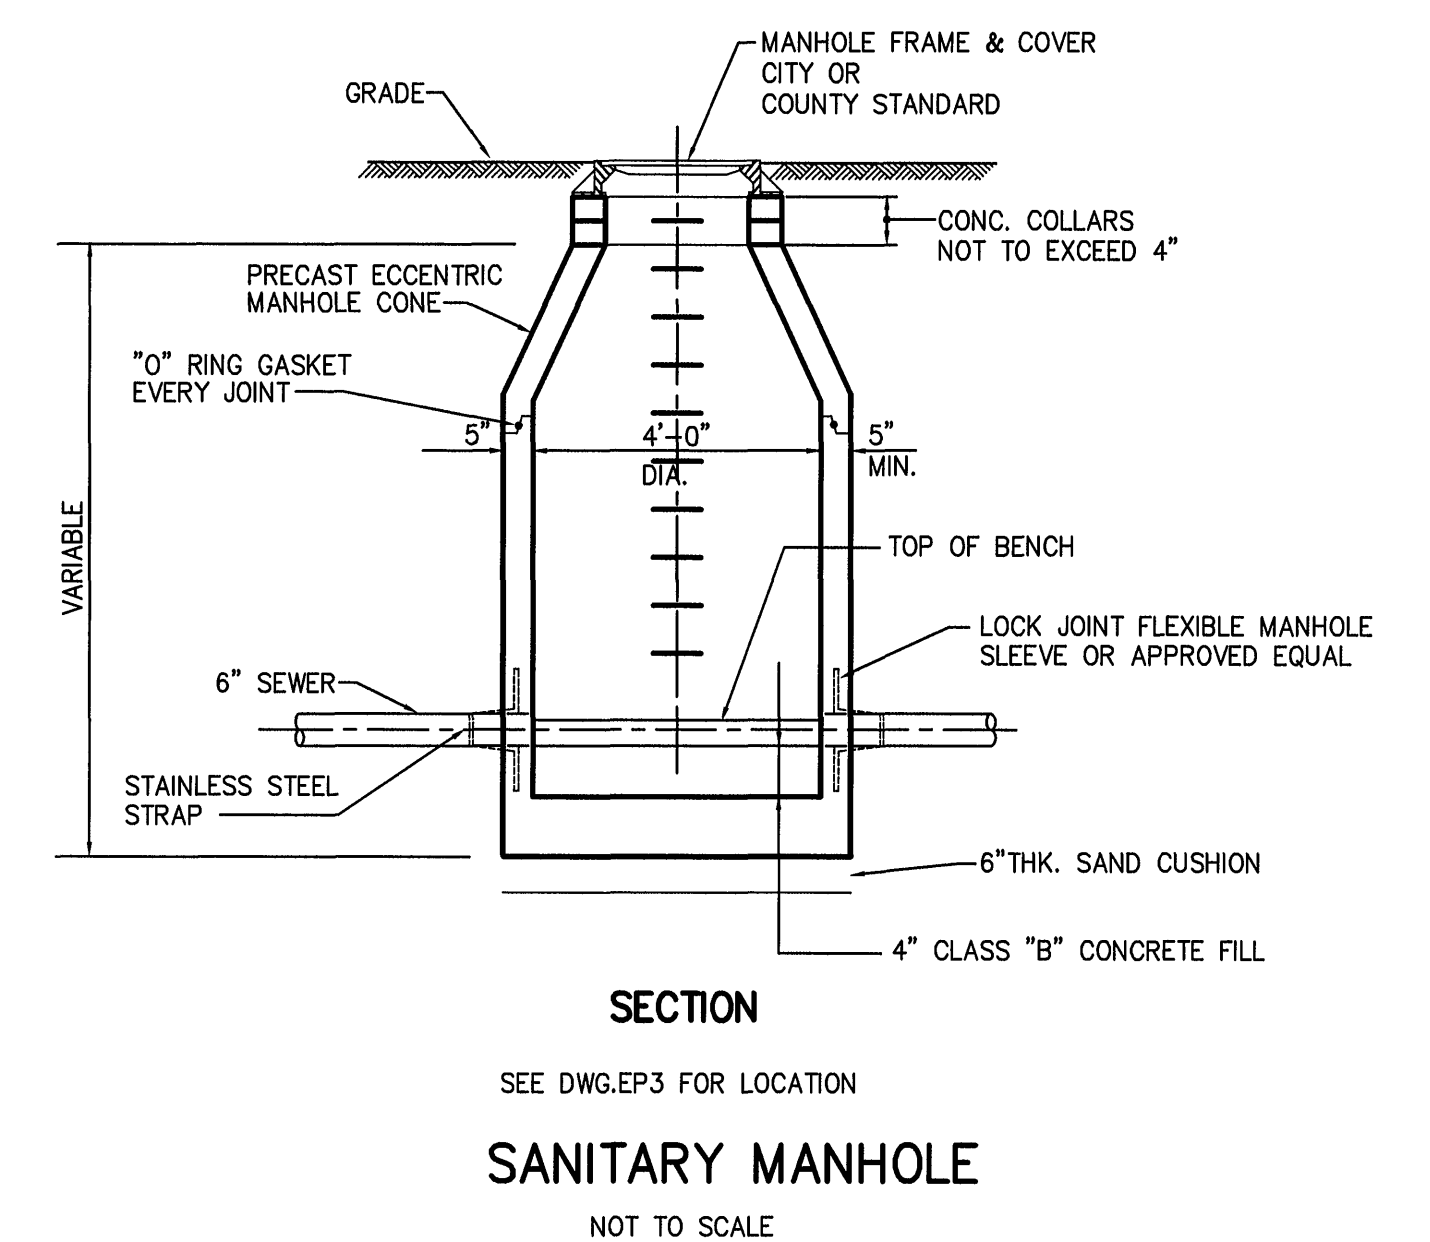
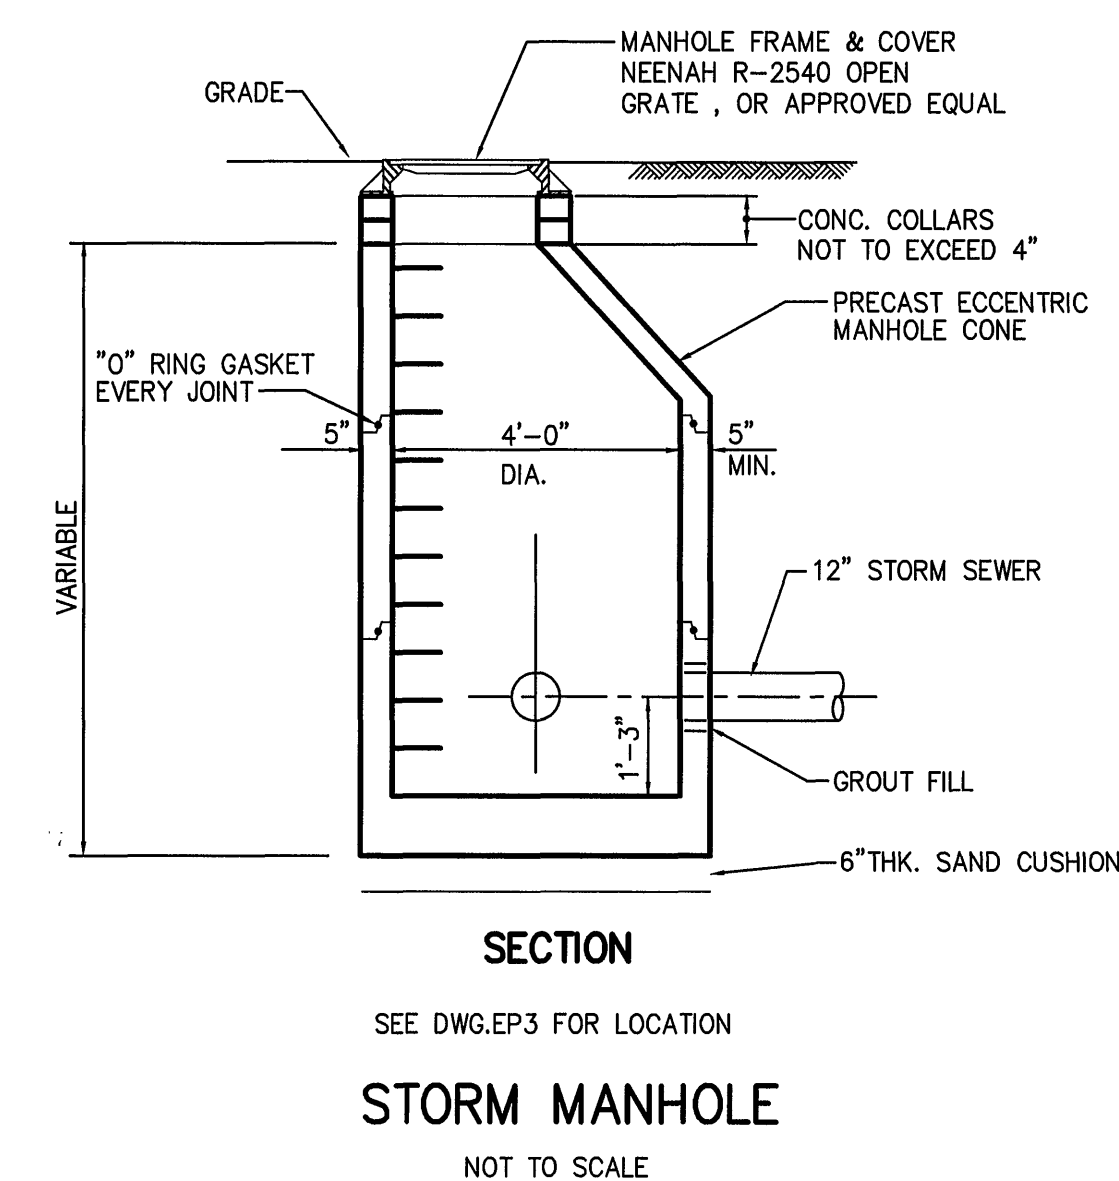
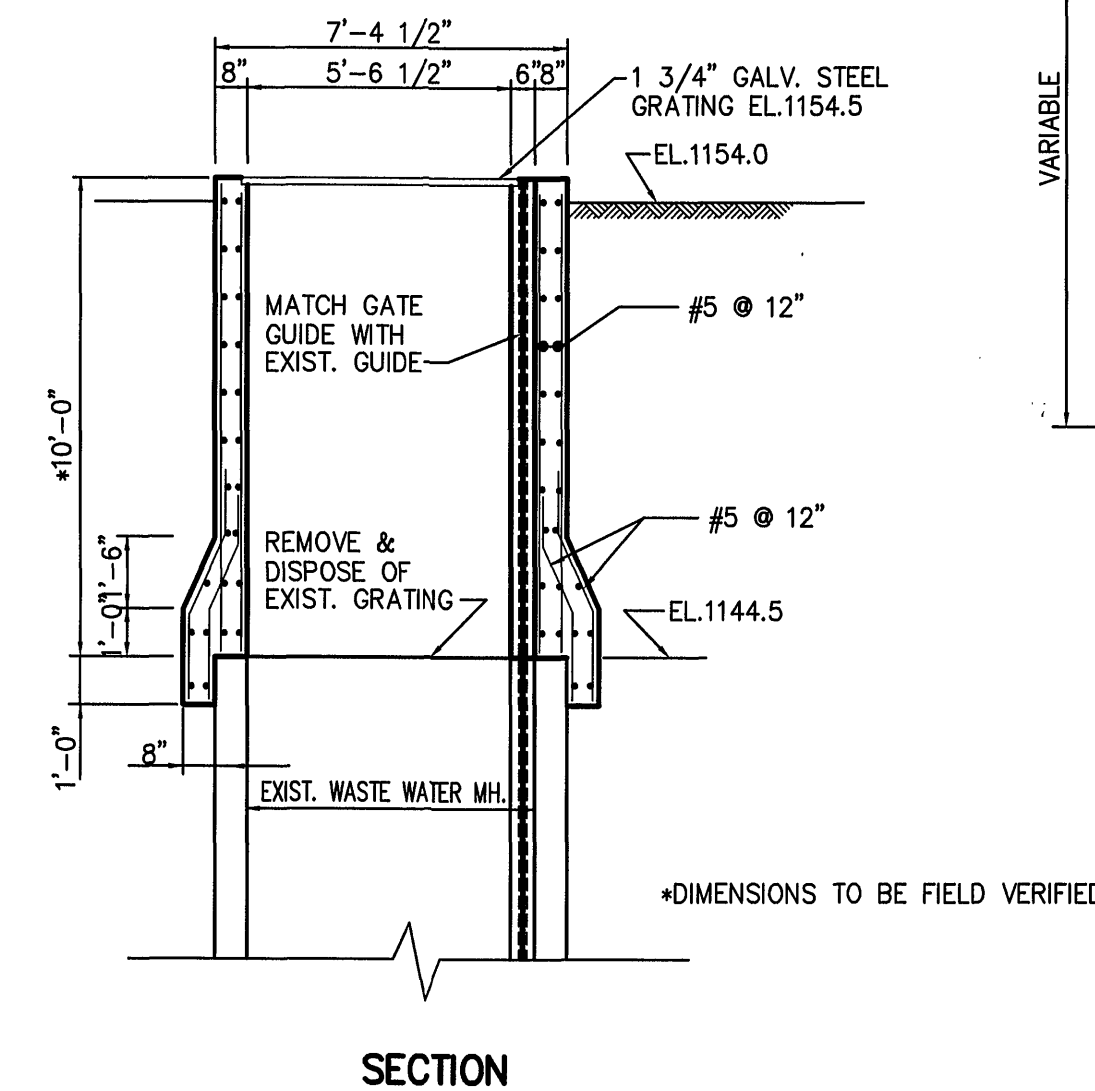
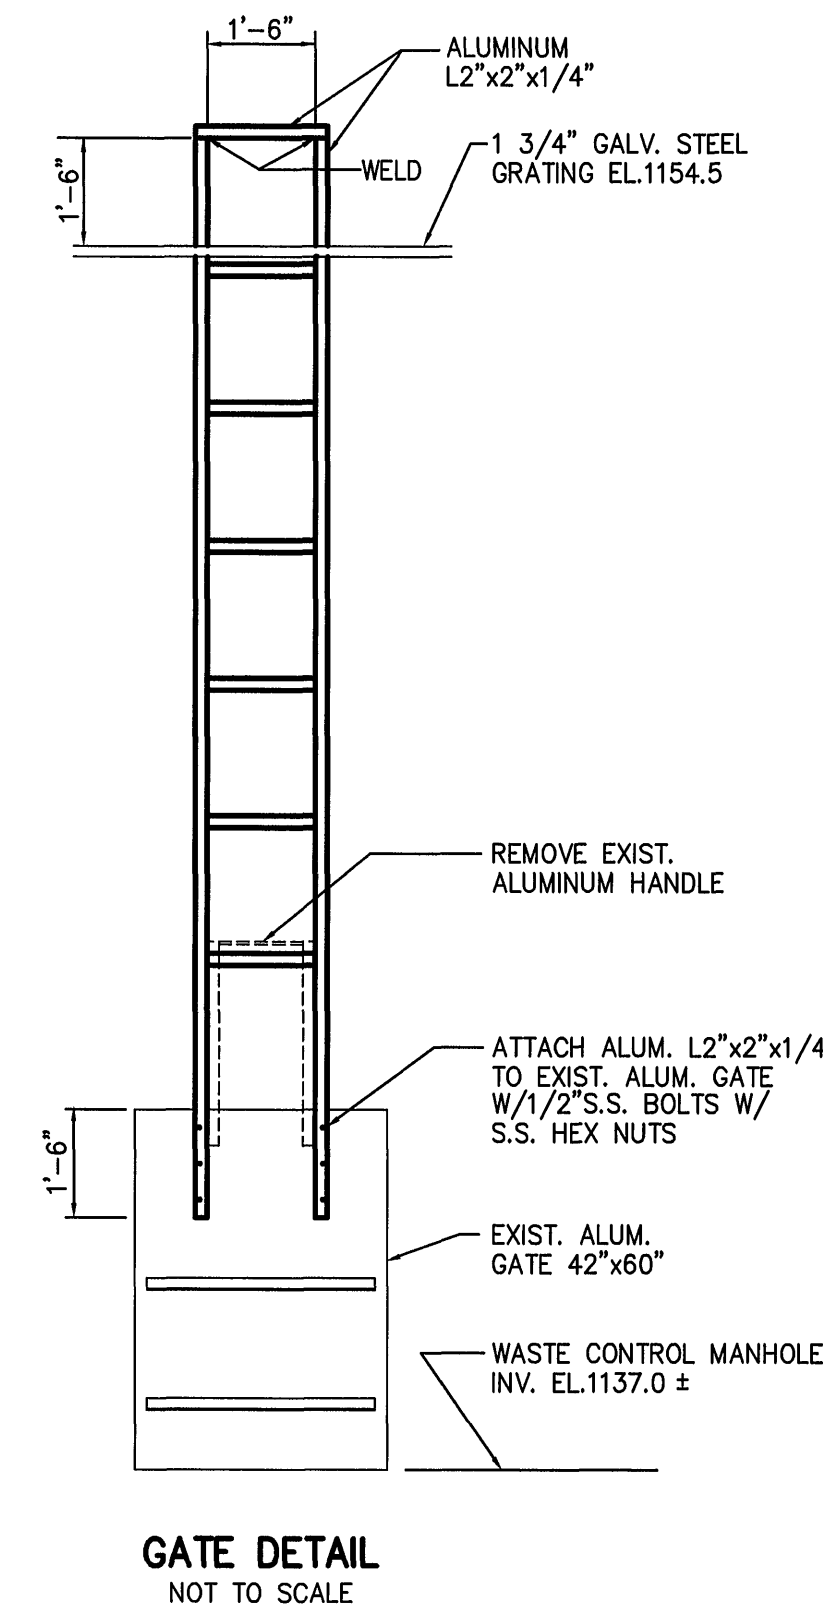
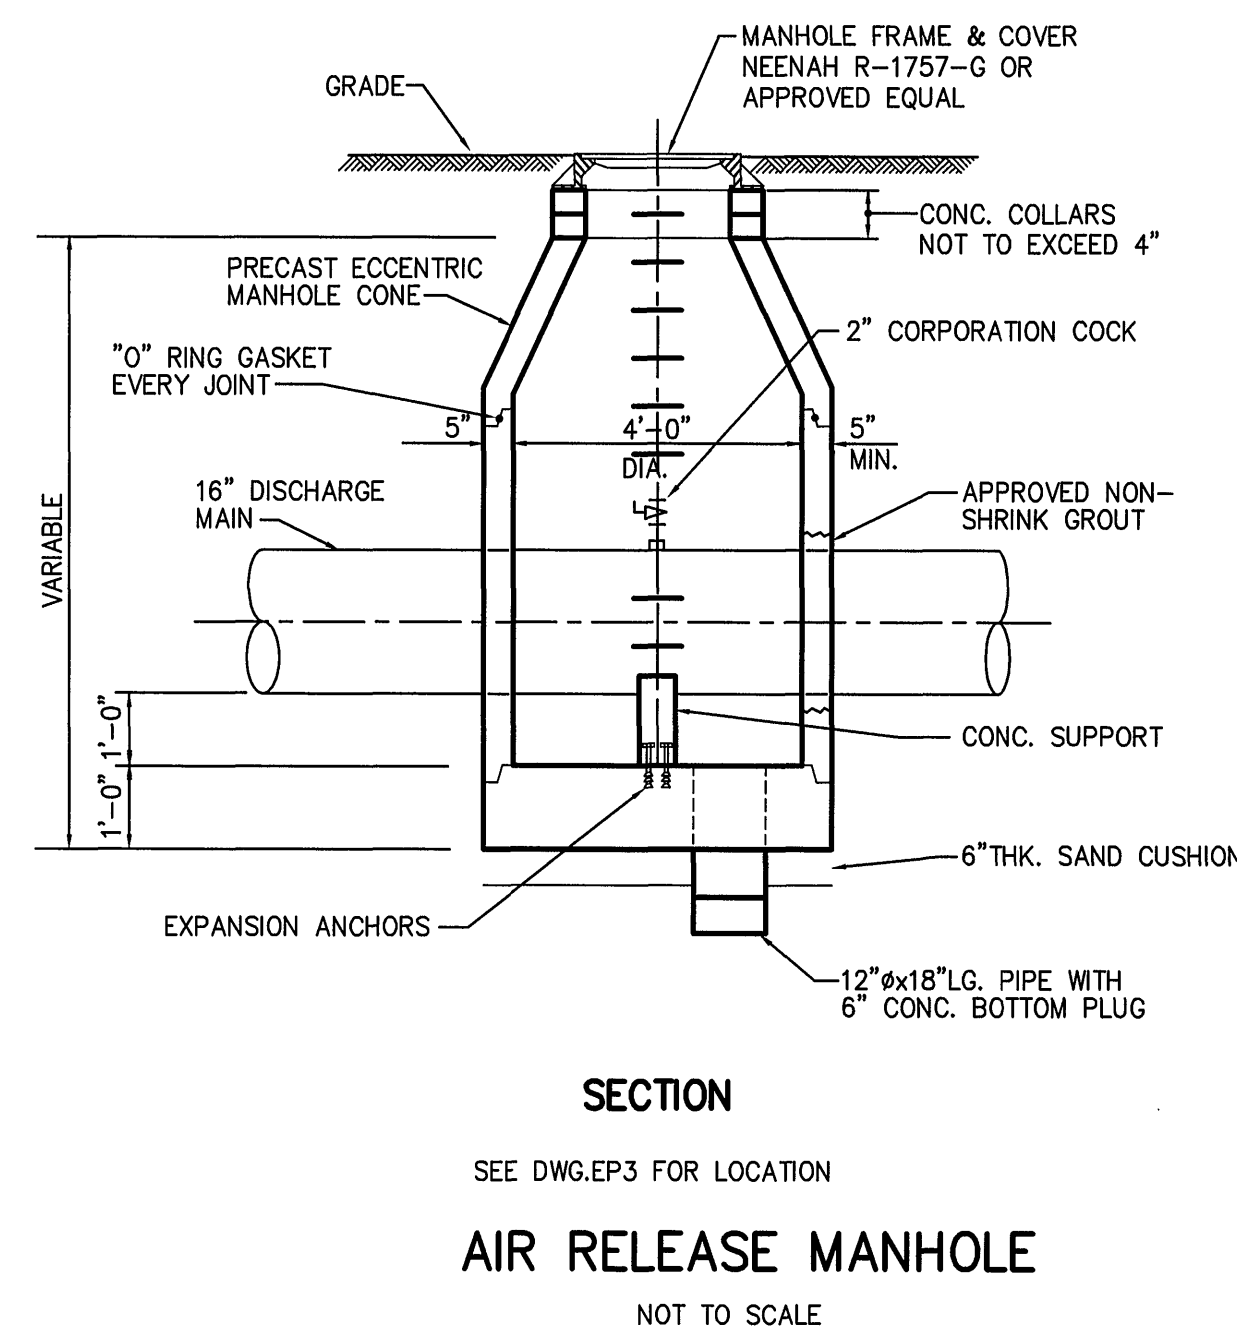
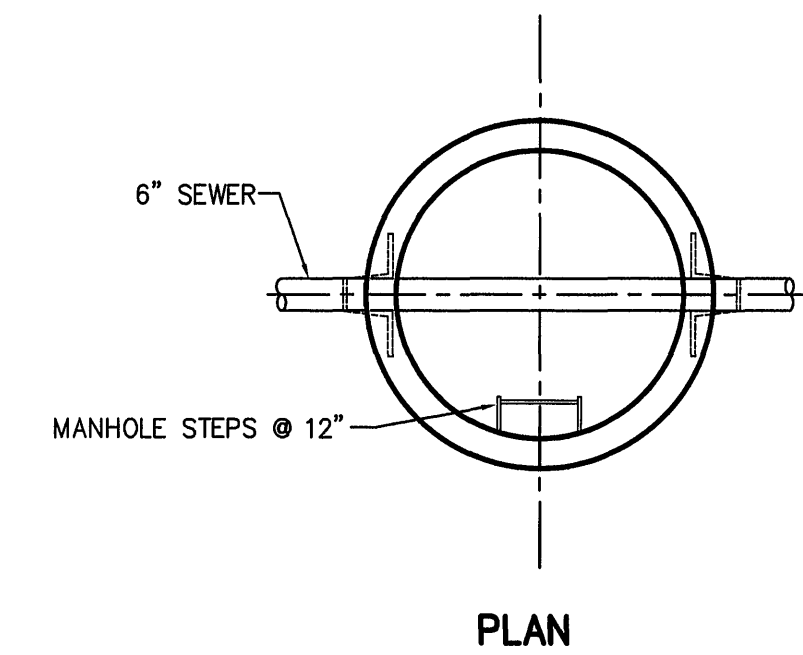
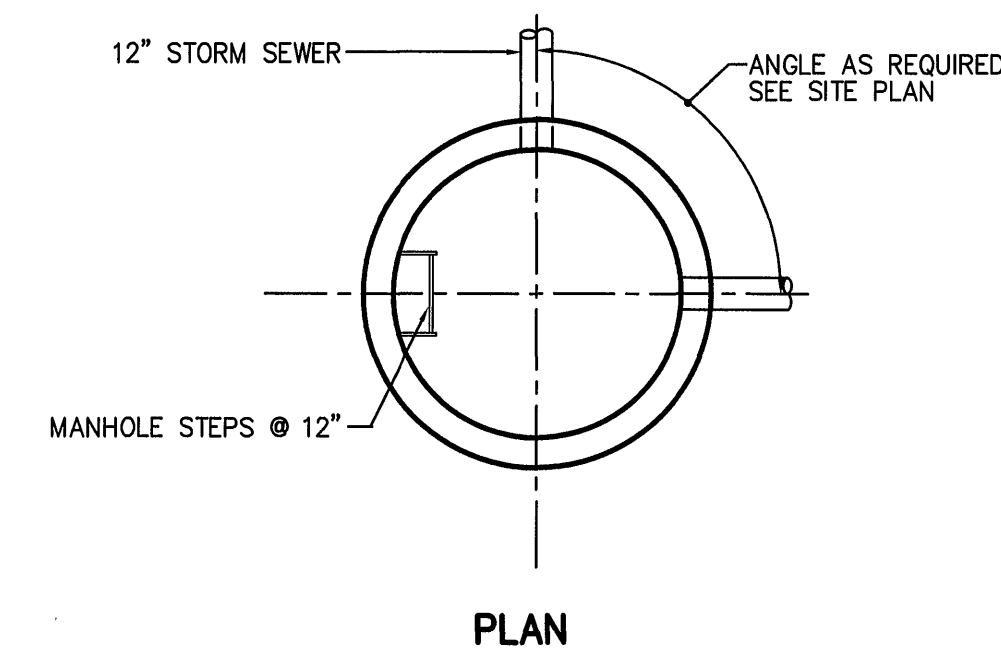
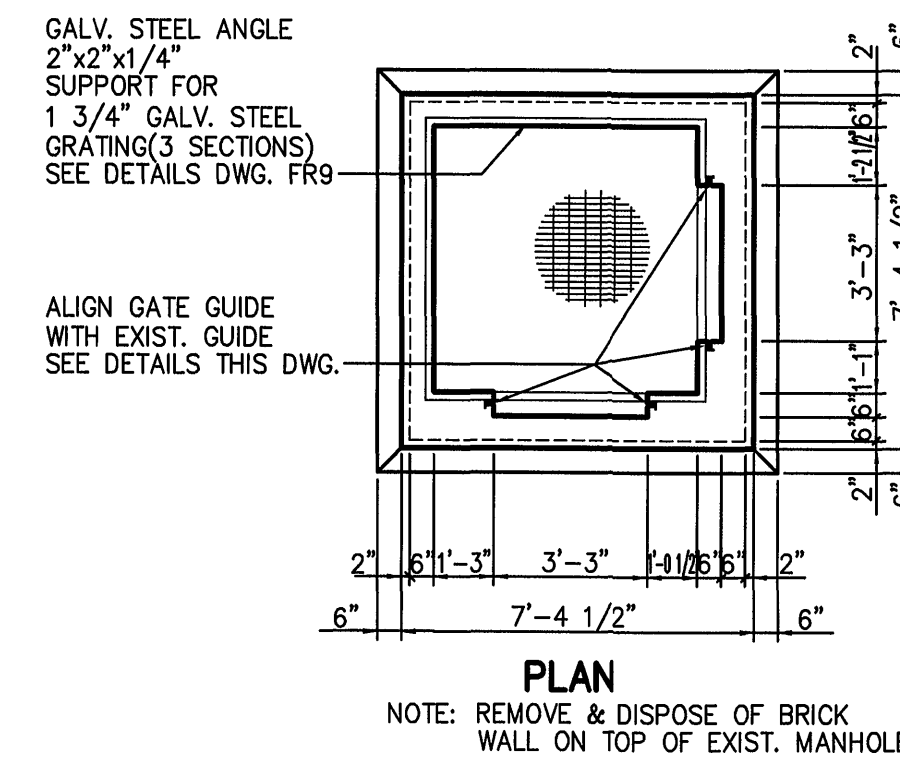
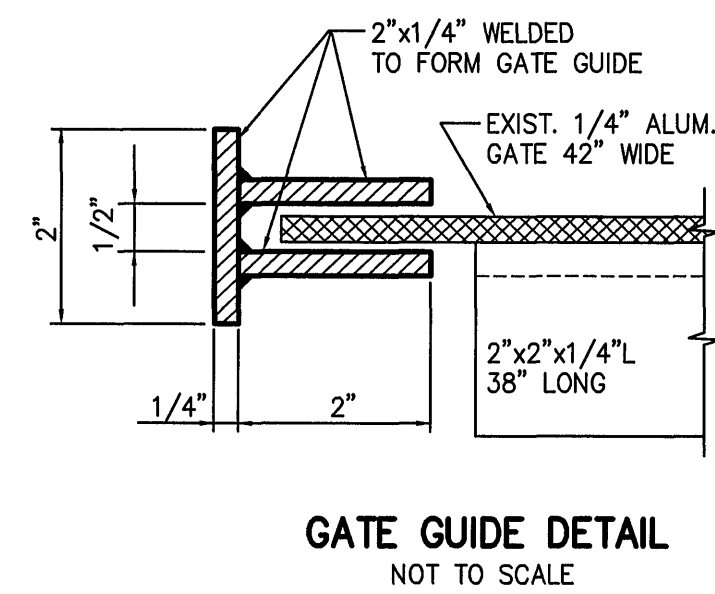


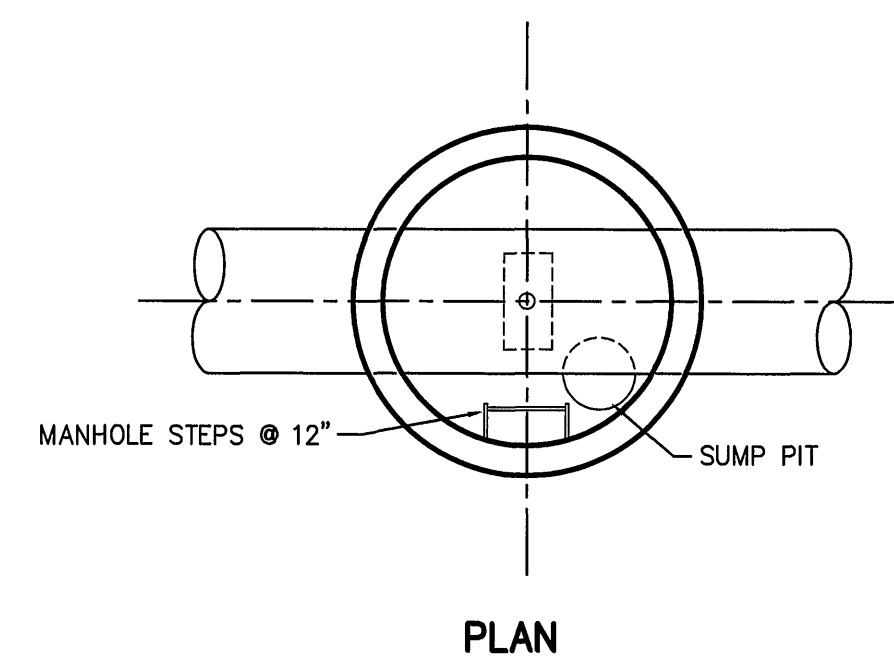

DRAWING OF RECORD
DATE: **SEP 30 1987**

MATTERN & CRAIG CONSULTING ENGINEERS • SURVEYORS ROANOKE VIRGINIA	DESIGNED: K.H.C. B.M.		REV.	DATE	DESCRIPTION	BY	APP.	CARVINS COVE FILTER PLANT IMPROVEMENTS – PHASE I ROANOKE, VIRGINIA	DATE APRIL 1992
	DRAWN: H.F. R.T.								COMM. NO. 9130
	CHECKED: Y.T.L.								SHEET EP17
ALVORD, BURDICK & HOWSON ENGINEERS CHICAGO								MISCELLANEOUS DETAILS – 2	