


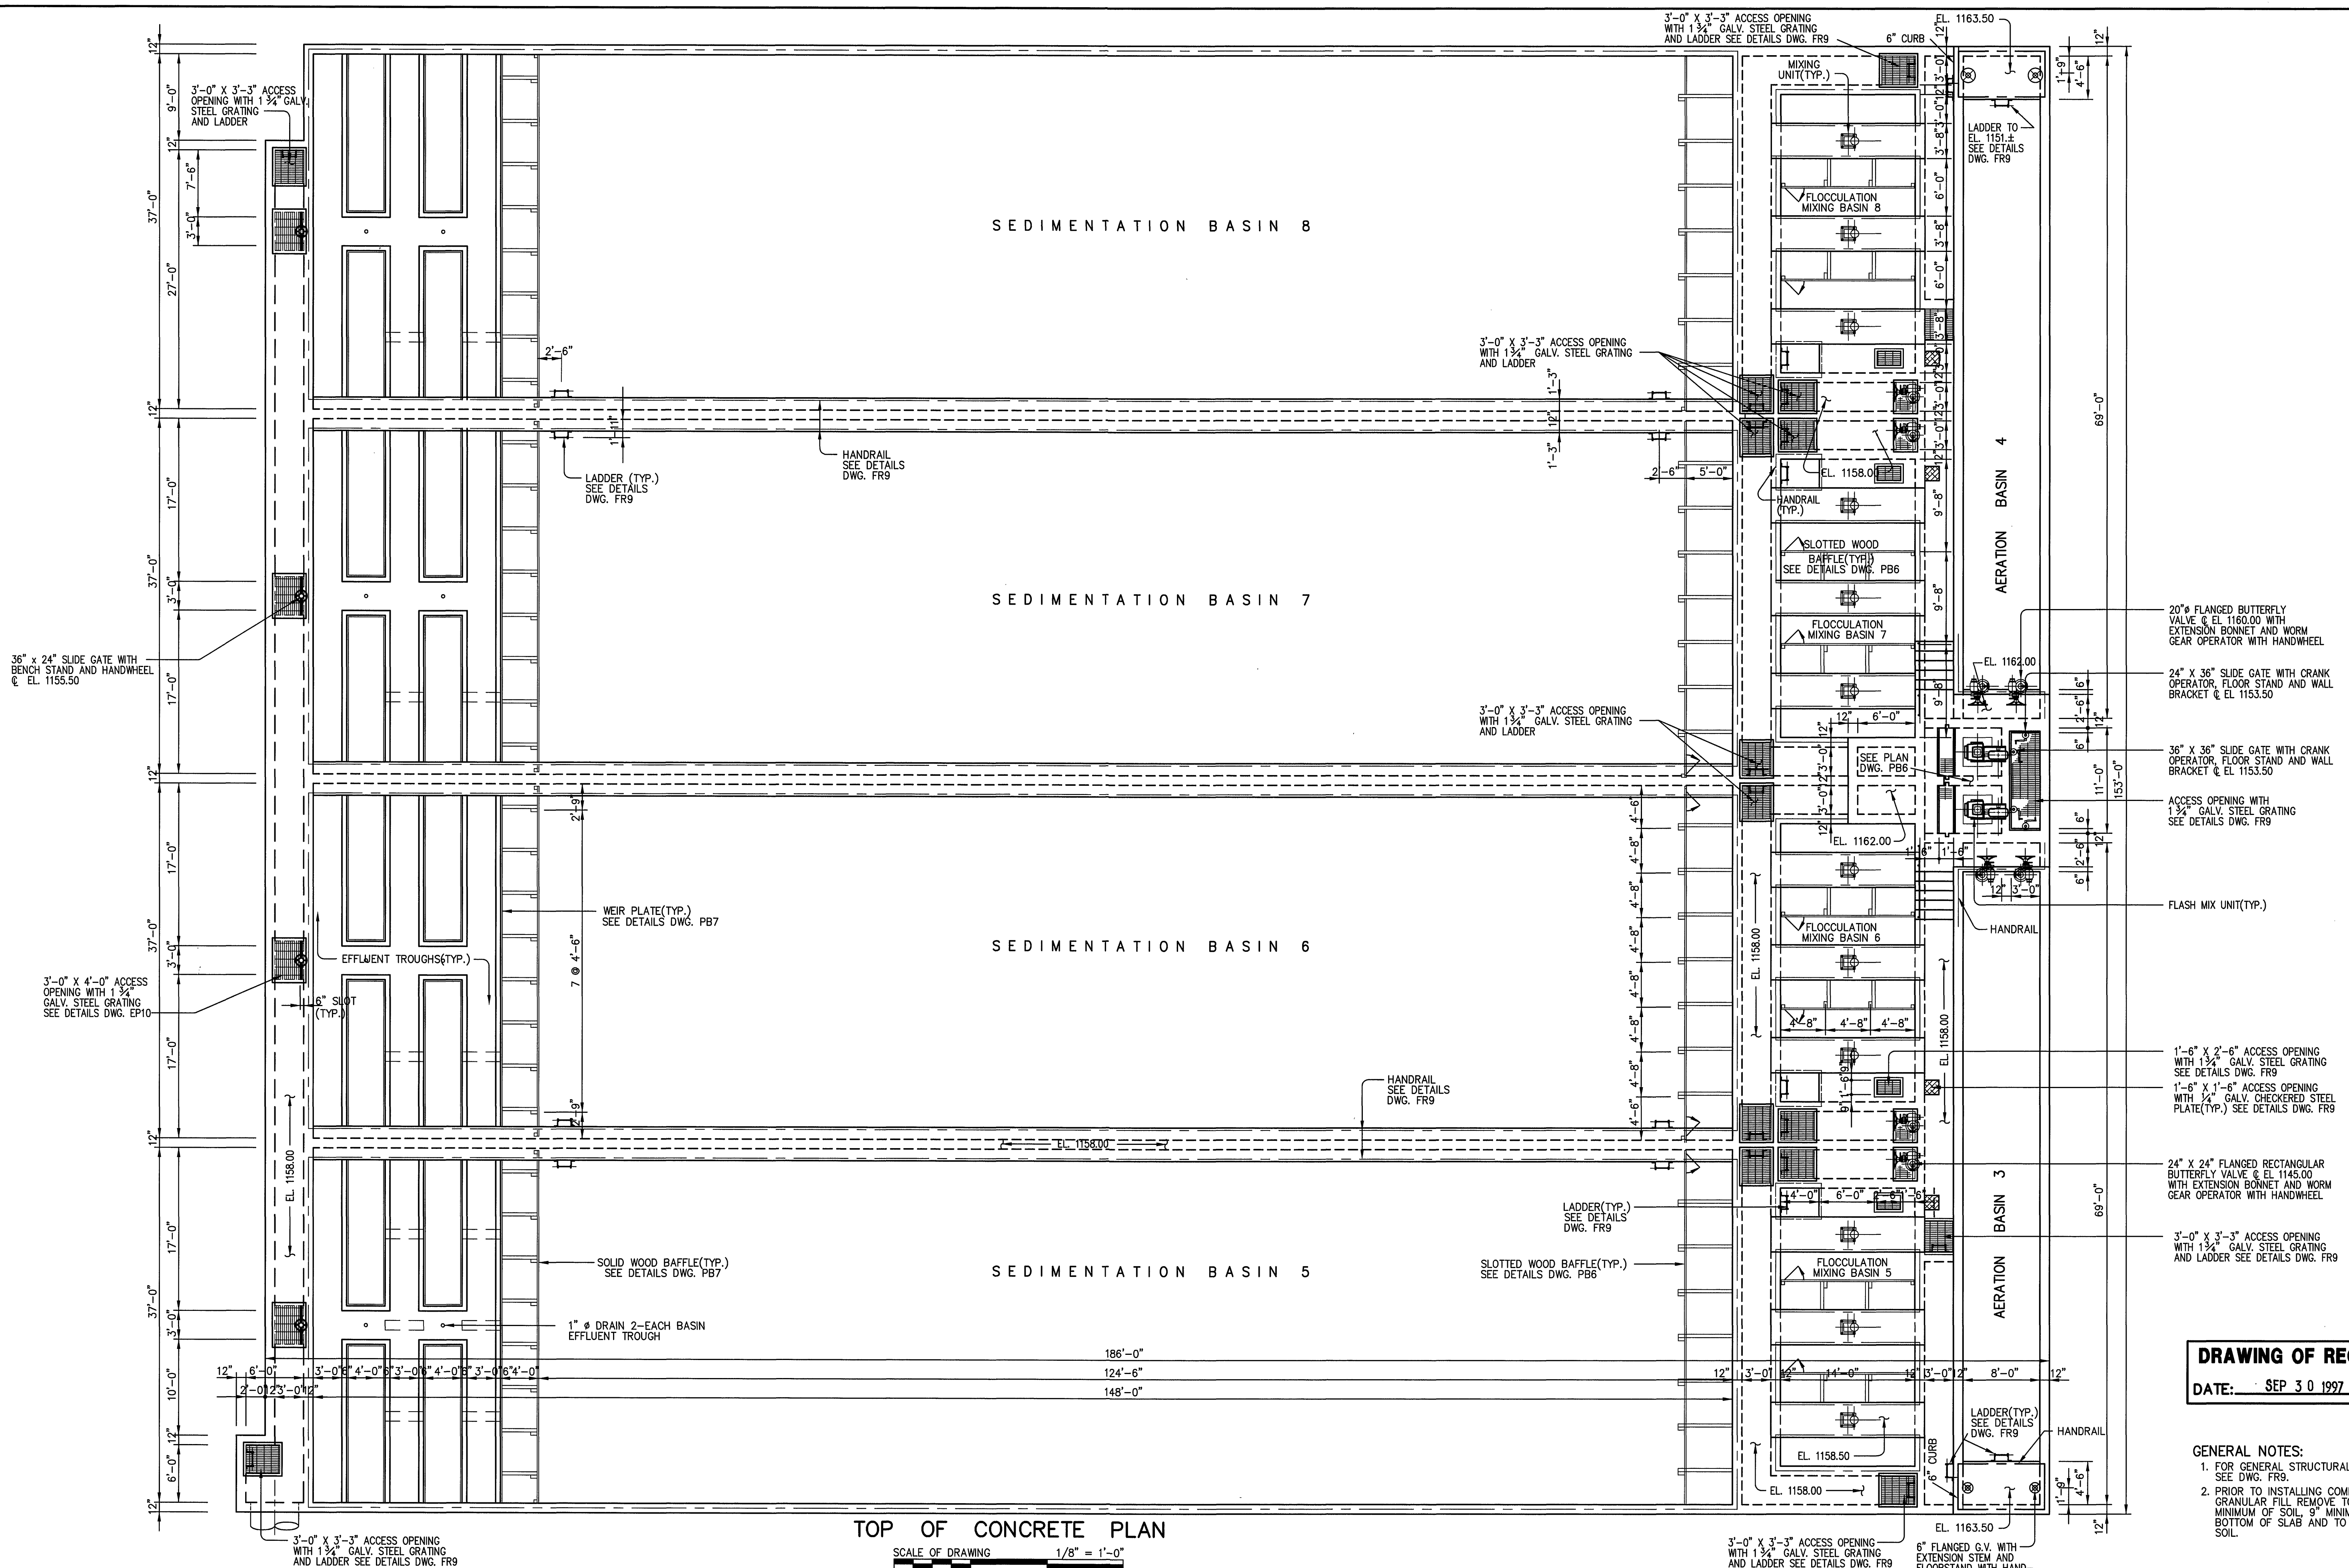


DRAWING OF RECORD
 DATE: SEP 30 1997

GENERAL NOTES:
 1. FOR GENERAL STRUCTURAL DETAILS SEE DWG. FR9.
 2. PRIOR TO INSTALLING COMPACTED GRANULAR FILL REMOVE TOP 2'-0" MINIMUM OF SOIL, 9" MINIMUM BELOW BOTTOM OF SLAB AND TO UNDISTURBED SOIL.

MATTERN & CRAIG
 CONSULTING ENGINEERS • SURVEYORS
 ROANOKE VIRGINIA

ALVORD, BURDICK & HOWSON
 ENGINEERS CHICAGO

DESIGNED: BGM
 DRAWN: HFF
 CHECKED: YTL

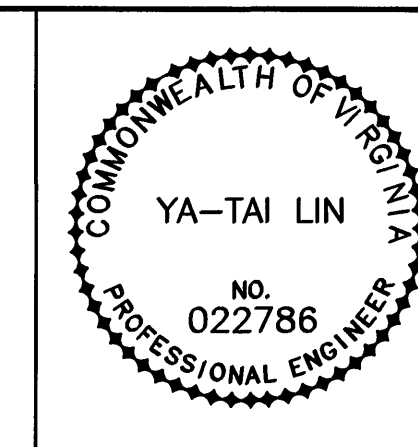

REV.	DATE	DESCRIPTION	BY	APP.

CARVINS COVE FILTER PLANT IMPROVEMENTS – PHASE I
 ROANOKE, VIRGINIA

12 MGD PRETREATMENT BASINS – TOP OF CONCRETE PLAN

DATE
APRIL 1992

COMM. NO.
9130

SHEET
PB2